


ORIGINAL	BY	DATE
SURVEY		
PLOTTED		
TEMPLATE		
NOTE BOOK		

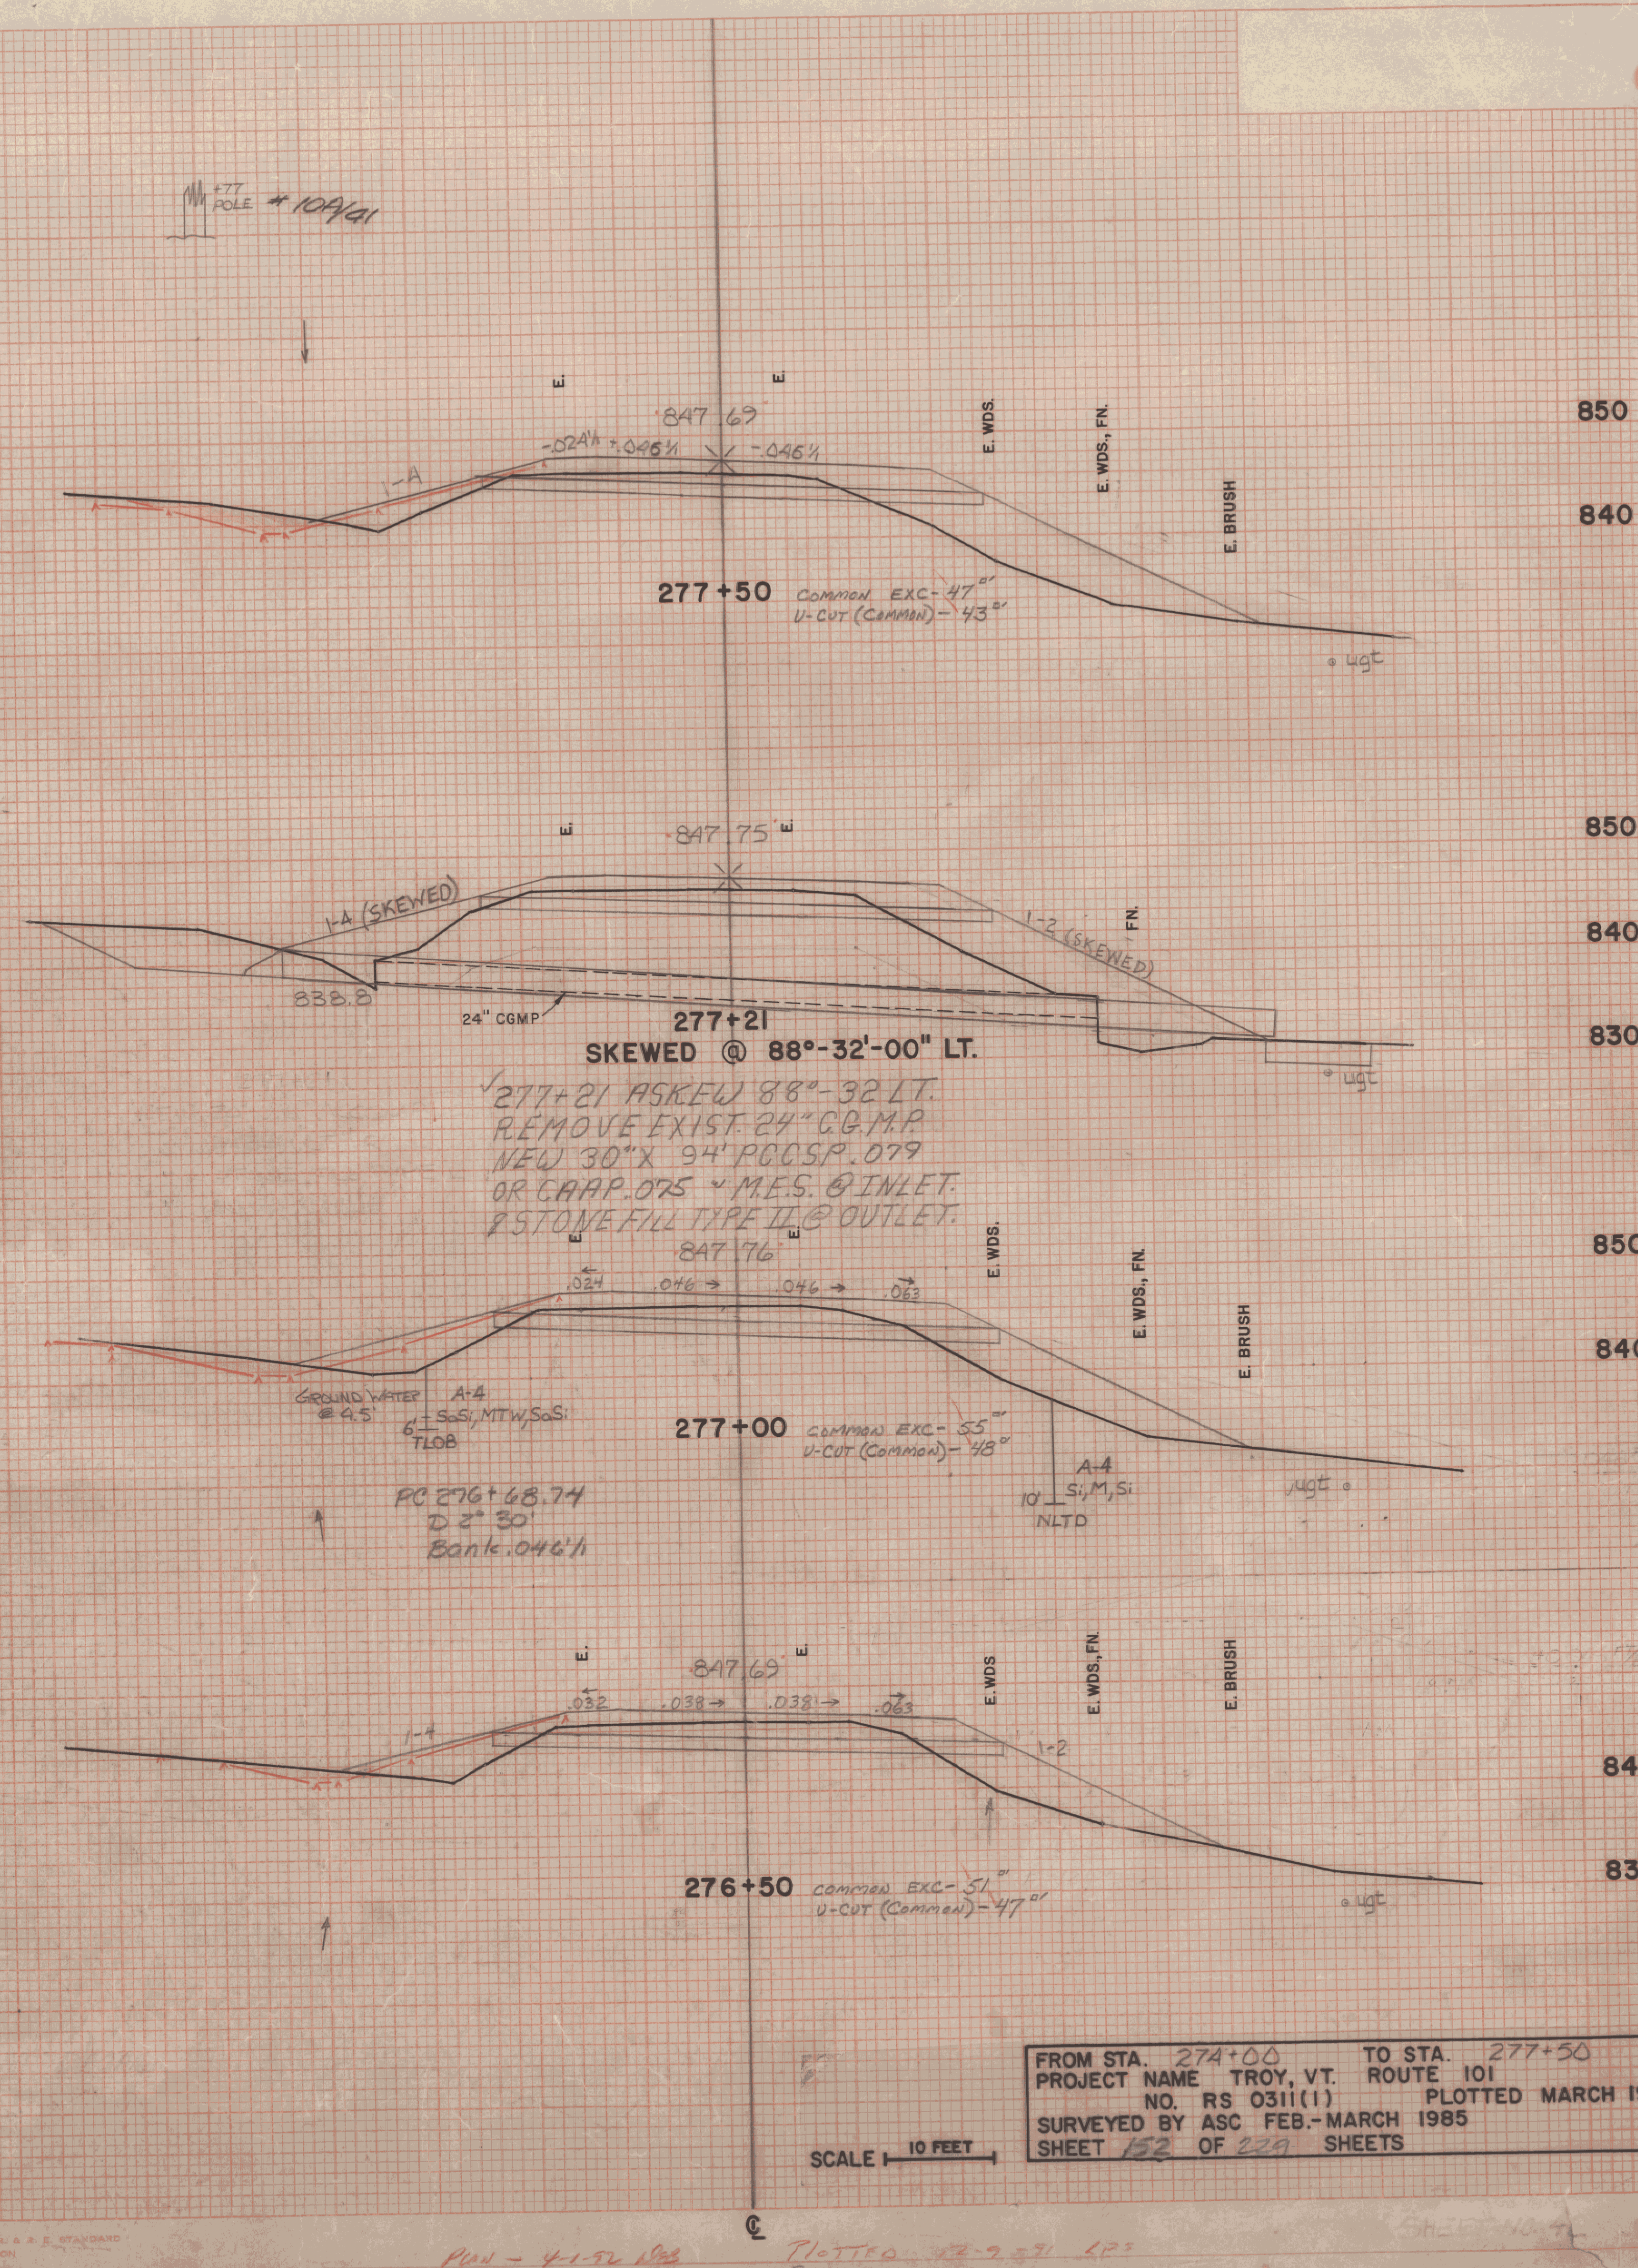

FROM STA. 274+00 TO STA. 277+50
PROJECT NAME TROY, VT. ROUTE 101
NO. RS 0311(1) PLOTTED MARCH 1985
SURVEYED BY ASC FEB.-MARCH 1985
SHEET 152 OF 229 SHEETS

SCALE 1" = 10 FEET

PCW - 4-1-52 1988

PLOTTED 12-9-91 LPS
 PLANIMETERED 1-30-92 LEM

RUGGED TUB 12/98