


FINAL SURVEY NOTE BOOK No.	DATE	BY	SURVEYED	PLATTED	TEMPERATURE	AREAS CHECKED

ORIGINAL SURVEY NOTE BOOK No.	DATE	BY	SURVEYED	PLATTED	TEMPERATURE	AREAS CHECKED

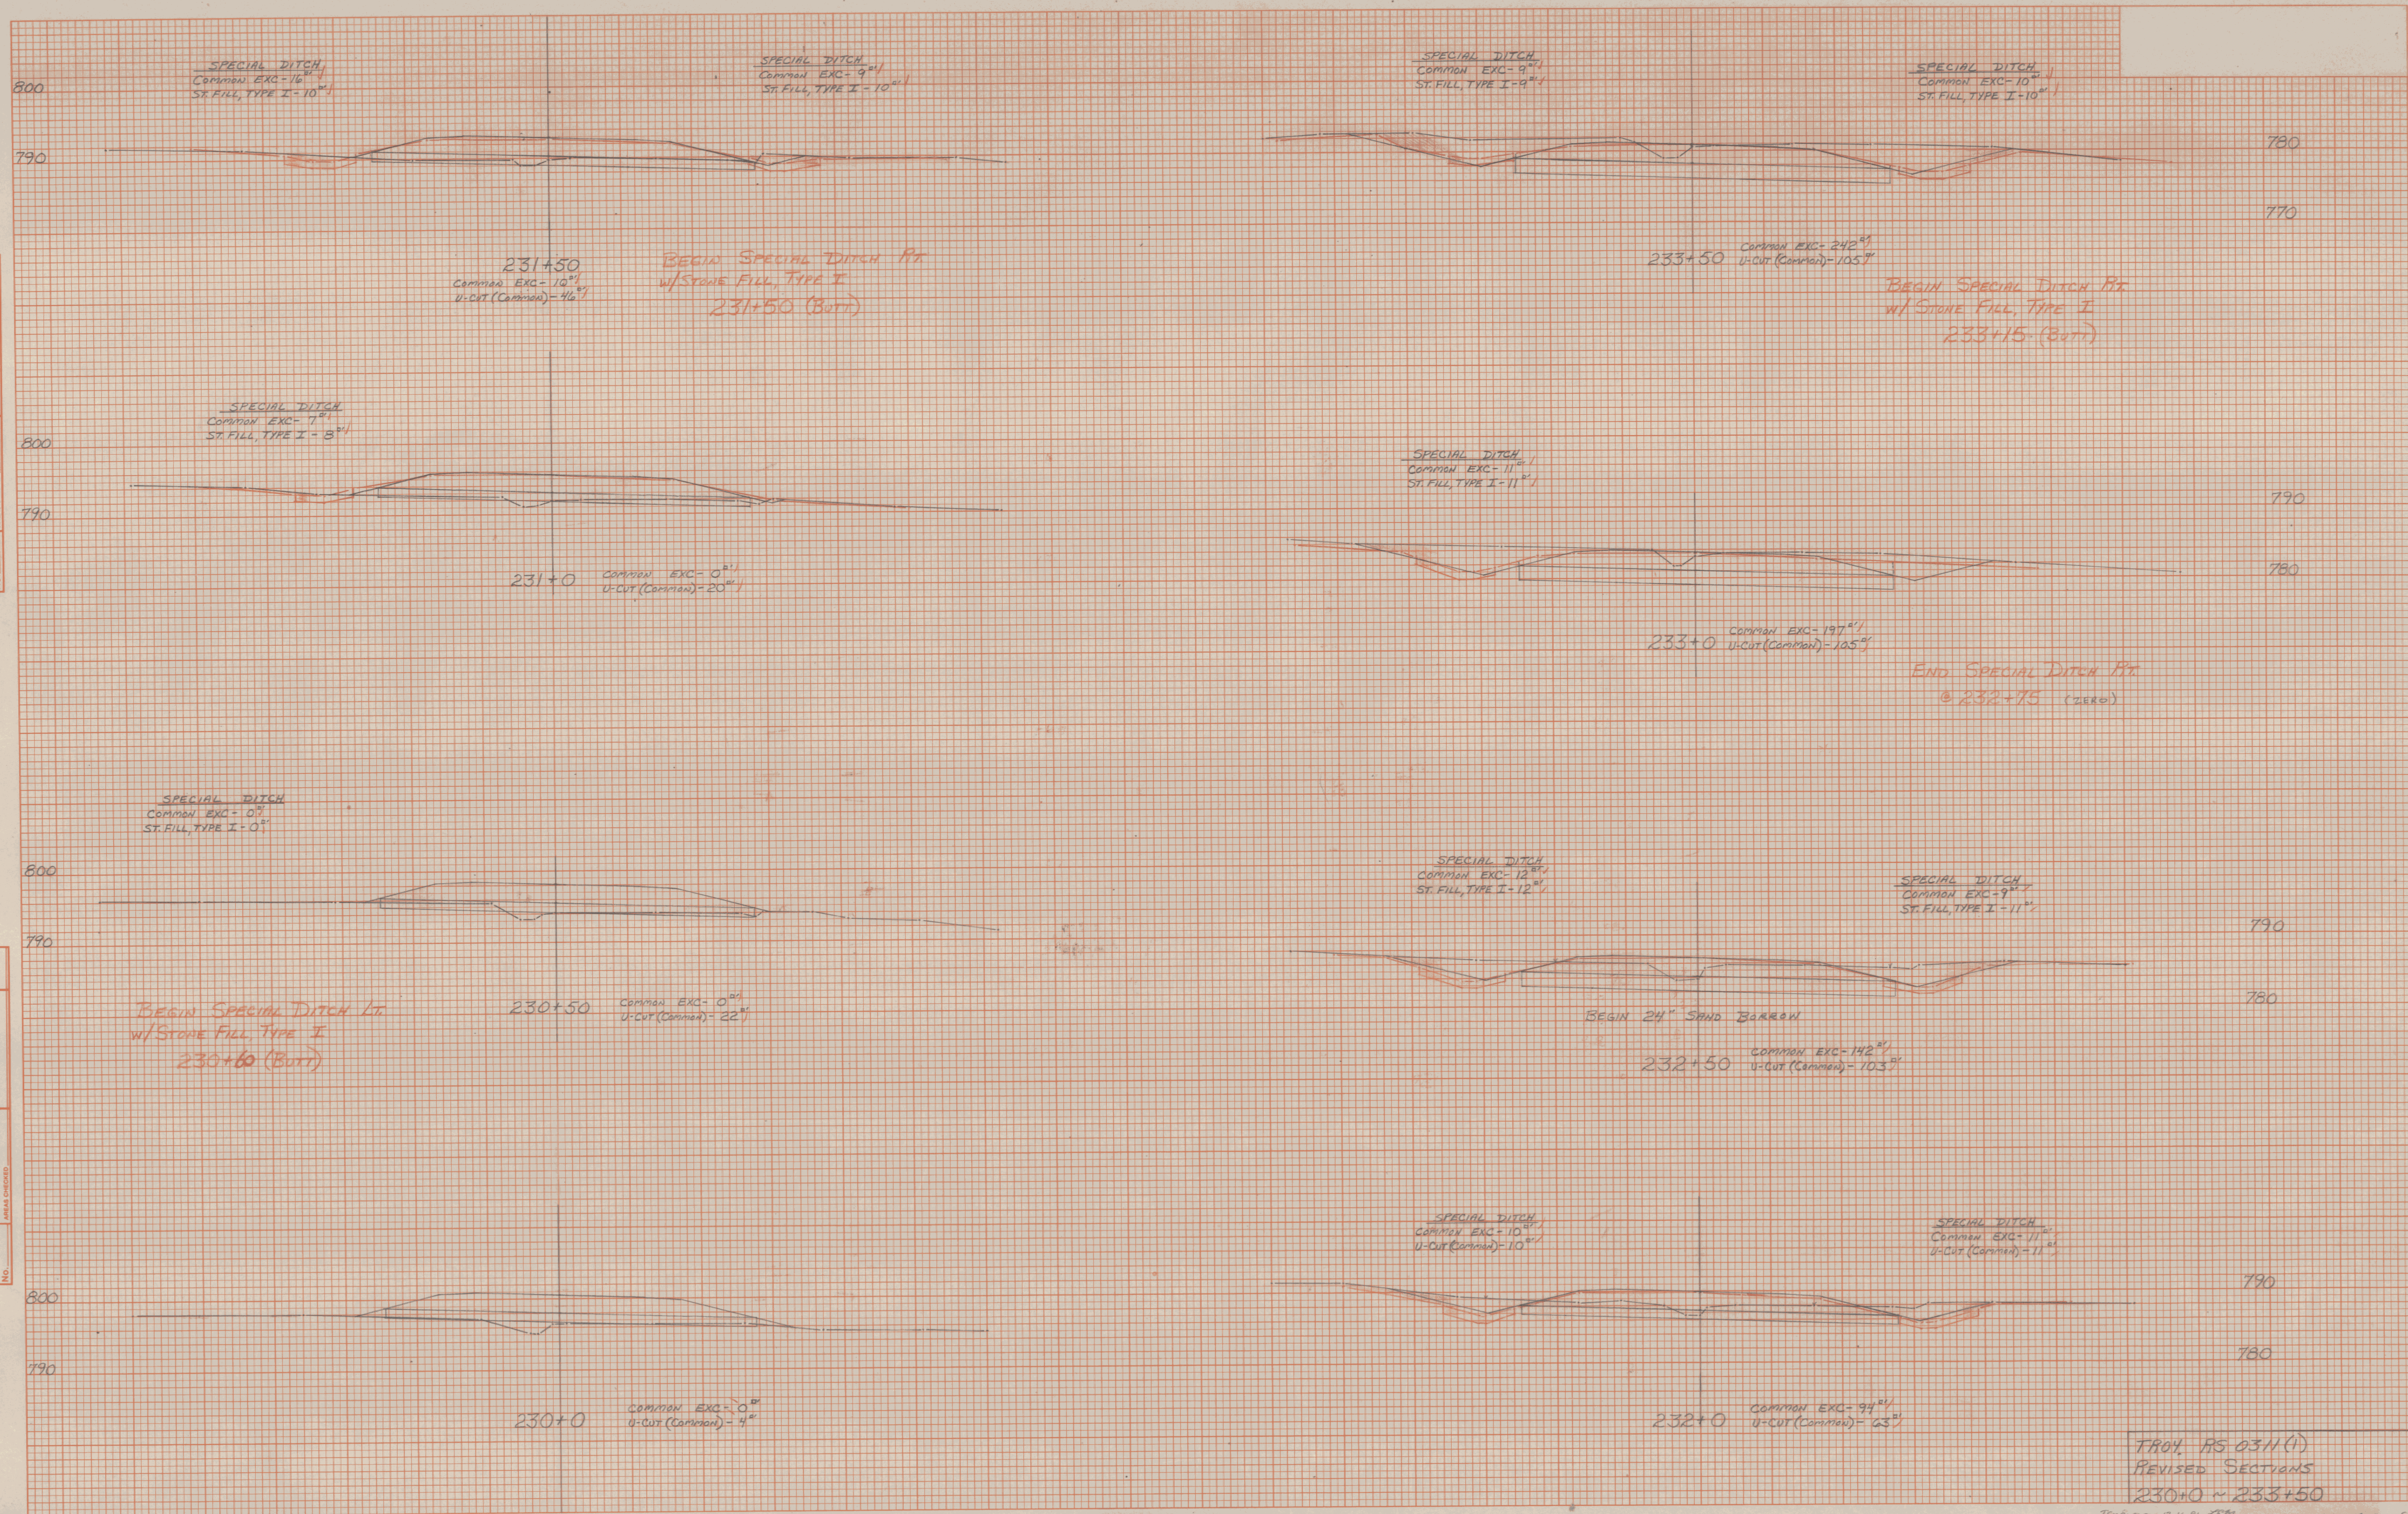

TRON. RS 0311(1)
 REVISED SECTIONS
 230+0 ~ 233+50