


ORIGINAL SURVEY		DATE	
SURVEYED	BY		
PLOTTED			
TEMPLATE			
AREAS			
AREAS CHECKED			

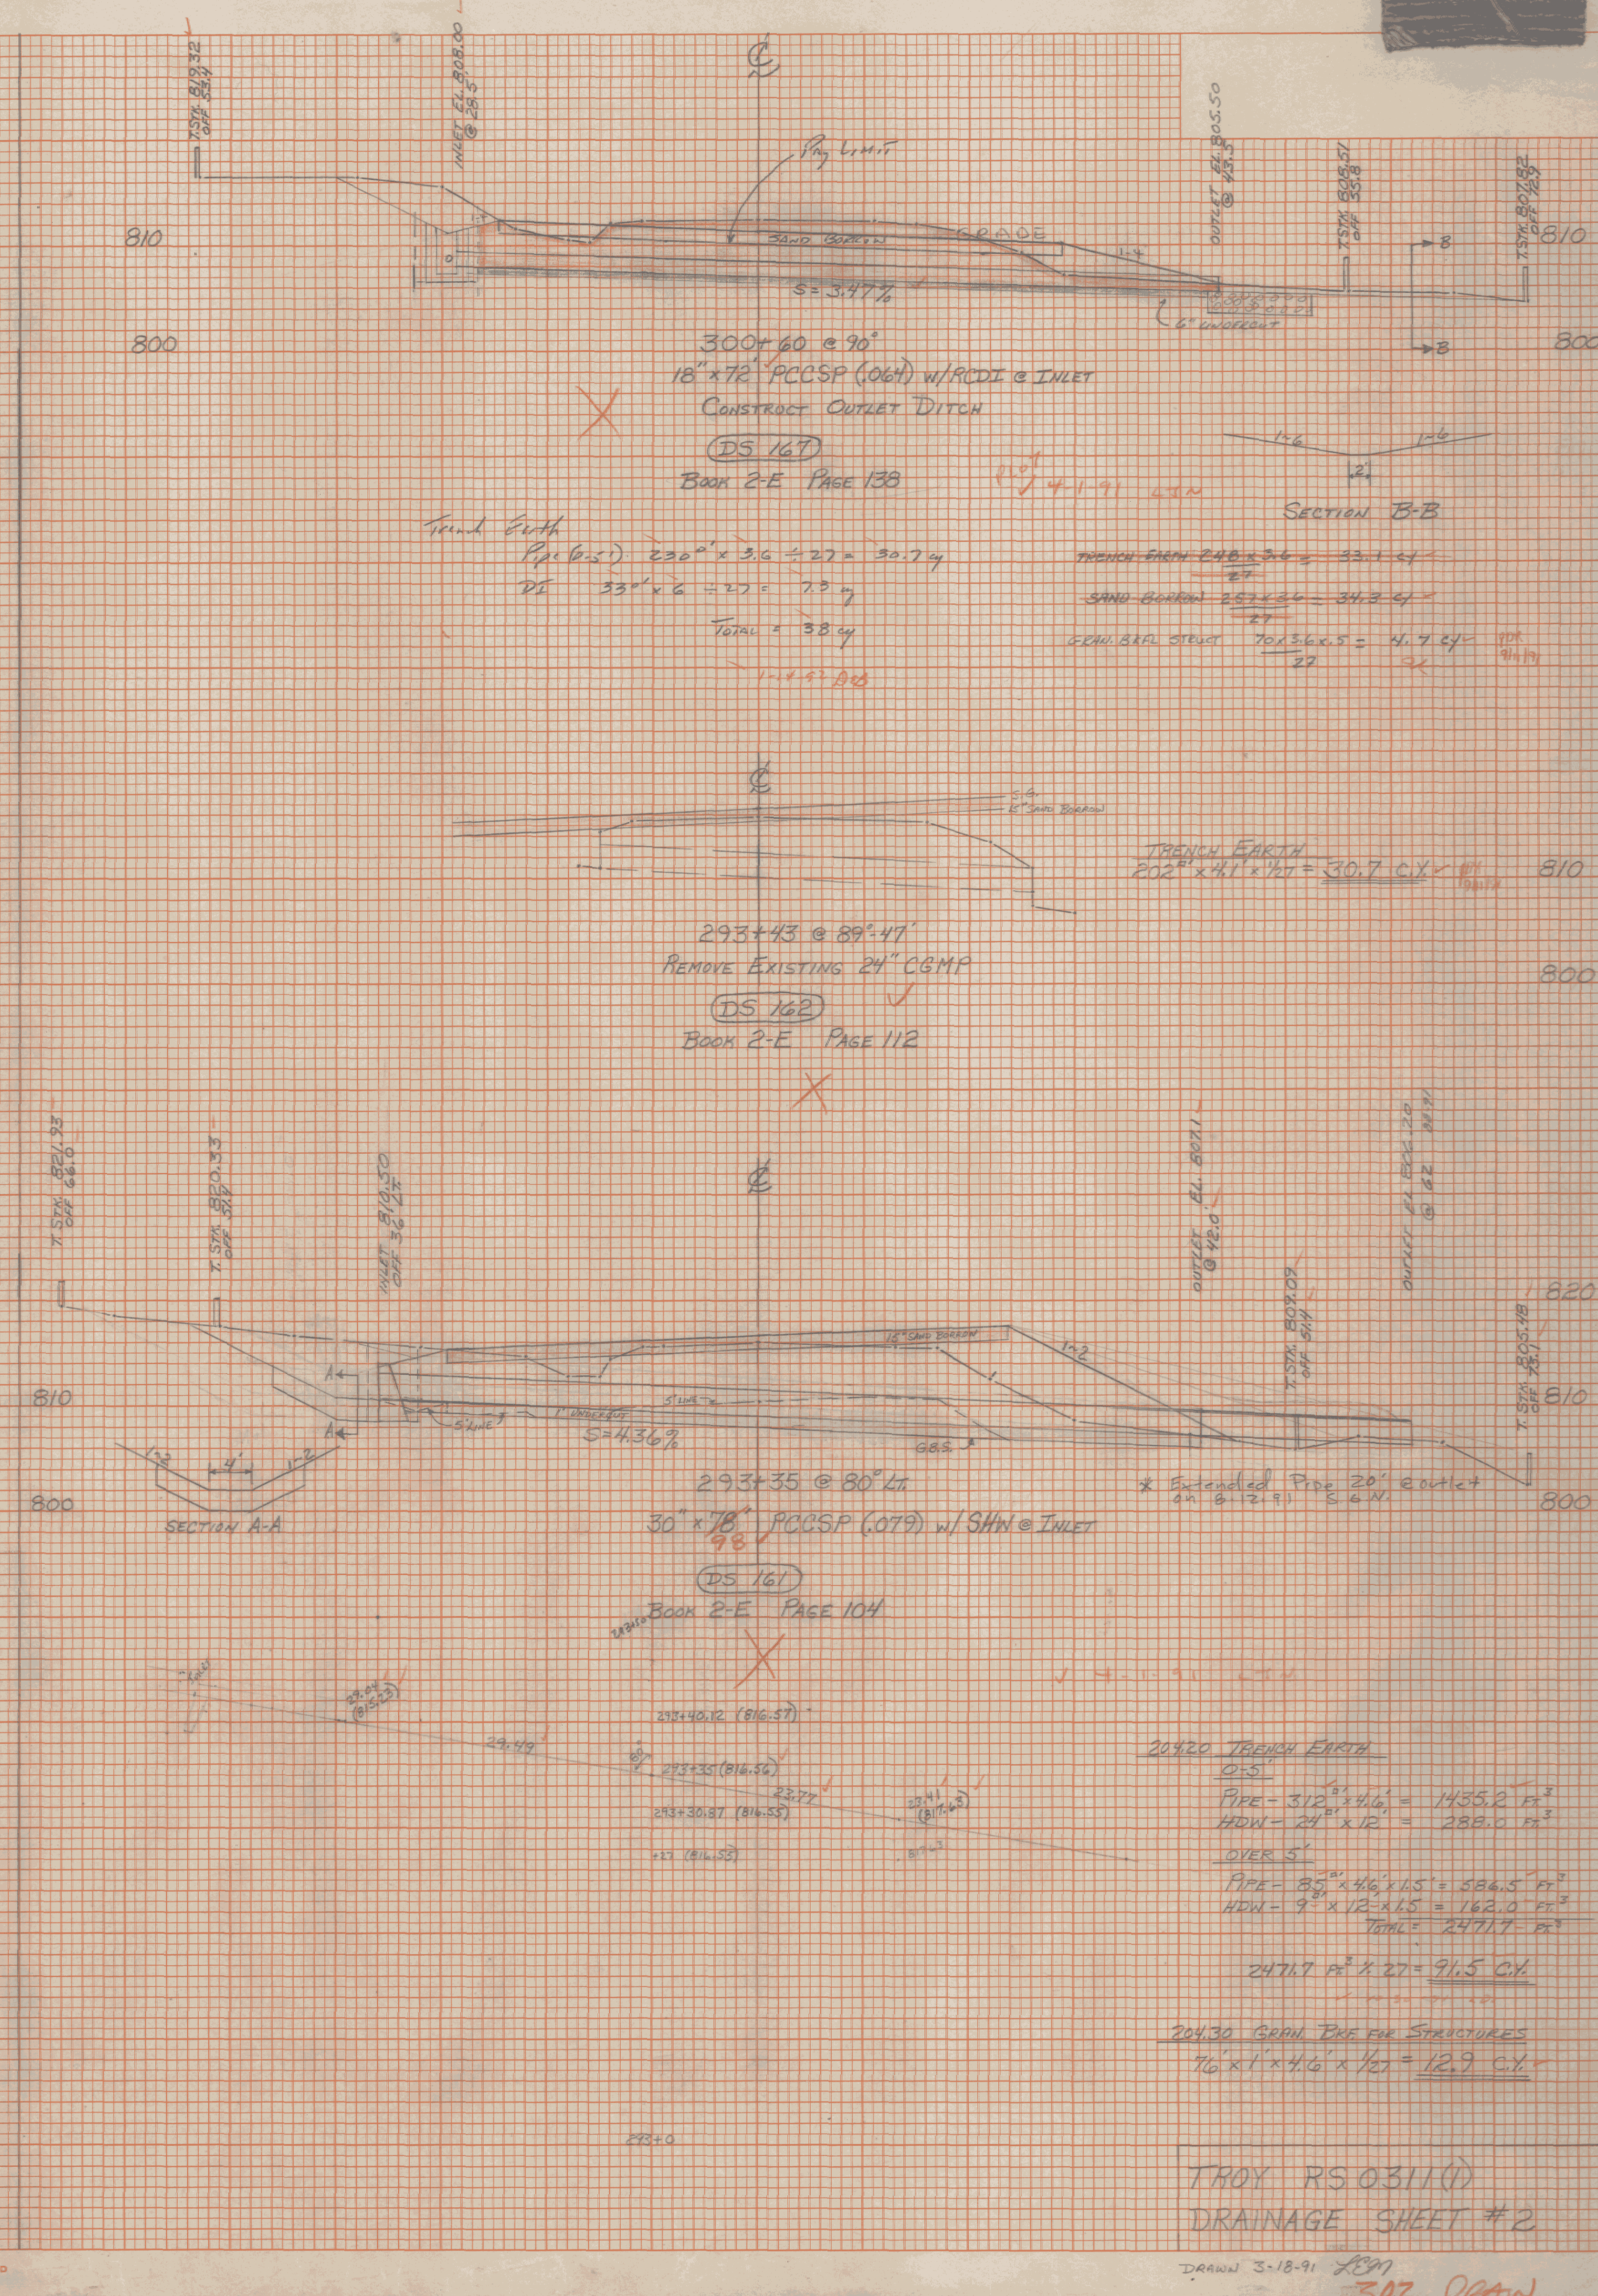

TROY RS 0311(1)
DRAINAGE SHEET #2
DRAWN 3-18-91 *LM*
302 DRAIN