




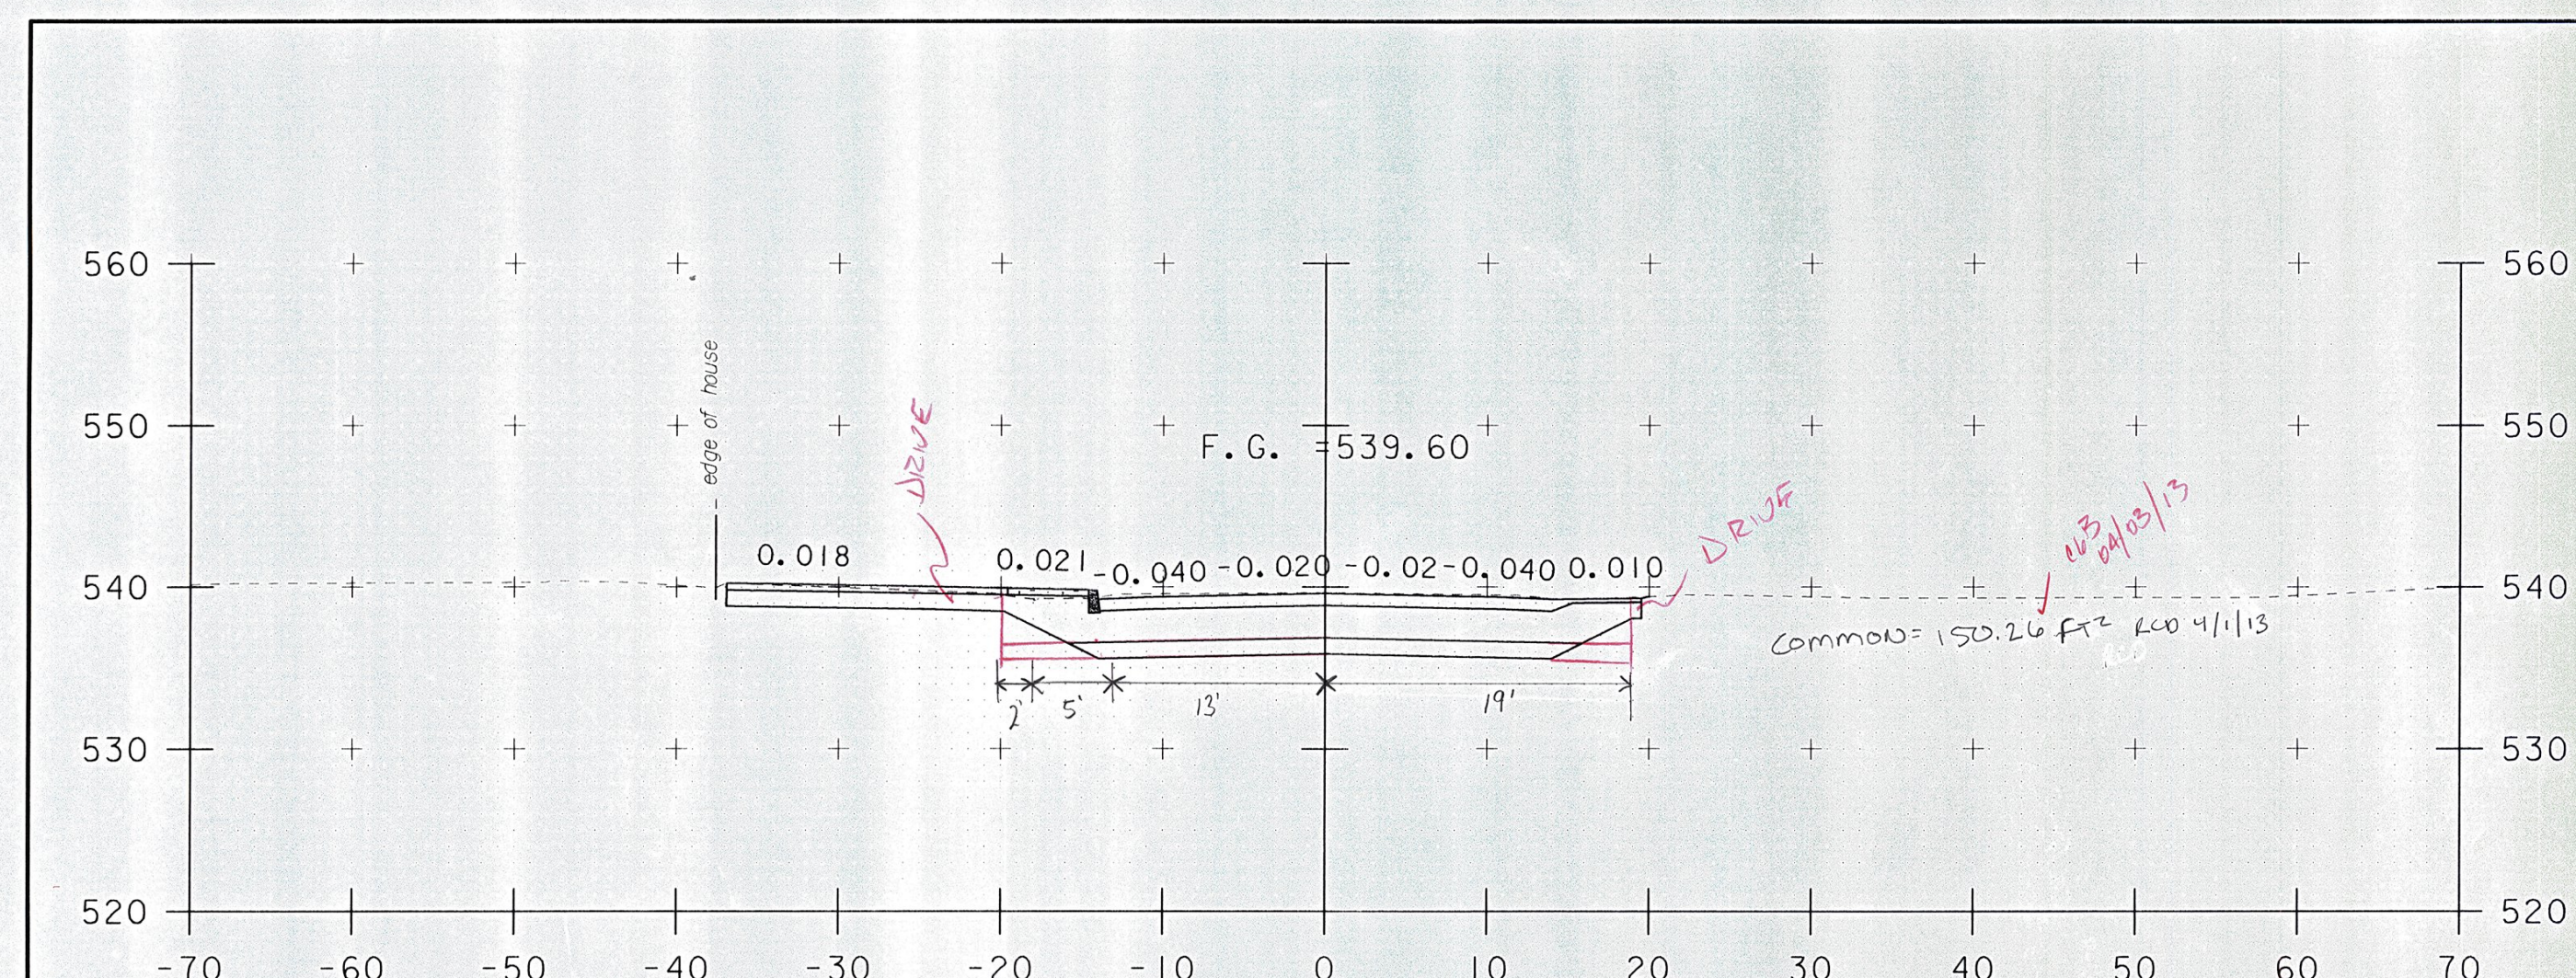

122+25
BEGIN PROJECT/END APPROACH 122+34.00


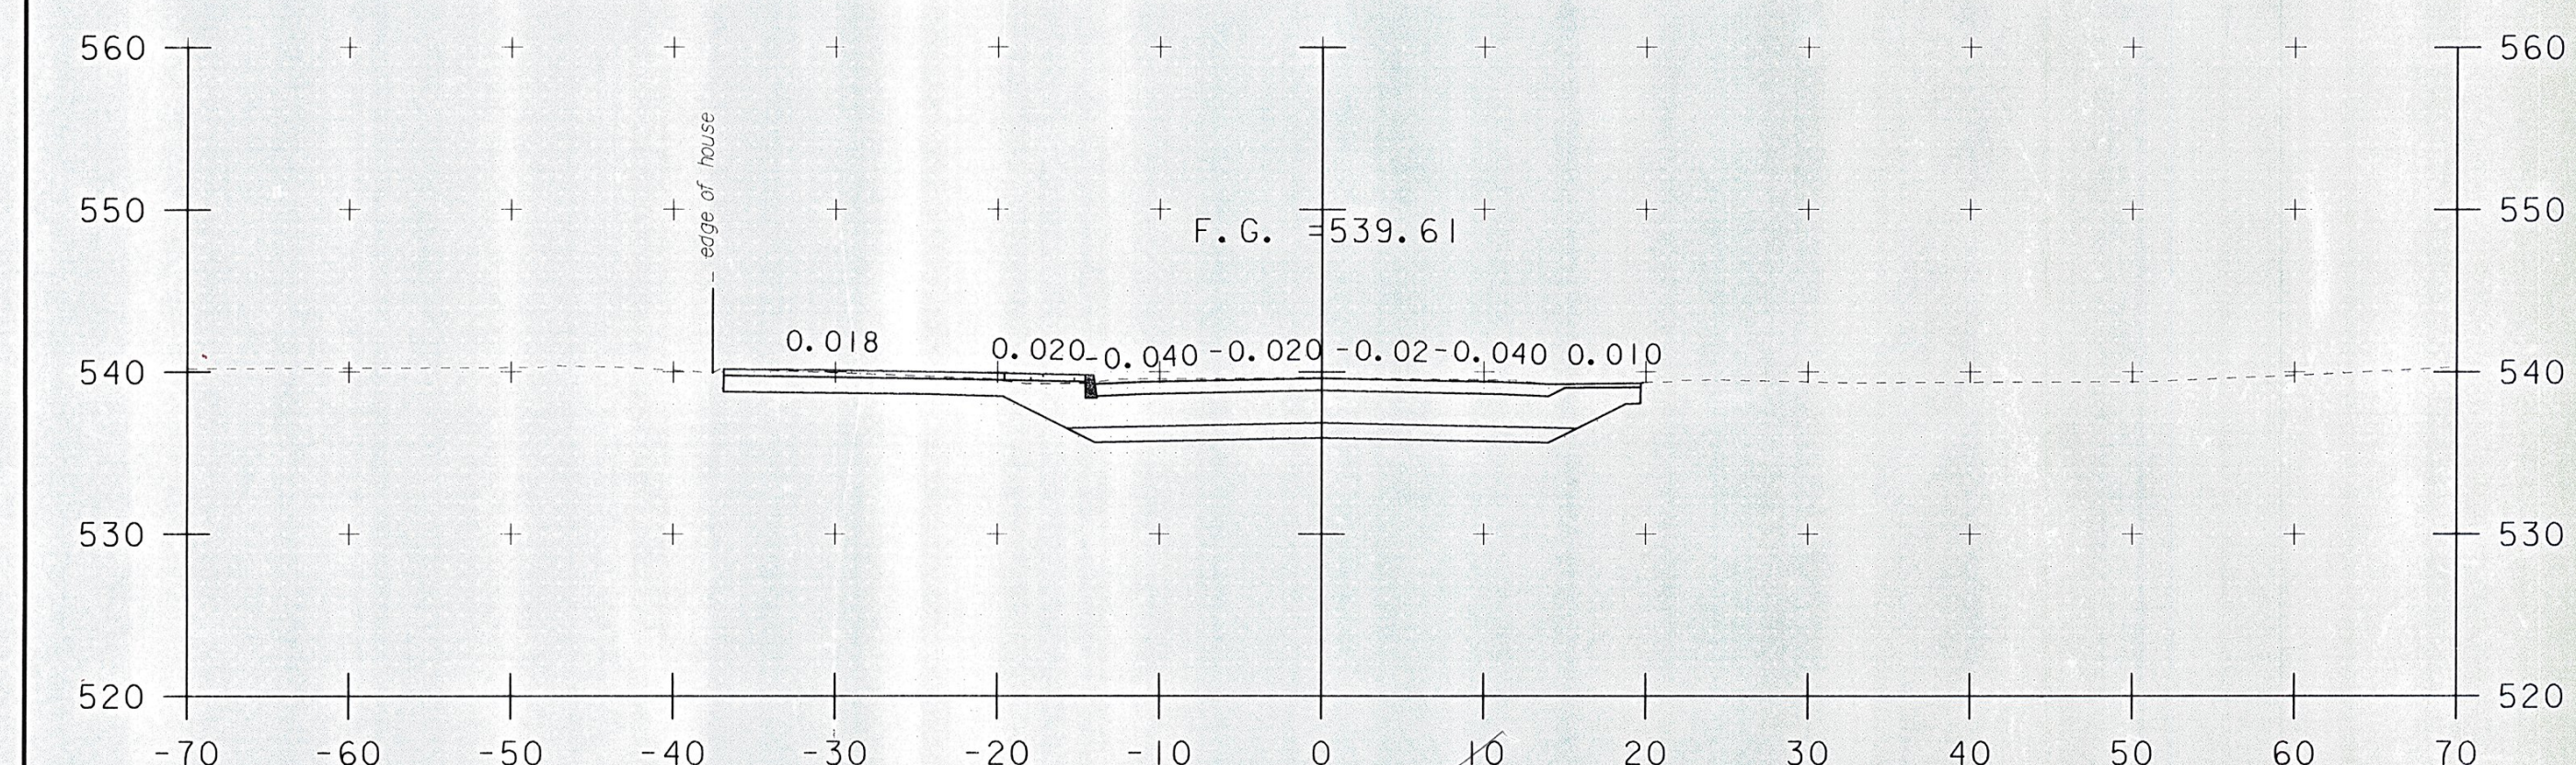


122+24
Q OF WALKWAY TO HOUSE (LEFT)

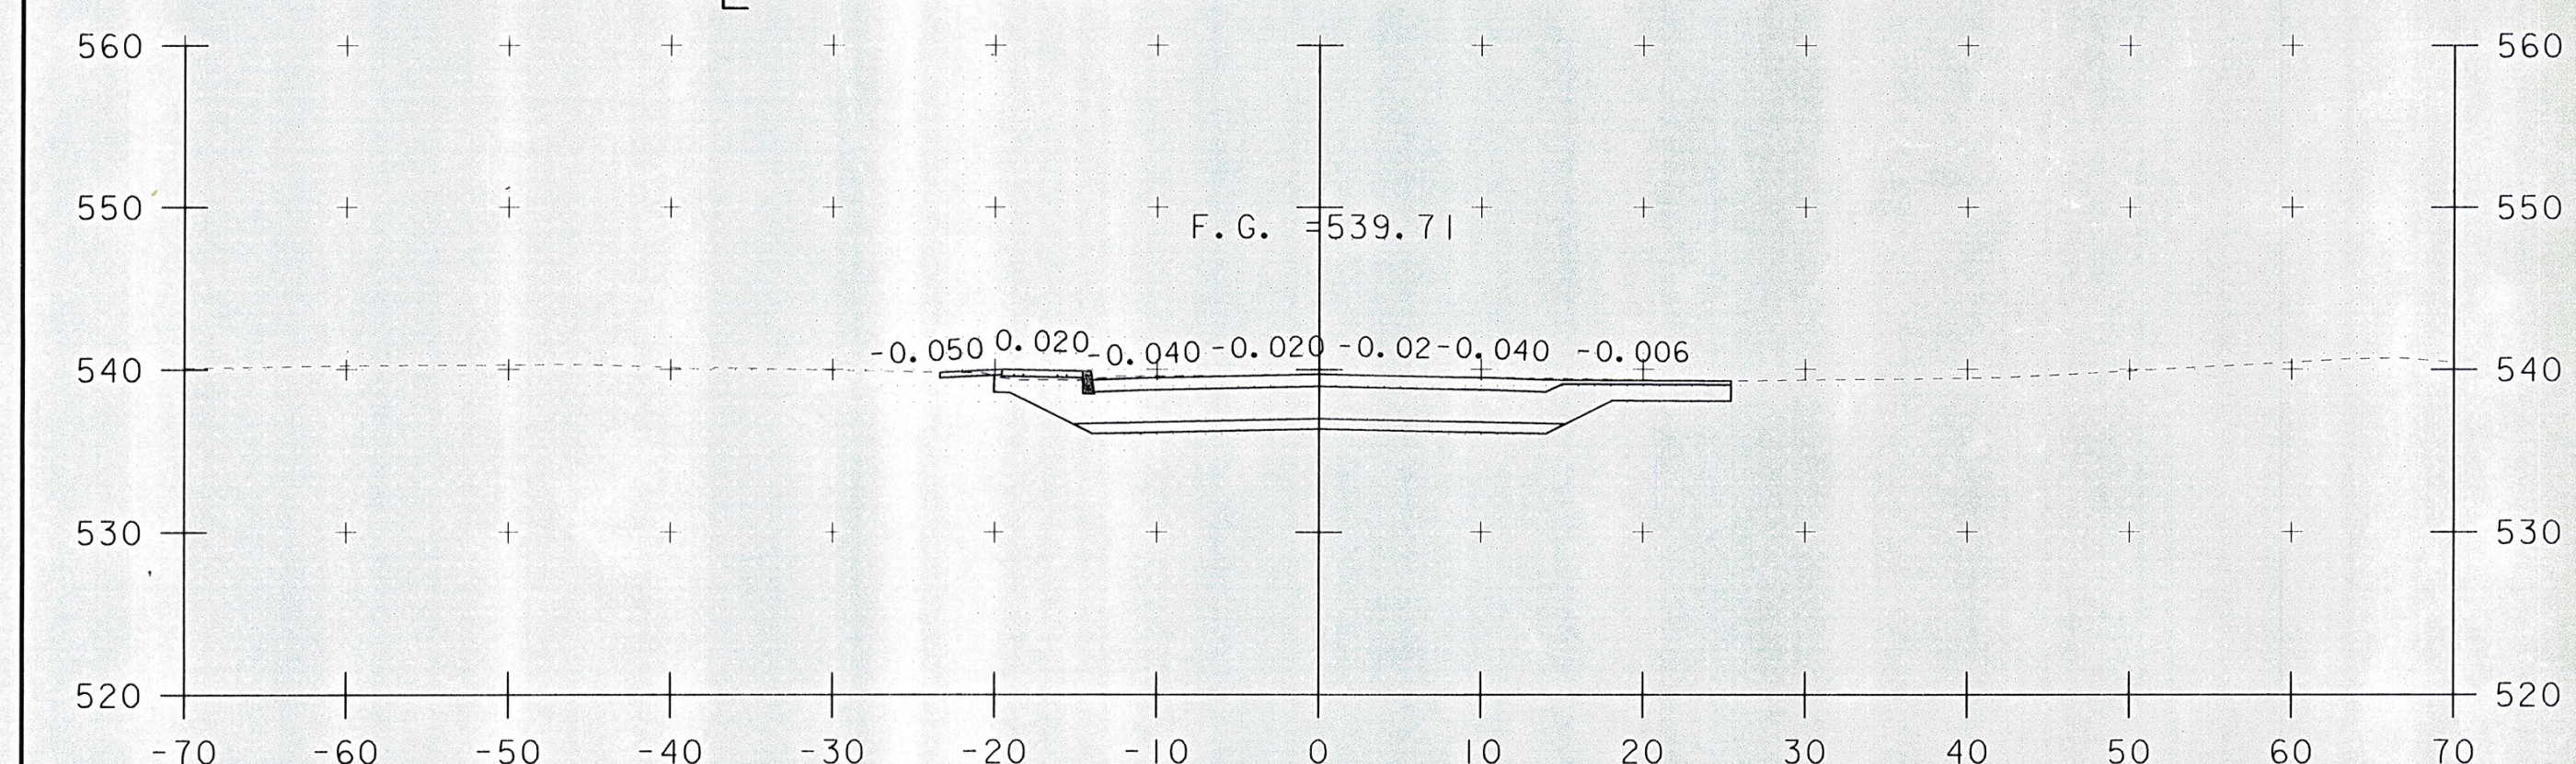


122+16
DRIVE RT


NOTE CB PRECAST CONCRETE CATCH BASIN

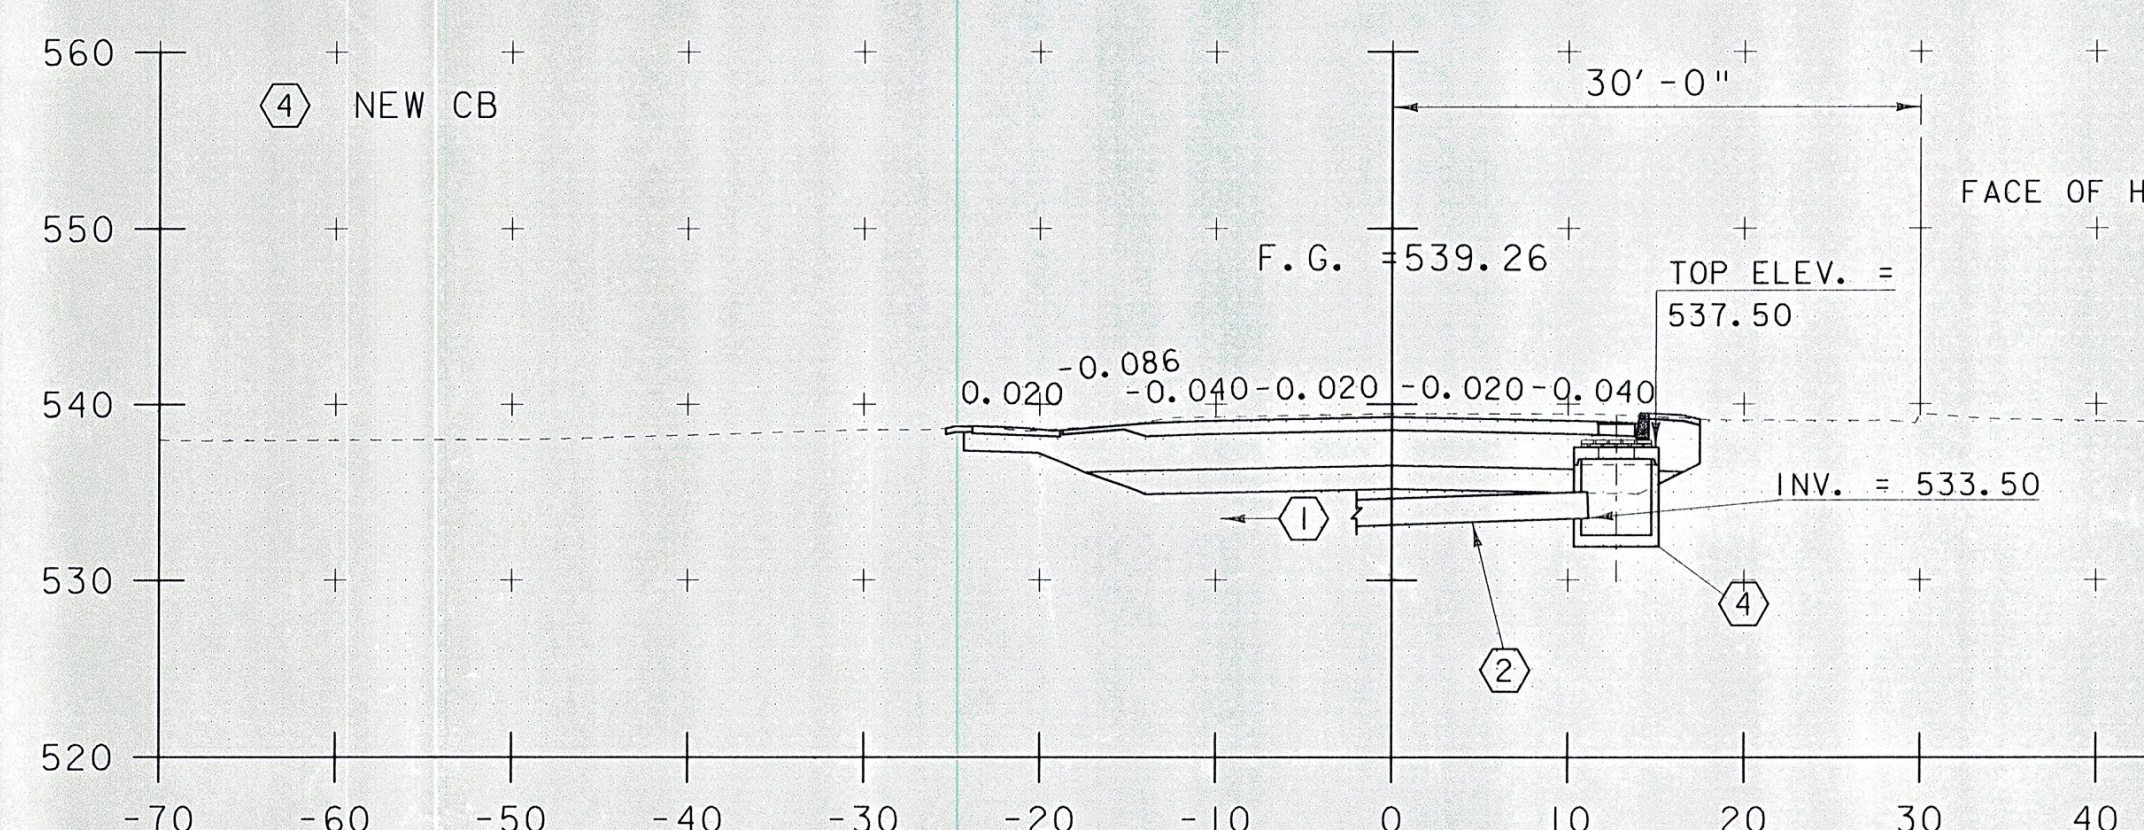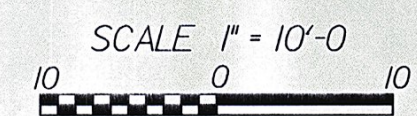

122+67

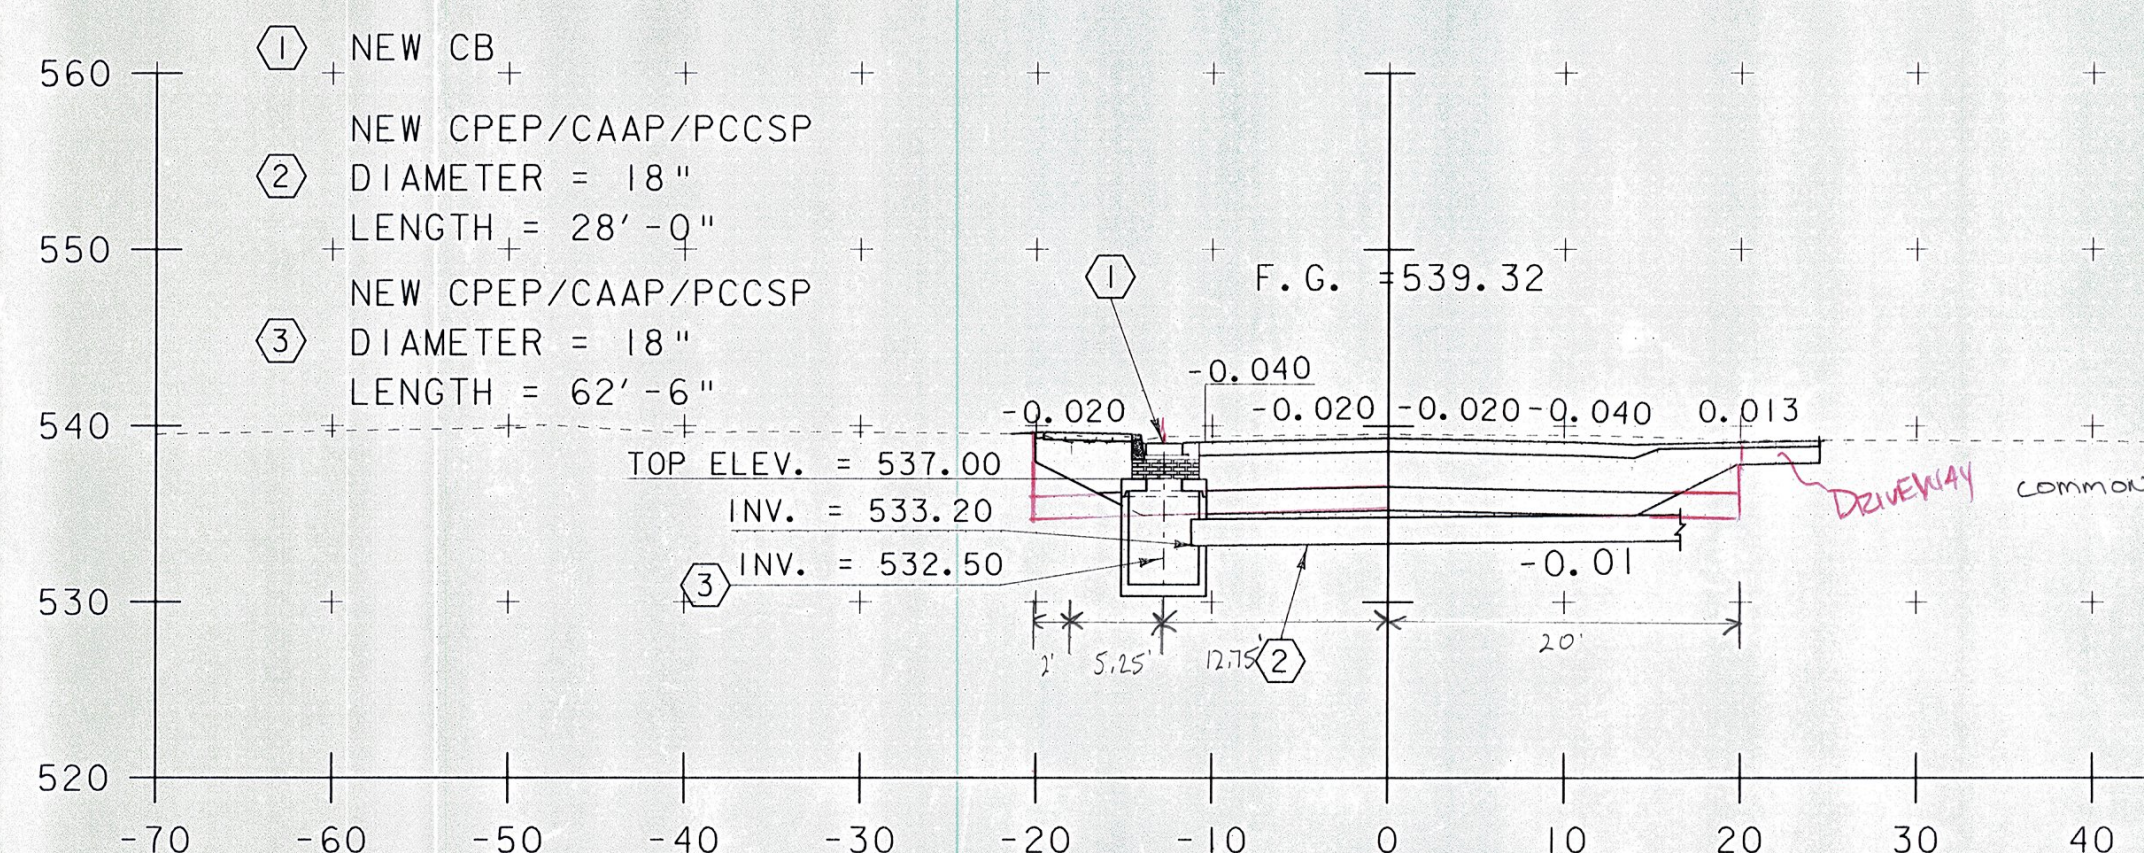

122+50

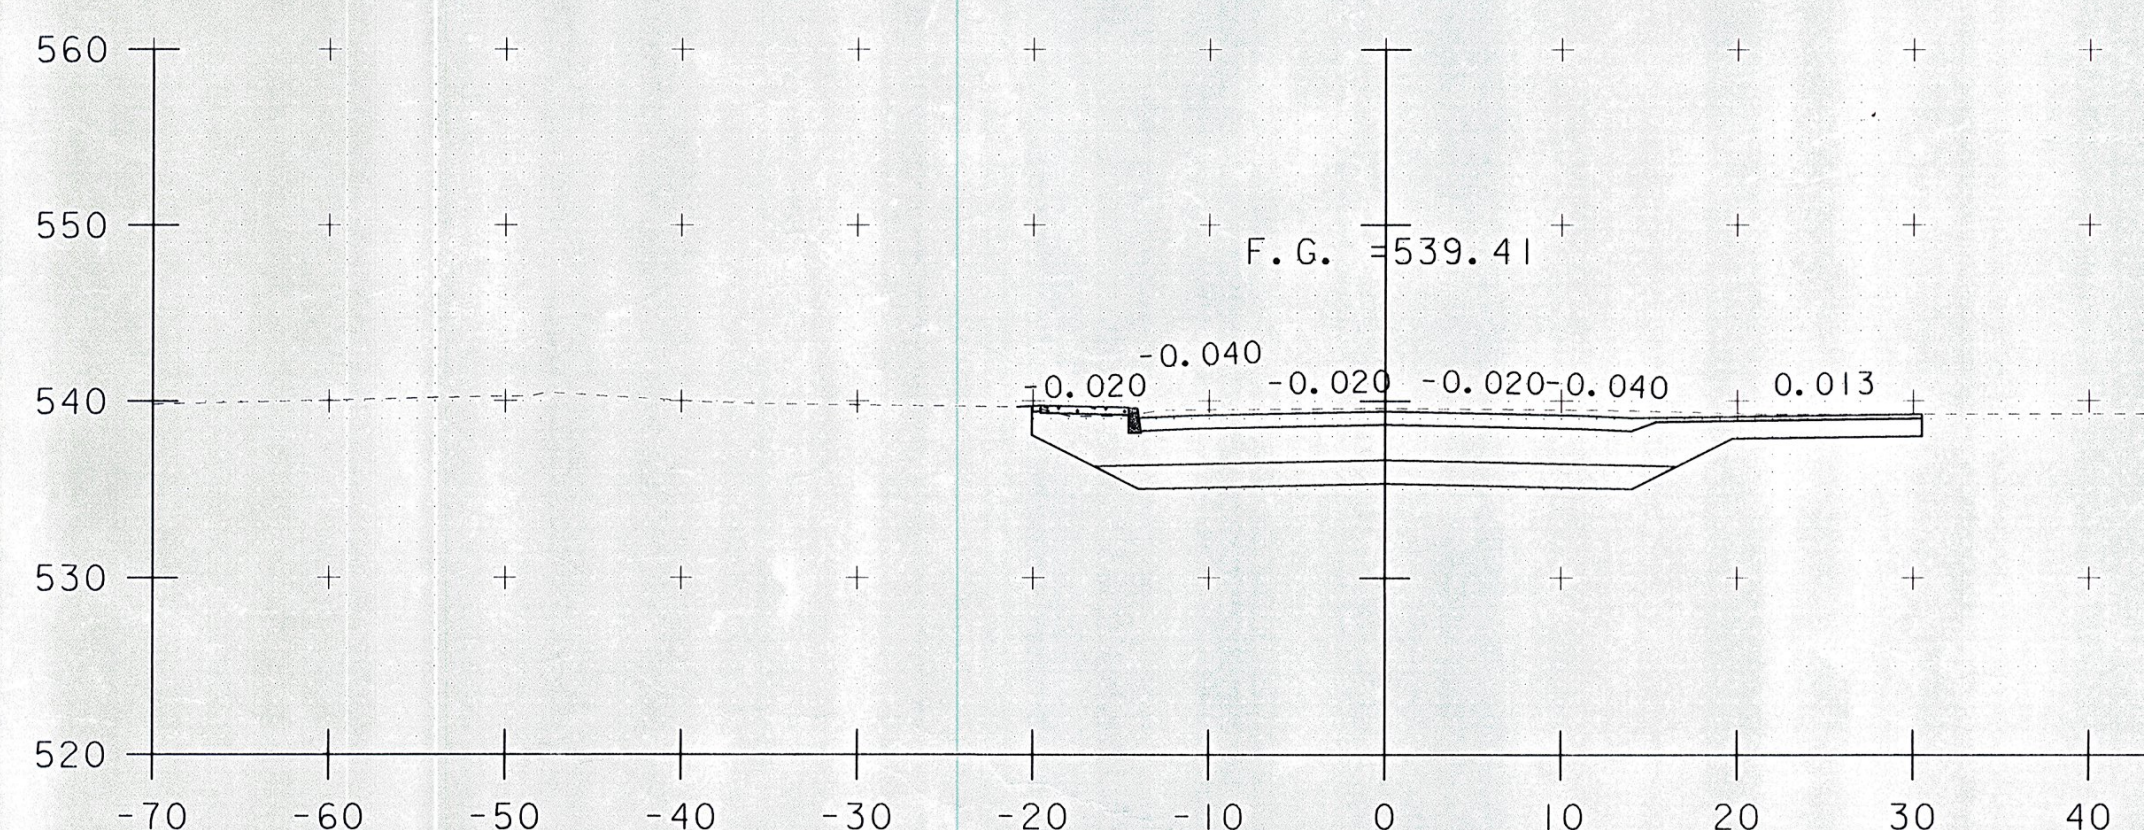

122+40
DRIVE RT

PROJECT NAME: BETHEL
PROJECT NUMBER: BR 022-10
FILE NAME: 78f16\STR\sf161xs.dgn
PROJECT LEADER: M. EVANS-MONGEON
DESIGNED BY: S. SCRIBNER
VT 107 CROSS SECTION SHEET 2

STA. 122+16 TO STA. 122+67

