
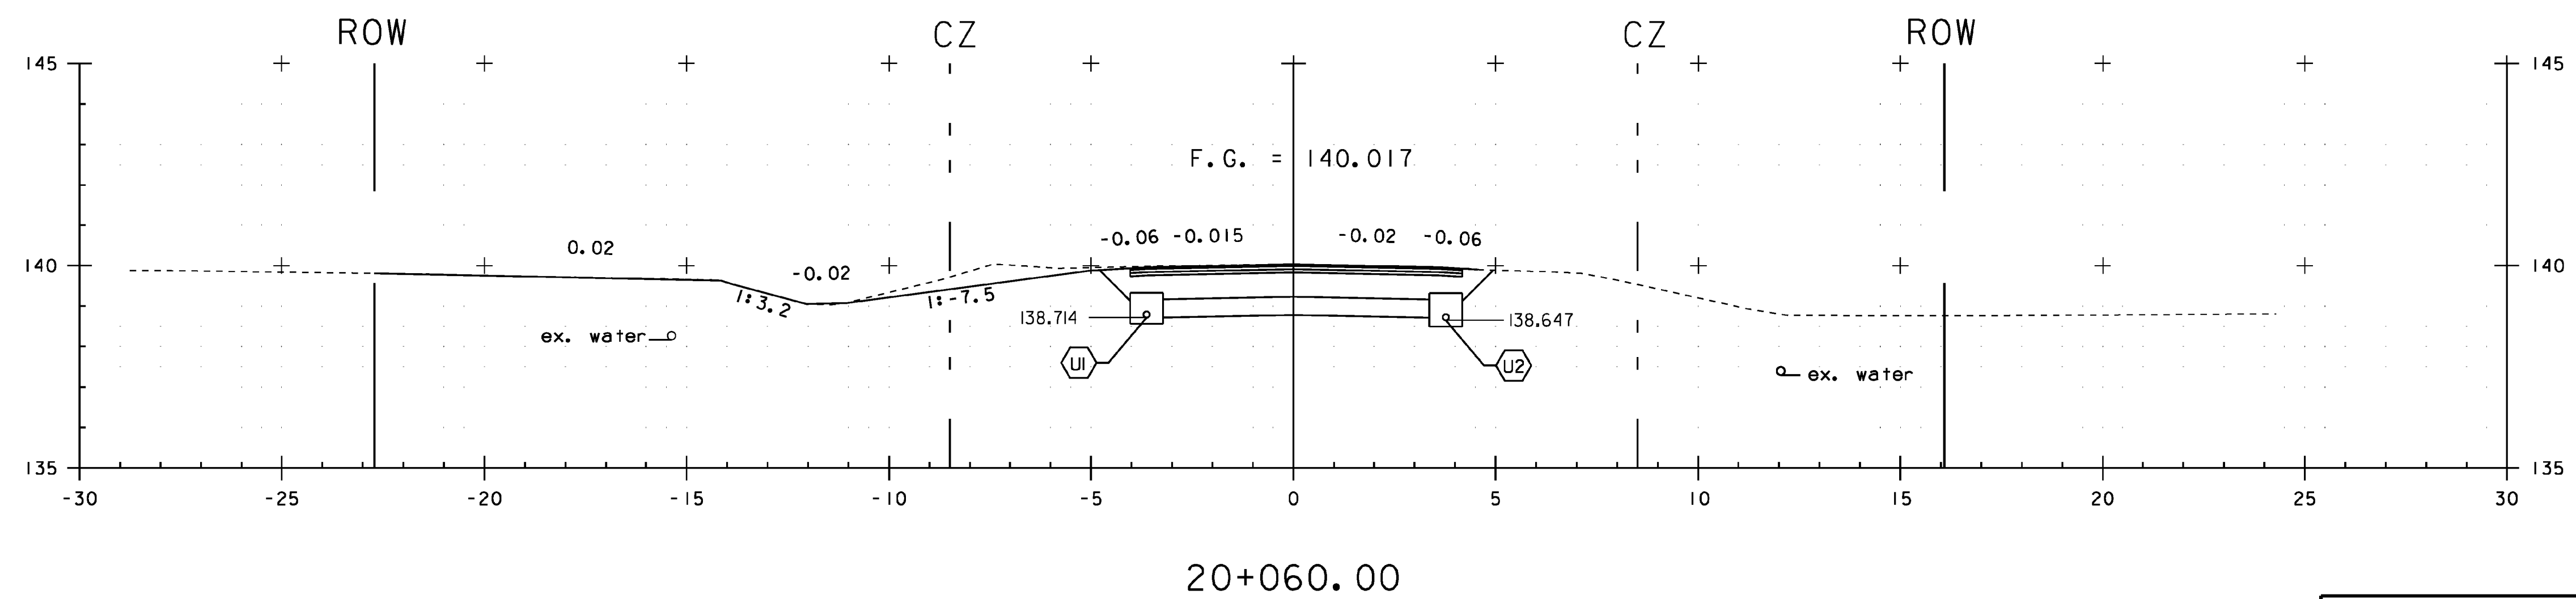


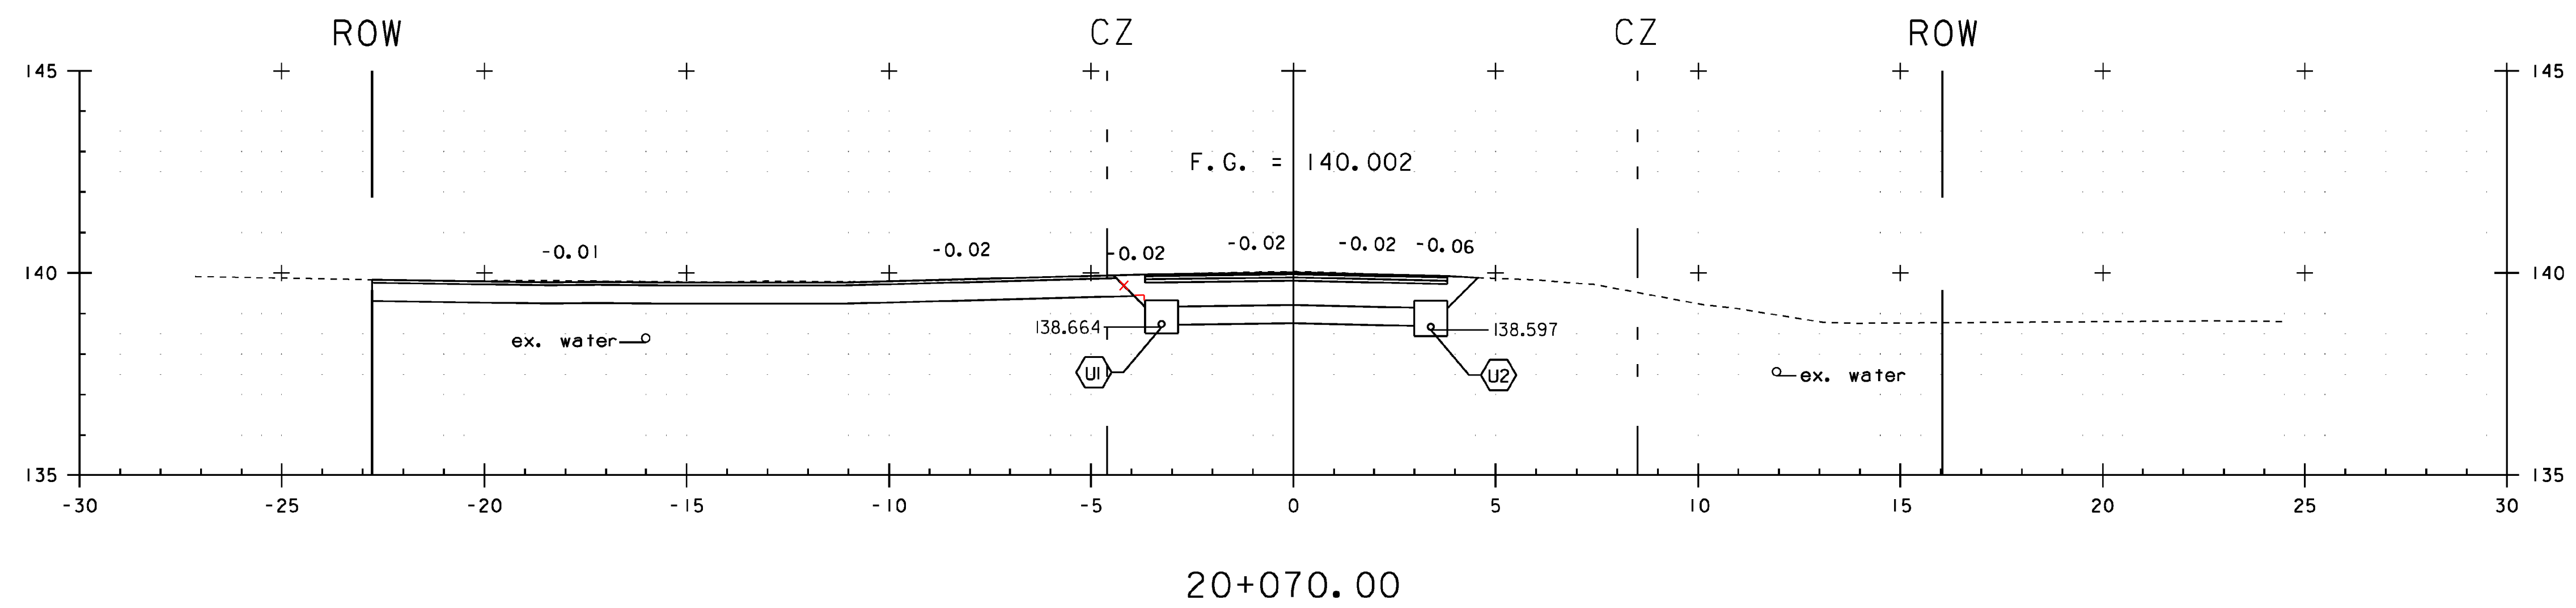

VT ROUTE 15

STA. 20+060 TO STA. 20+070

PROJECT NAME:	CAMBRIDGE
PROJECT NUMBER:	STP 030-2(27)
FILE NAME:	t78f163xsl.dgn
PROJECT LEADER:	JLS
DESIGNED BY:	MBL
CROSS SECTION SHEET 7	
PLOT DATE:	05-JUN-2012
DRAWN BY:	MBL
CHECKED BY:	JAD
SHEET	88 OF 214