

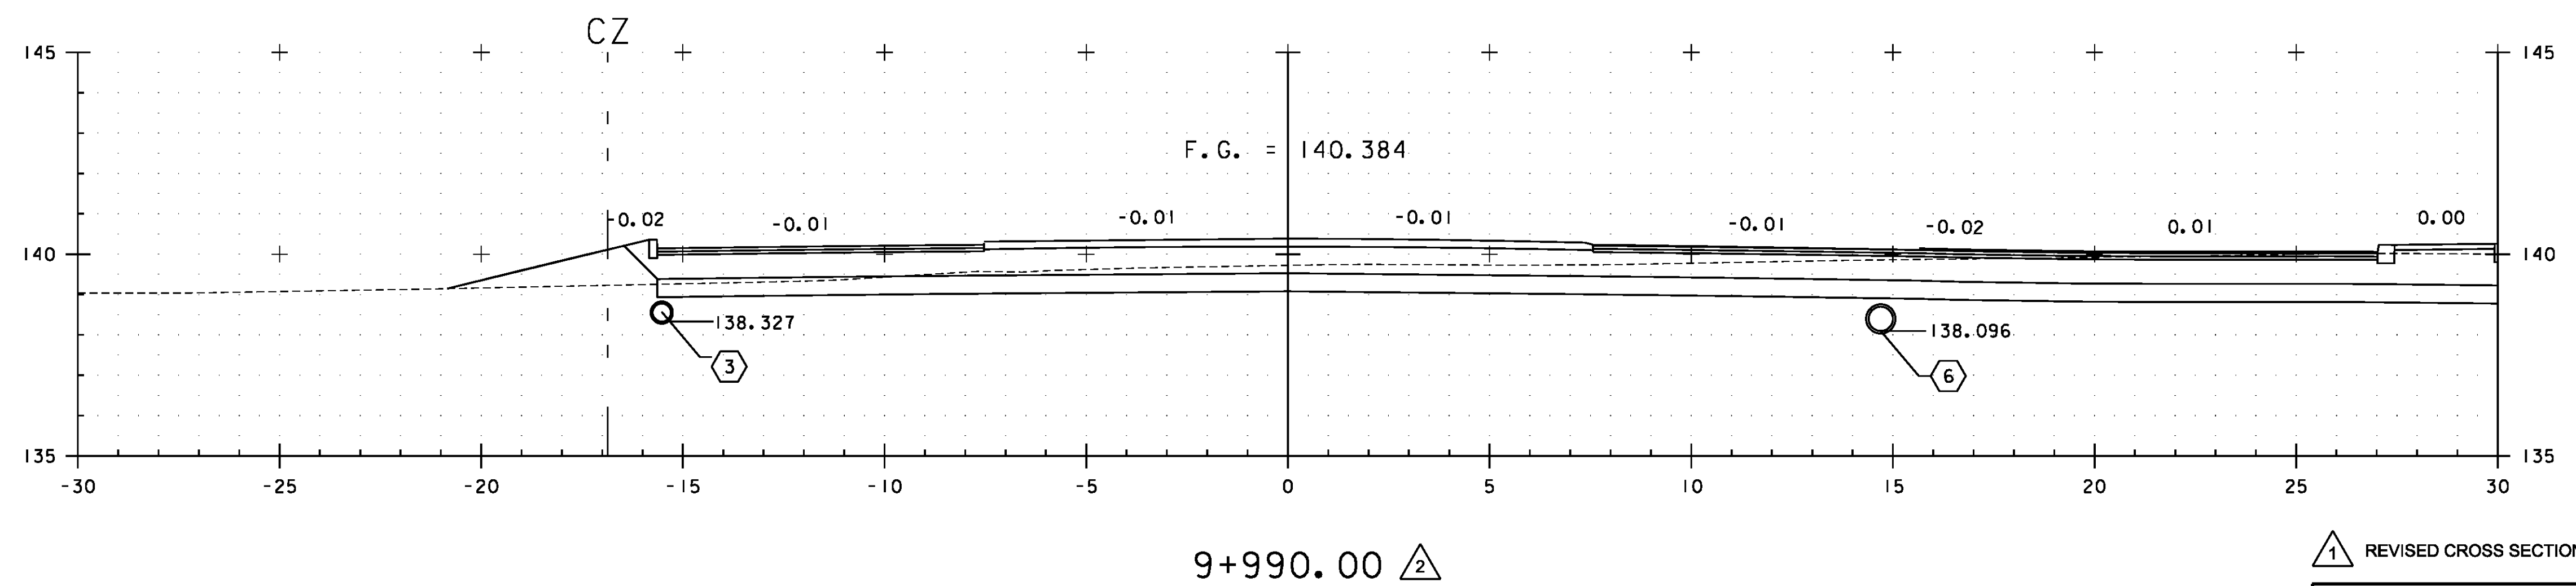


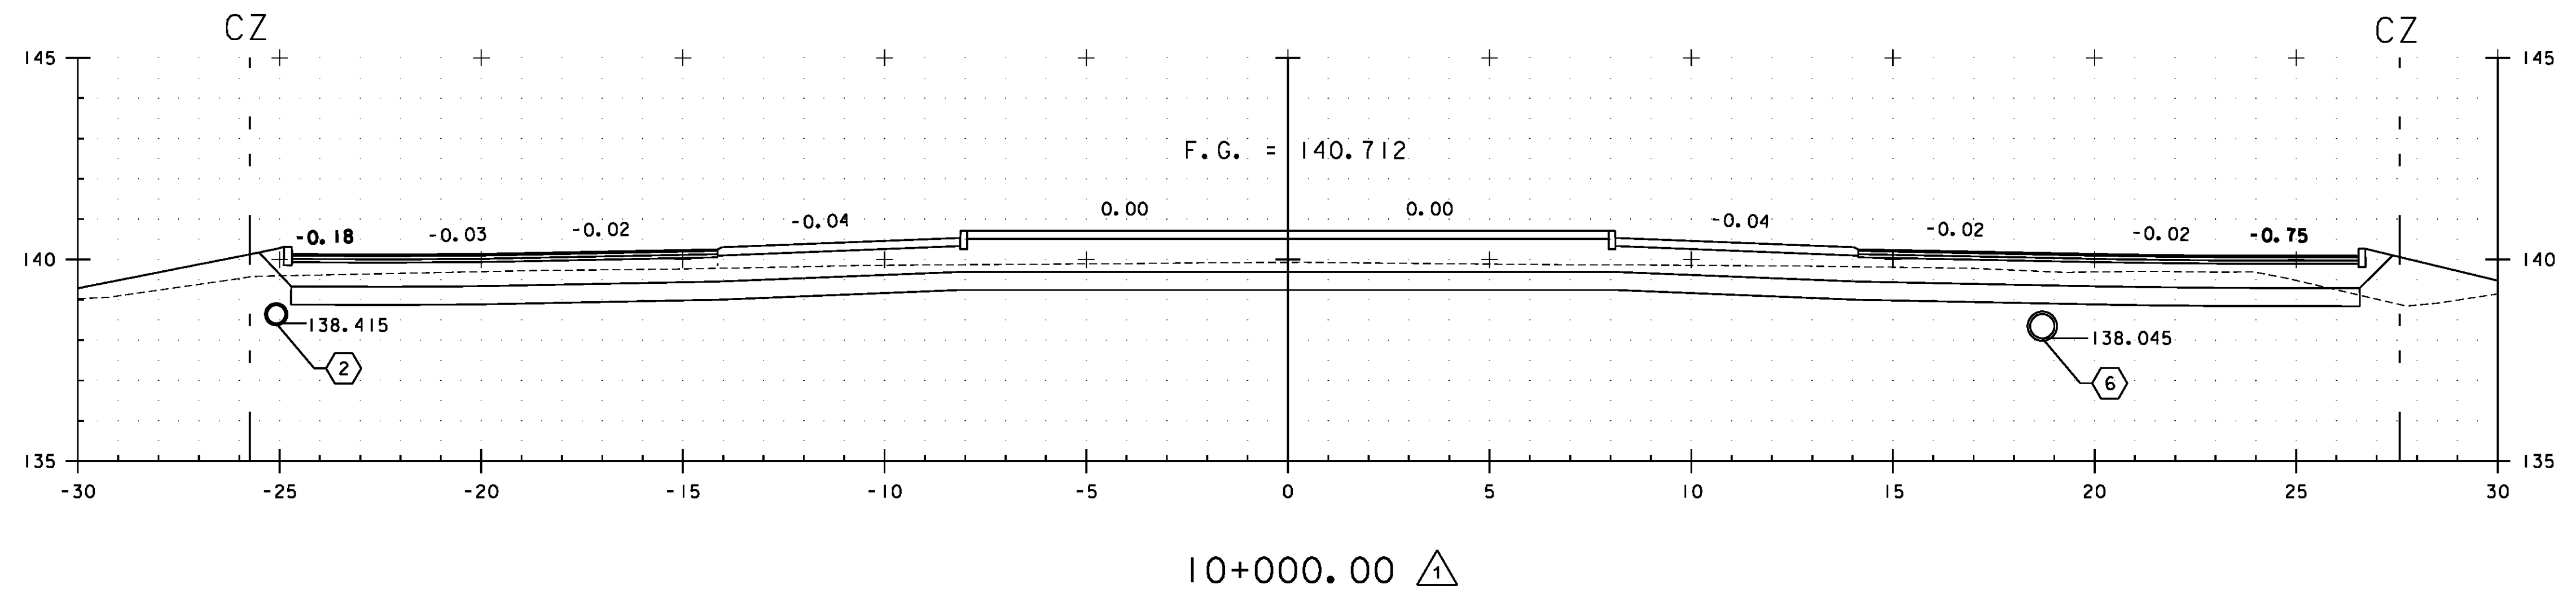

REVISED CROSS SECTIONS		VT ROUTE 108	
PROJECT NAME: CAMBRIDGE		PROJECT NUMBER: STP 030-2(27)	
FILE NAME: t78f163xsl.dgn		PLOT DATE: 4/22/13	
PROJECT LEADER: JLS		DRAWN BY: MBL	
DESIGNED BY: MBL		CHECKED BY: JAD	
CROSS SECTION SHEET 35 - REVISED		SHEET 116 OF 214	

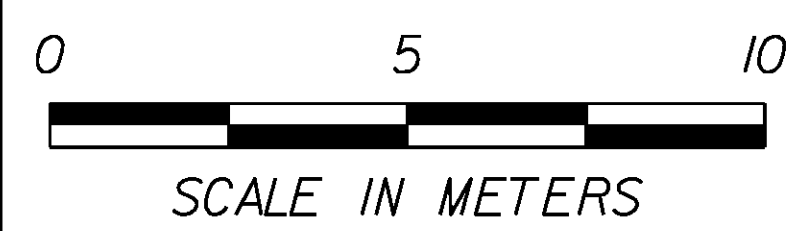

REVISED 10+000 FINISH GRADE AND SUBGRADE

REVISED 9+990 FINISH GRADE AND SUBGRADE

STA. 9+990 TO STA. 10+000