




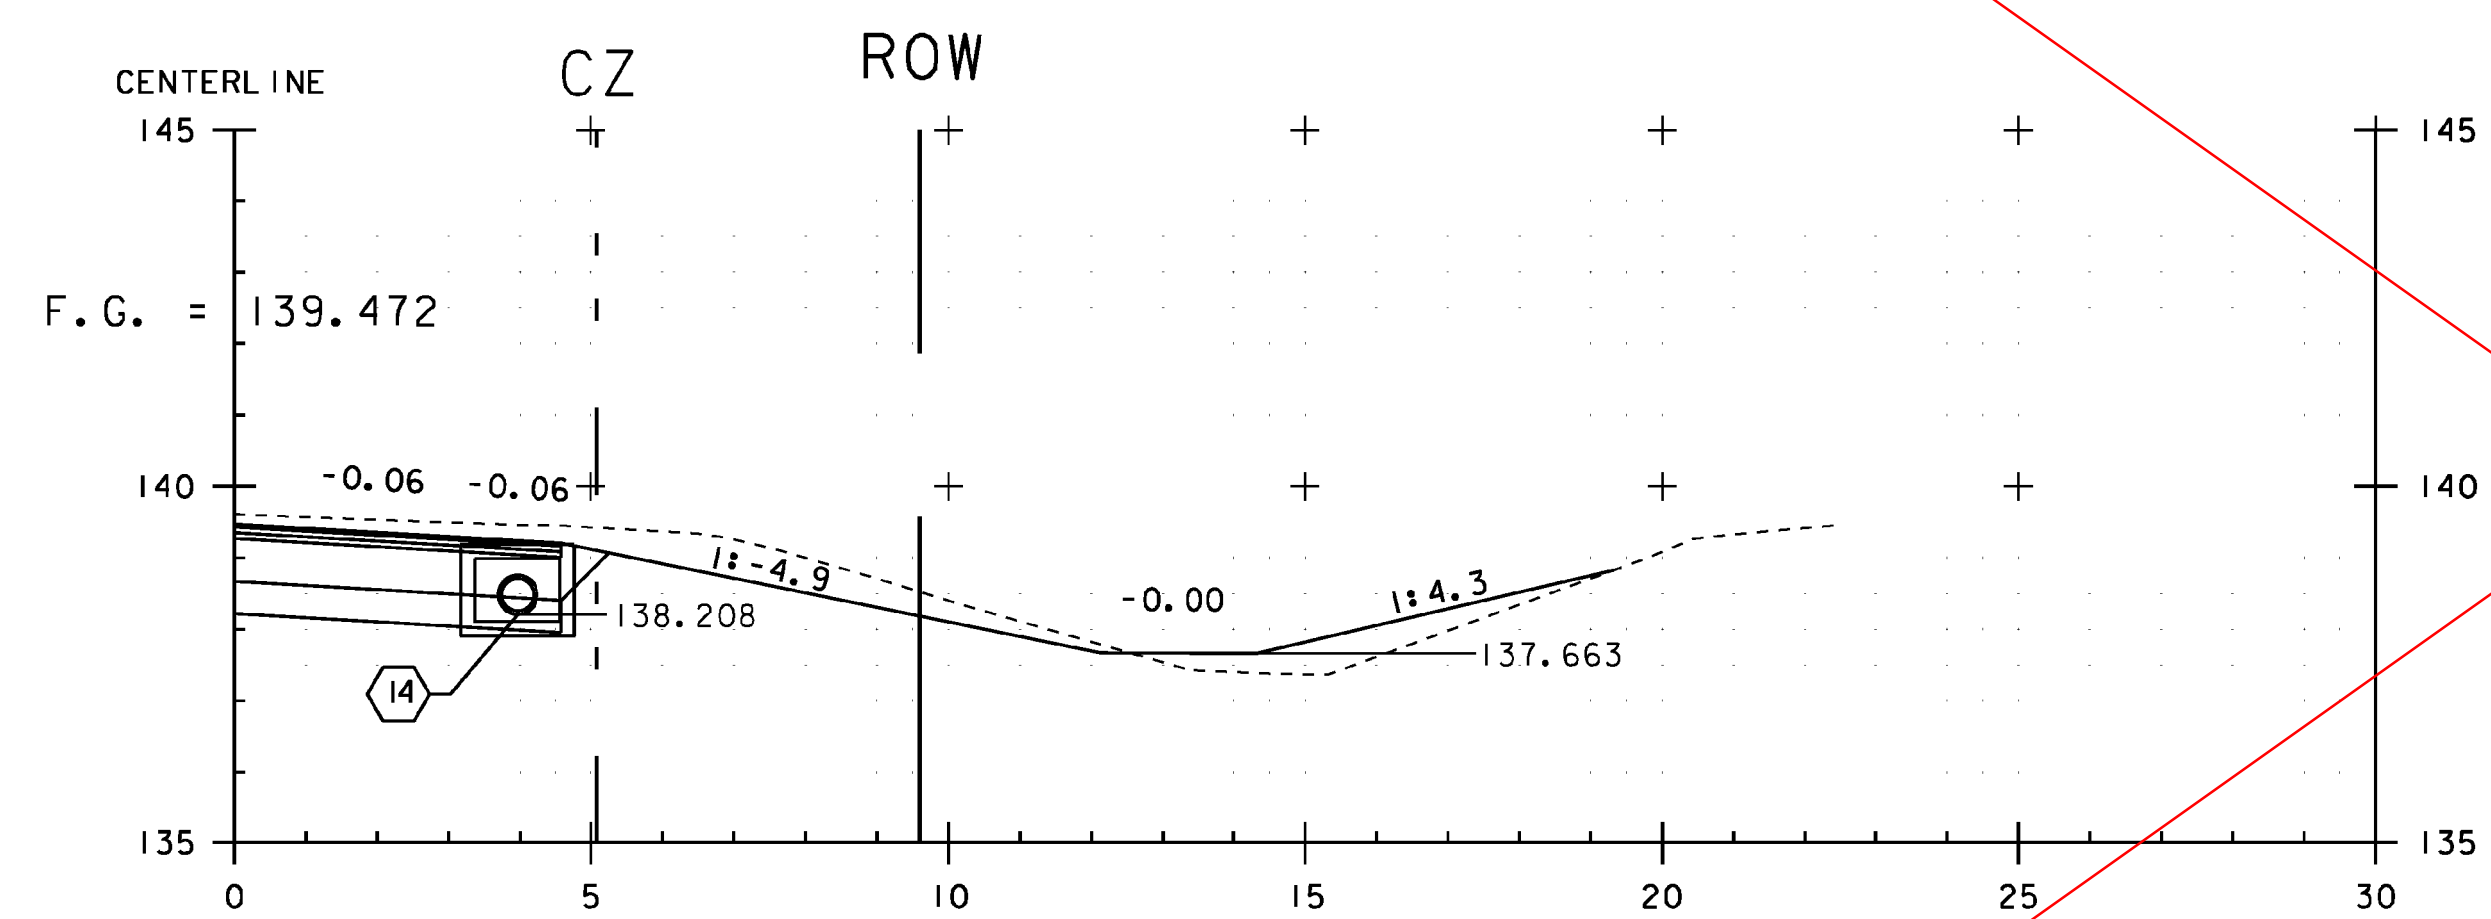

10+054.39

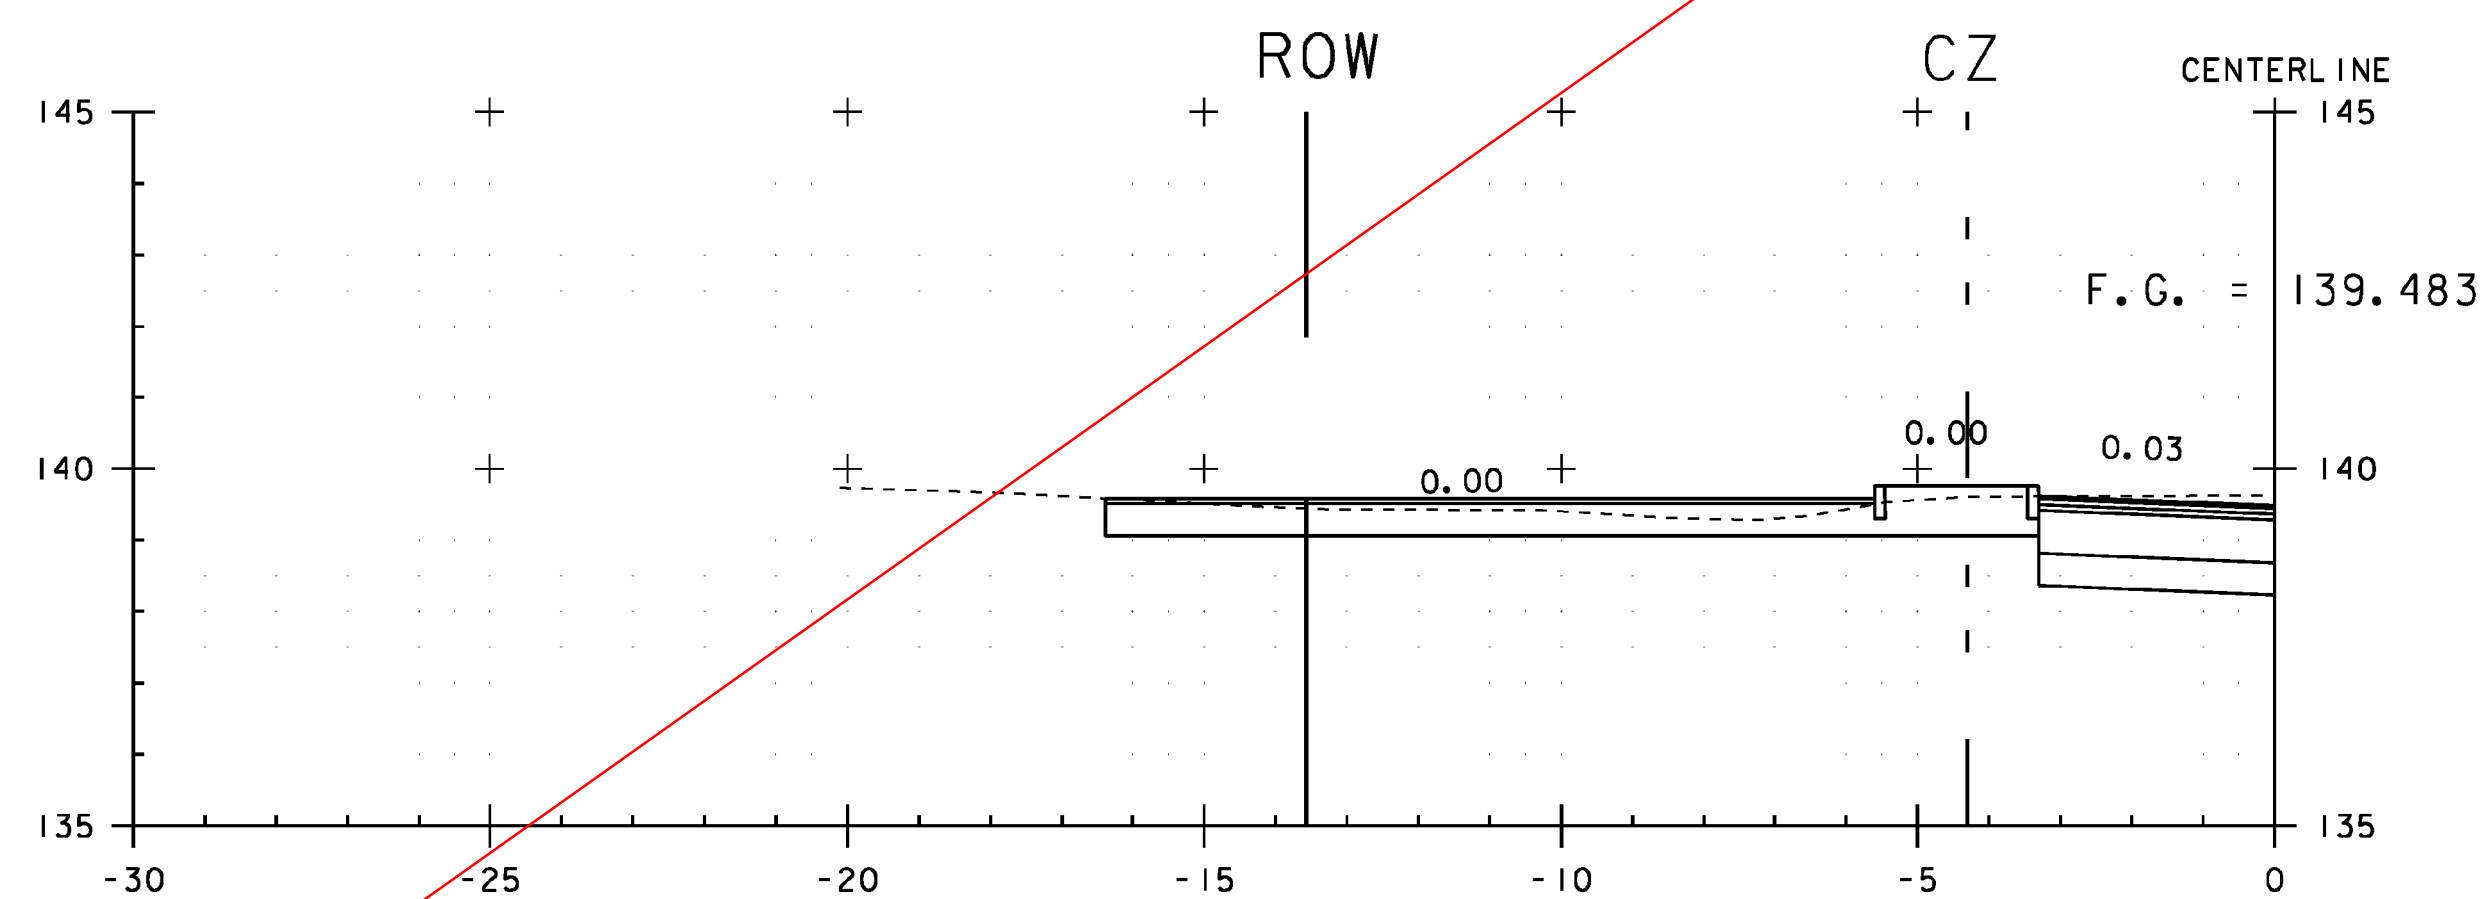

10+050.01

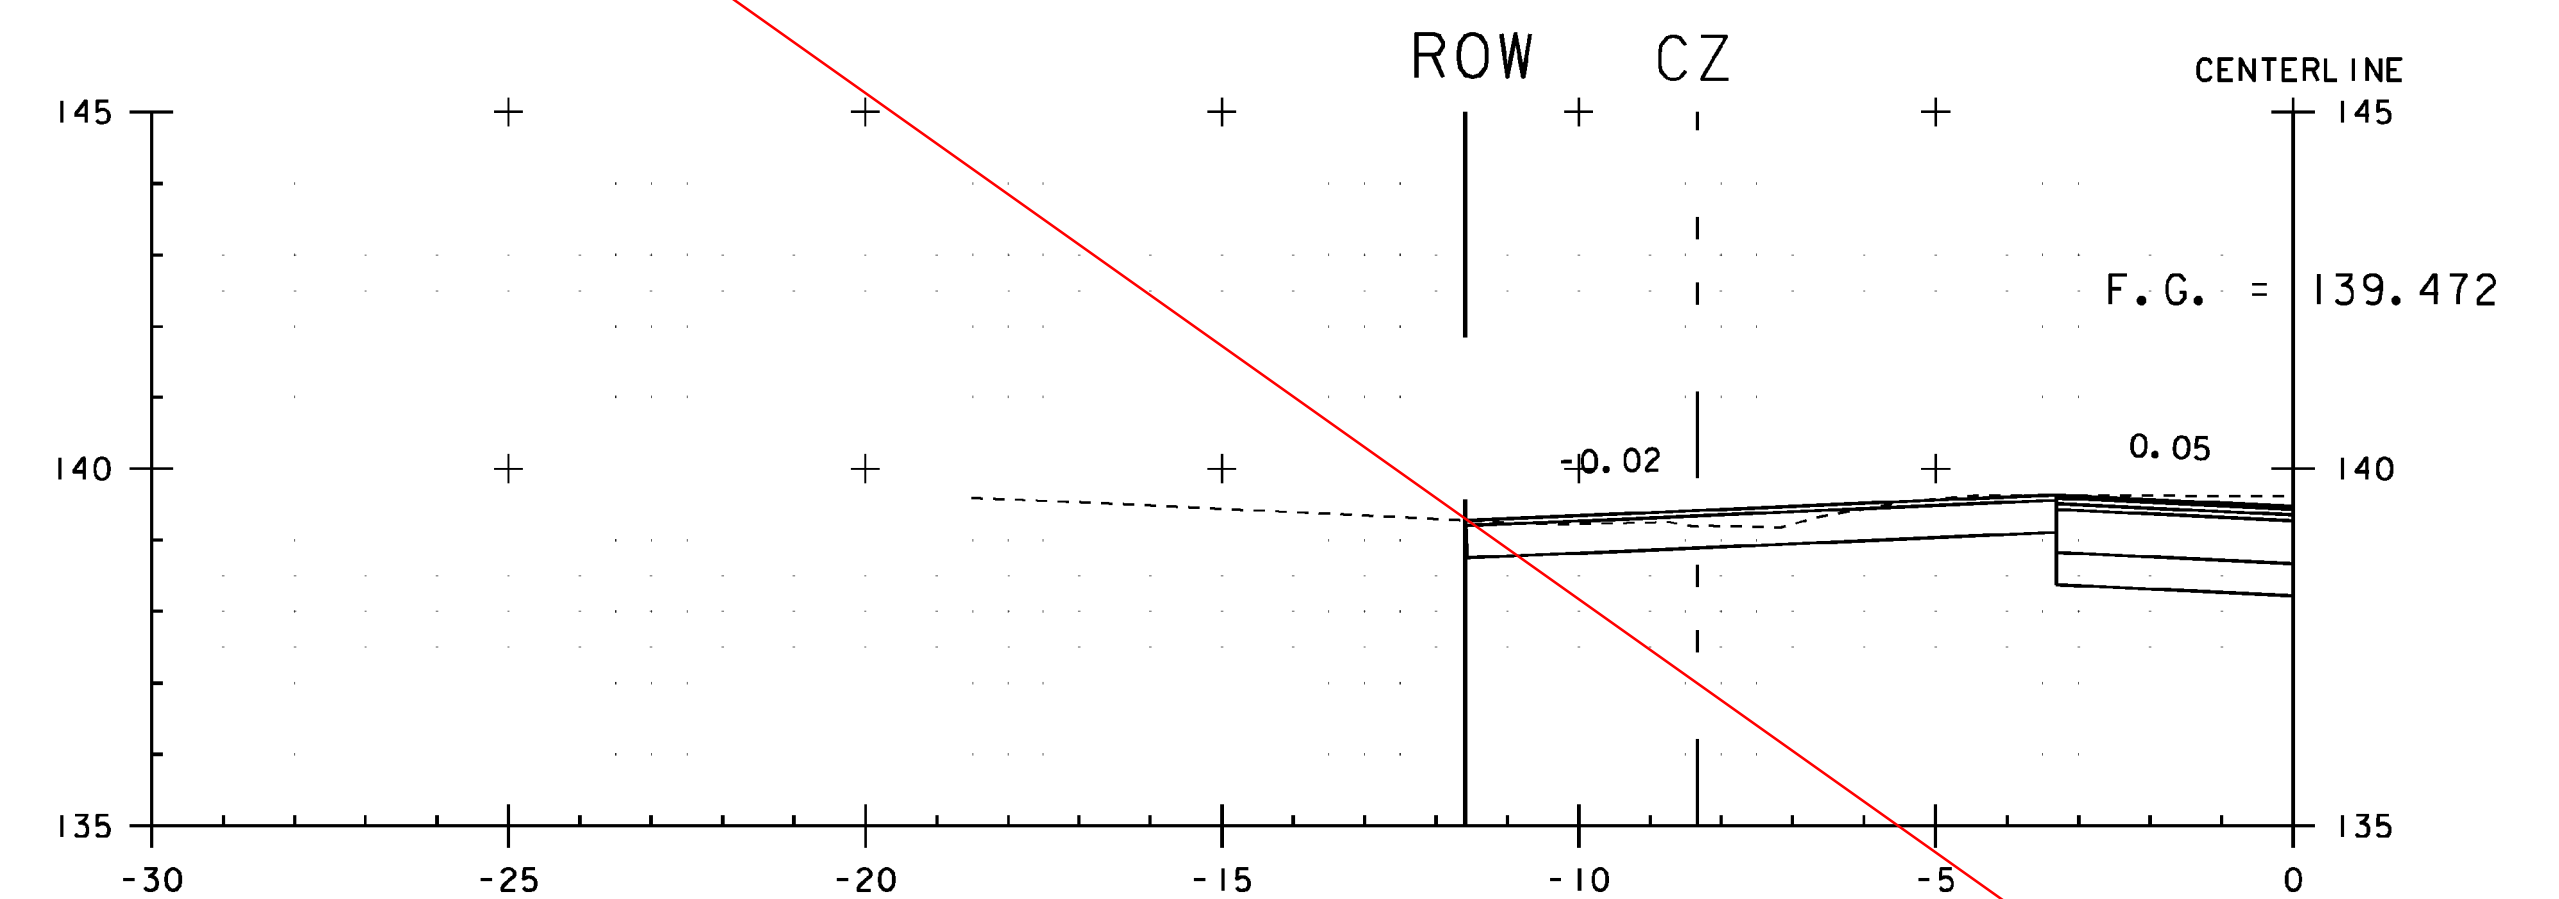

10+055.29

VT ROUTE 108

STA. 10+050 TO STA. 10+055

PROJECT NAME: CAMBRIDGE
PROJECT NUMBER: STP 030-2(27)

FILE NAME: t78f163xsl.dgn
PROJECT LEADER: JLS
DESIGNED BY: MBL
CROSS SECTION SHEET 41

PLOT DATE: 05-JUN-2012
DRAWN BY: MBL
CHECKED BY: JAD
SHEET 122 OF 214

SEE REVISION SHEET