

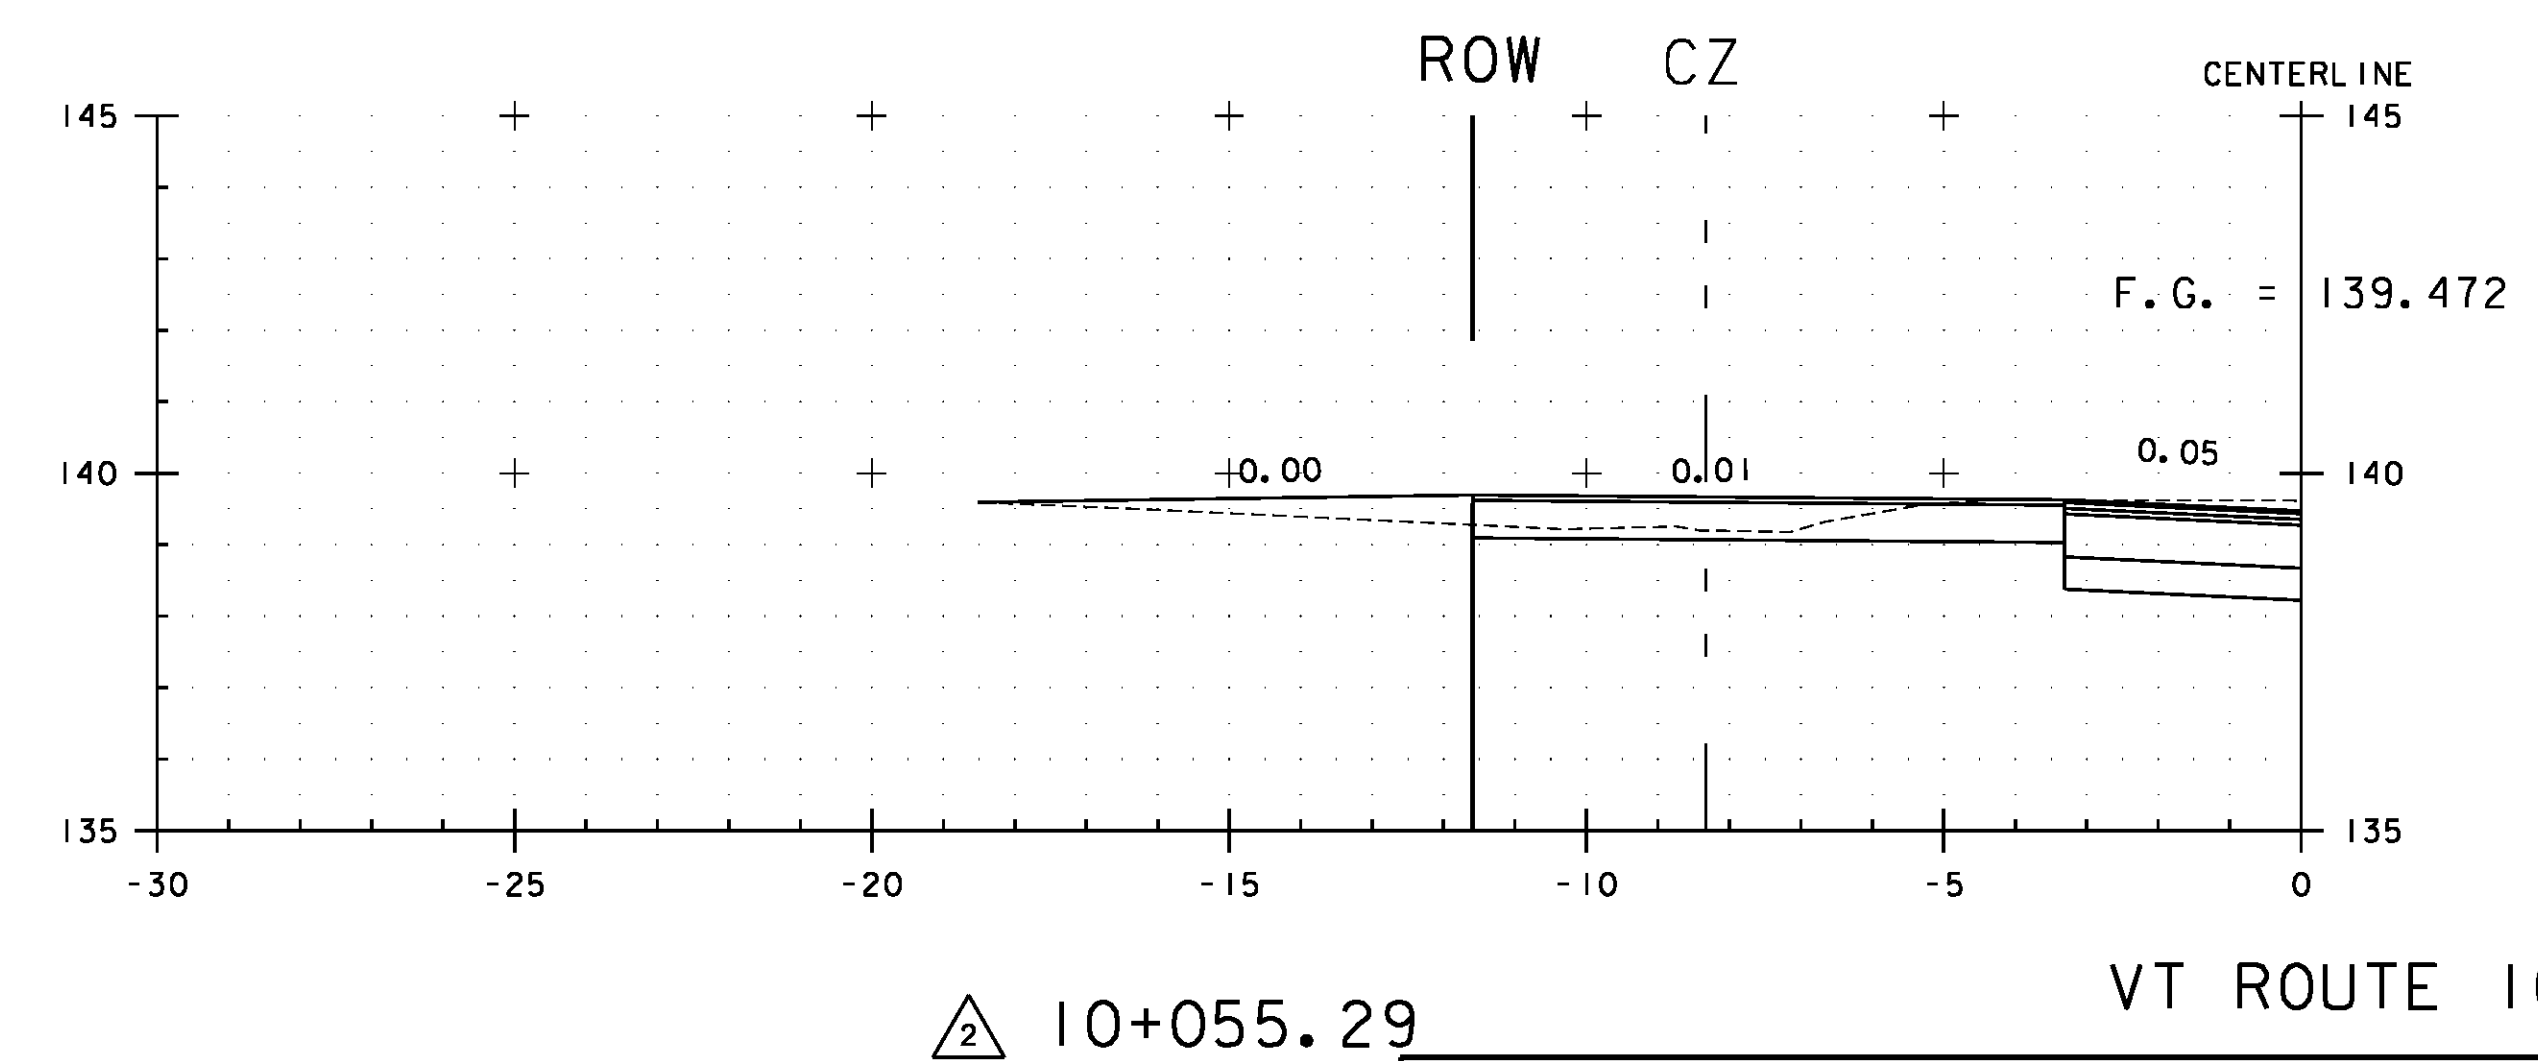
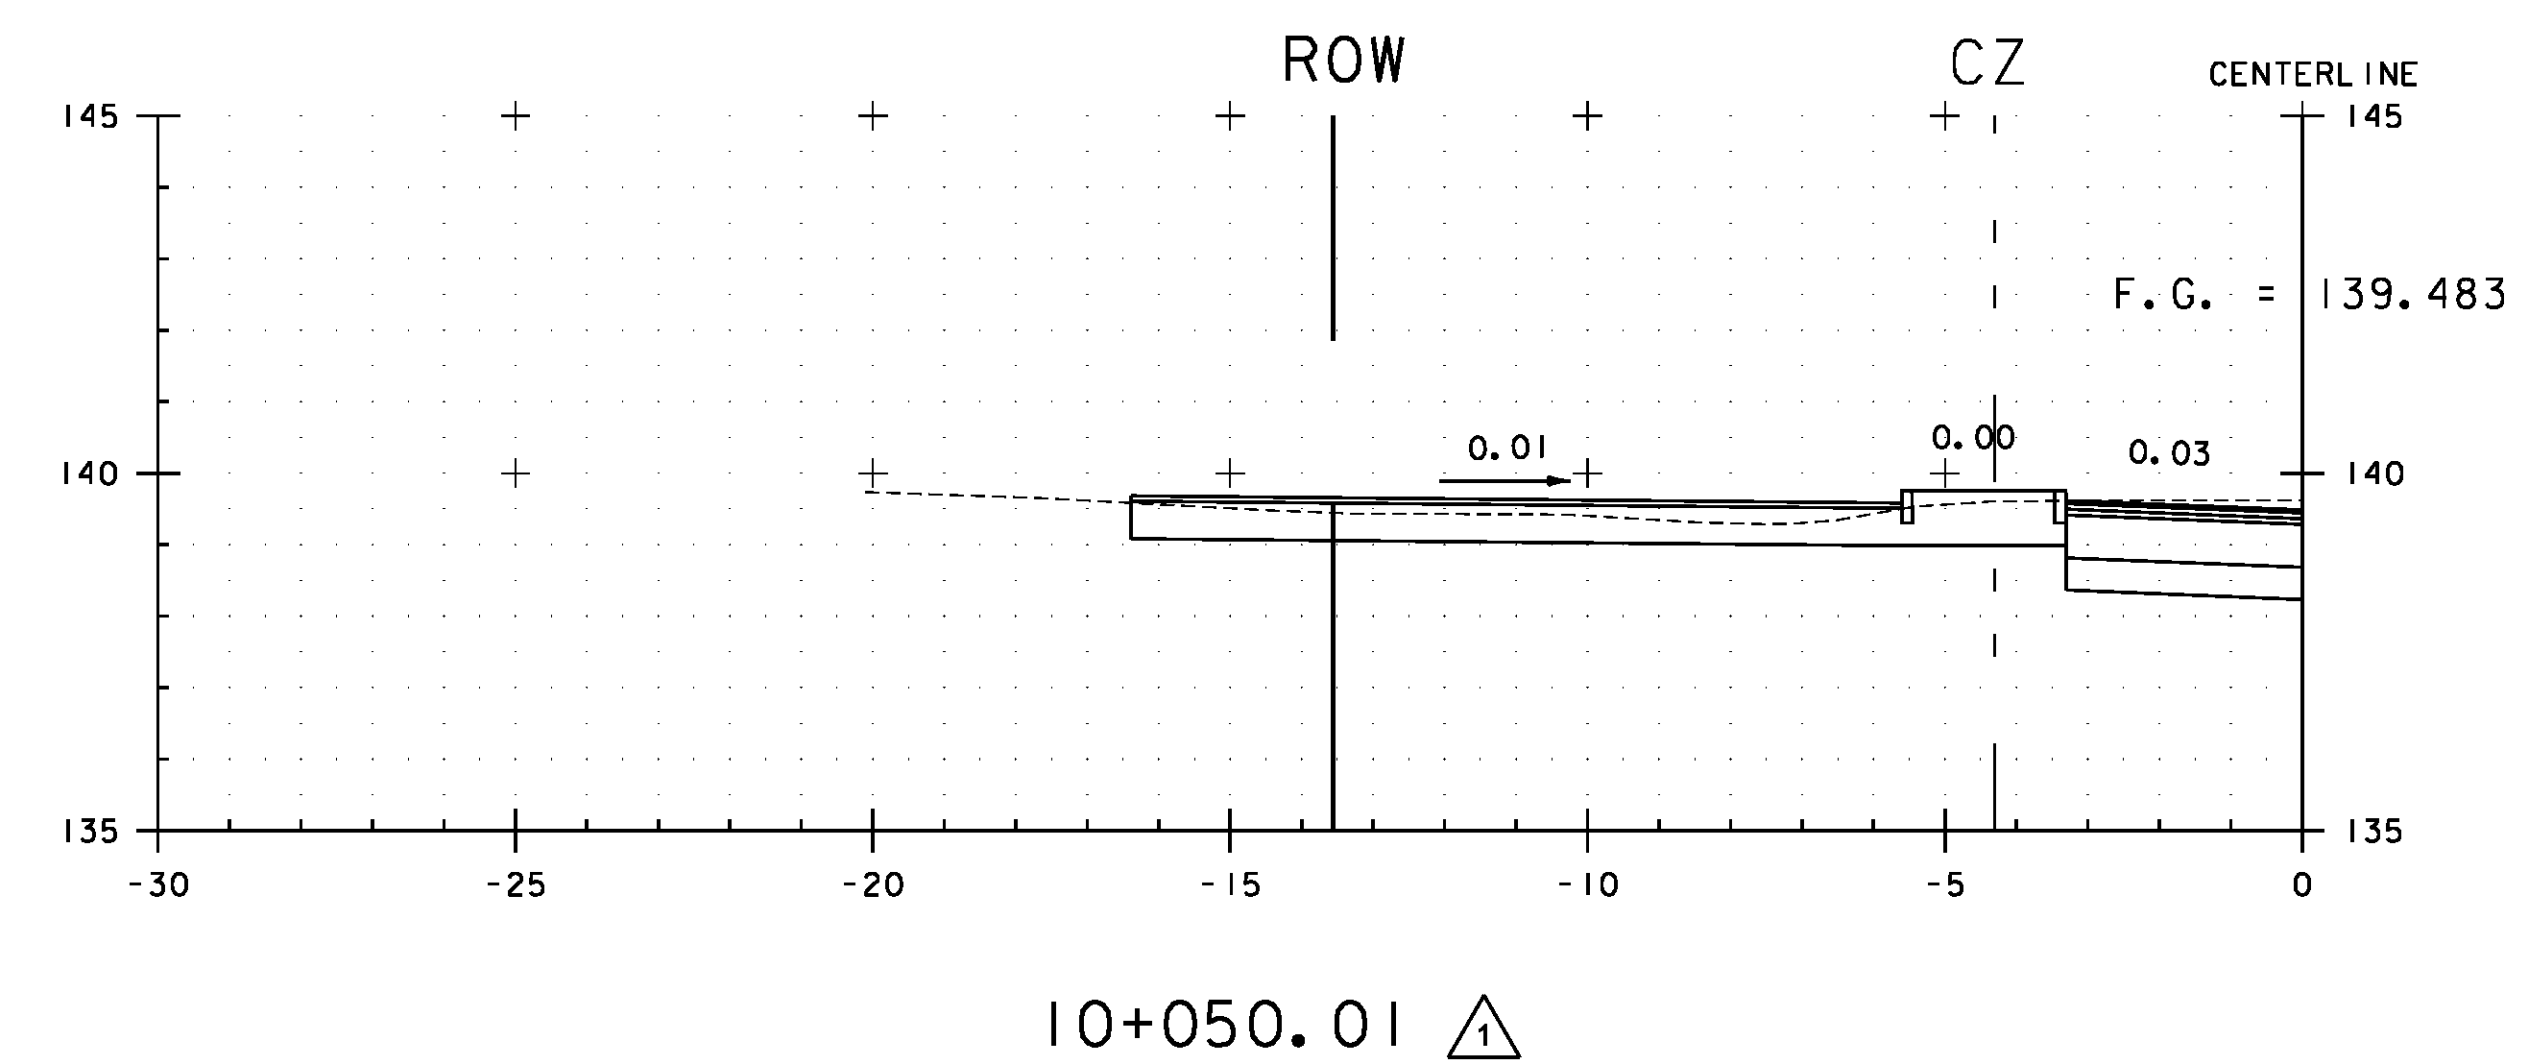


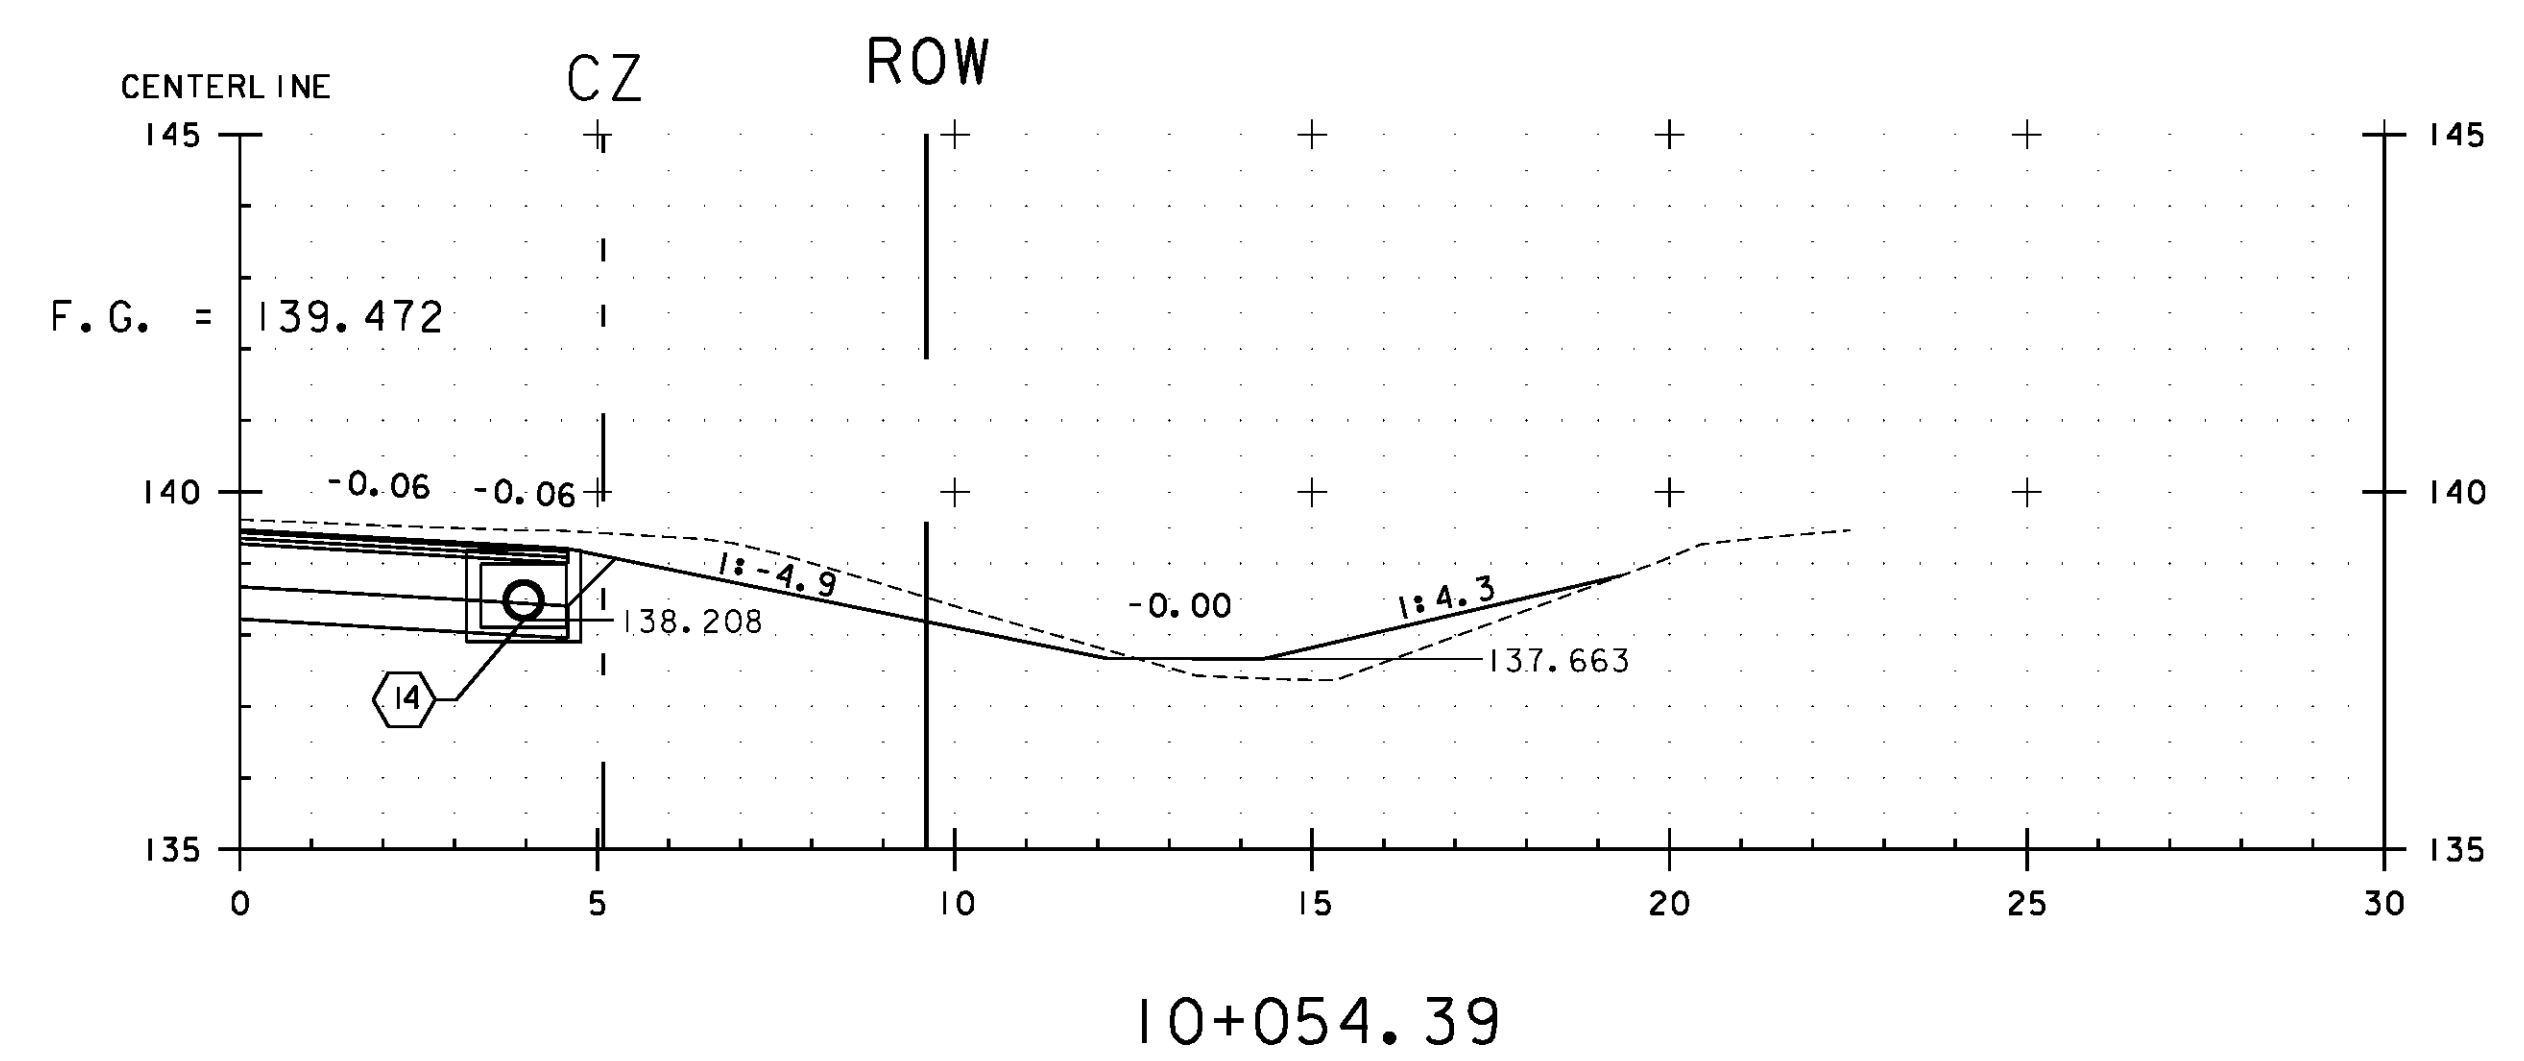

PROJECT NAME: CAMBRIDGE	
PROJECT NUMBER: STP 030-2(27)	
FILE NAME: t78f163xsl.dgn	PLOT DATE: 6/24/13
PROJECT LEADER: JLS	DRAWN BY: MBL
DESIGNED BY: MBL	CHECKED BY: JAD
CROSS SECTION SHEET 41	SHEET 122 OF 214

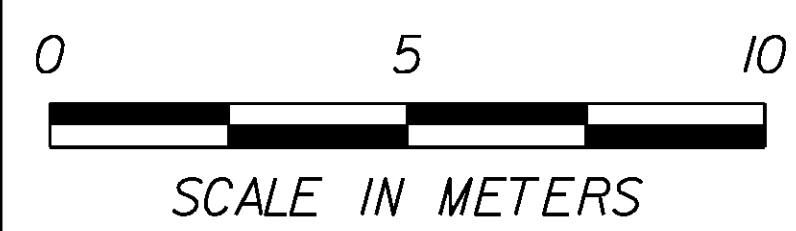

- 1 REVISED BANKING AND SUBGRADE OF PARKING LOT
- 2 REVISED BANKING AND SUBGRADE OF PARKING LOT

STA. 10+050 TO STA. 10+055