


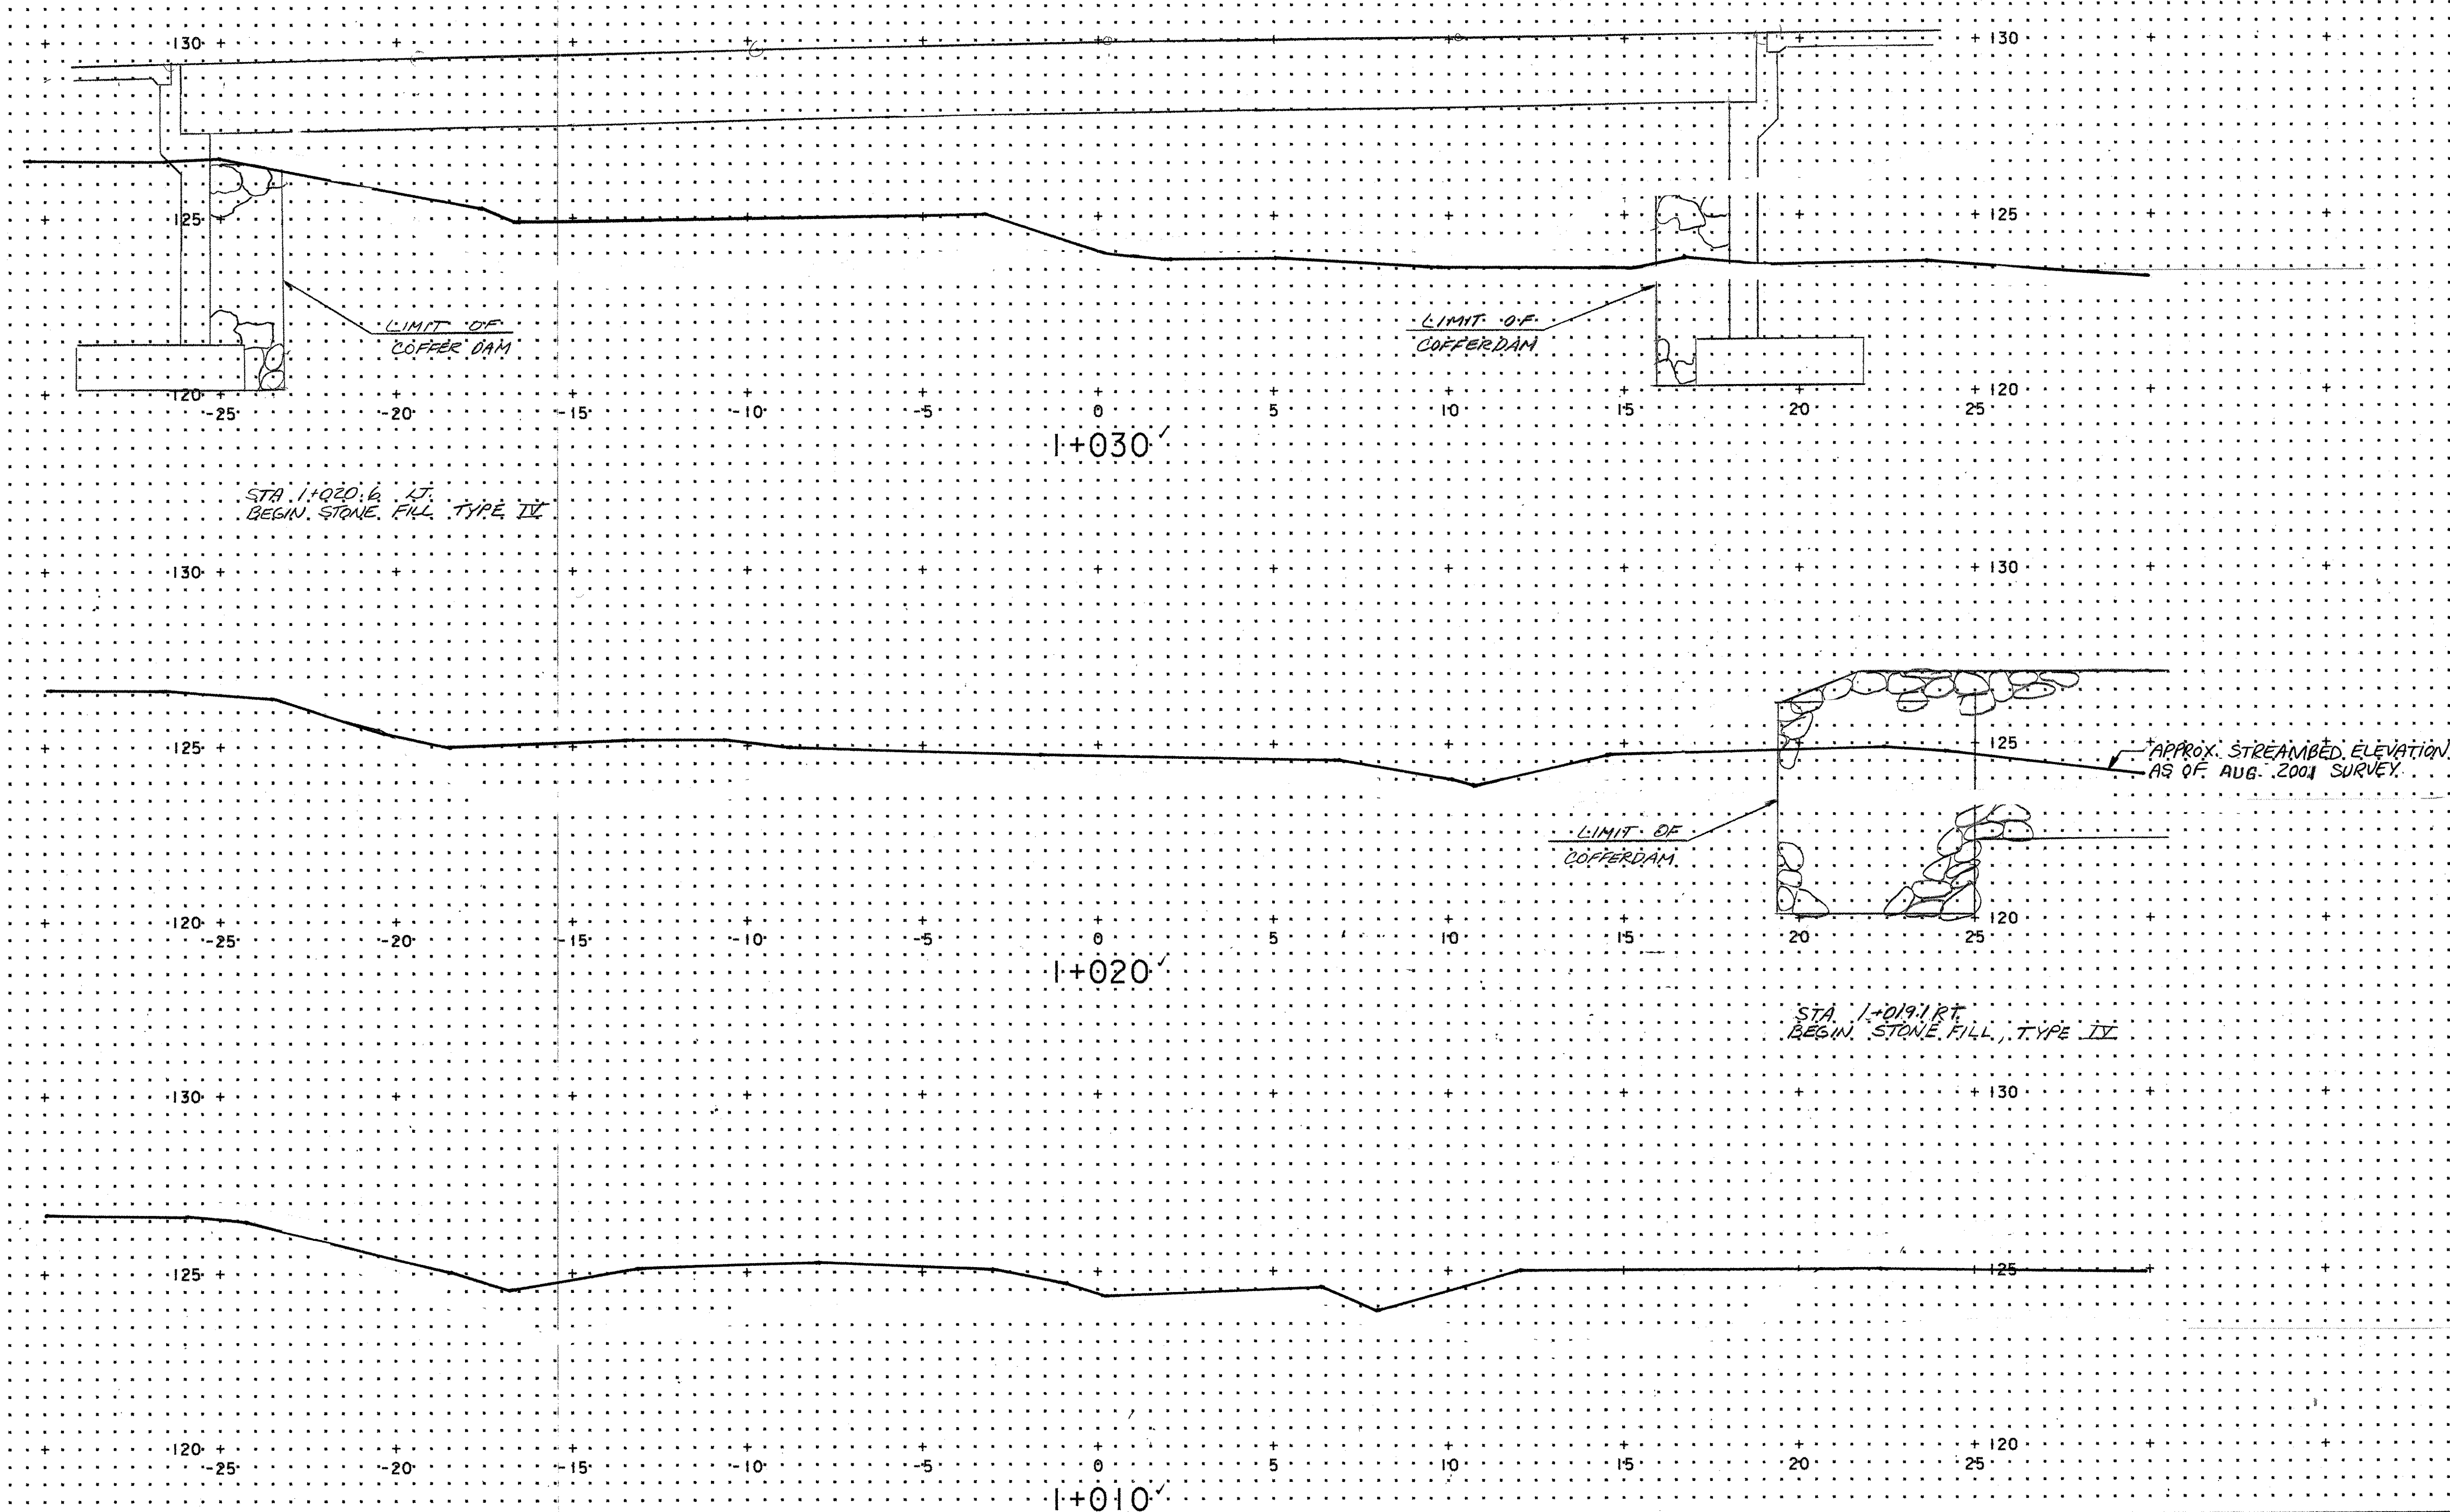

FROM STA. I+010 TO STA. I+030 TROUT RIVER
PROJECT NAME: VERMONT ROUTE 118 OVER TROUT RIVER
PROJECT NO. BRS 0283(7)
PLOTTED BY: CJM 10/28/96 CHECKED BY: JAY 10/29/96
SHEET 85 OF 140 SHEETS