


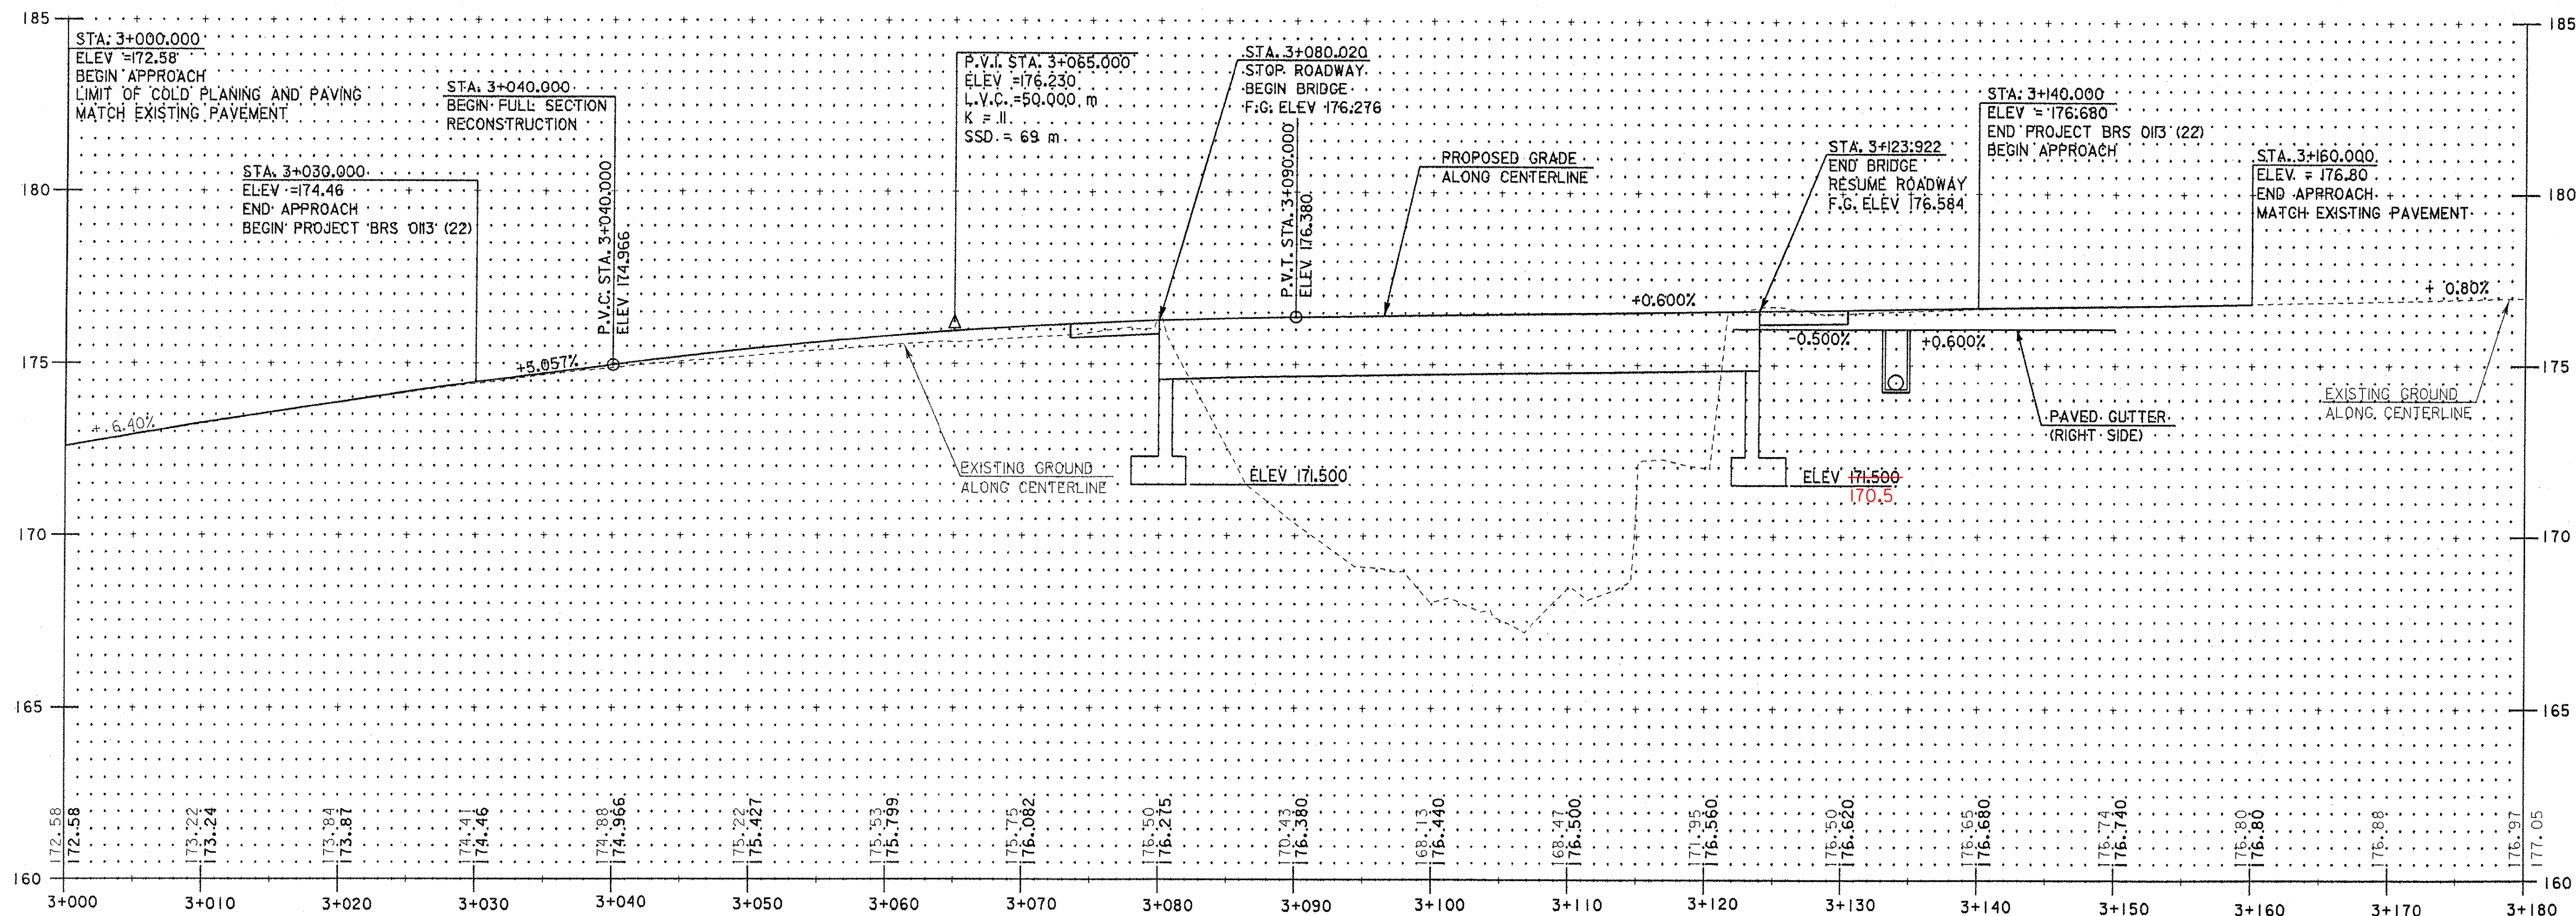

U.S. ROUTE 5

0 5 10
SCALE IN METERS

0 5
SCALE IN METERS

STATE OF VERMONT AGENCY OF TRANSPORTATION

Town Of	HARTLAND	Bridge No.	60
Highway No.	U.S. ROUTE 5	Log Sta.	
		Surv. Sta.	
U.S. ROUTE 5 OVER LULLS BROOK			

PROFILE

Designed By	S.E. COSILMON	Drawn By	R. REMY / G.F. O'NEIL
Checked By	J. R. McDUFFEE	Bridge Design Supervisor	J. MIECZKOWSKI
Date	2/ 04	Date	2/ 04
PROJECT	HARTLAND	PROJECT NO.	BRS No. 0113(22)
I.G.C. Info. M:\456201\VAOT Hartland\zf204xsl.dgn			
Bridge Sheet No.	Sheet 15 of 86		