




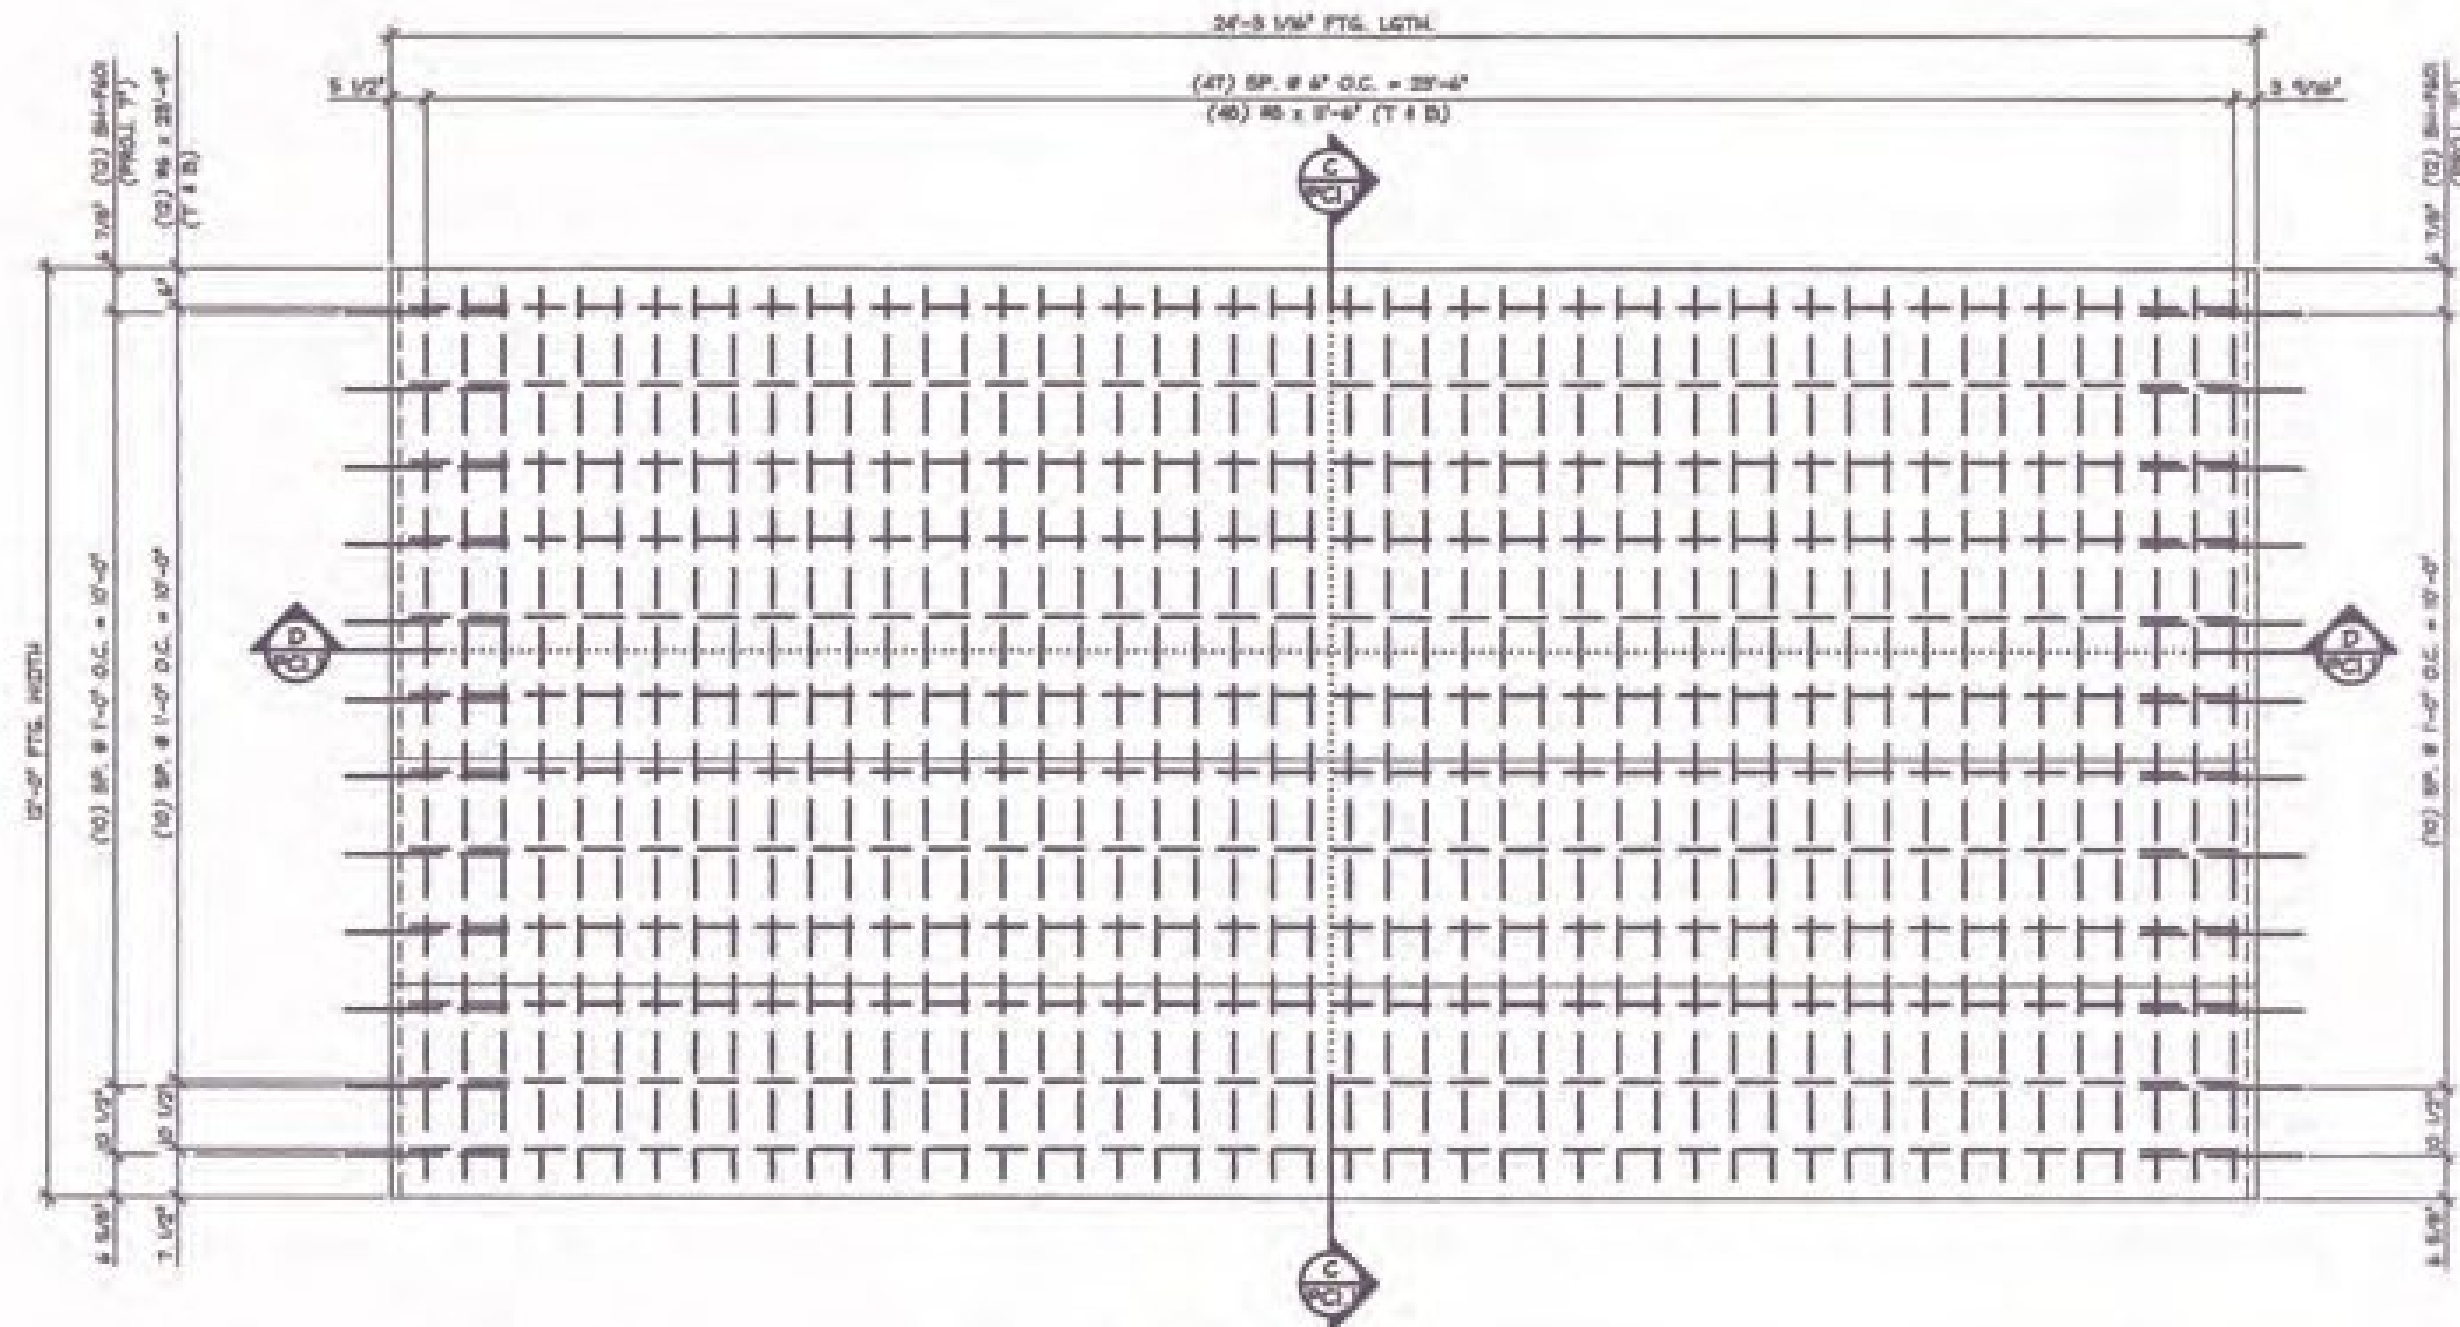


2 REINFORCING PLAN VIEW IN FORM
1/2" = 1'-0"

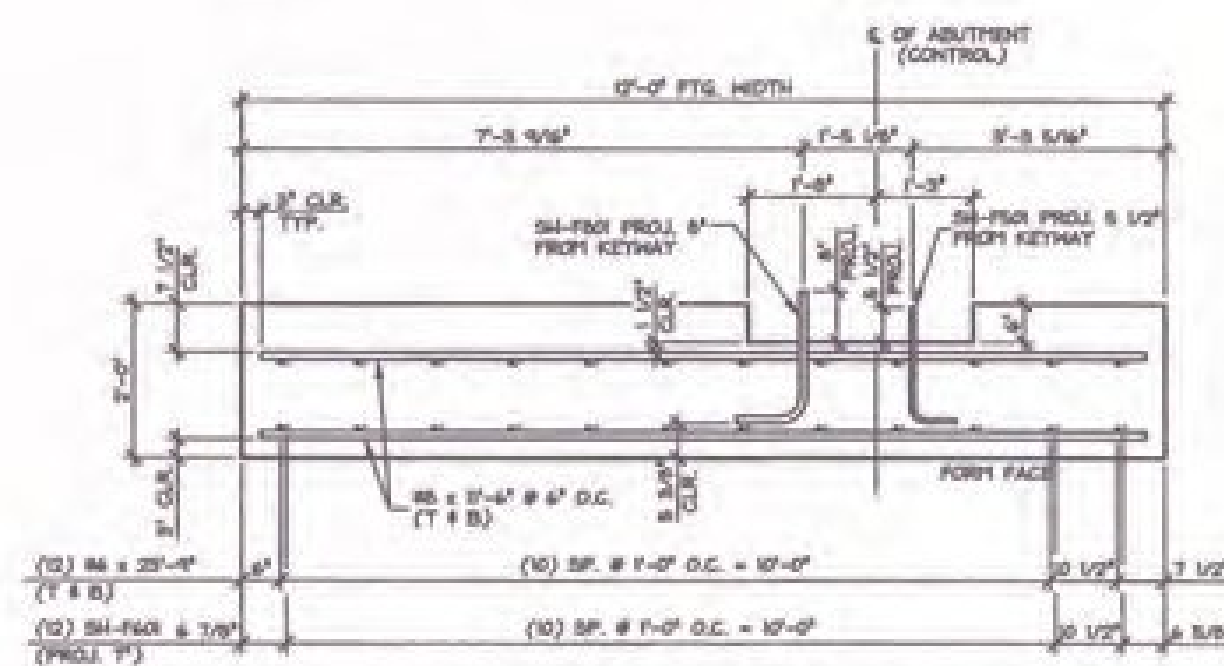

C REINFORCING SECTION C-C
1/2" = 1'-0"

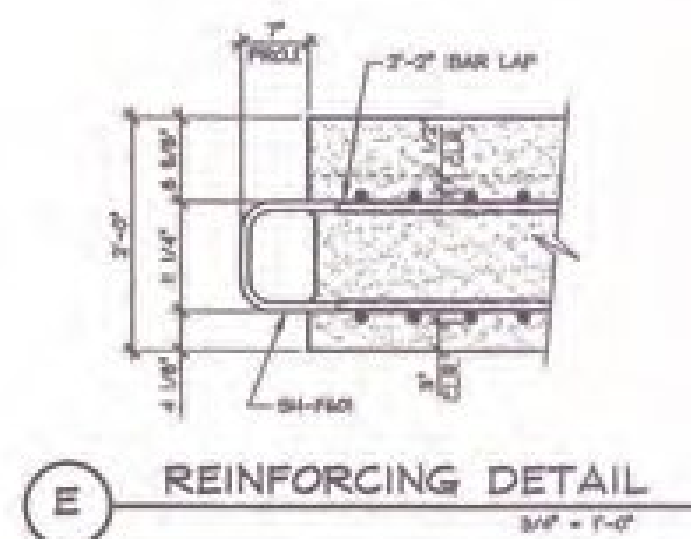

REINFORCING DETAIL
1/2" = 1'-0"

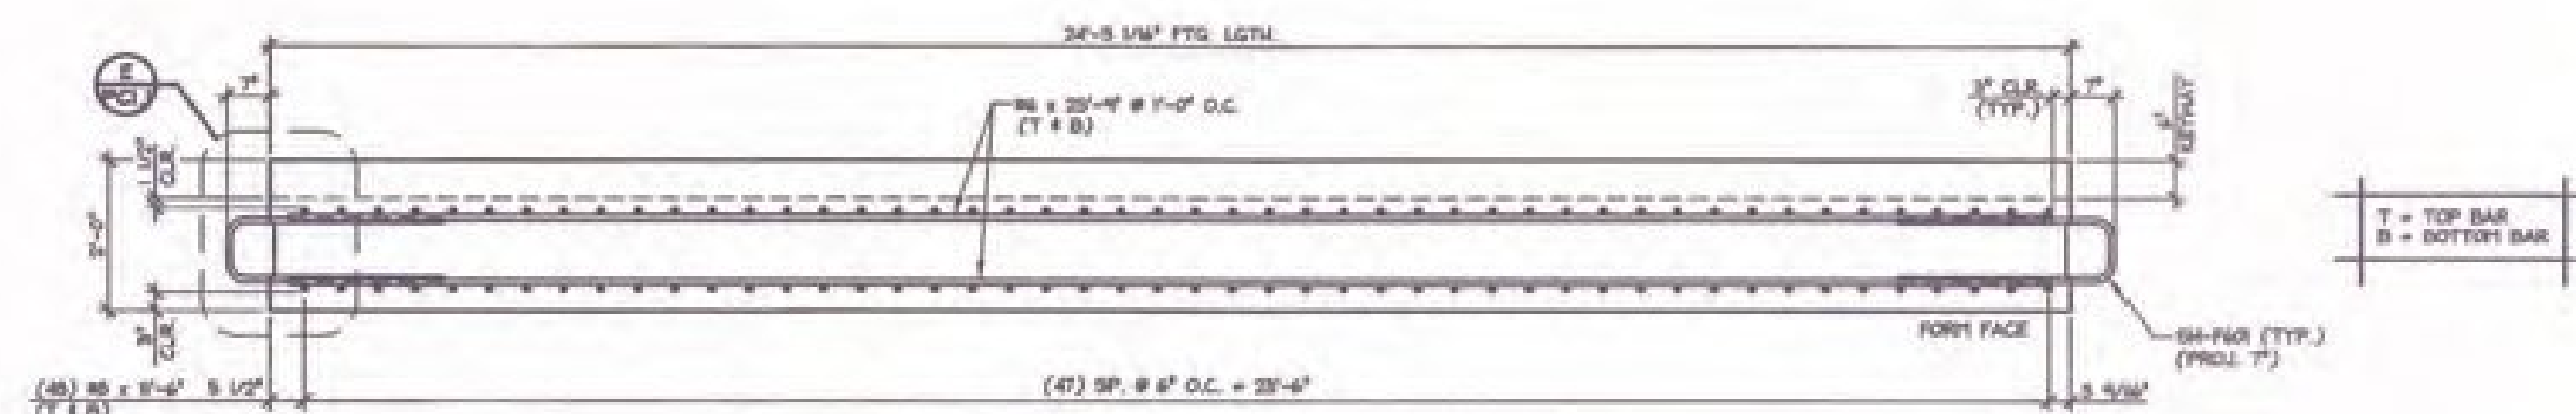

D REINFORCING SECTION D-D
1/2" = 1'-0"

1/2" = 1'-0"
1/4" = 1'-0"

Vermont Agency of Transportation
RECEIVED
ON: January 28, 2014
and Checked for
CONFORMANCE
BY: Jennifer Fitch DATE: 02/04/2014

SUBMITTED
JAN 27 2014
J.P. CARRARA & SONS, INC.
Middlebury, VT 05753

MARK: SHF-1	QTY.: 1	WT.: 40.99 T	VOL.: 20.24 cy
MATERIAL LIST / FOOTING			
ITEM	MARK	DESCRIPTION	QTY.
1		SB # 2'-0" (BLACK)	24
2		SB # 1'-0" (BLACK)	46
3		SB # 1'-0" (BLACK)	46
4		SB # 1'-0" (BLACK)	46
5	SH-100	1/4" BENT BAR (BLACK)	24
6			
7			
8			
9			
10			
11			
12			
13			
14			
15			

SHOP DRAWING REVIEW

Reviewed by: SPH38
Reviewed by: Asst. Designer
Date: 1-31-2014

APPROVAL STAMP:

J.P. CARRARA & SONS INC.
Precast & Prestress Manufacturer
1000 ROUTE 100, MIDDLEBURY, VERMONT 05753 Phone: (802) 288-6001 Fax: (802) 288-6010

T. BUCK CONSTRUCTION
CONTRACTOR
AUBURN, MAINE

STATE OF VERMONT AGENCY OF TRANSPORTATION
COUNTY OF ADDISON

TOWN OF MIDDLEBURY
ROUTE NO. VT 125, EAST MIDDLEBURY GORGE
BRIDGE NO. 13 PROJECT NO. 13 0174(8)

DATE: OCT. 9, 2013
SCALE: NOTED
CHKD: DFM: T.D.
JOB NO: 25411-013
DWG. NO: PC1.1