



RECEIVED

ON: April 2, 2014


and Checked for

CONFORMANCE

BY: Jennifer Fitch DATE: 04/04/2014

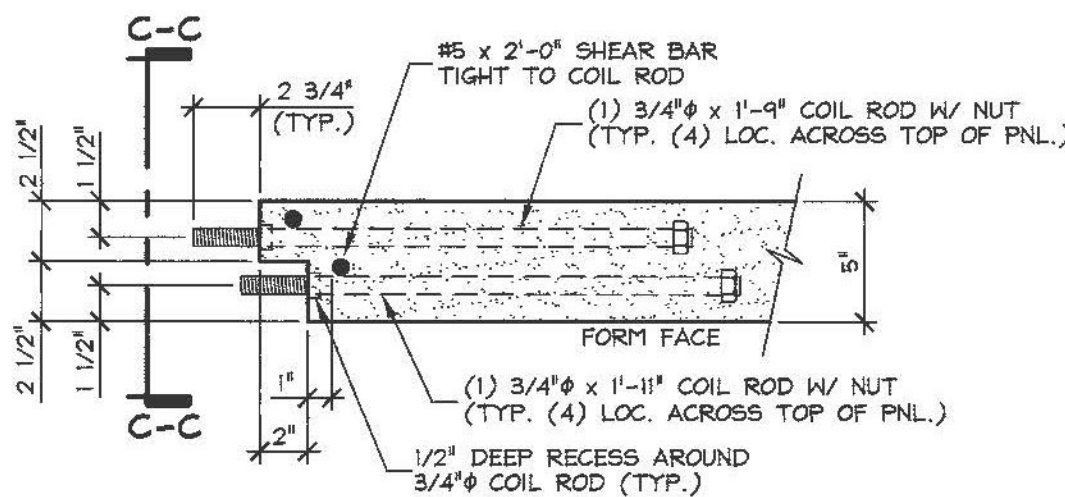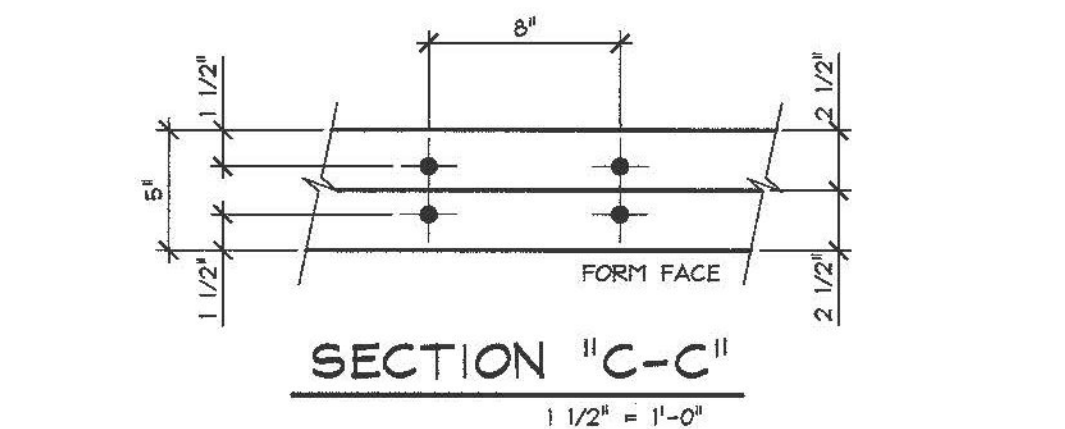

C TOP EDGE SECTION
1/2\"/>

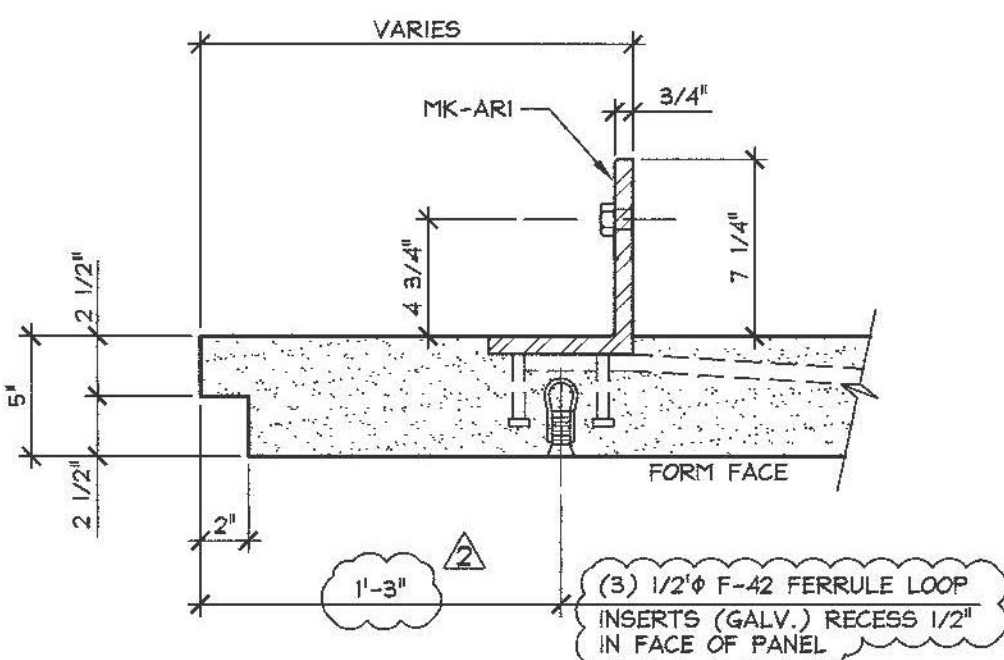

D TOP EDGE SECTION
1/2\"/>

3500 PSI @ RELEASE
5000 PSI @ 28 DAYS

MIX DESIGN: 446MSCC

MARK: SHPN-10 QTY.: 1 WT.: 1.41 T VOL.: 0.7 cy

MATERIAL LIST / ARCHITECTURAL PANEL

ITEM	MARK	DESCRIPTION	QTY.
1	MK-ARI	4 8 x 6 x 3/4 x 1'-0\"/>	2
2		3/4\"/>	4
3		3/4\"/>	4
4		DAYTON P30 COREWALL CS835 SLOTTED INSERT (GALV.)	4
5		DAYTON 4T x 3 3/4\"/>	4
6		1/2\"/>	3
7			
8			
9		#5 x 2'-0\"/>	4
10		#4 x 9'-9\"/>	1
11		#6 x 9'-5 1/4\"/>	6
12		#6 x 5'-1\"/>	10
13			
14			
15			

ISSUED FOR
PRODUCTION
APR 01 2014
J.P. CARRARA & SONS, INC.
MIDDLEBURY, VT 05753

APPROVAL STAMP:

J.P. CARRARA & SONS INC.

Precast & Prestress Manufacturer

2464 CASE ST., MIDDLEBURY, VERMONT 05753 Phone: (802)388-6361 Fax: (802)388-6010

T. BUCK CONSTRUCTION
CONTRACTOR
AUBURN, MAINE

STATE OF VERMONT AGENCY OF TRANSPORTATION
COUNTY OF ADDISON

DATE: OCT. 9, 2013

SCALE: NOTED


TOWN OF MIDDLEBURY
ROUTE NO. VT 125, EAST MIDDLEBURY GORGE
BRIDGE NO.: 13 PROJECT NO.: RS 0174(B)

CHKD: DFTM: T.D.


JOB NO: 23411-013

P/C ARCHITECTURAL PANEL DETAILS


DWG. NO: PA10

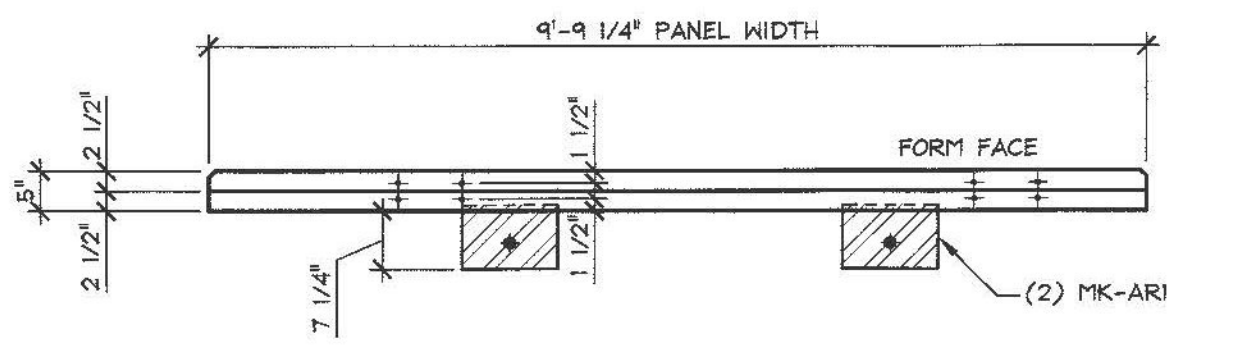


1 TOP ELEVATION VIEW IN FORM
PA10
1/2\"/>

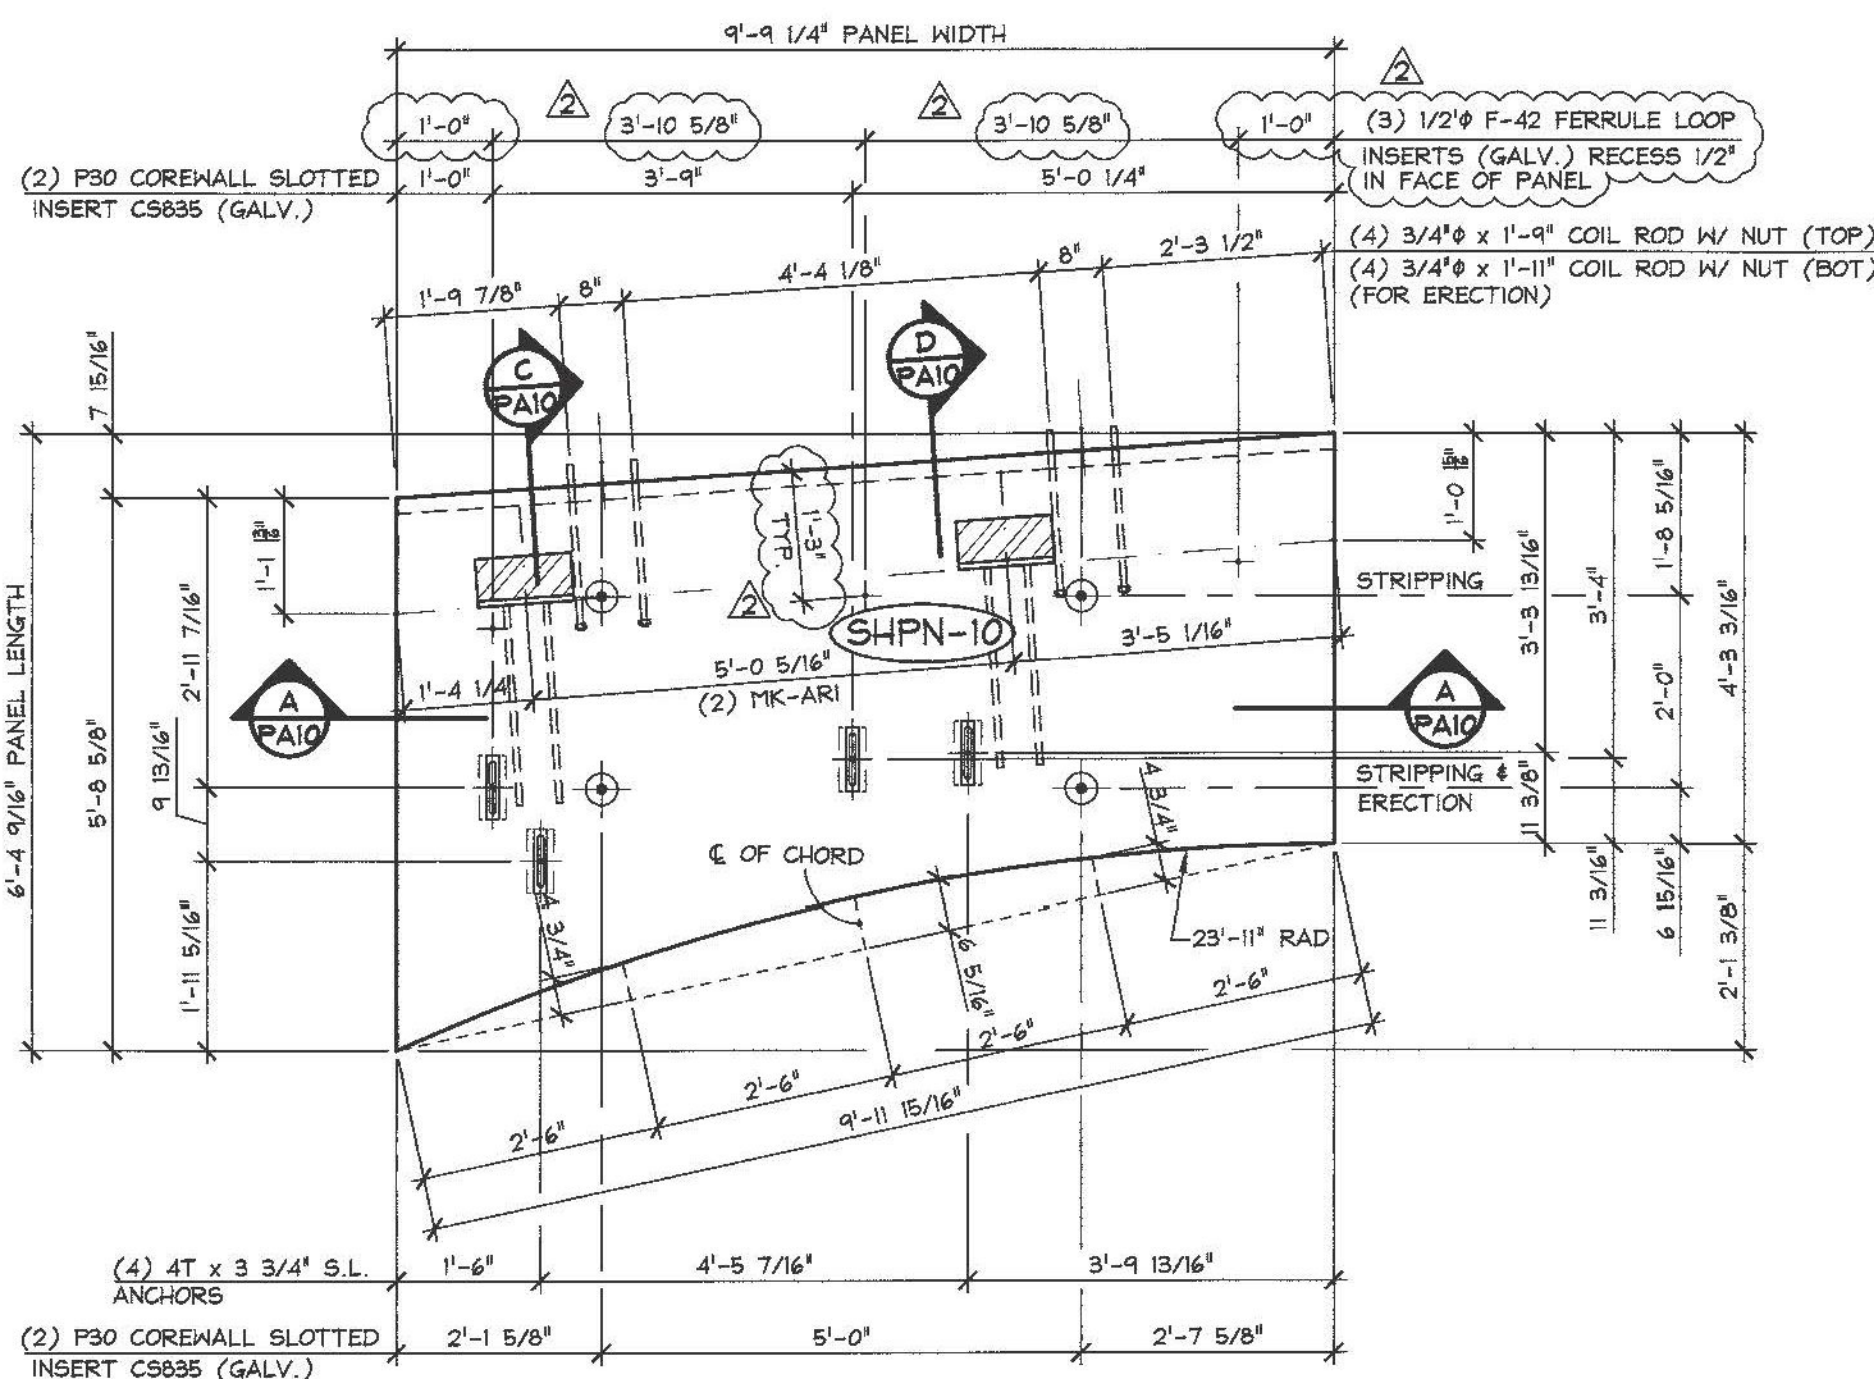


2 PLAN VIEW IN FORM
PA10
1/2\"/>

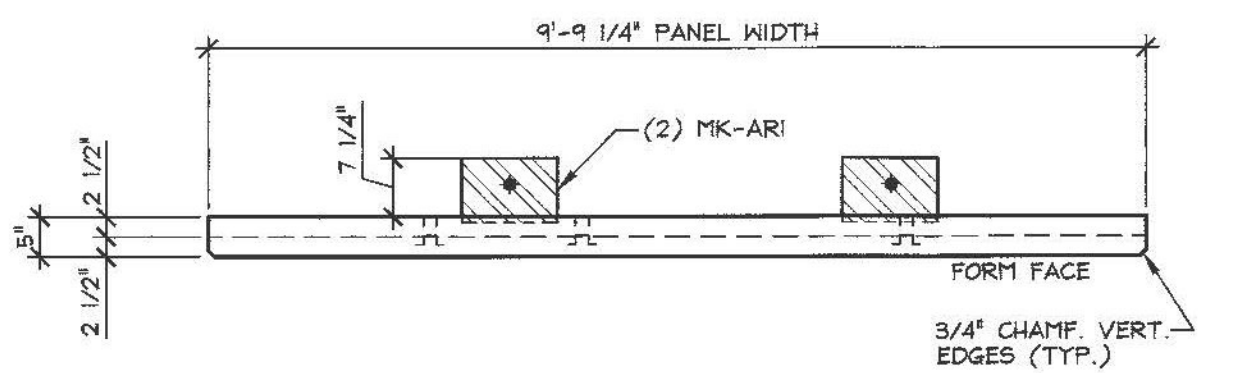

A DIMENSIONAL SECTION
1/2\"/>

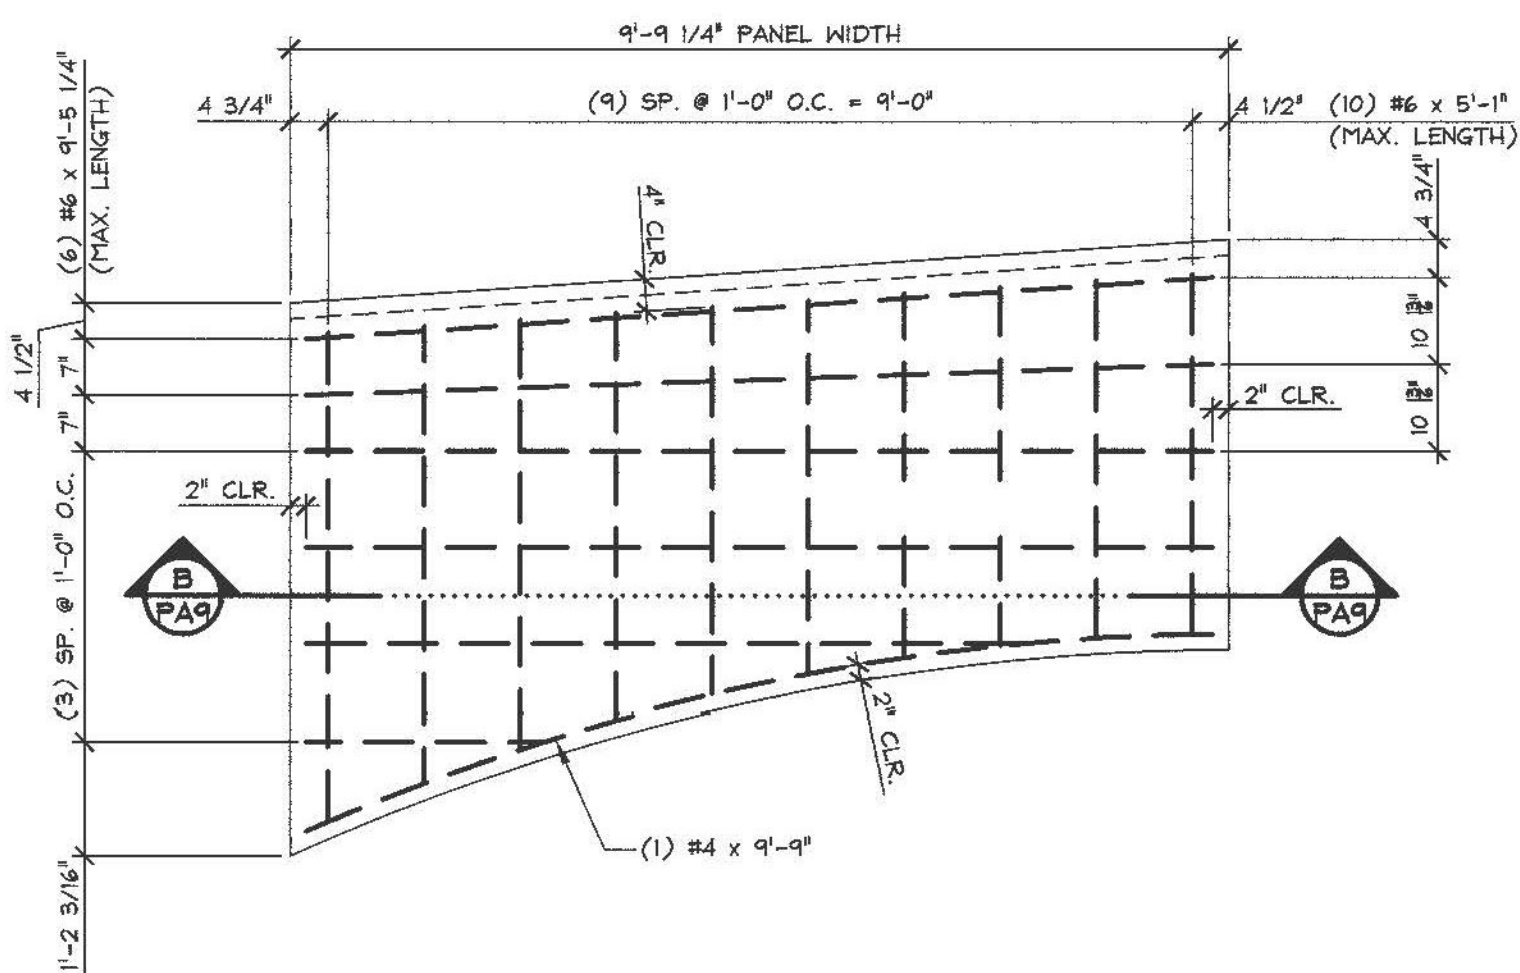

3 REINFORCING PLAN VIEW IN FORM
PA10
1/2\"/>

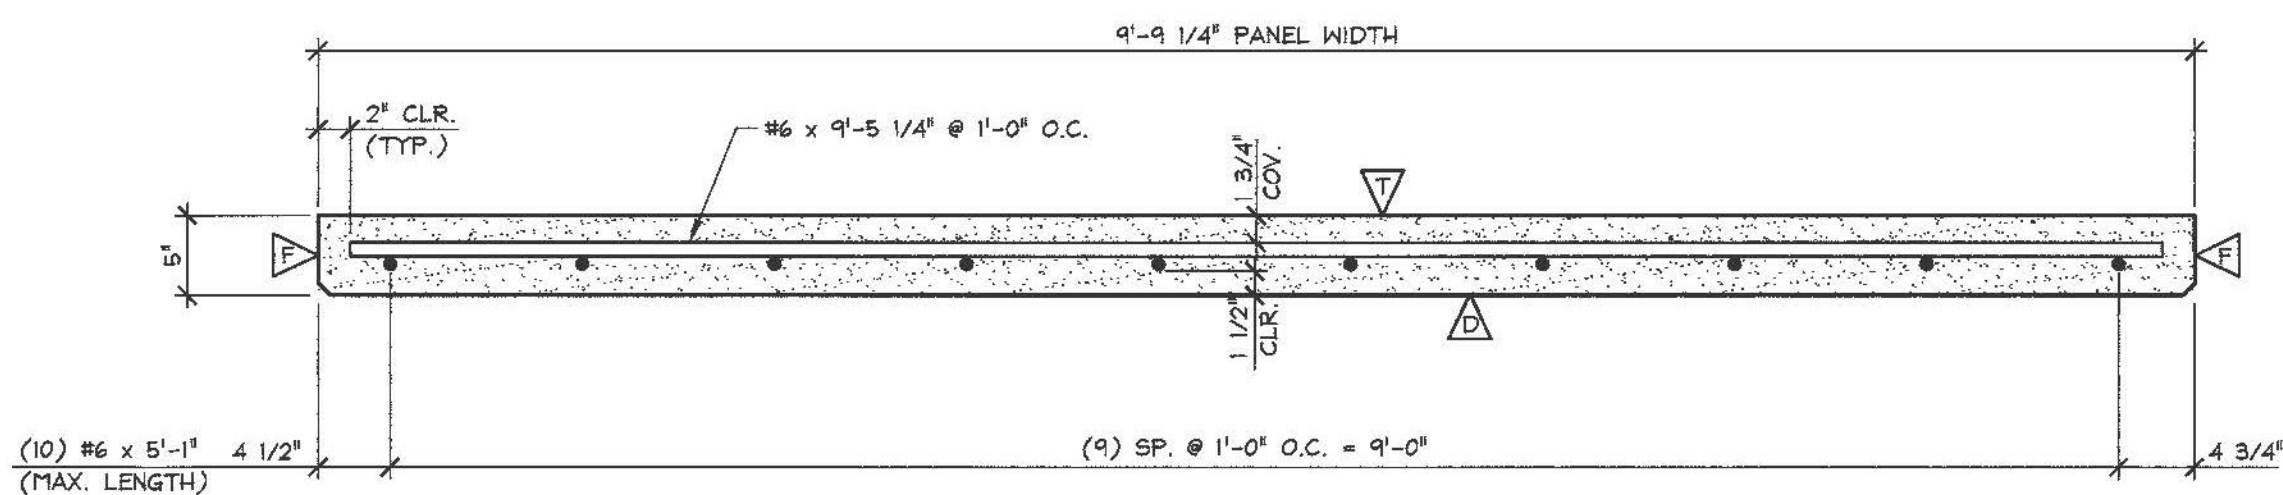

B REINFORCING SECTION
1/2\"/>

SHOP DRAWING REVIEW

REVIEWED AS REQUIRED BY THE CONSTRUCTION CONTRACT DOCUMENTS AND APPROVED, BUT ONLY FOR CONFORMANCE TO THE DESIGN CONCEPT OF THE WORK, AND SUBJECT TO FURTHER LIMITATIONS AND REQUIREMENTS CONTAINED IN THE CONSTRUCTION CONTRACT DOCUMENTS.

REJECTED REVIS AND RESUBMIT FURNISH AS CORRECTED

CORRECTIONS OR COMMENTS MADE ON THE SHOP DRAWINGS DURING THIS REVIEW DO NOT RELIEVE CONTRACTOR FROM COMPLIANCE WITH REQUIREMENTS OF THE DRAWINGS AND SPECIFICATIONS. THIS CHECK IS ONLY FOR REVIEW OF GENERAL CONFORMANCE WITH THE DESIGN CONCEPT OF THE PROJECT AND GENERAL COMPLIANCE WITH THE INFORMATION GIVEN IN THE CONTRACT DOCUMENTS. THE CONTRACTOR IS RESPONSIBLE FOR: CONFIRMING AND CORRELATING ALL QUANTITIES AND DIMENSIONS; SELECTING FABRICATION PROCESSES AND TECHNIQUES OF CONSTRUCTION; COORDINATING HIS WORK WITH THAT OF ALL OTHER TRADES; AND PERFORMING HIS WORK IN A SAFE AND SATISFACTORY MANNER.

VHB

Job Number: 57438

Reviewed By: G.S. Goodrich

Date: 4/4/2014

3-26-14 GENERAL REVISION T.D.
2-11-14 GENERAL REVISION T.D.