




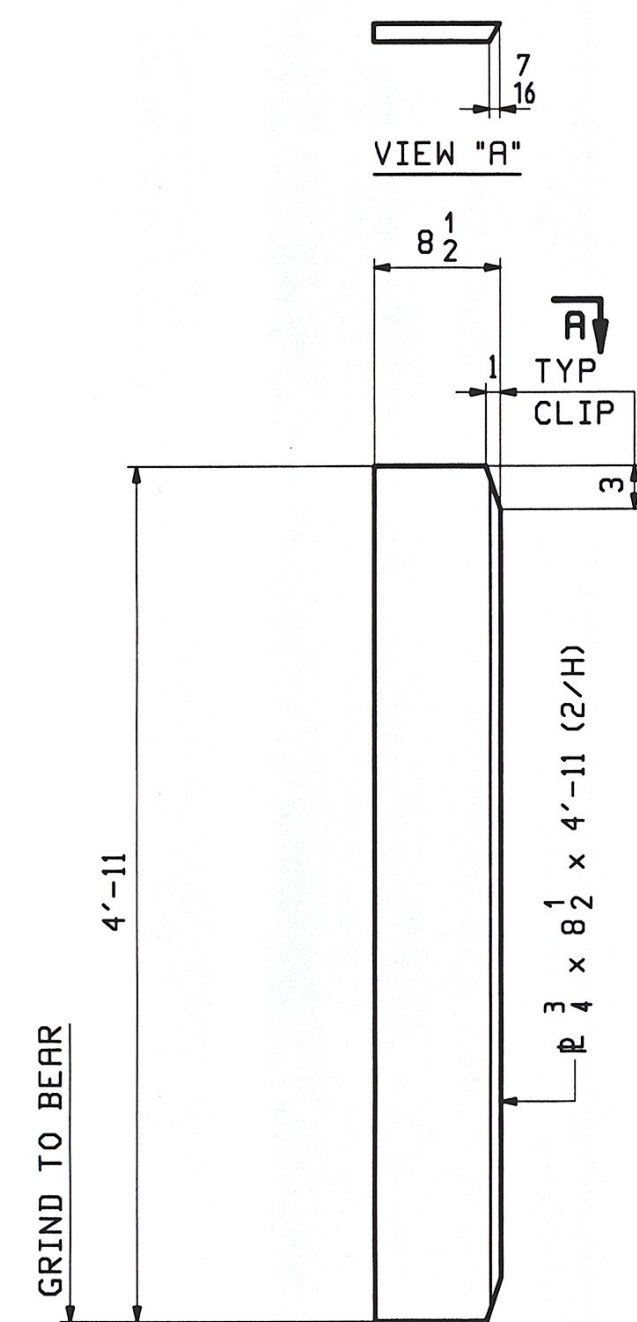


2 - x2a
BRG. STIFF

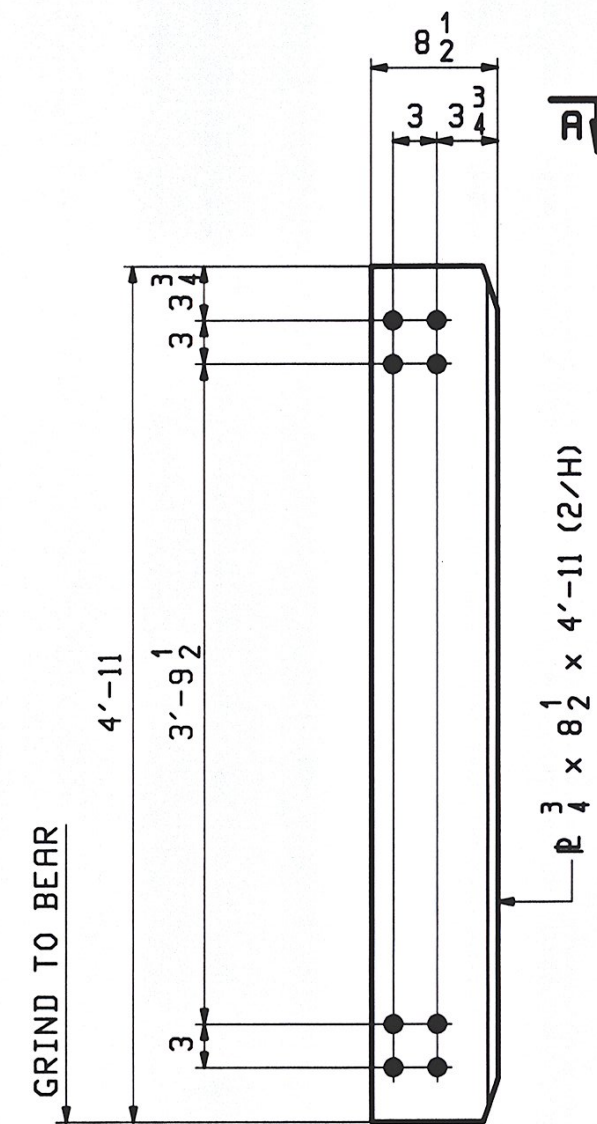


8 - x2b
BRG. STIFF

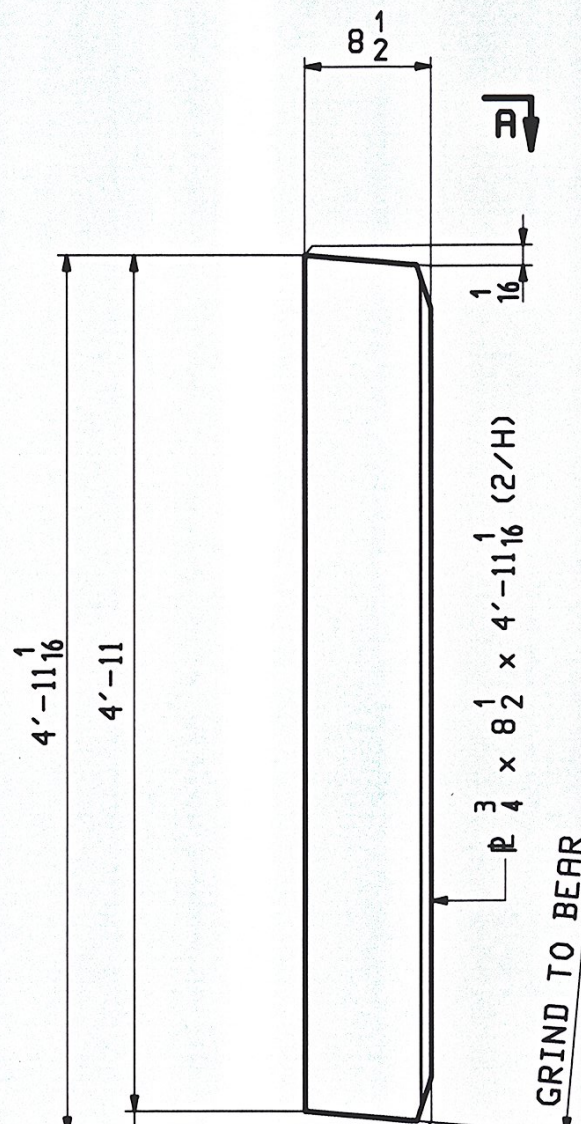


1 - x2c
BRG. STIFF

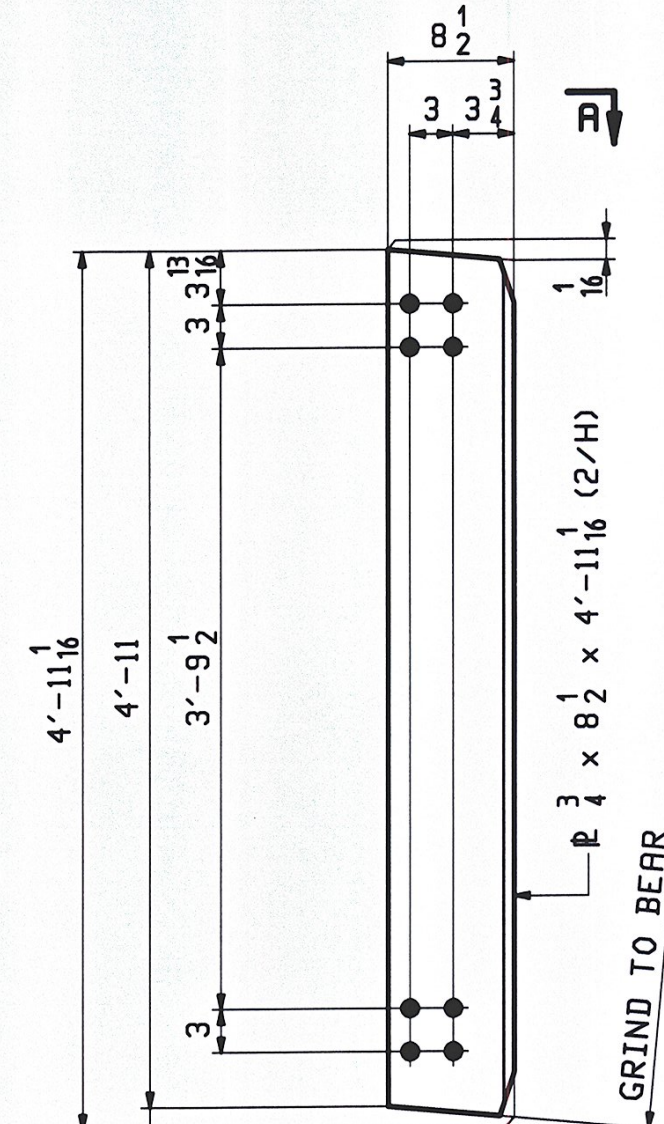


4 - x2d
BRG. STIFF

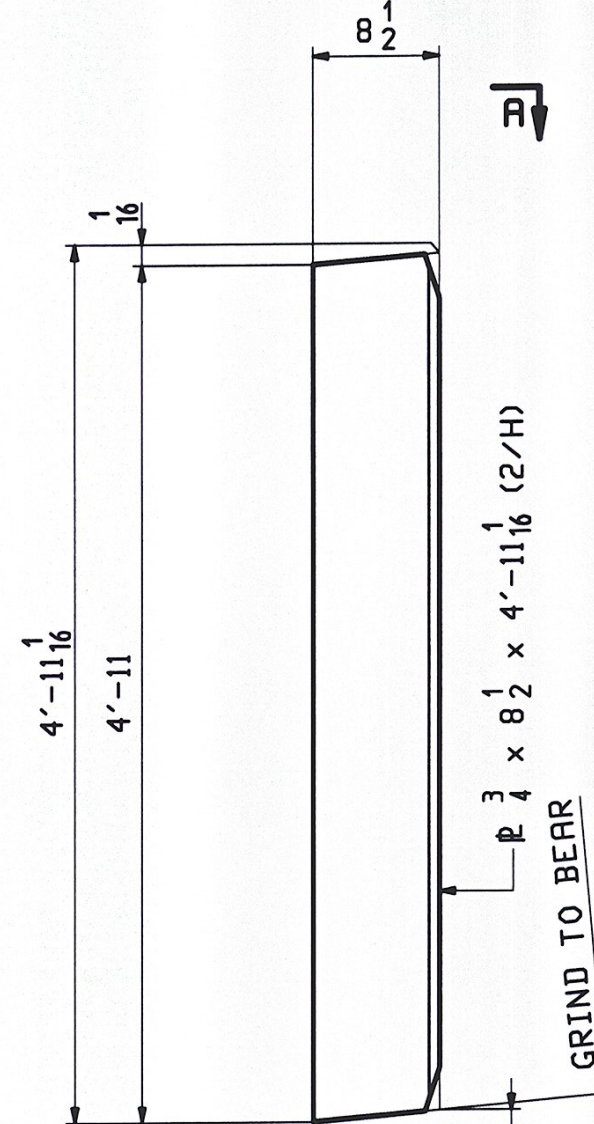


1 - x2f
BRG. STIFF

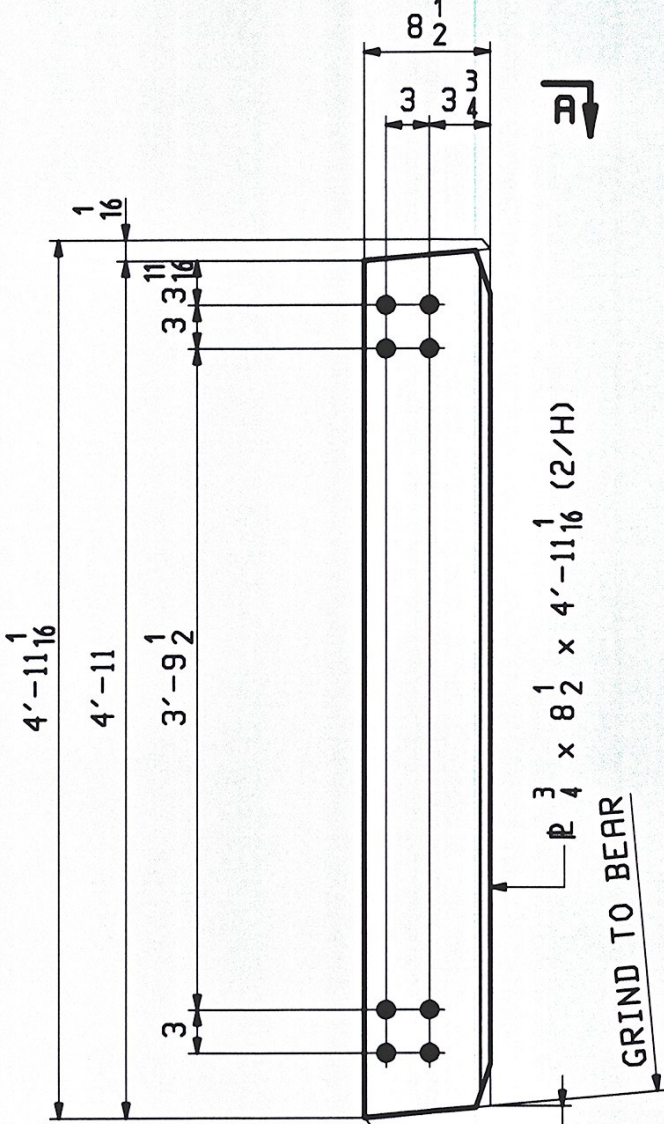


4 - x2g
BRG. STIFF

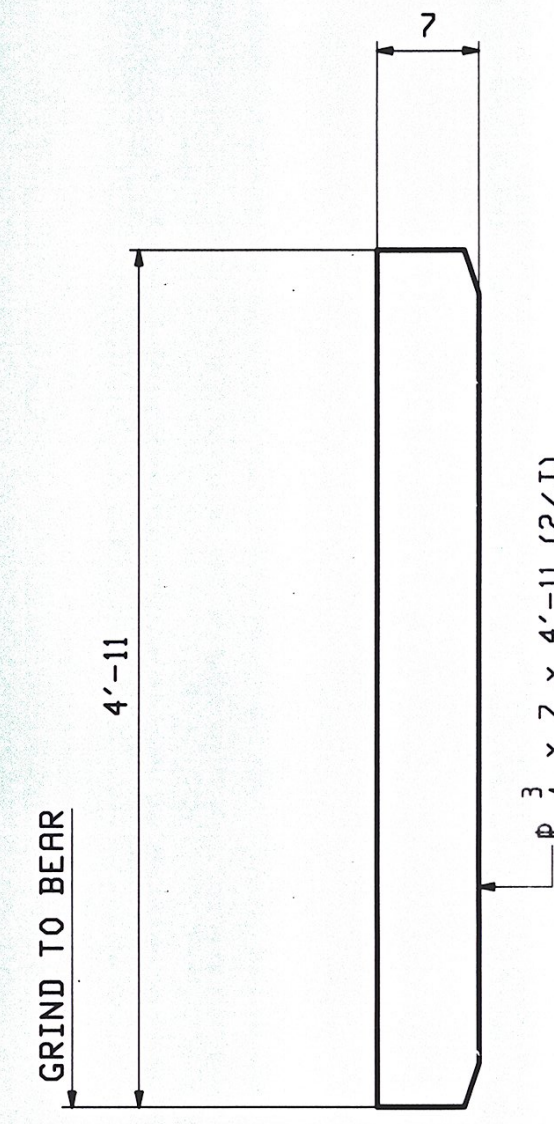


20 - x2h
JACK STIFF

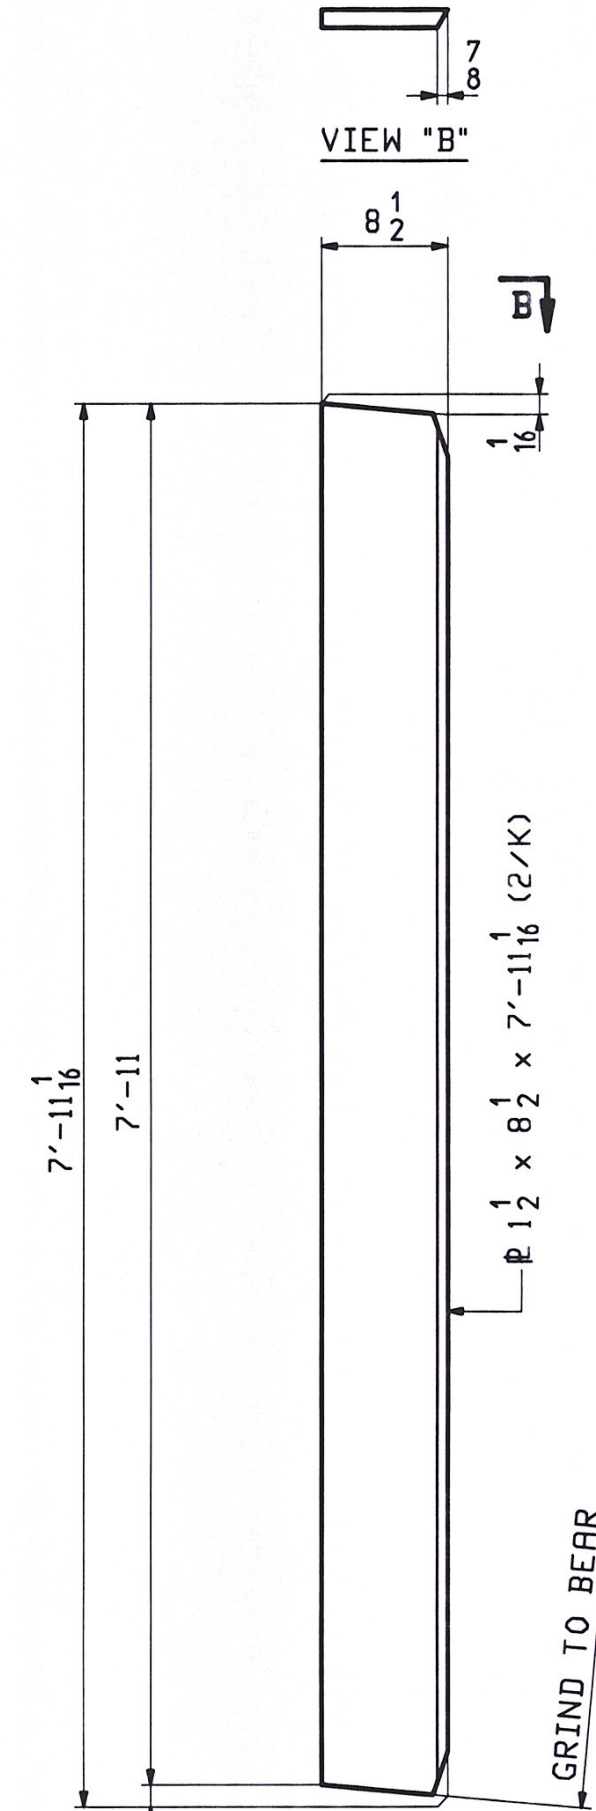


5 - x2k
BRG. STIFF

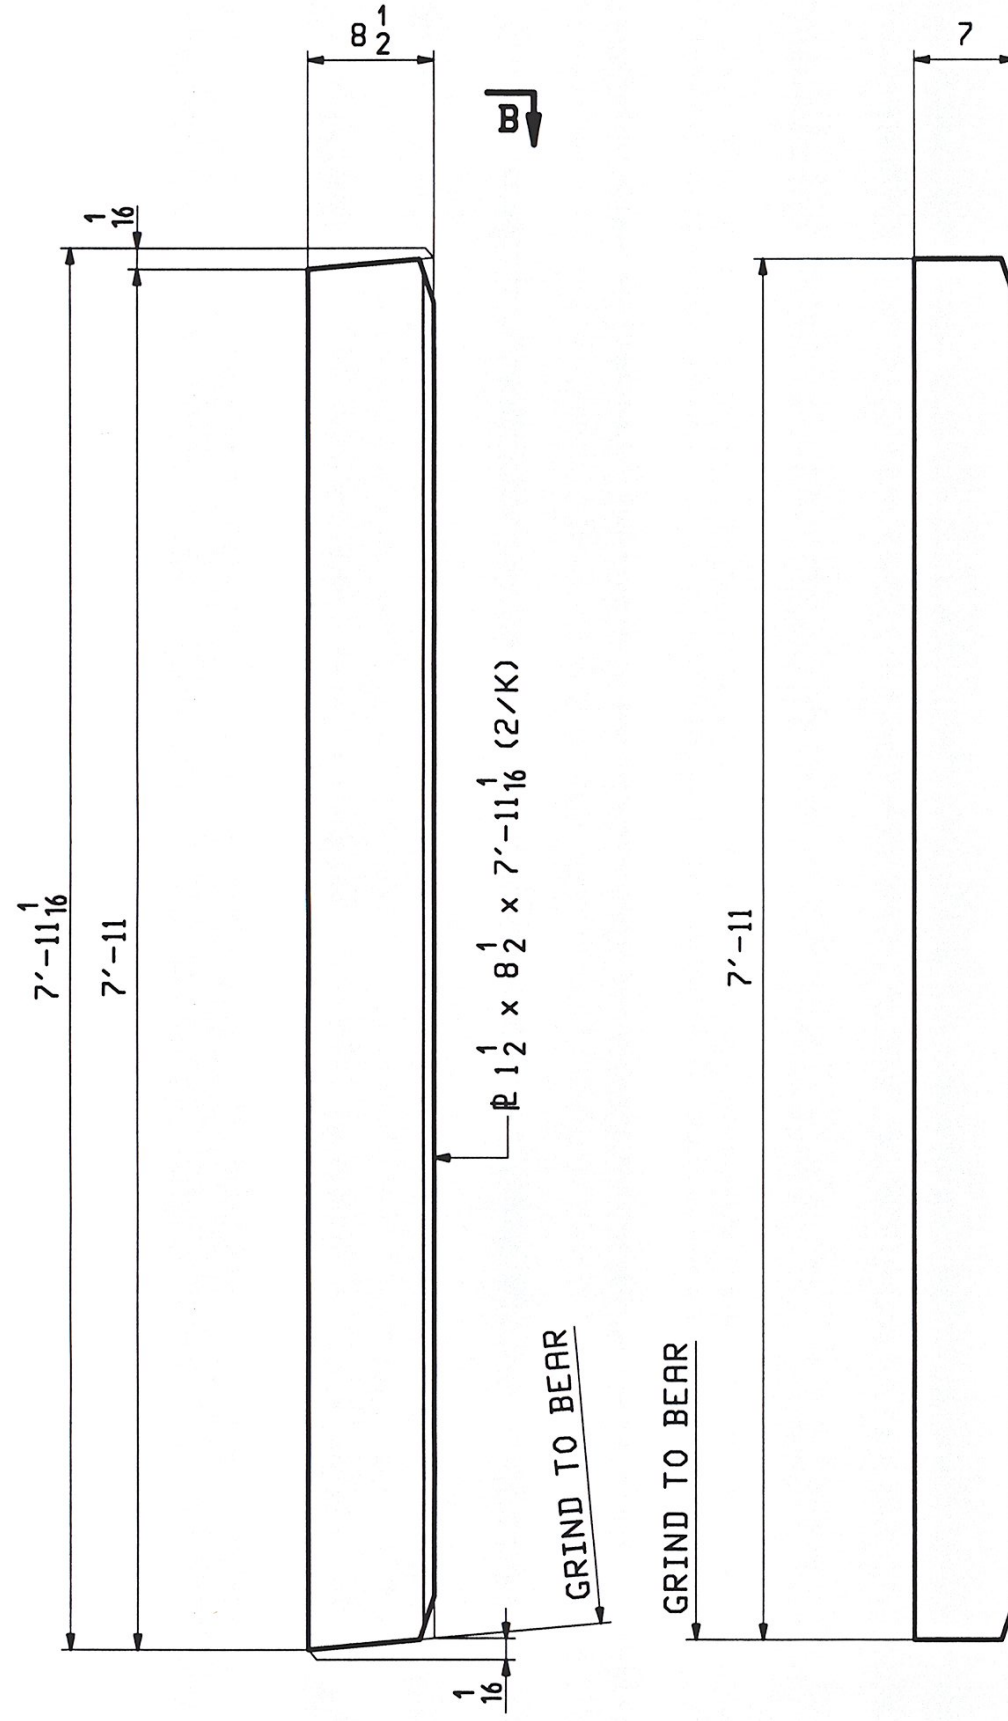


5 - x2m
BRG. STIFF

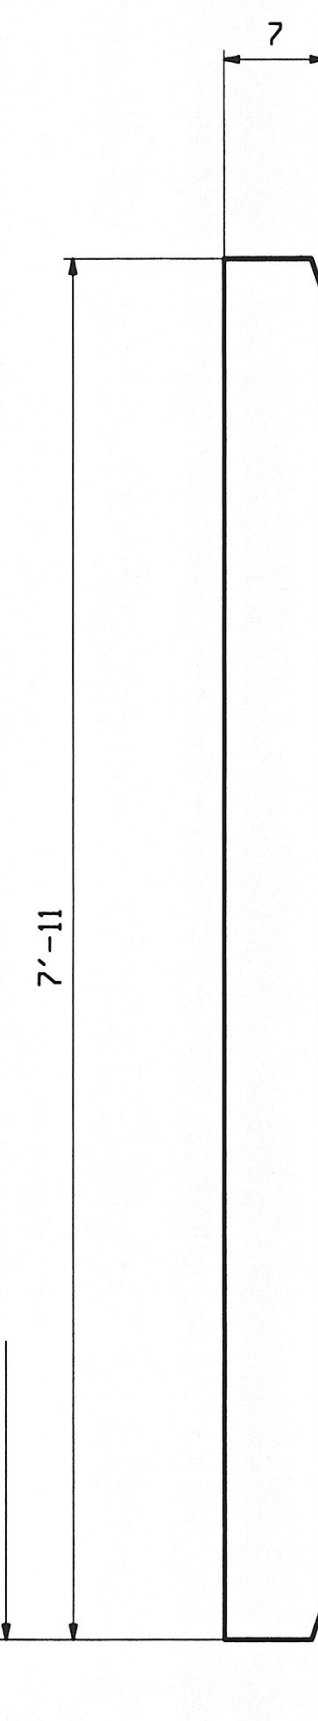


10 - x2n
JACK STIFF

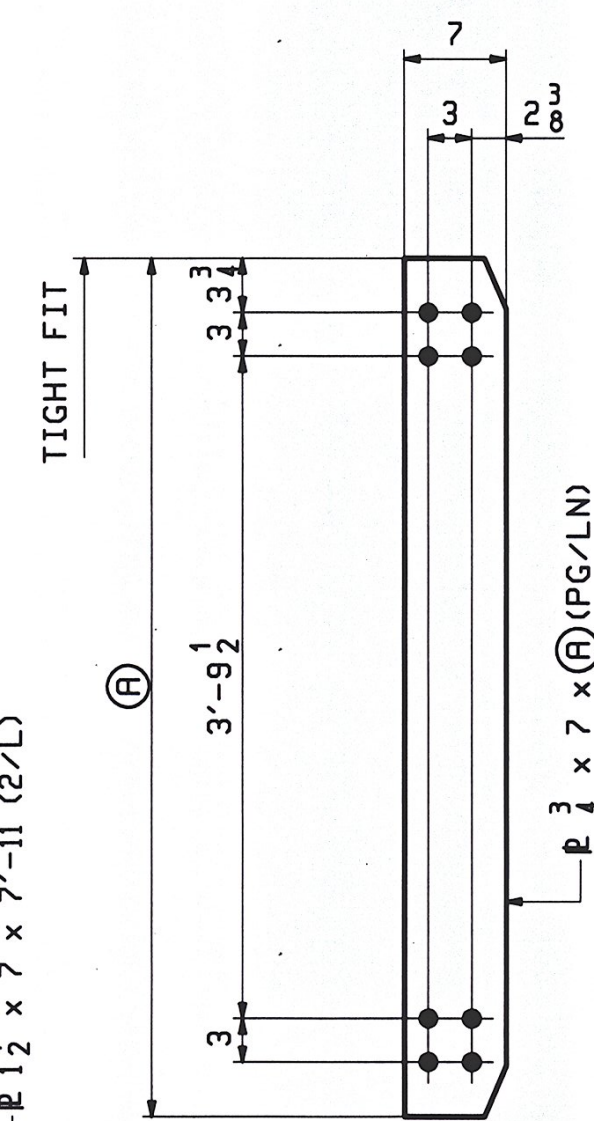


MARK	QTY.	(A)	PG/LN
x2p	112	4'-11	2/M
x2s	8	4'-11 13/16	2/N
x2t	8	5'-1 13/16	2/N

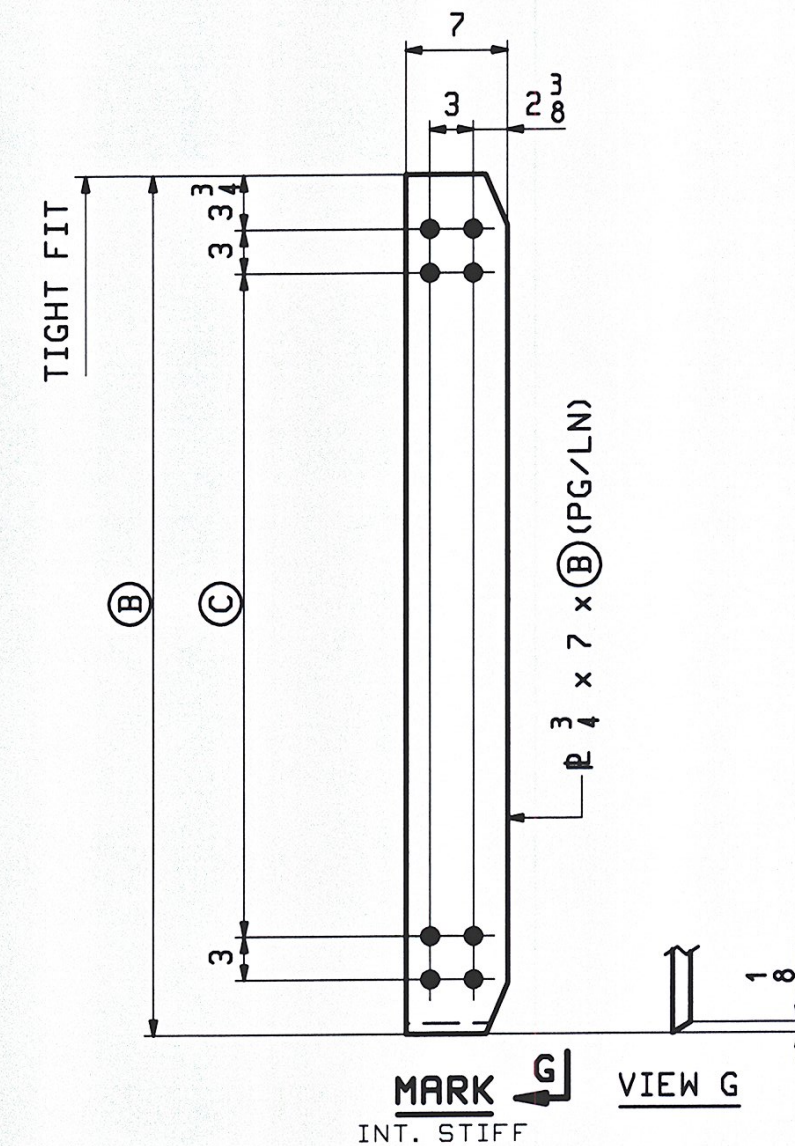


MARK	QTY.	(B)	(C)	PG/LN
x2v	8	6'-9 13/16	5'-1 1/2	2/Q
x2w	8	7'-5 7/8	5'-8 1/4	2/R

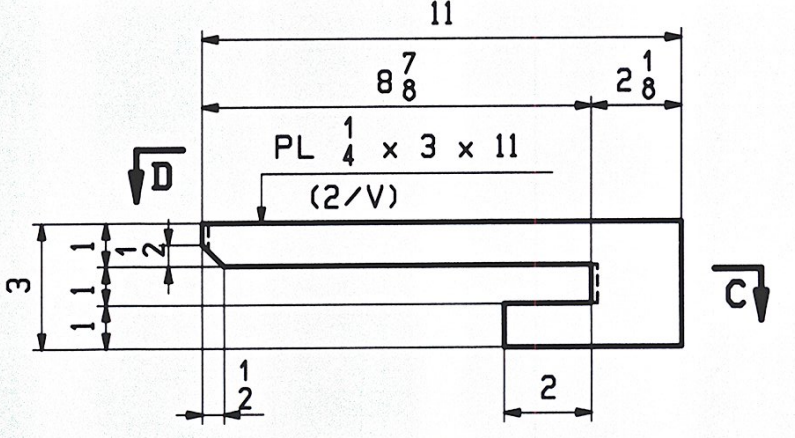


2 - x2ad
DRIP BAR

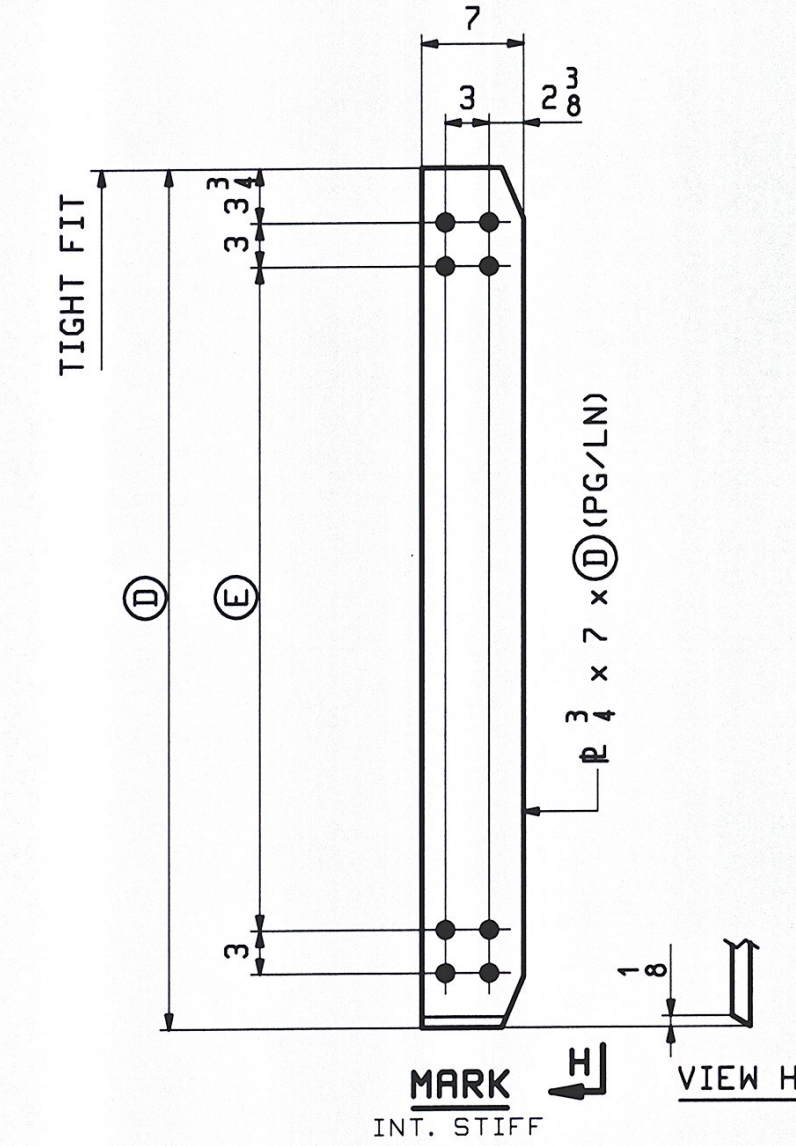


MARK	QTY.	(D)	(E)	PG/LN
x2y	8	6'-3	5'-1 1/2	2/P
x2aa	8	6'-9 13/16	5'-8 1/4	2/Q

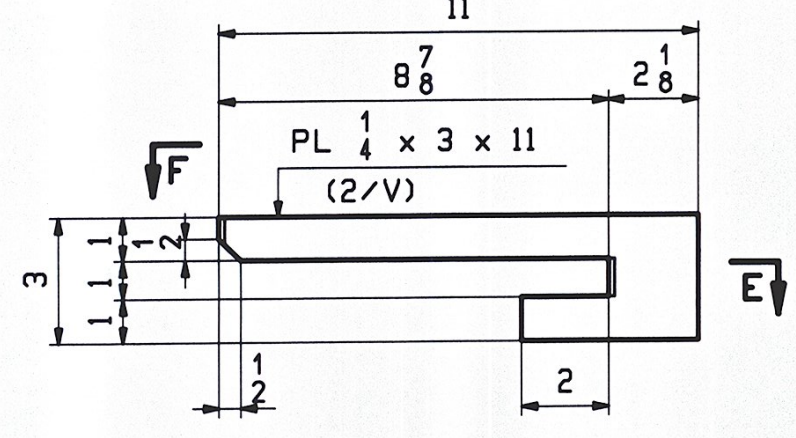

2 - x2af
DRIP BAR

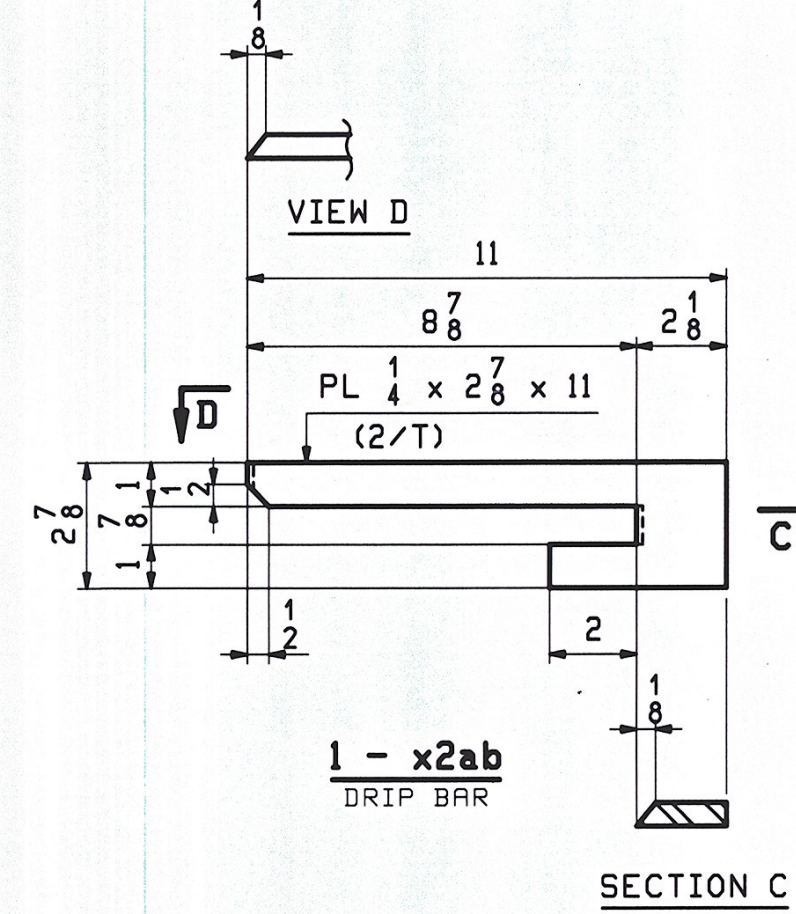

1 - x2ab
DRIP BAR

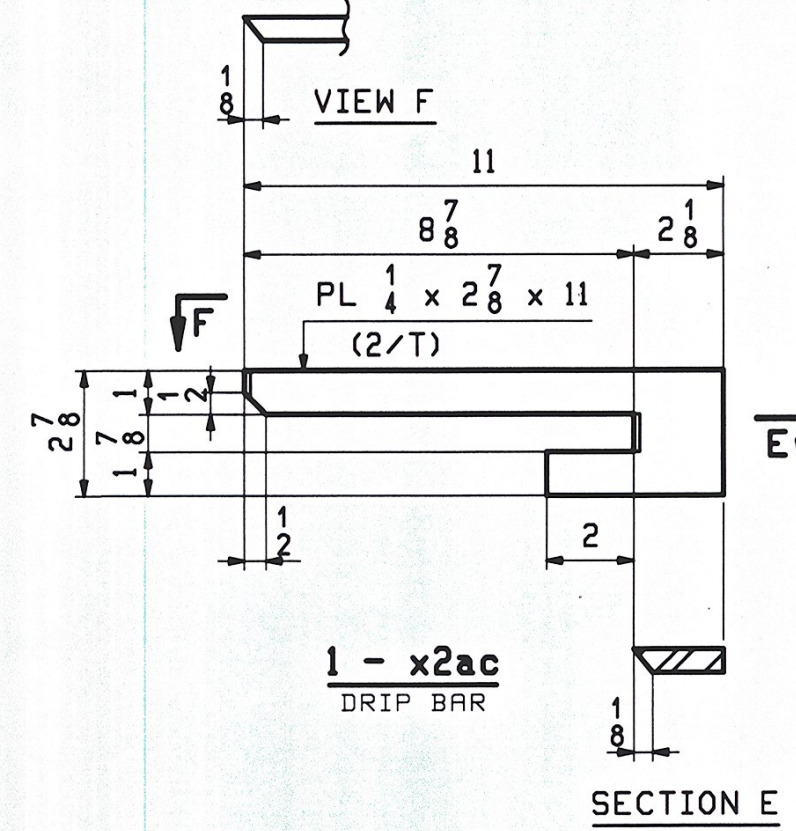

1 - x2ac
DRIP BAR

NOTES:
FOR GENERAL NOTES SEE DRAWING GNI.

	10/19	ADDED x2ad & x2af PER APPR.	WJF	PCP	REV 0 2 2009		
					REV 7 2009		
REV.	DATE	REMARKS	DWN	CHK	APVL	SHOP	
MATERIAL:	M270-50W	SURFACE PREP. & PAINT:	SEE GNI	HOLES:	15 16 ∅	SHOP BOLTS:	NONE
DESCRIPTION: GIRDER STANDARDS							
CASCO BAY STEEL STRUCTURES, INC.							
75 SPRING HILL ROAD SACO, MAINE 04072							
PHONE (207) 282-7360 FAX. (207) 282-1179							
							
STRUCTURE: US RTE 2 OVER WINOOSKI RIVER WASHINGTON COUNTY, VT				DRAWN:		DATE:	
				WJF		08/11	
				CHKD:		DATE:	
				PCP		08/17	
LOCATION: TOWNS OF MORETOWN ~ MIDDLESEX, VT				JOB NO.		DWG NO.	
PROJ NO. BRS 0284(14)				421-1		X2	
CUSTOMER: WINTERSET INC.						REV.	