

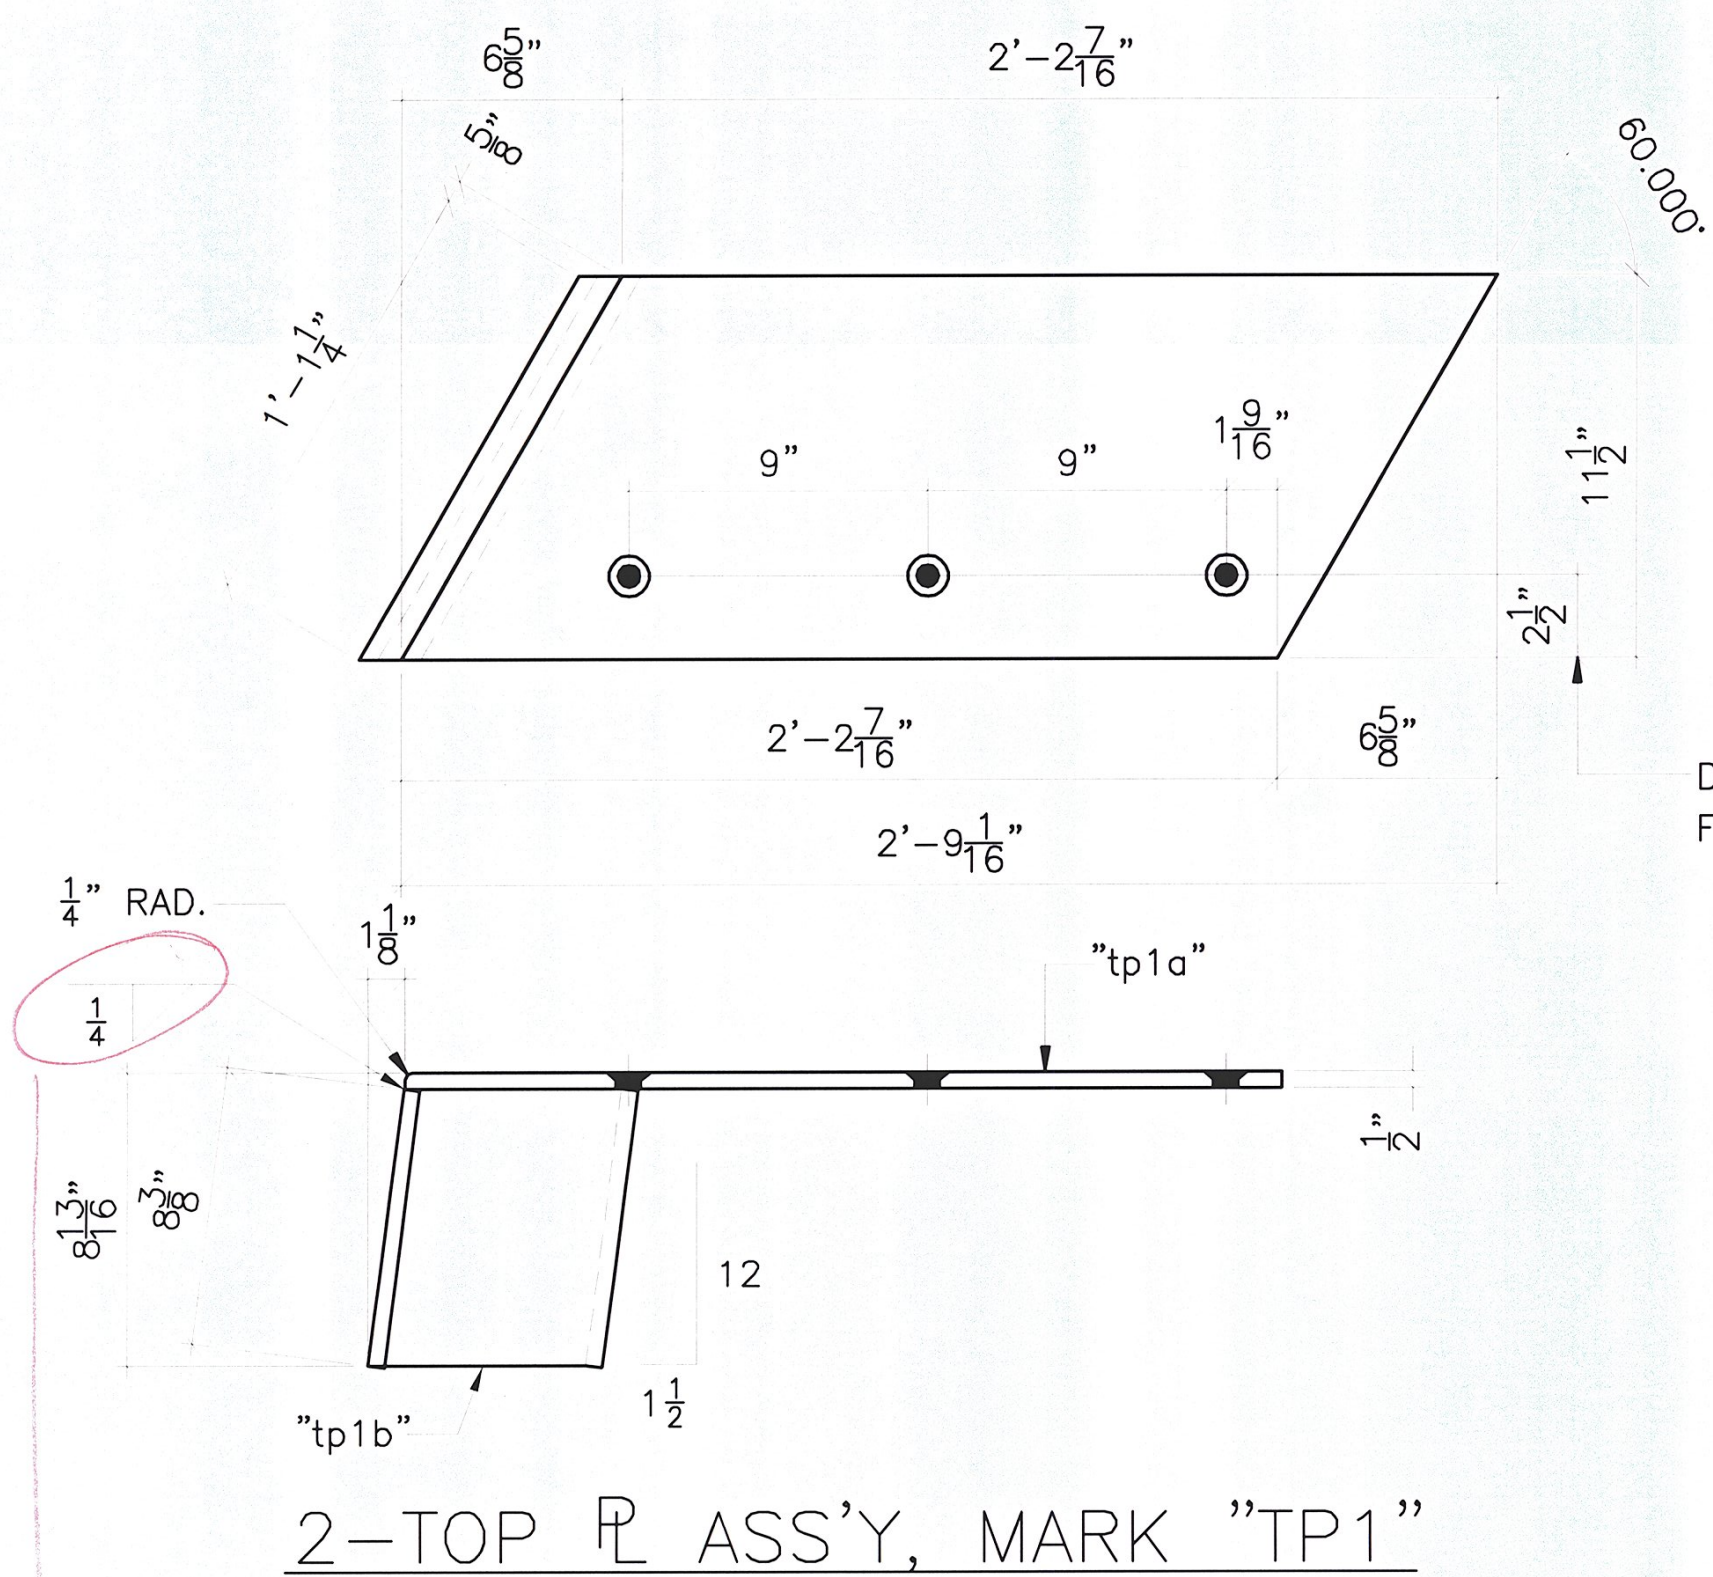
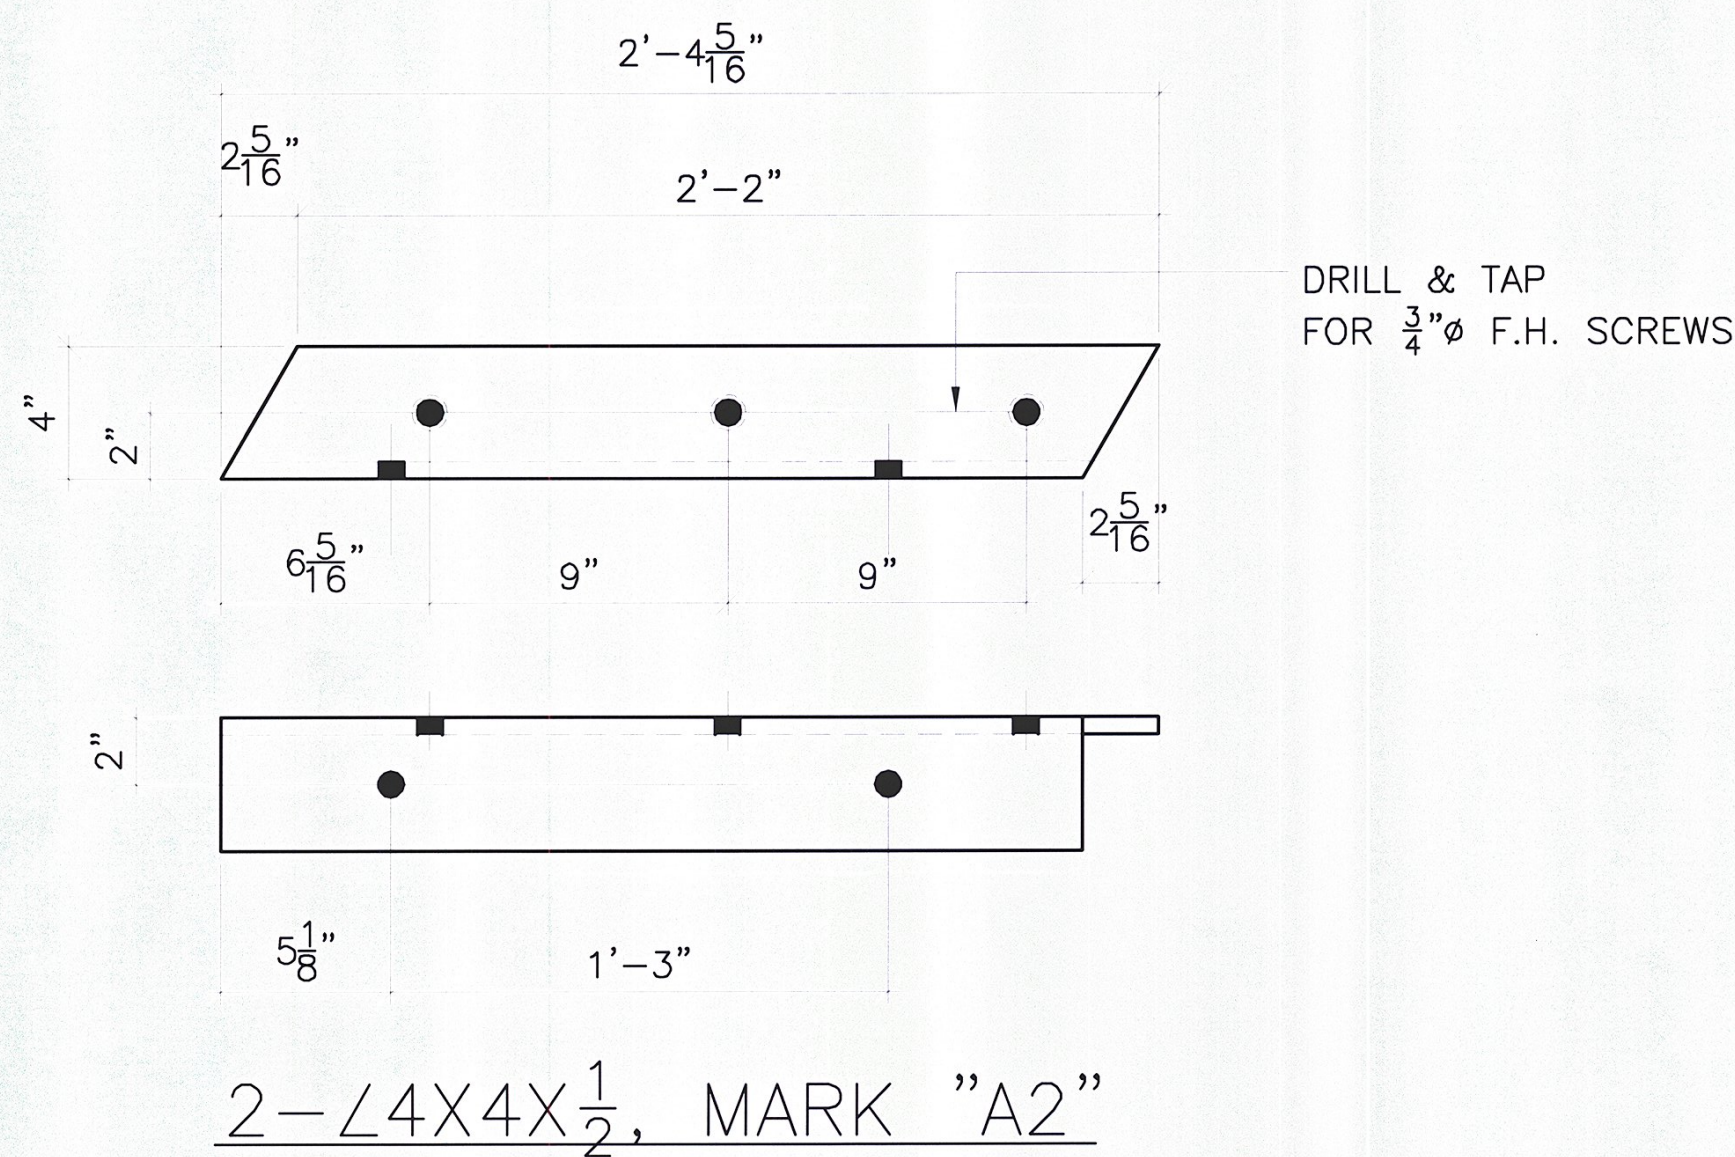
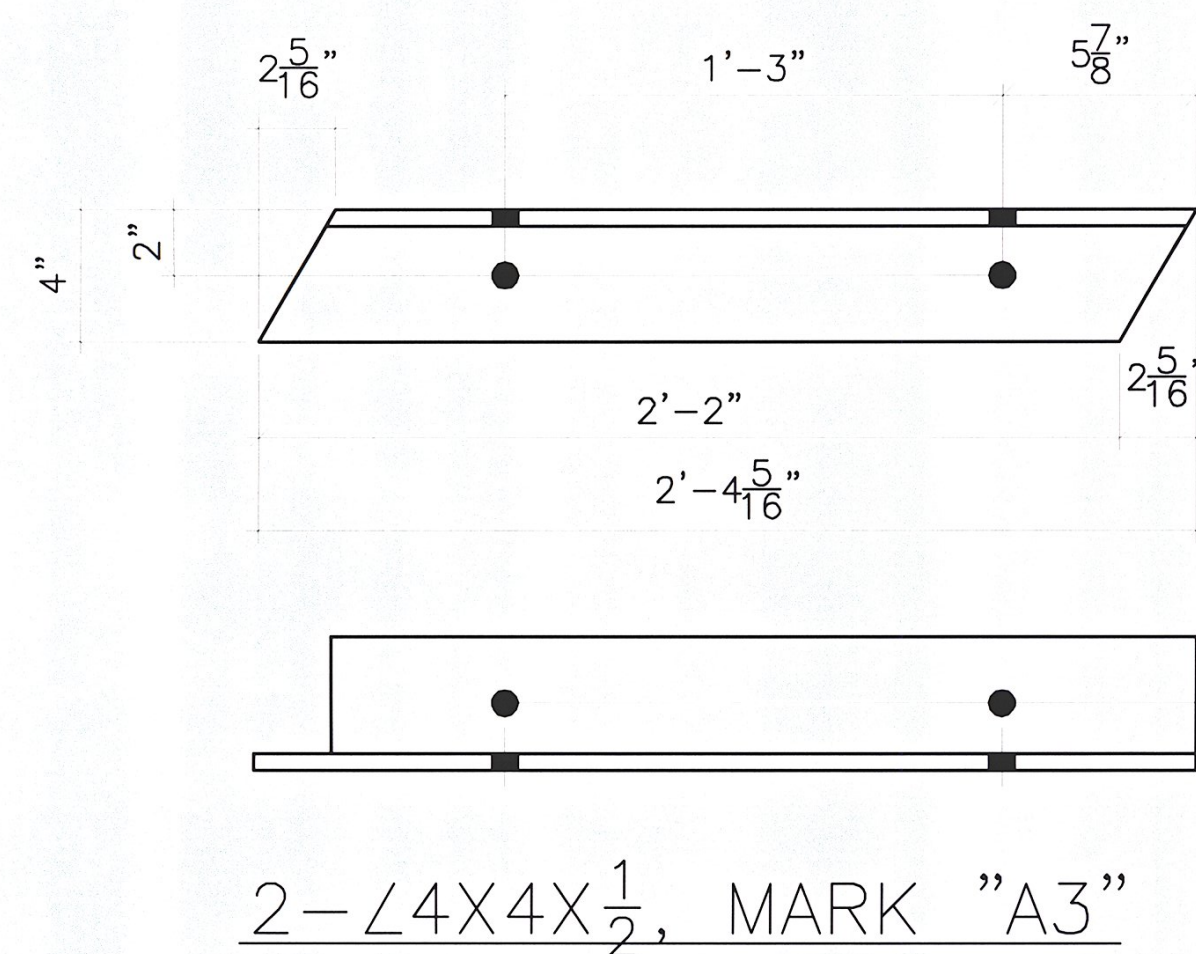
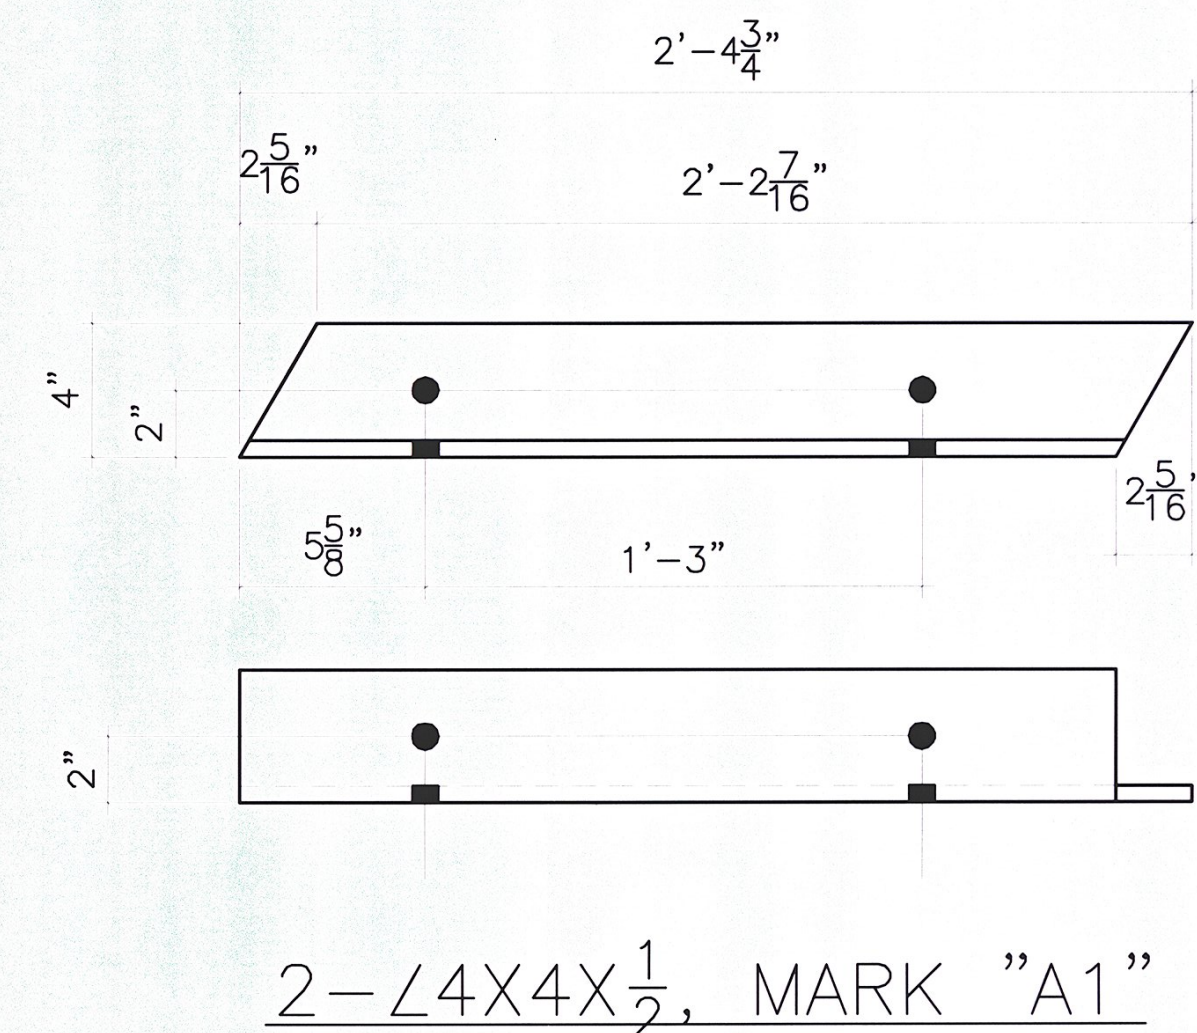
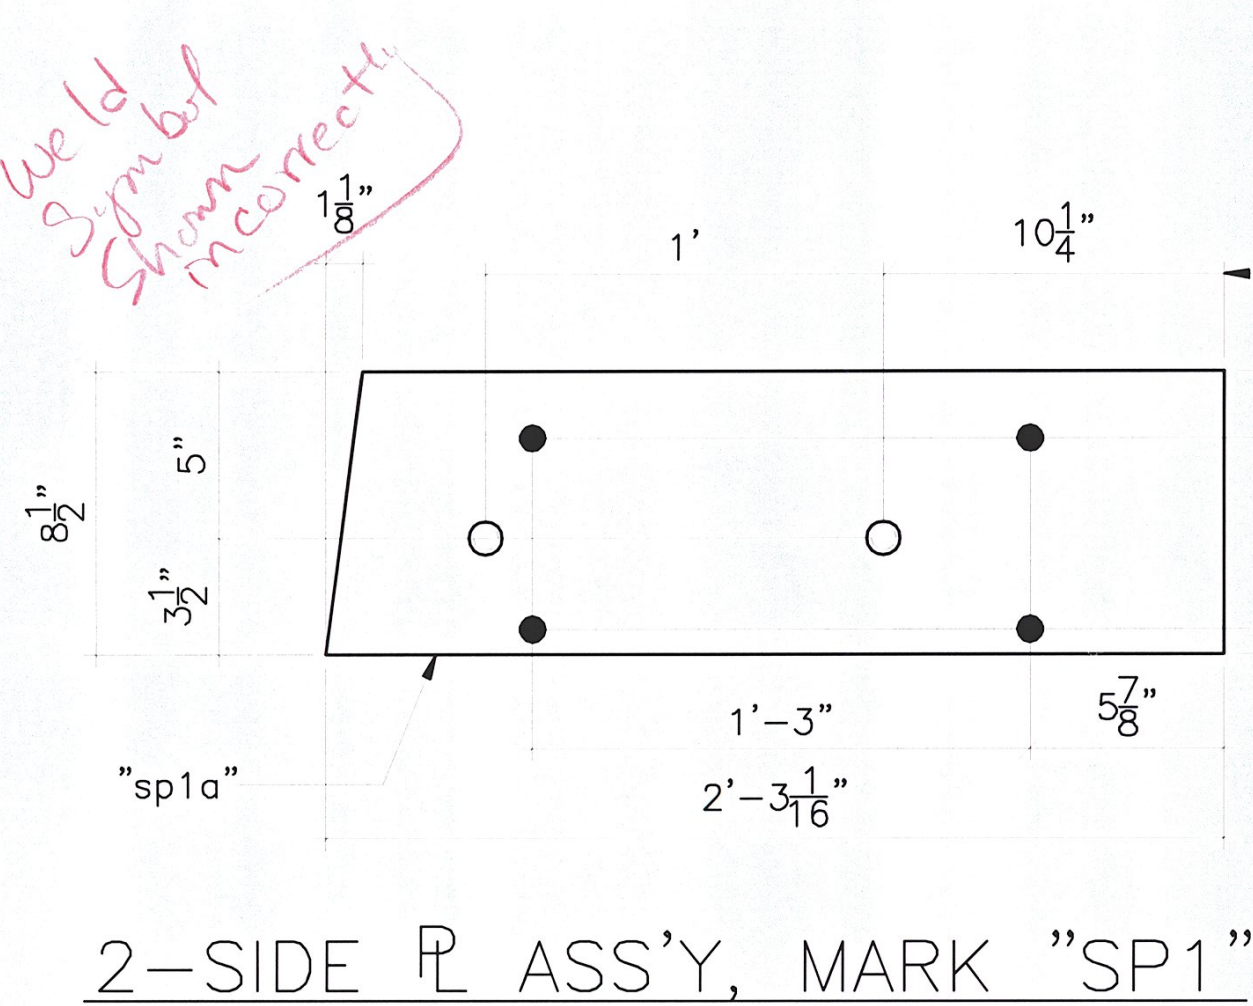


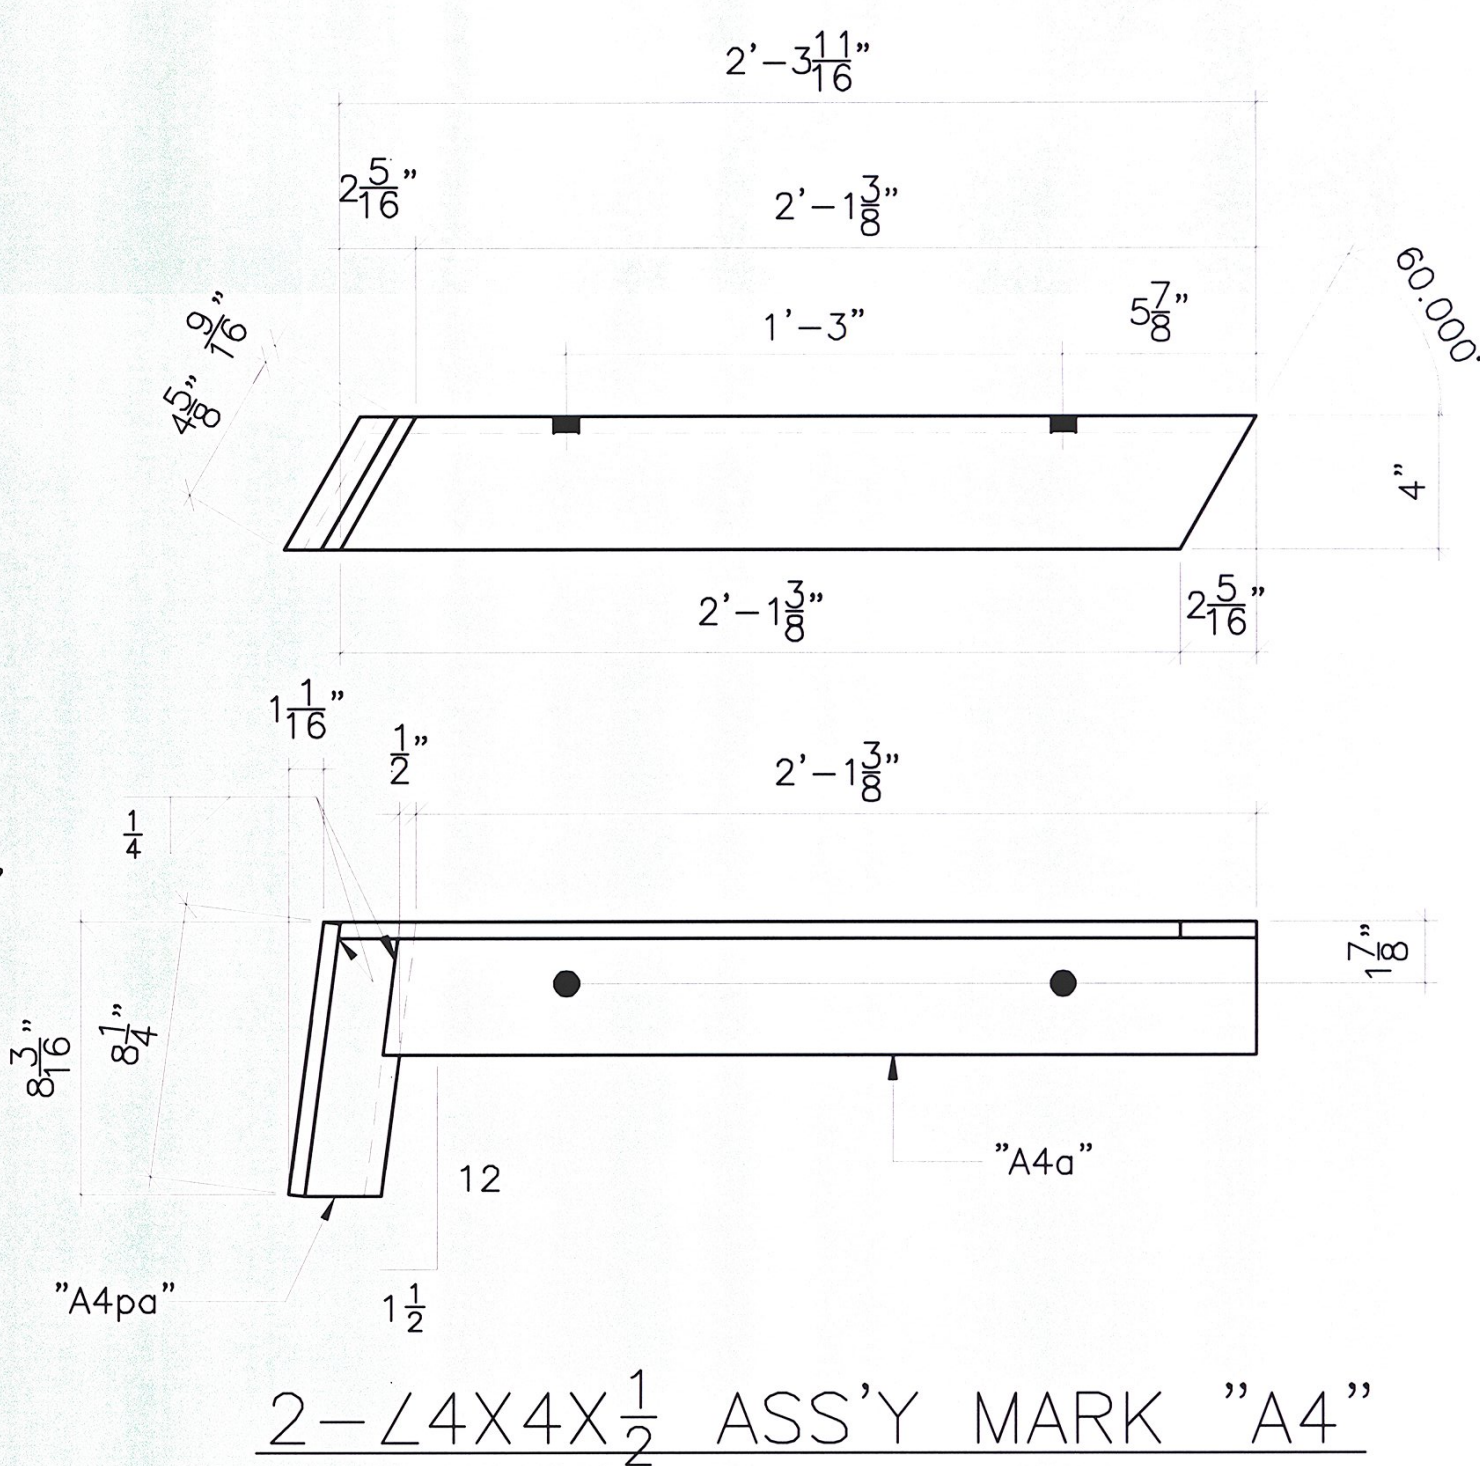

DRILL & CNTRSK
FOR 3/4" F.H. SCREWS

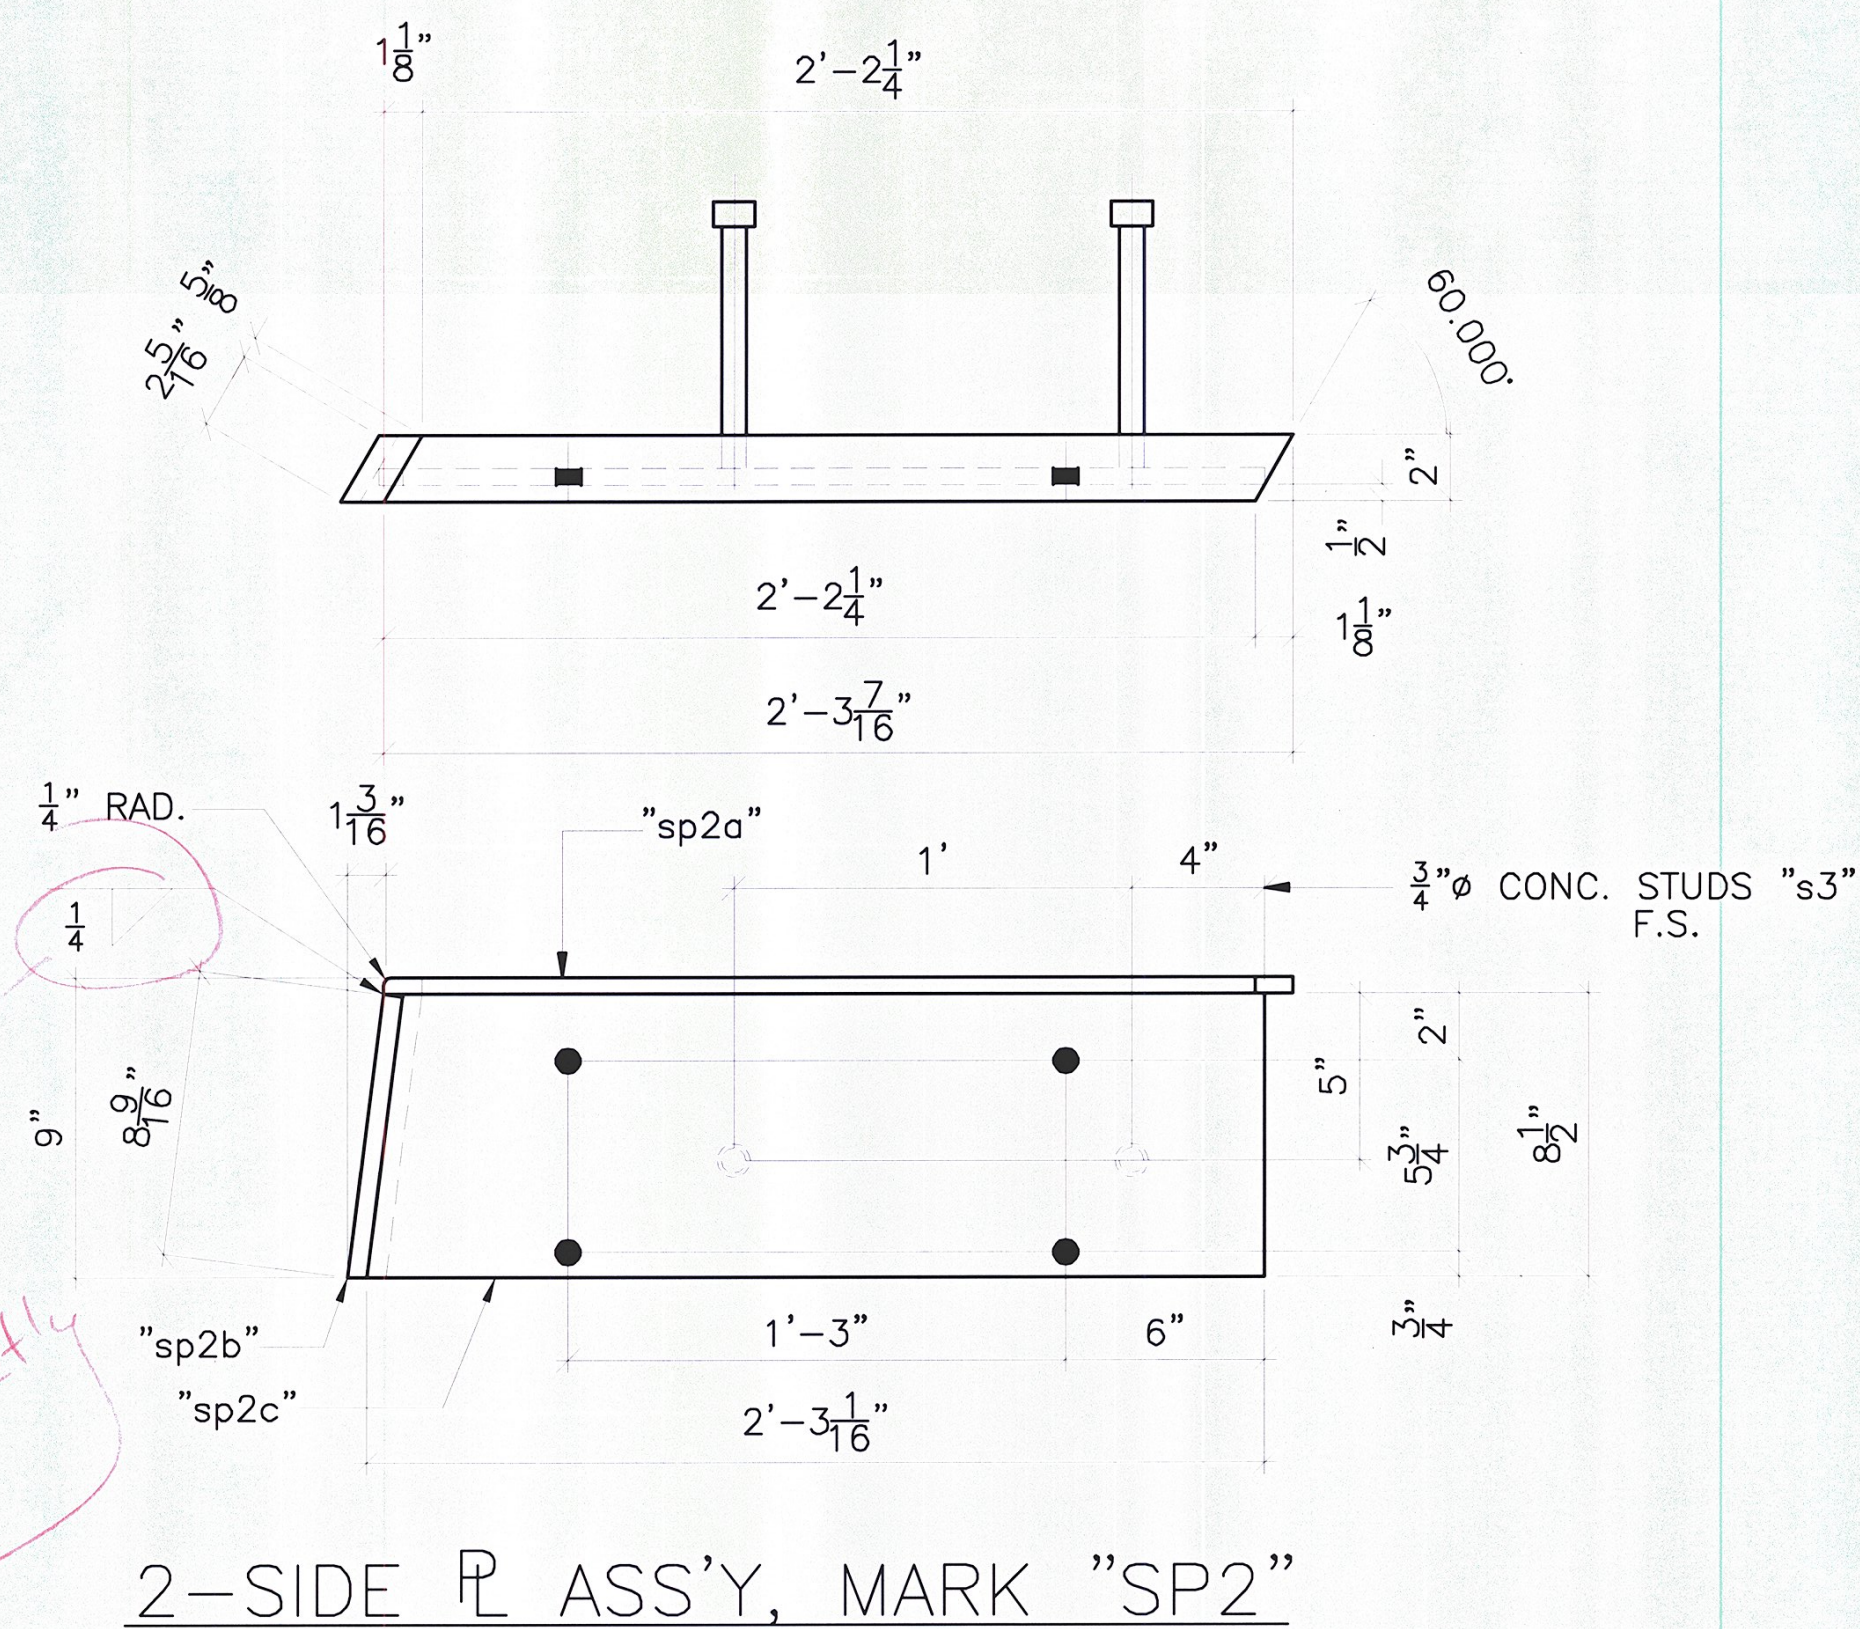

WORK THIS DWG. WITH DWG. 5

RECEIVED
CK'D BY SSS OK'D BY MEM
JAN 20 2010
RESUBMIT APPROVED AS NOTED
BY DATE 2/5/2010

ERECTION BOLTS W/H.H.N.				WASHERS		FINISH	
QUAN.	SIZE	LENGTH	TYPE	FLAT	BEV.	GALV.	AASHTO M232
FINISH MATERIAL			HOT DIPPED GALVANIZED				
HOLES			AASHTO M270 GR. 36				
ELECTRODES			13/16" U.O.N.				
WELDS			PER W.P.S.				
SURFACE PREP			AS NOTED				
			SSPC-SP8				
				NO	DATE	DESCRIPTION	BY
REVISIONS							
				ADVANCED RESOURCES & CONST. ENTERPRISES, INCORPORATED P.O. BOX 120 KINGFIELD, ME. 04947 PHONE: (207) 265-2646 - FAX: (207) 265-4054			
DRAFTER JAC		EXPANSION JOINT DETAILS				PROJECT NO.	
DATE 1/8/10		VERMONT AGENCY OF TRANSPORTATION, TOWNS OF MORETOWN-MIDDLESEX, U.S. RTE. 2 MAJOR COLL.				BRS 0284(14)	
CHECKED MTD		G.C. WINTERSSET, INC.				DWG. NO.	
JOB #09-200						6	