


DATE: 07/92
BY: [signature]
CHECKED: [signature]
NO.

DATE: 07/92
BY: [signature]
CHECKED: [signature]
NO.

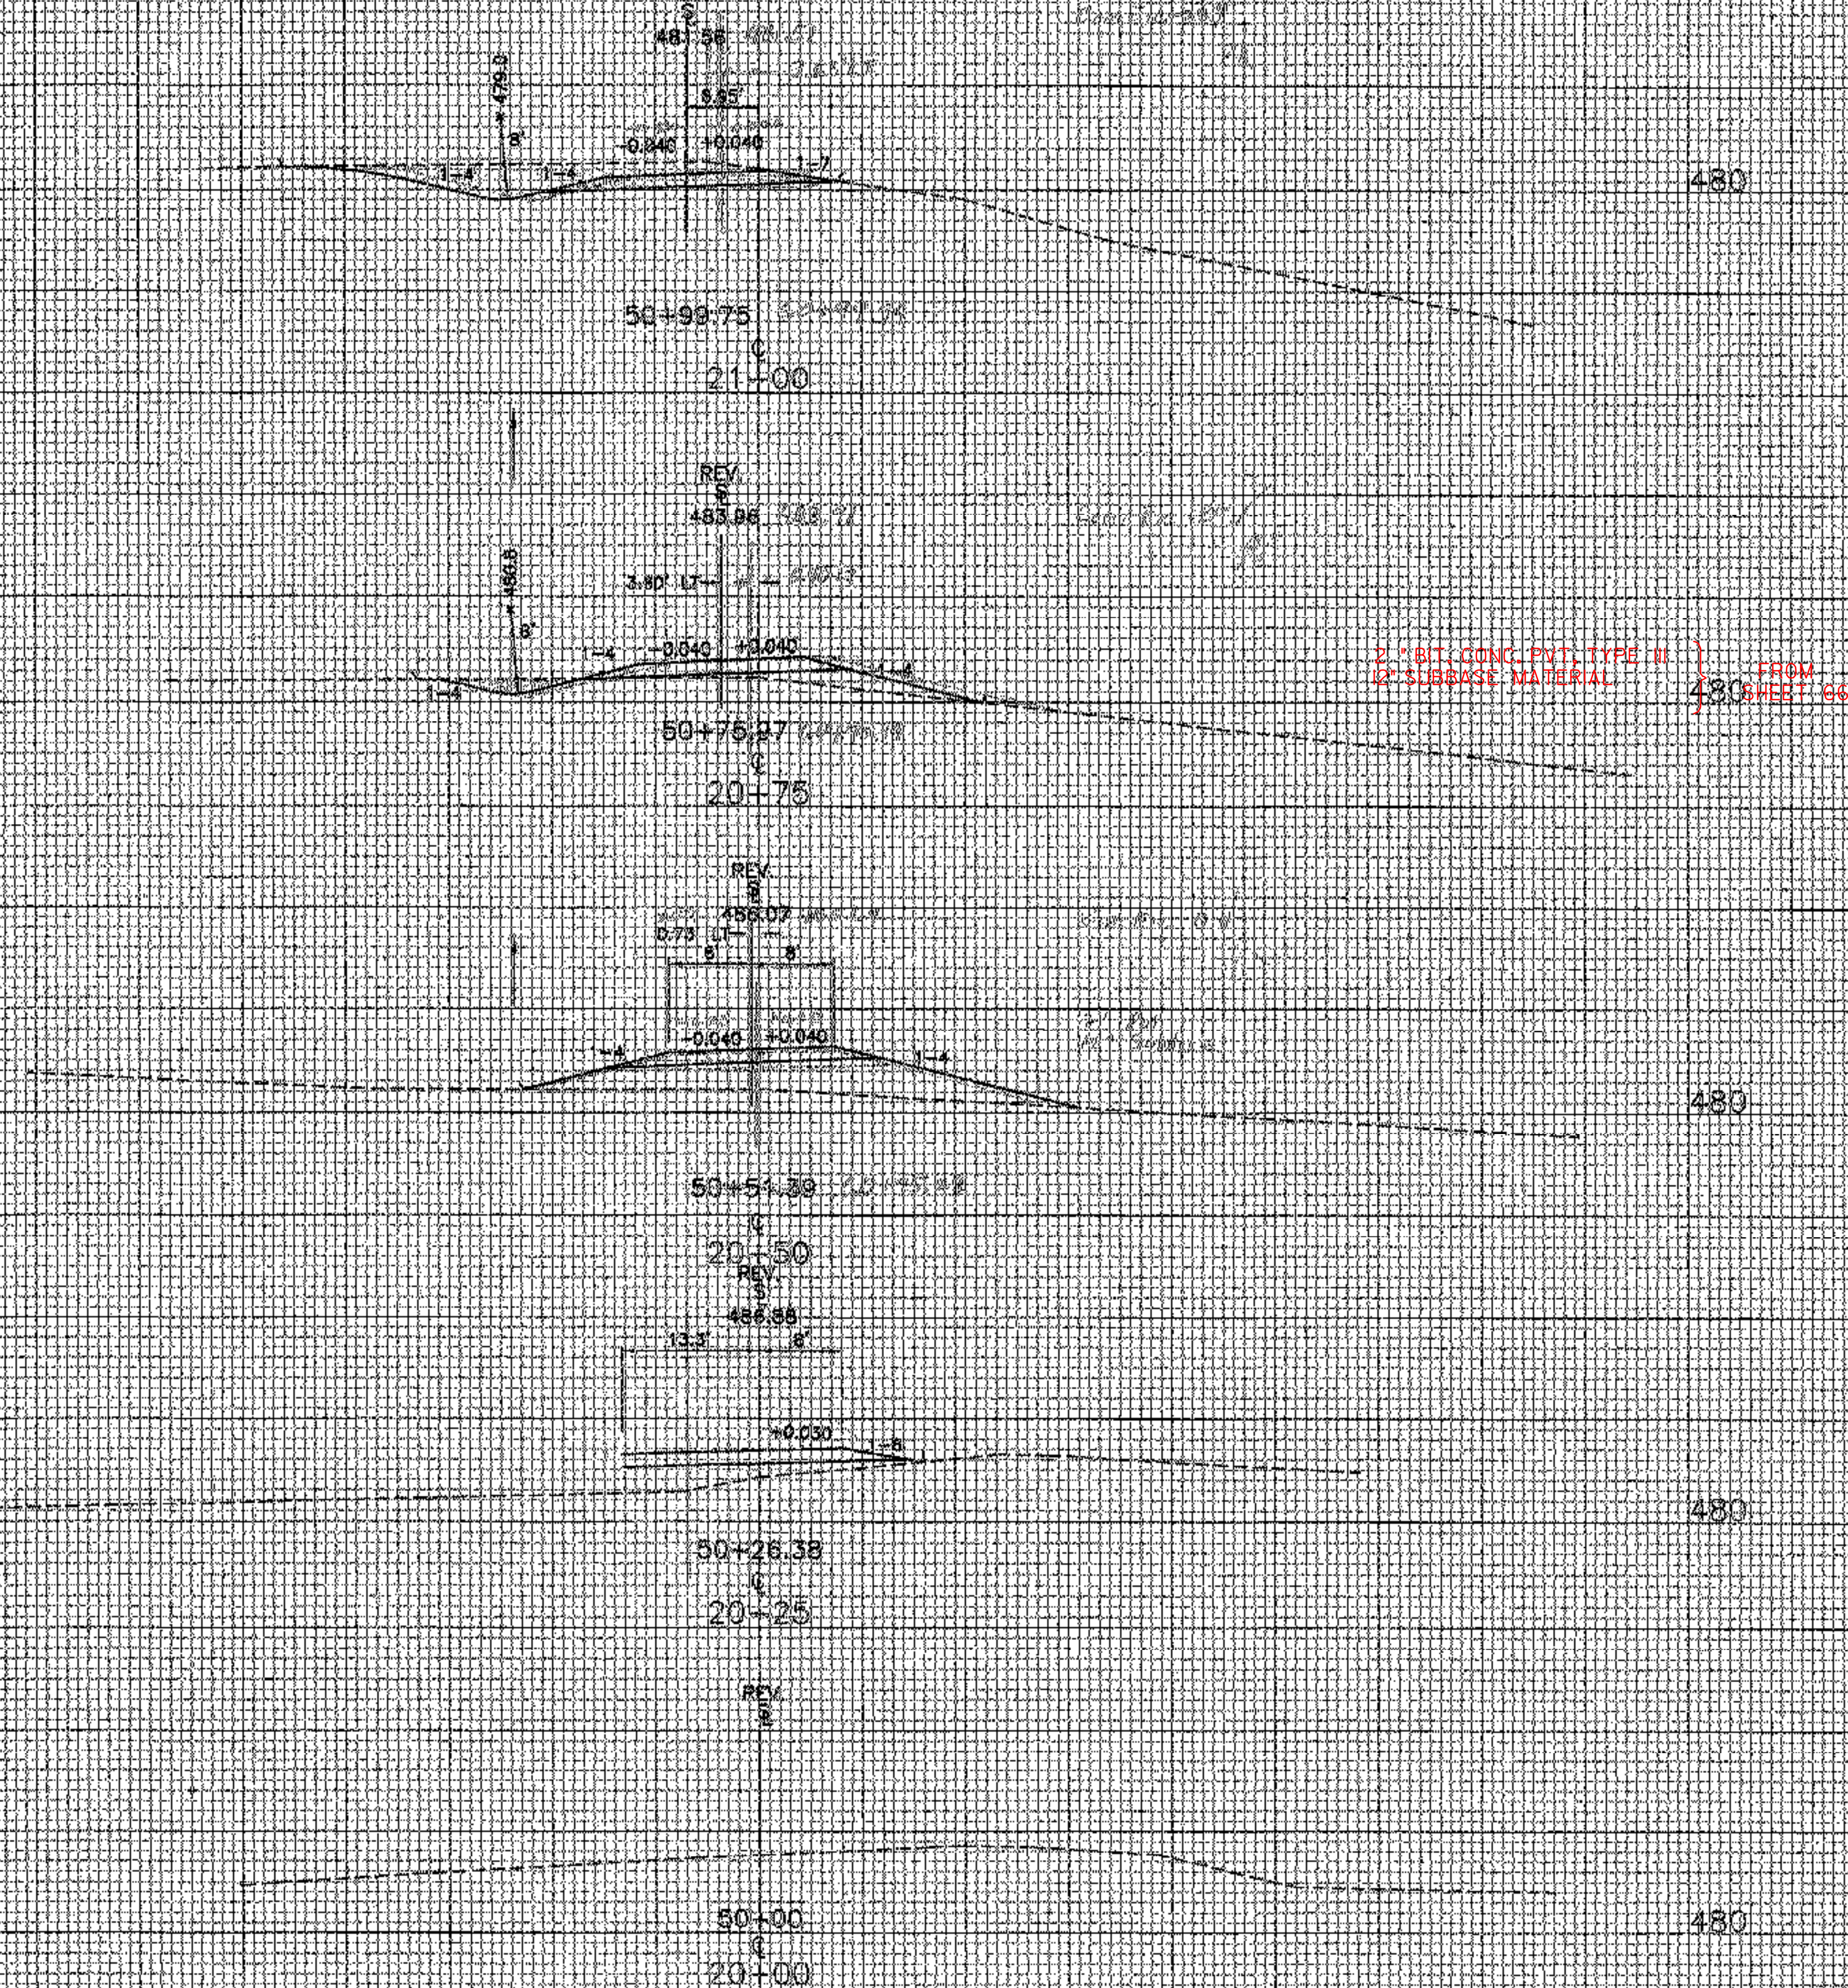

SCALE 10 FEET

REV. \$ 50+00 TO 50+99.75			
FROM STA.	20+00	TO STA.	21+00
PROJECT NAME	ROYALTON DRIVE		
NO.	OPS 01475/S		
SURVEYED BY	CLO		
SHEET	69	OF	78 SHEETS
PLOTTED 07/92			
JULY 1993			

0.5" x 1.5" = 1'