

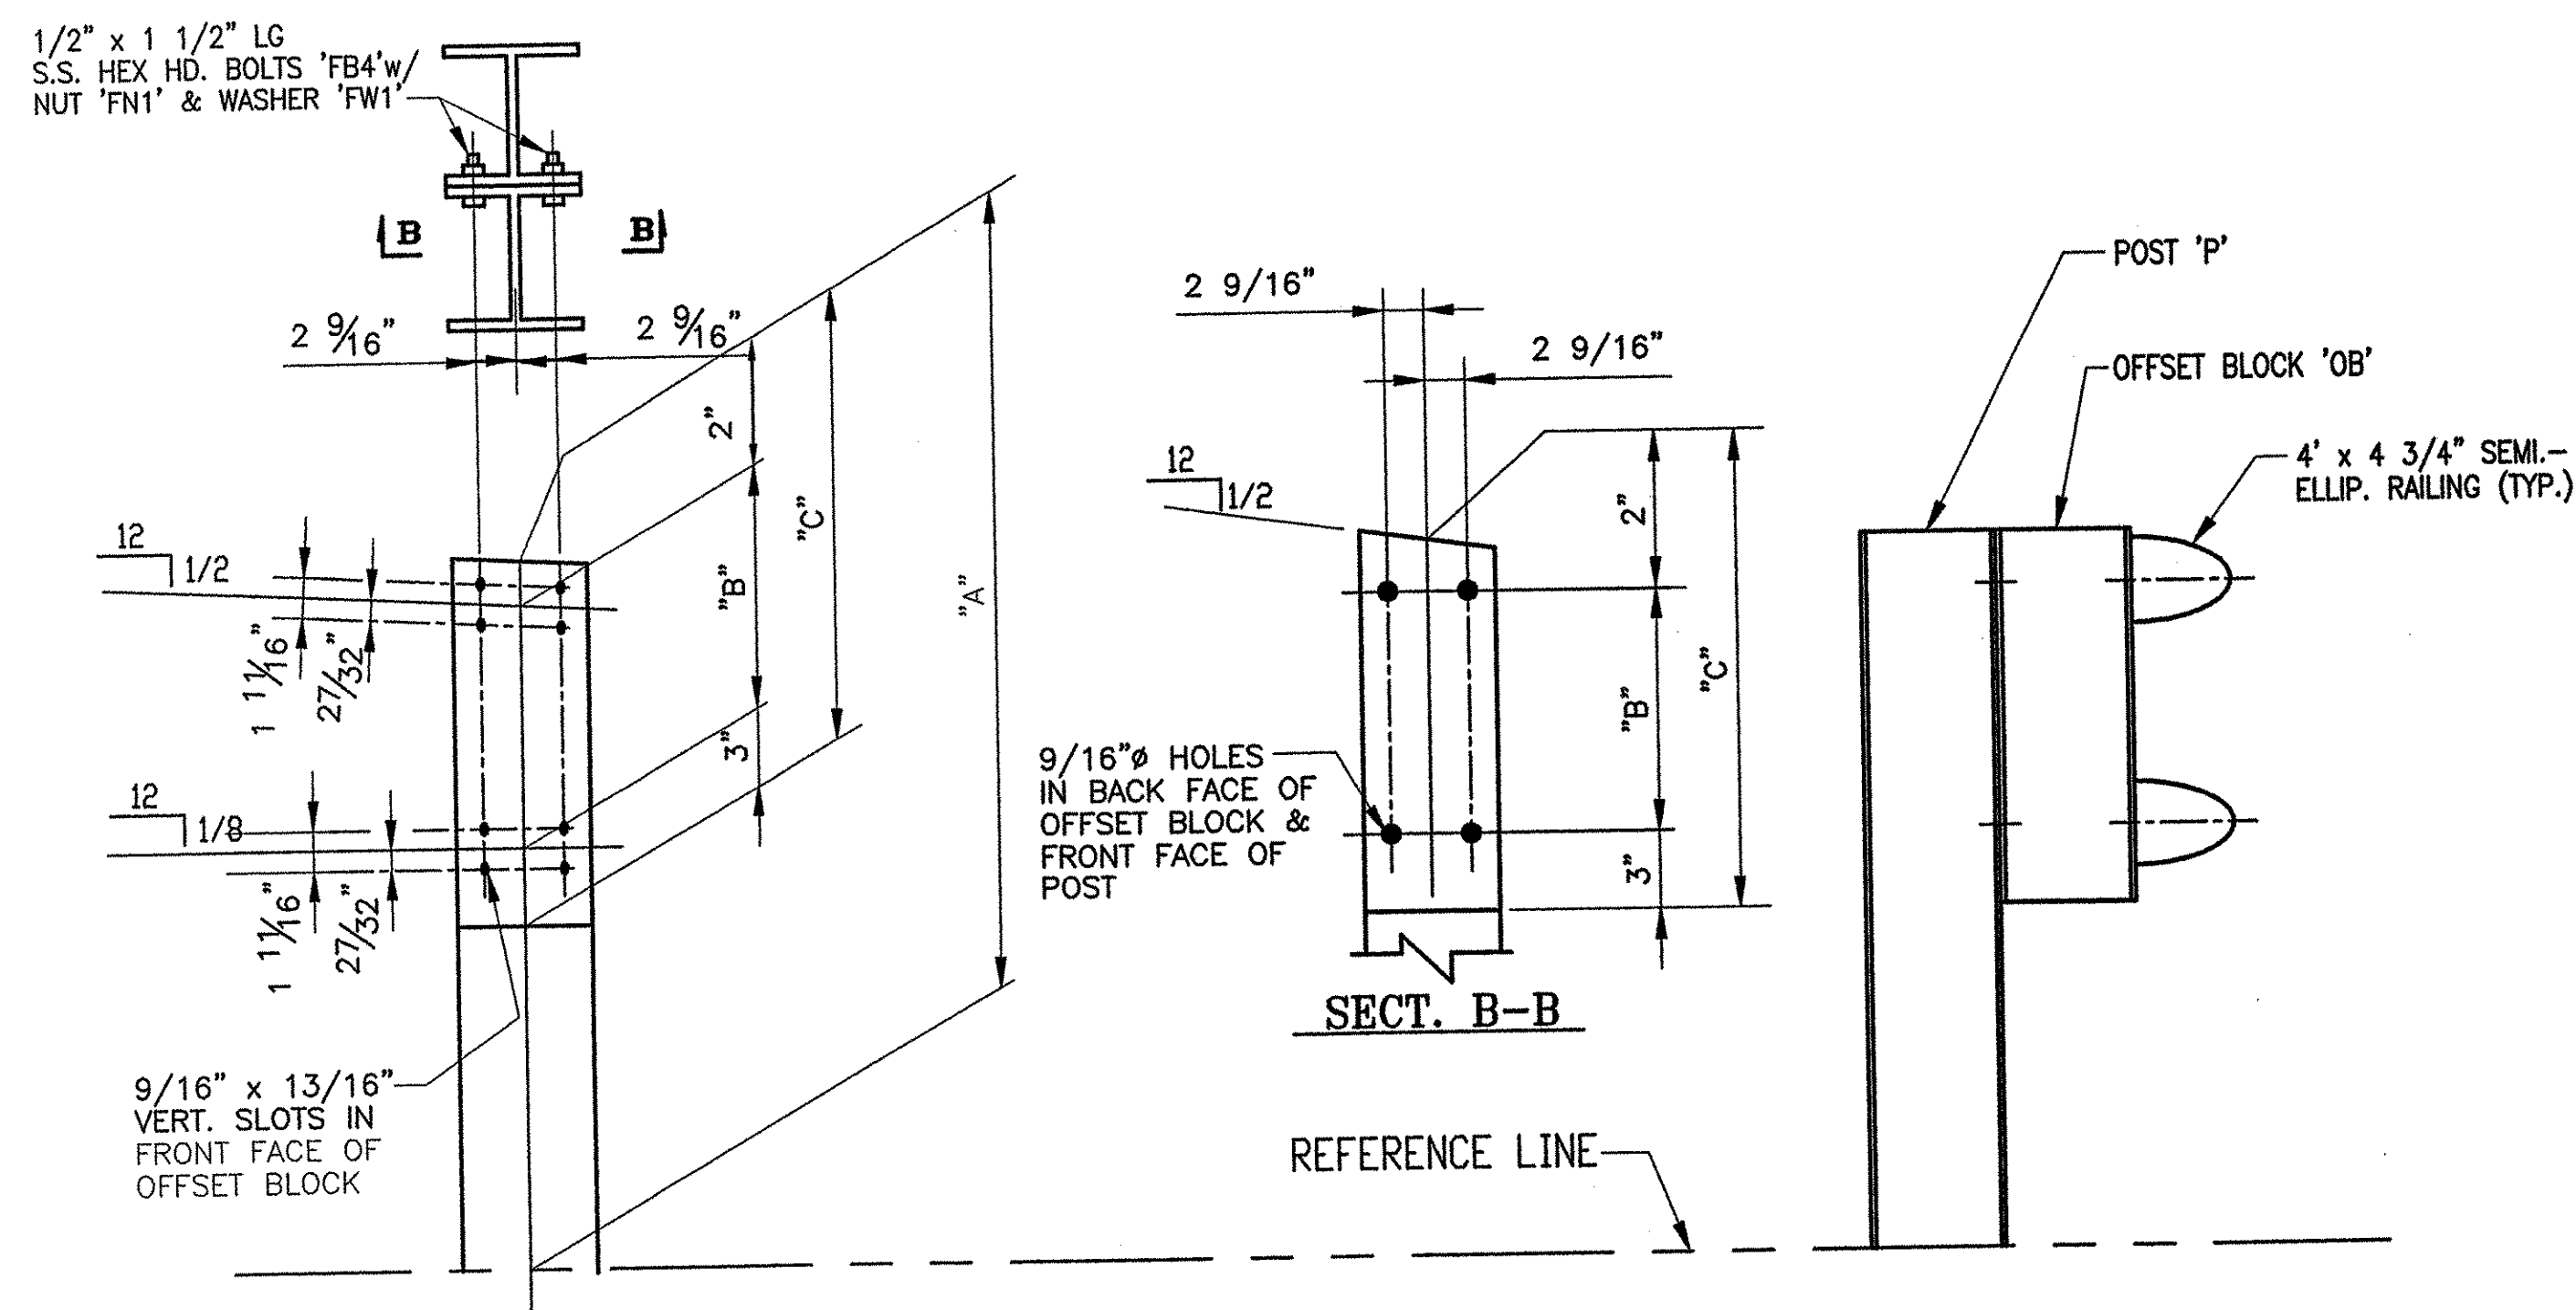


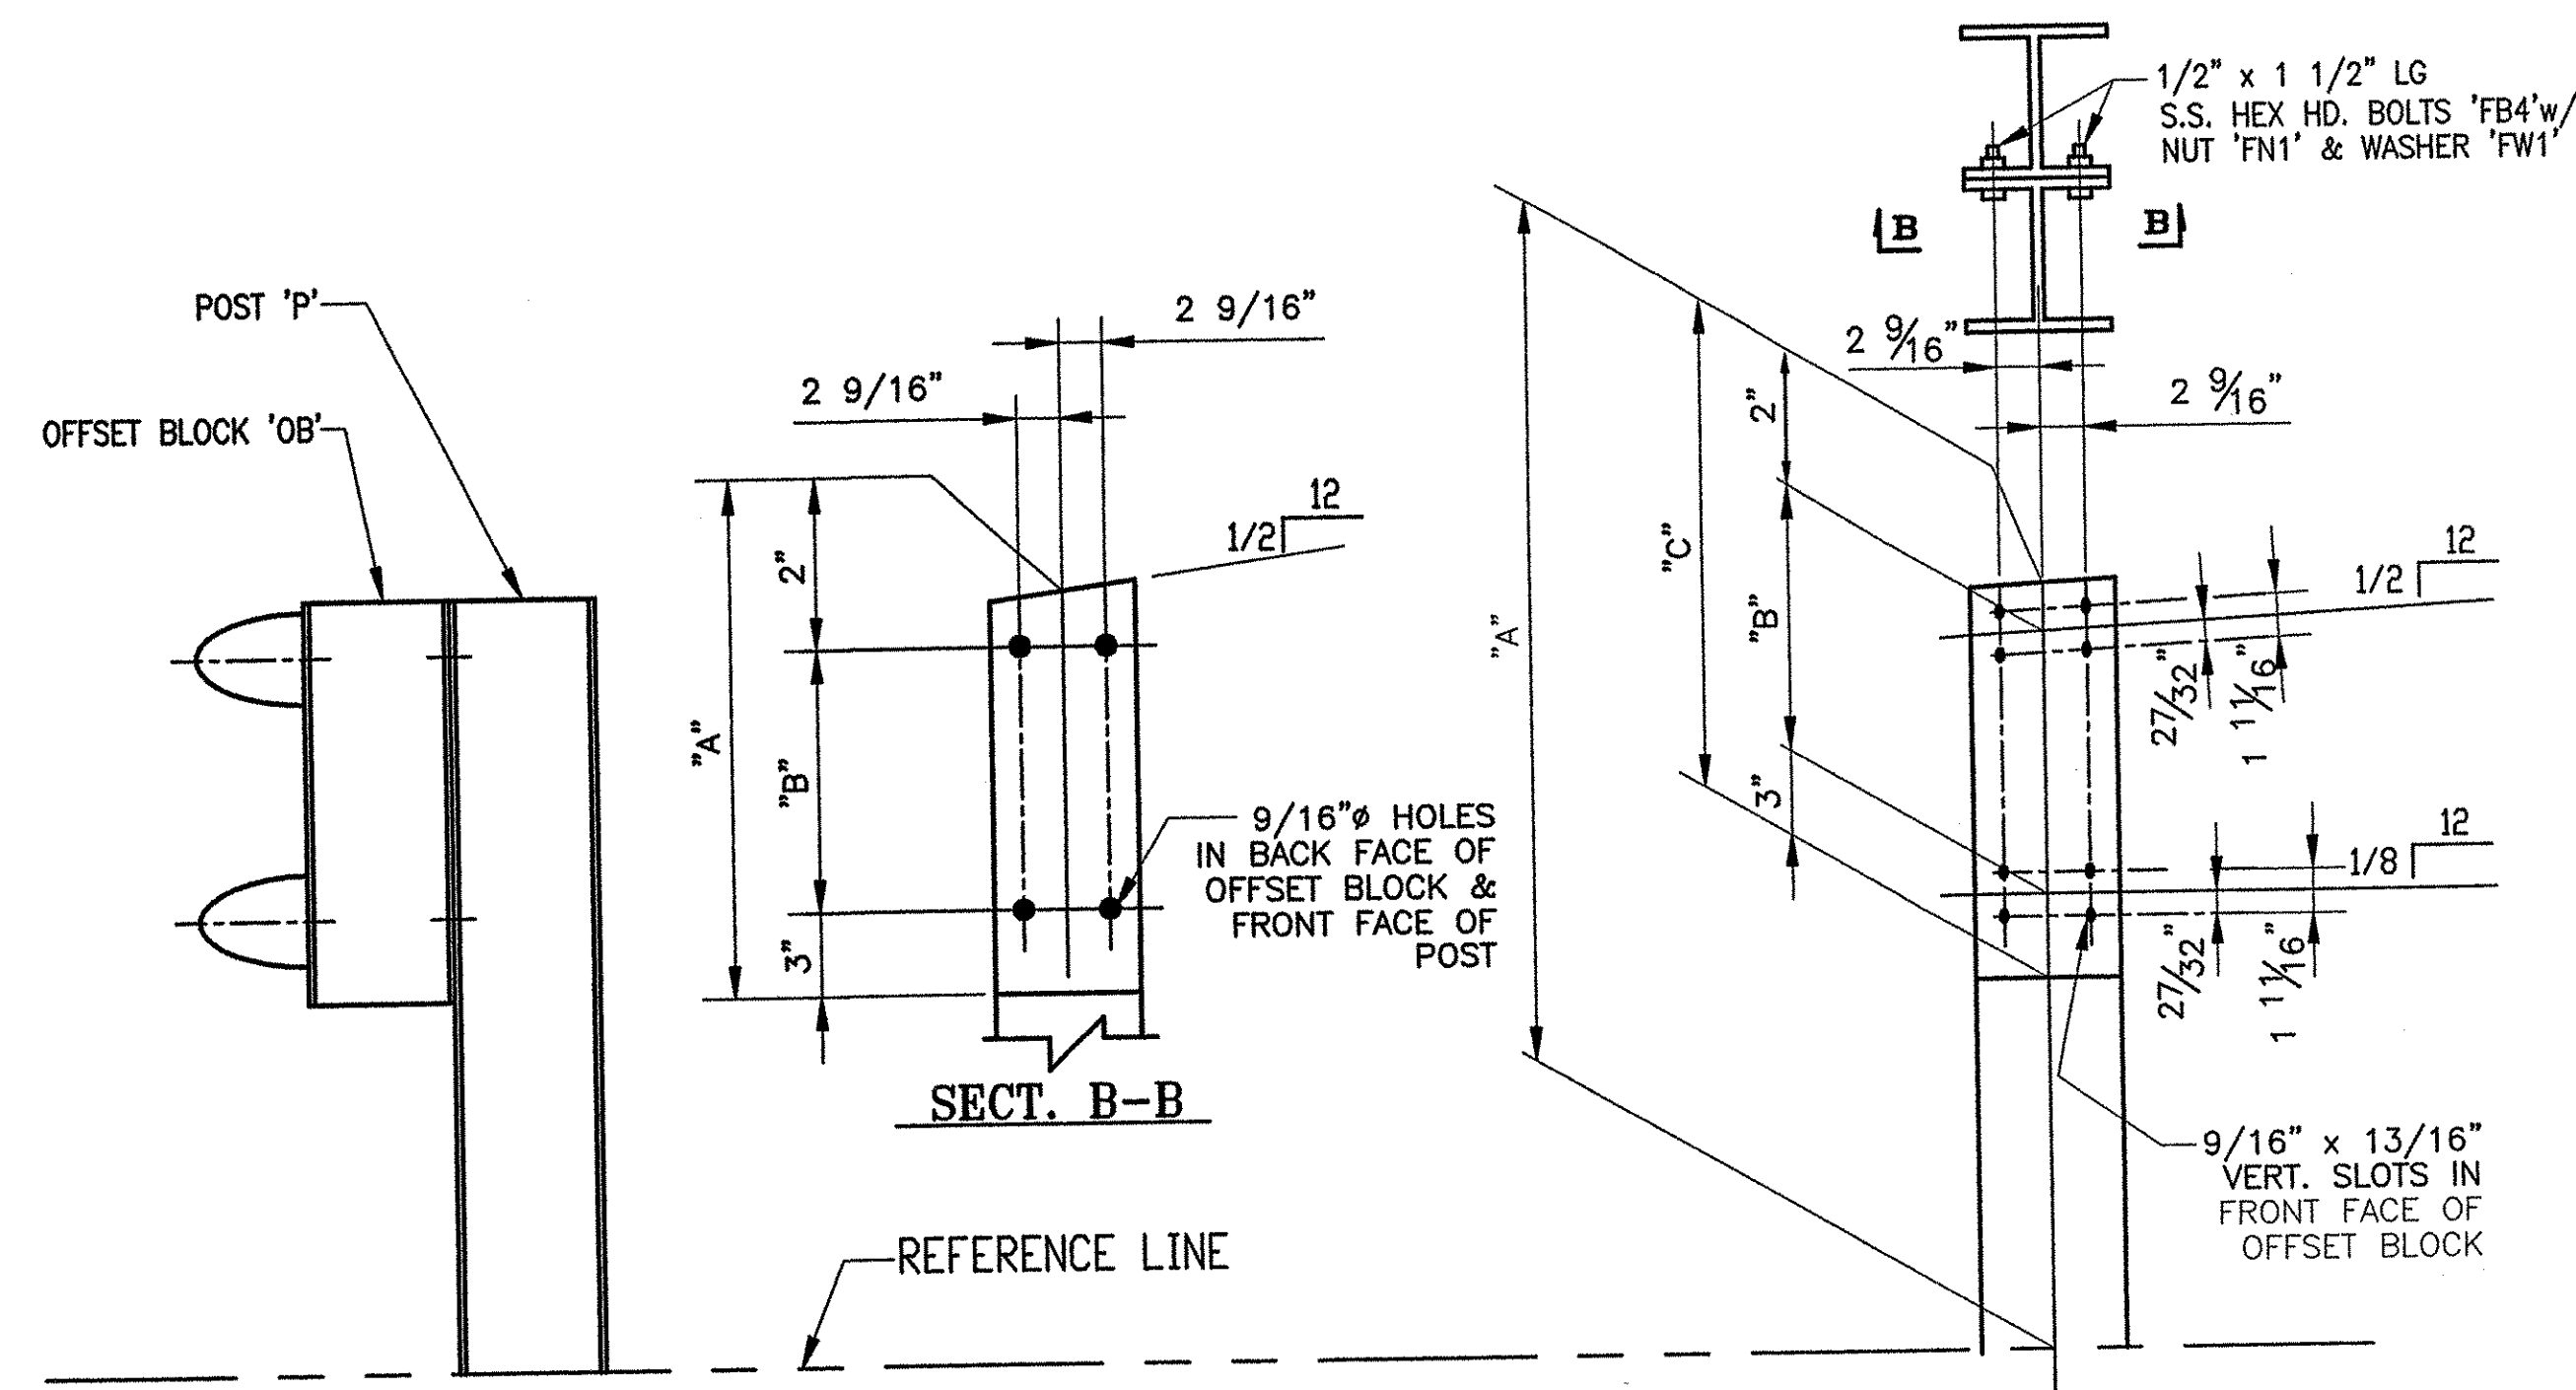


CURB SIDE (NW)					
RAIL HEIGHT DIMENSIONS			OFFSET BLOCK DIMENSIONS		
POST No.	QTY.	A	OFFSET BLOCK No.	B	C
P8 ^R	1	3'-2 15/16"	OB8 ^R	1'-5 1/8"	1'-10 1/8"
P9 ^R	1	3'-1 5/16"	OB9 ^R	1'-3 7/8"	1'-8 7/8"
P10 ^R	1	2'-11 11/16"	OB10 ^R	1'-2 9/16"	1'-7 9/16"
P11 ^R	1	2'-10 1/16"	OB11 ^R	1'-1 1/4"	1'-6 1/4"
P12 ^R	1	2'-7 7/8"	OB12 ^R	11 9/16"	1'-4 9/16"
P13 ^R	1	2'-5 3/4"	OB13 ^R	9 13/16"	1'-2 13/16"

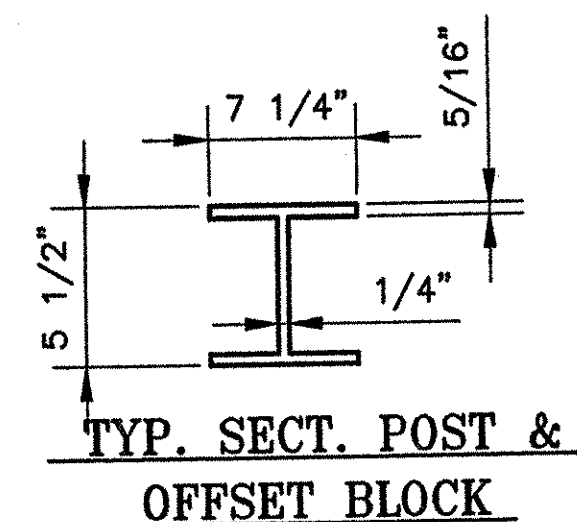

CURB SIDE (NW)					
RAIL HEIGHT DIMENSIONS			OFFSET BLOCK DIMENSIONS		
POST No.	QTY.	A	OFFSET BLOCK No.	B	C
P8 ^L	1	3'-2 15/16"	OB8 ^L	1'-5 1/8"	1'-10 1/8"
P9 ^L	1	3'-1 5/16"	OB9 ^L	1'-3 7/8"	1'-8 7/8"
P10 ^L	1	2'-11 11/16"	OB10 ^L	1'-2 9/16"	1'-7 9/16"
P11 ^L	1	2'-10 1/16"	OB11 ^L	1'-1 1/4"	1'-6 1/4"
P12 ^L	1	2'-7 7/8"	OB12 ^L	11 9/16"	1'-4 9/16"
P13 ^L	1	2'-5 3/4"	OB13 ^L	9 13/16"	1'-2 13/16"

VT TRANS RECEIVED
CHK'D BY: Gan OK'D BY: _____
JAN 12 2005
RESUBMIT: _____ APPROVED: _____
BY: _____ DATE: _____

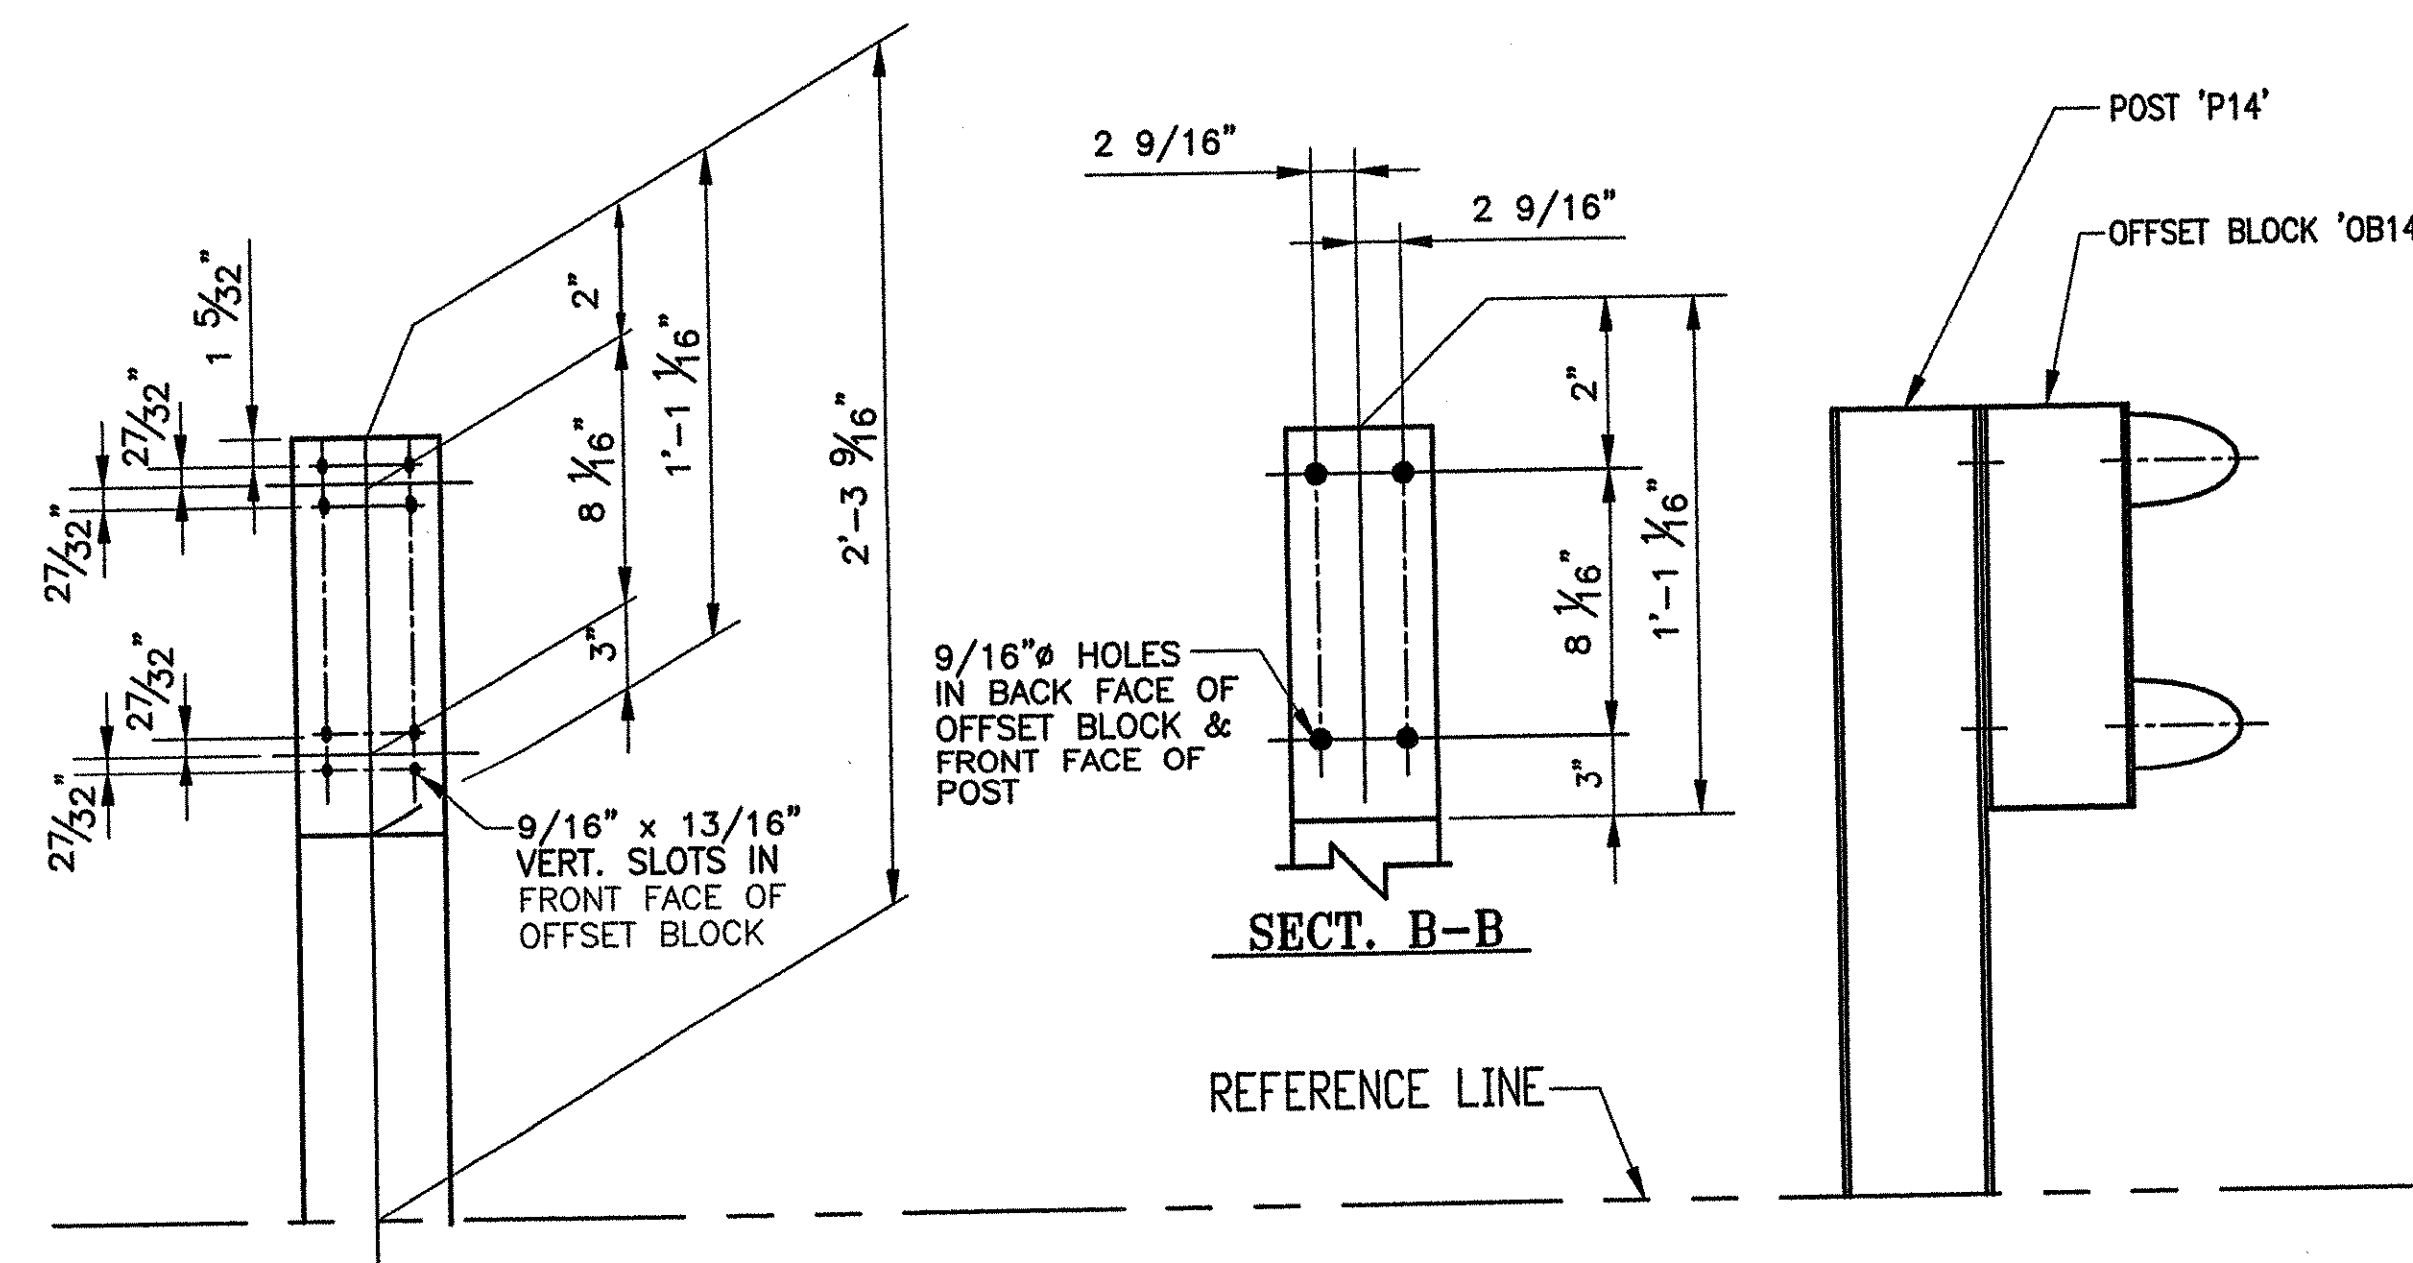

5 REQ'D. ~ POST P14

BRIDGE No. 21	PROJ. No: BRS 0147(5)S	ITEM No: 621.74
APPROVED: _____	REC'D APPROVAL _____	DRAWING _____
L.B. FOSTER COMPANY 1016 GREENTREE ROAD PITTSBURGH, PENNSYLVANIA 15220		
FOR: BECK & BELLUCCI, INCORPORATED VERMONT AGENCY OF TRANSPORTATION TOWN OF ROYALTON, COUNTY OF WINDSOR BRIDGE APPROACH RAILING FOR VT RTE 14 OVER WHITE RIVER POST DETAILS & OFFSET BLOCK DETAILS		
MADE CMS. DATE 10/08/04	JOB No. AR0170	CUST. No. _____
CHECK AW DATE 10/21/04	DRAWING LB11	REV. No. _____

REV.	DESCRIPTION	BY	DATE