
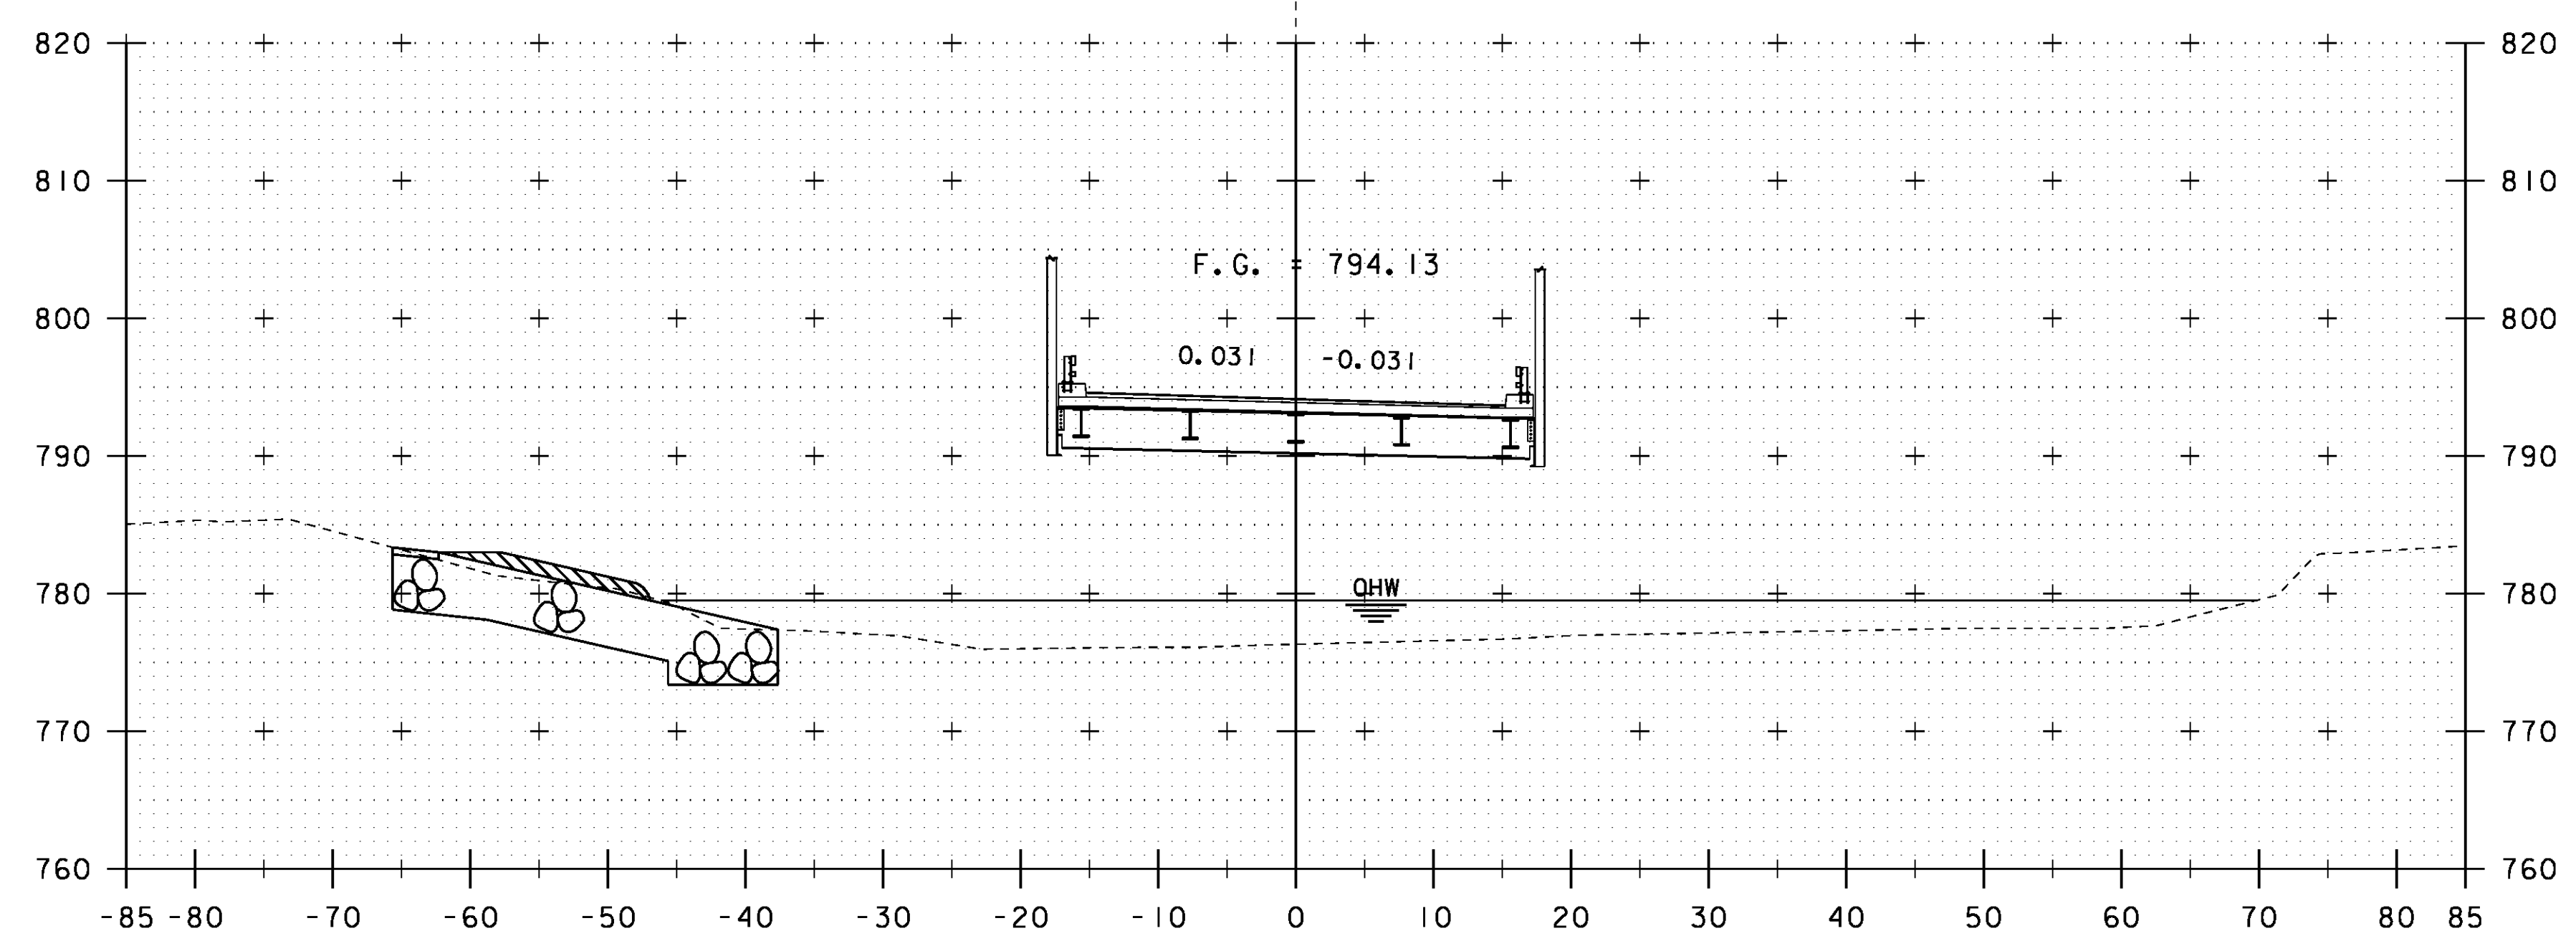


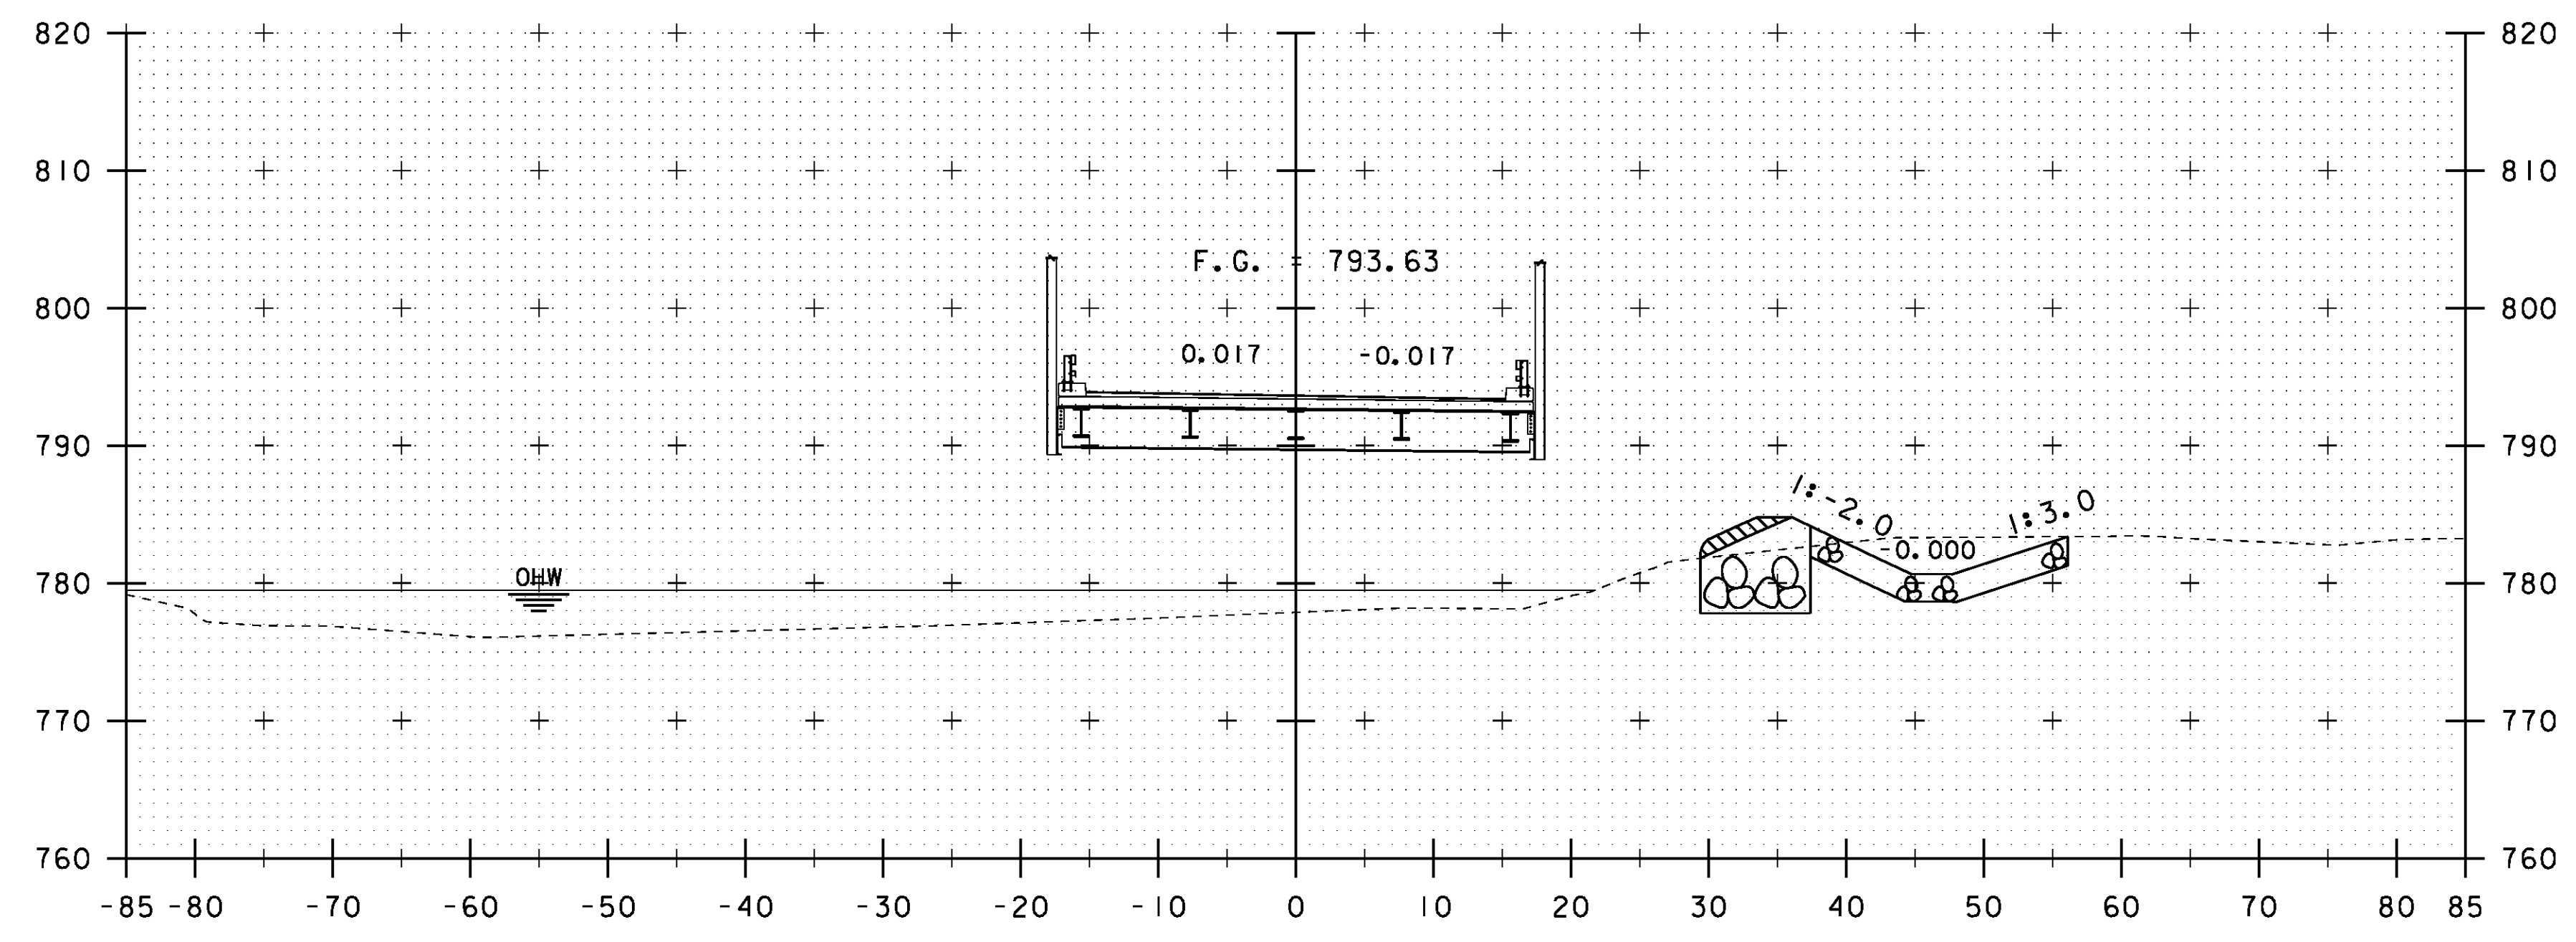

SCALE 1" = 10'-0"

STA. 206+50 TO STA. 207+00

|                                |                        |
|--------------------------------|------------------------|
| PROJECT NAME: WARREN           |                        |
| PROJECT NUMBER: BRP 013-4 (14) |                        |
| FILE NAME: s78f242xs.dgn       | PLOT DATE: 27-JUL-2012 |
| PROJECT LEADER: J. LACROIX     | DRAWN BY: G. ROKES     |
| DESIGNED BY: U. STANLEY        | CHECKED BY: U. STANLEY |
| VT 100 CROSS SECTIONS SHEET 8  | SHEET 68 OF 83         |