


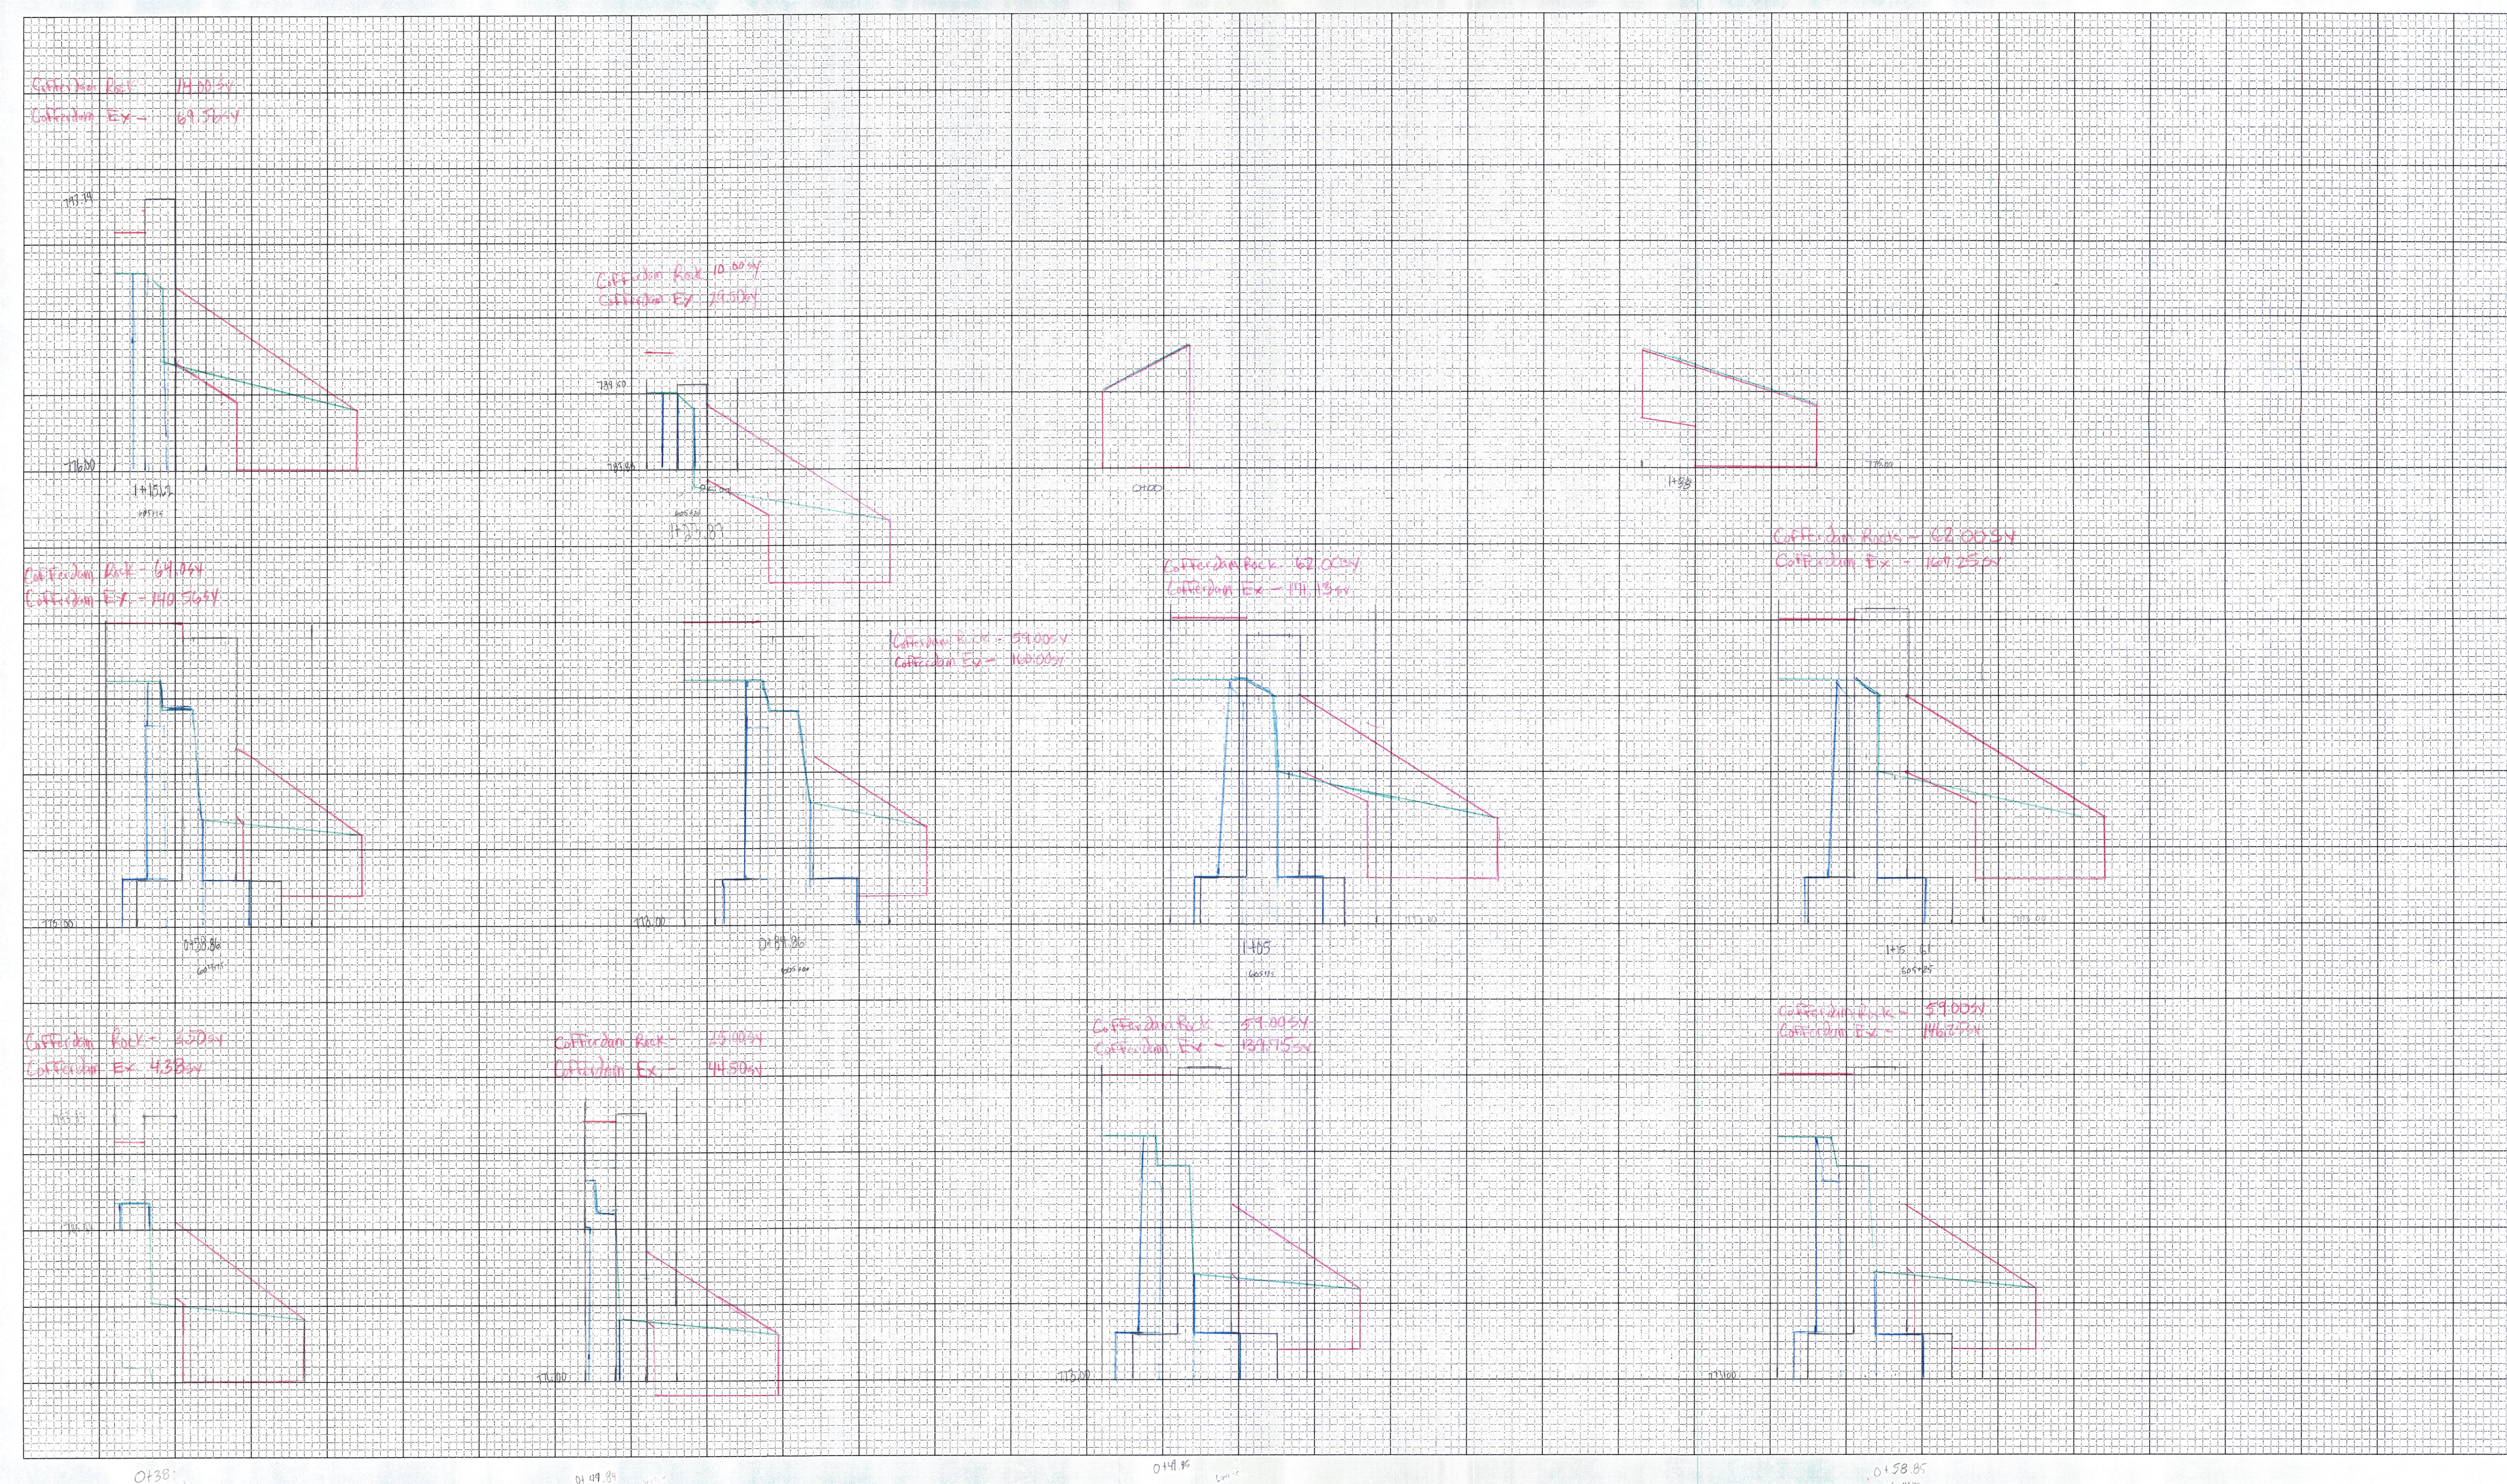

CROSS SECTION SHEET

PROJECT NAME: <u>02-2000</u>		
PROJECT NUMBER: <u>1000000000</u>		
FILE NAME: <u>02-2000-0000</u>	PLOT DATE: 05-JUN-2000 05	
PROJECT LEADER: _____	DRAWN BY: _____	
DESIGNED BY: _____	CHECKED BY: _____	
const: g:/common/cadd/e-xsection.dgn		SHEET _____ OF _____