

REMOVAL & DISPOSAL OF GUIDE POSTS

8+30 Lt ~ 8+93 Lt.
9+00 Lt.

Removing and Resetting Fence
7+15 Lt. ~ 11+40 Lt.

Temporary Barbed Wire Fence (4 Strand)
7+15 Lt. ~ 11+40 Lt.

Woven Wire Fence w/ Wood Posts (400)

6+25 Lt ~ 11+50 Lt.
8+75 Rt ~ 10+30 Rt.

REMOVAL AND DISPOSAL OF GUARD RAIL

10+10 Lt. ~ 11+92 Lt.
10+38 Rt ~ 12+18 Rt.
4-7 + 31

CONSTRUCT TEMPORARY DETOUR


8+80 Rt. ~ 13+30 Rt.

GEOTEXTILE FABRIC FOR SILT FENCE


8+00 Lt ~ 15+00 Lt

REMOVAL OF EXISTING FENCE (NON-PARTICIPATING)

16+21 ~ 20+89 Lt

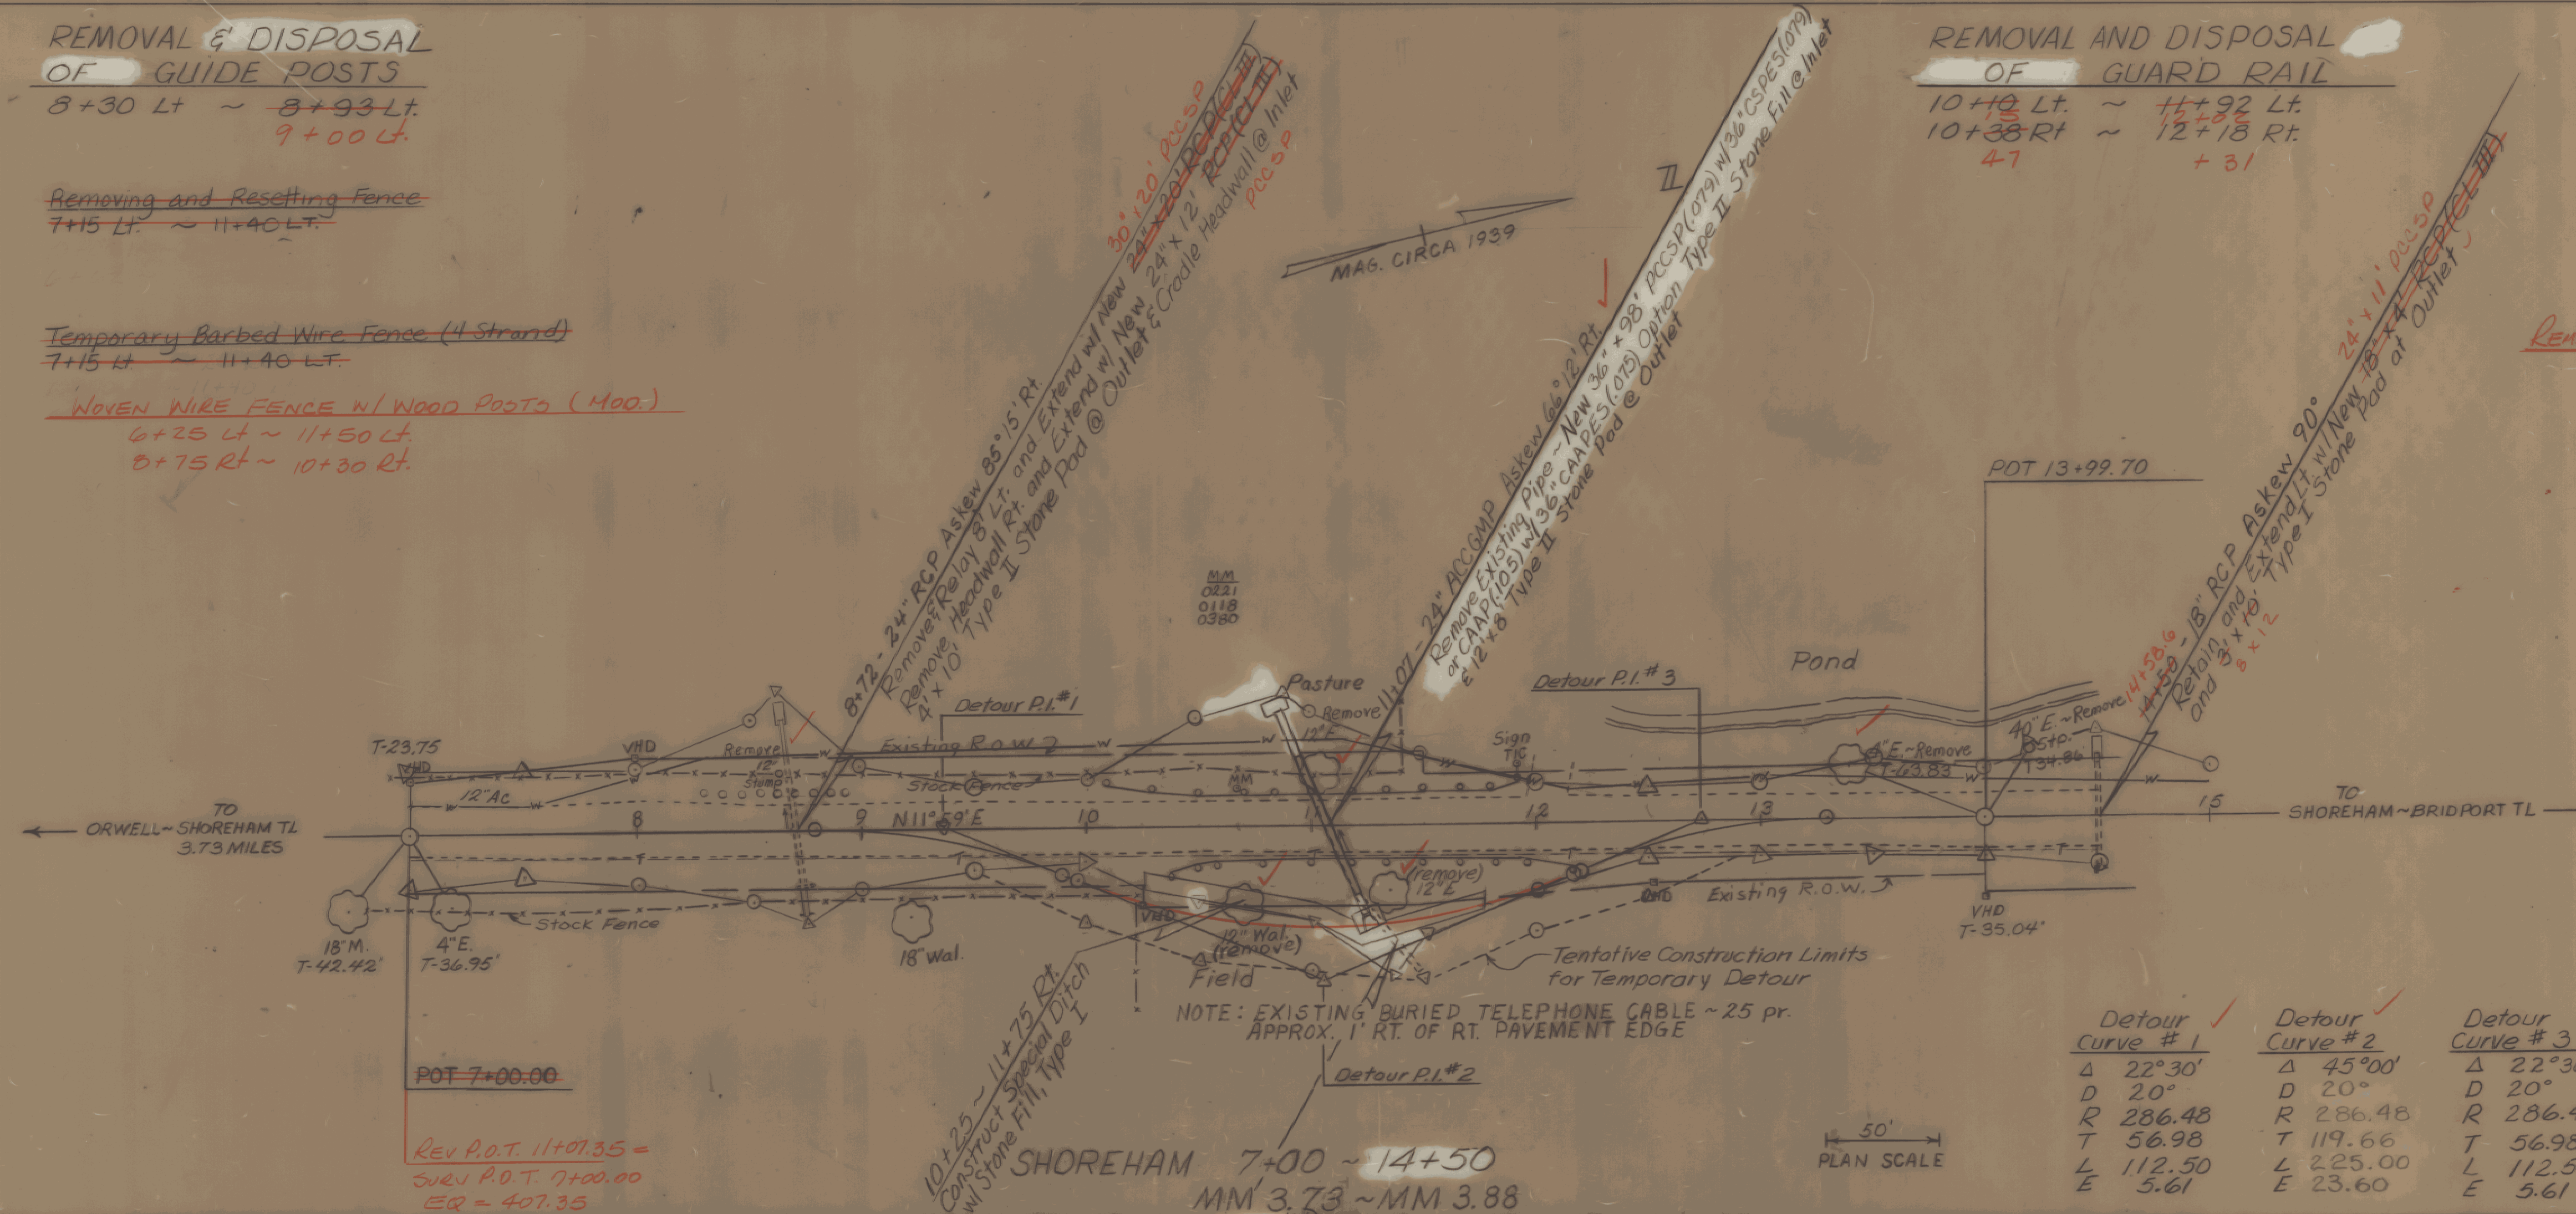

Detour Curve #1	Detour Curve #2	Detour Curve #3
Δ 22°30'	Δ 45°00'	Δ 22°30'
D 20°	D 20°	D 20°
R 286.48	R 286.48	R 286.48
T 56.98	T 119.66	T 56.98
L 112.50	L 225.00	L 112.50
E 5.61	E 23.60	E 5.61

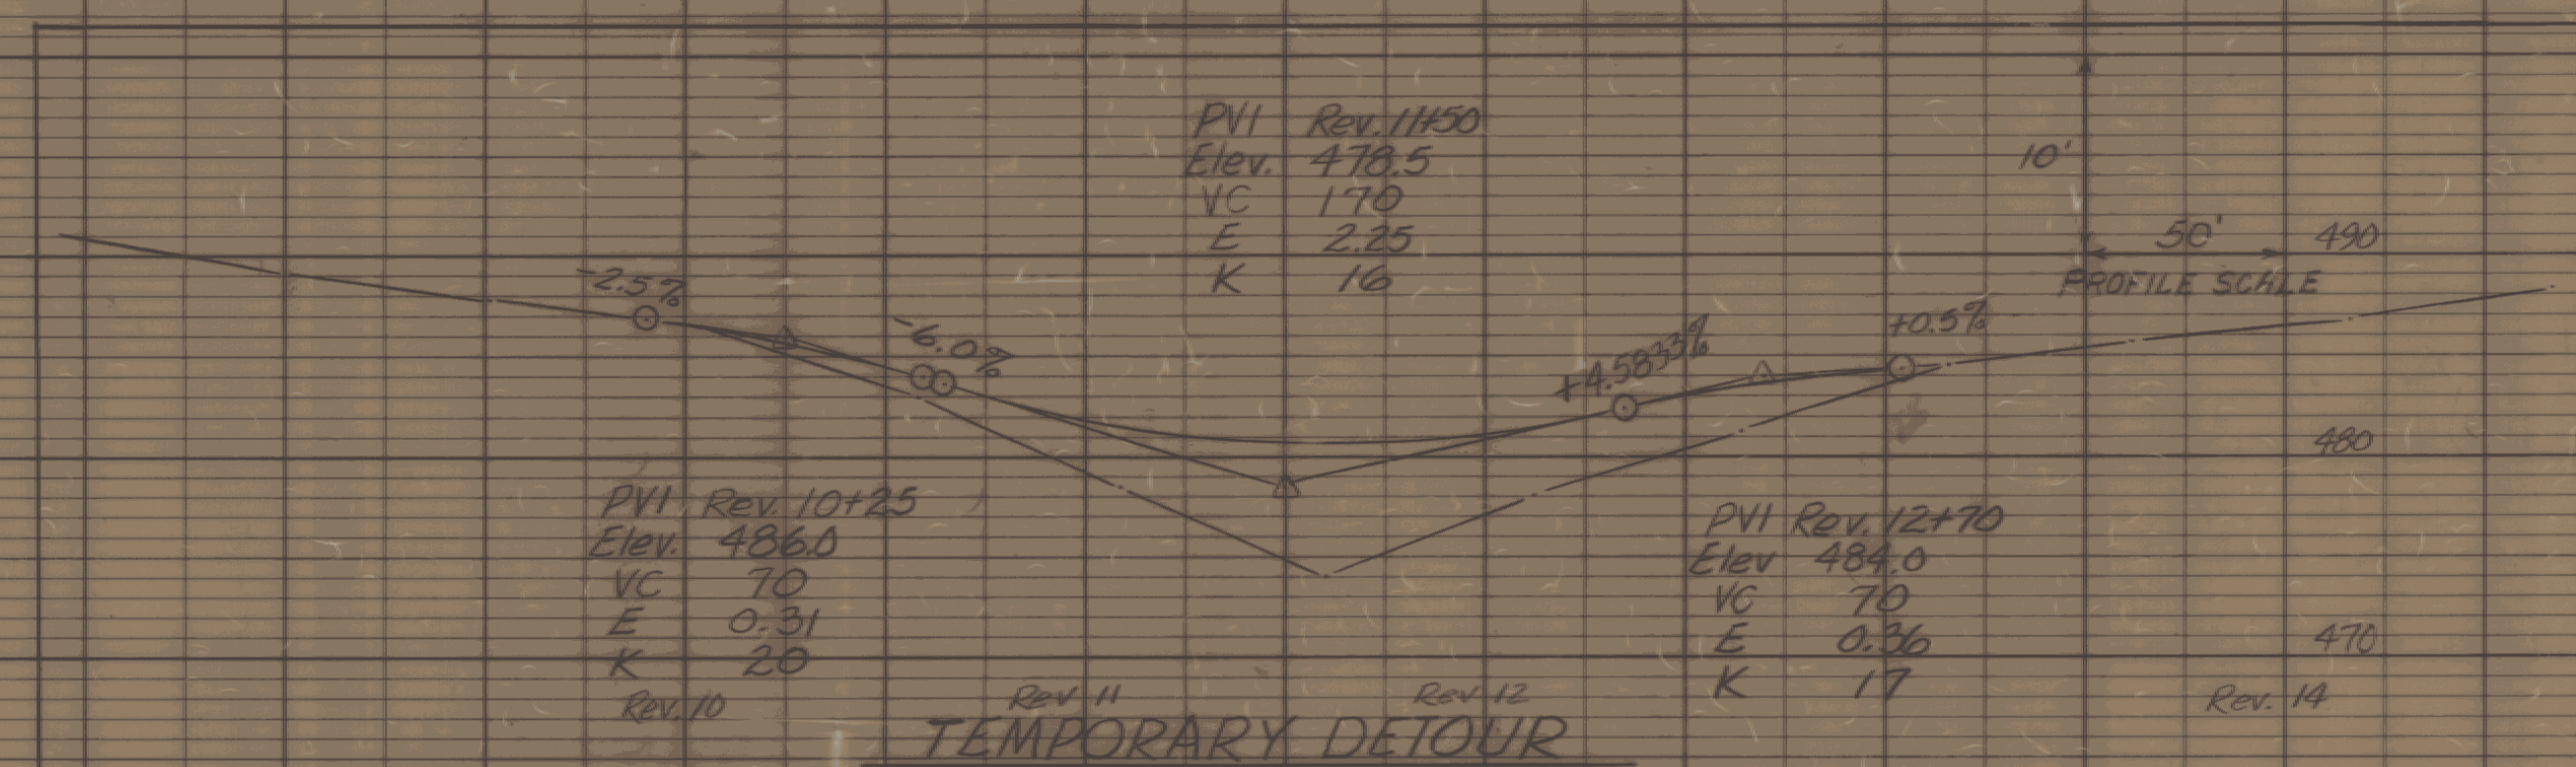

SHOREHAM-BRIDPORT-ADDISON

FOI 7-1(2)

Sheet 122 of 428

SHEET 122 OF 477