


REMOVAL AND DISPOSAL OF
GUARD RAIL


LT. 57+74 - 59+83
RT. 58+06 - 59+92

CLEARING & GRUBBING

Rt.
58+90 - 60+50
(to exist. ROW)

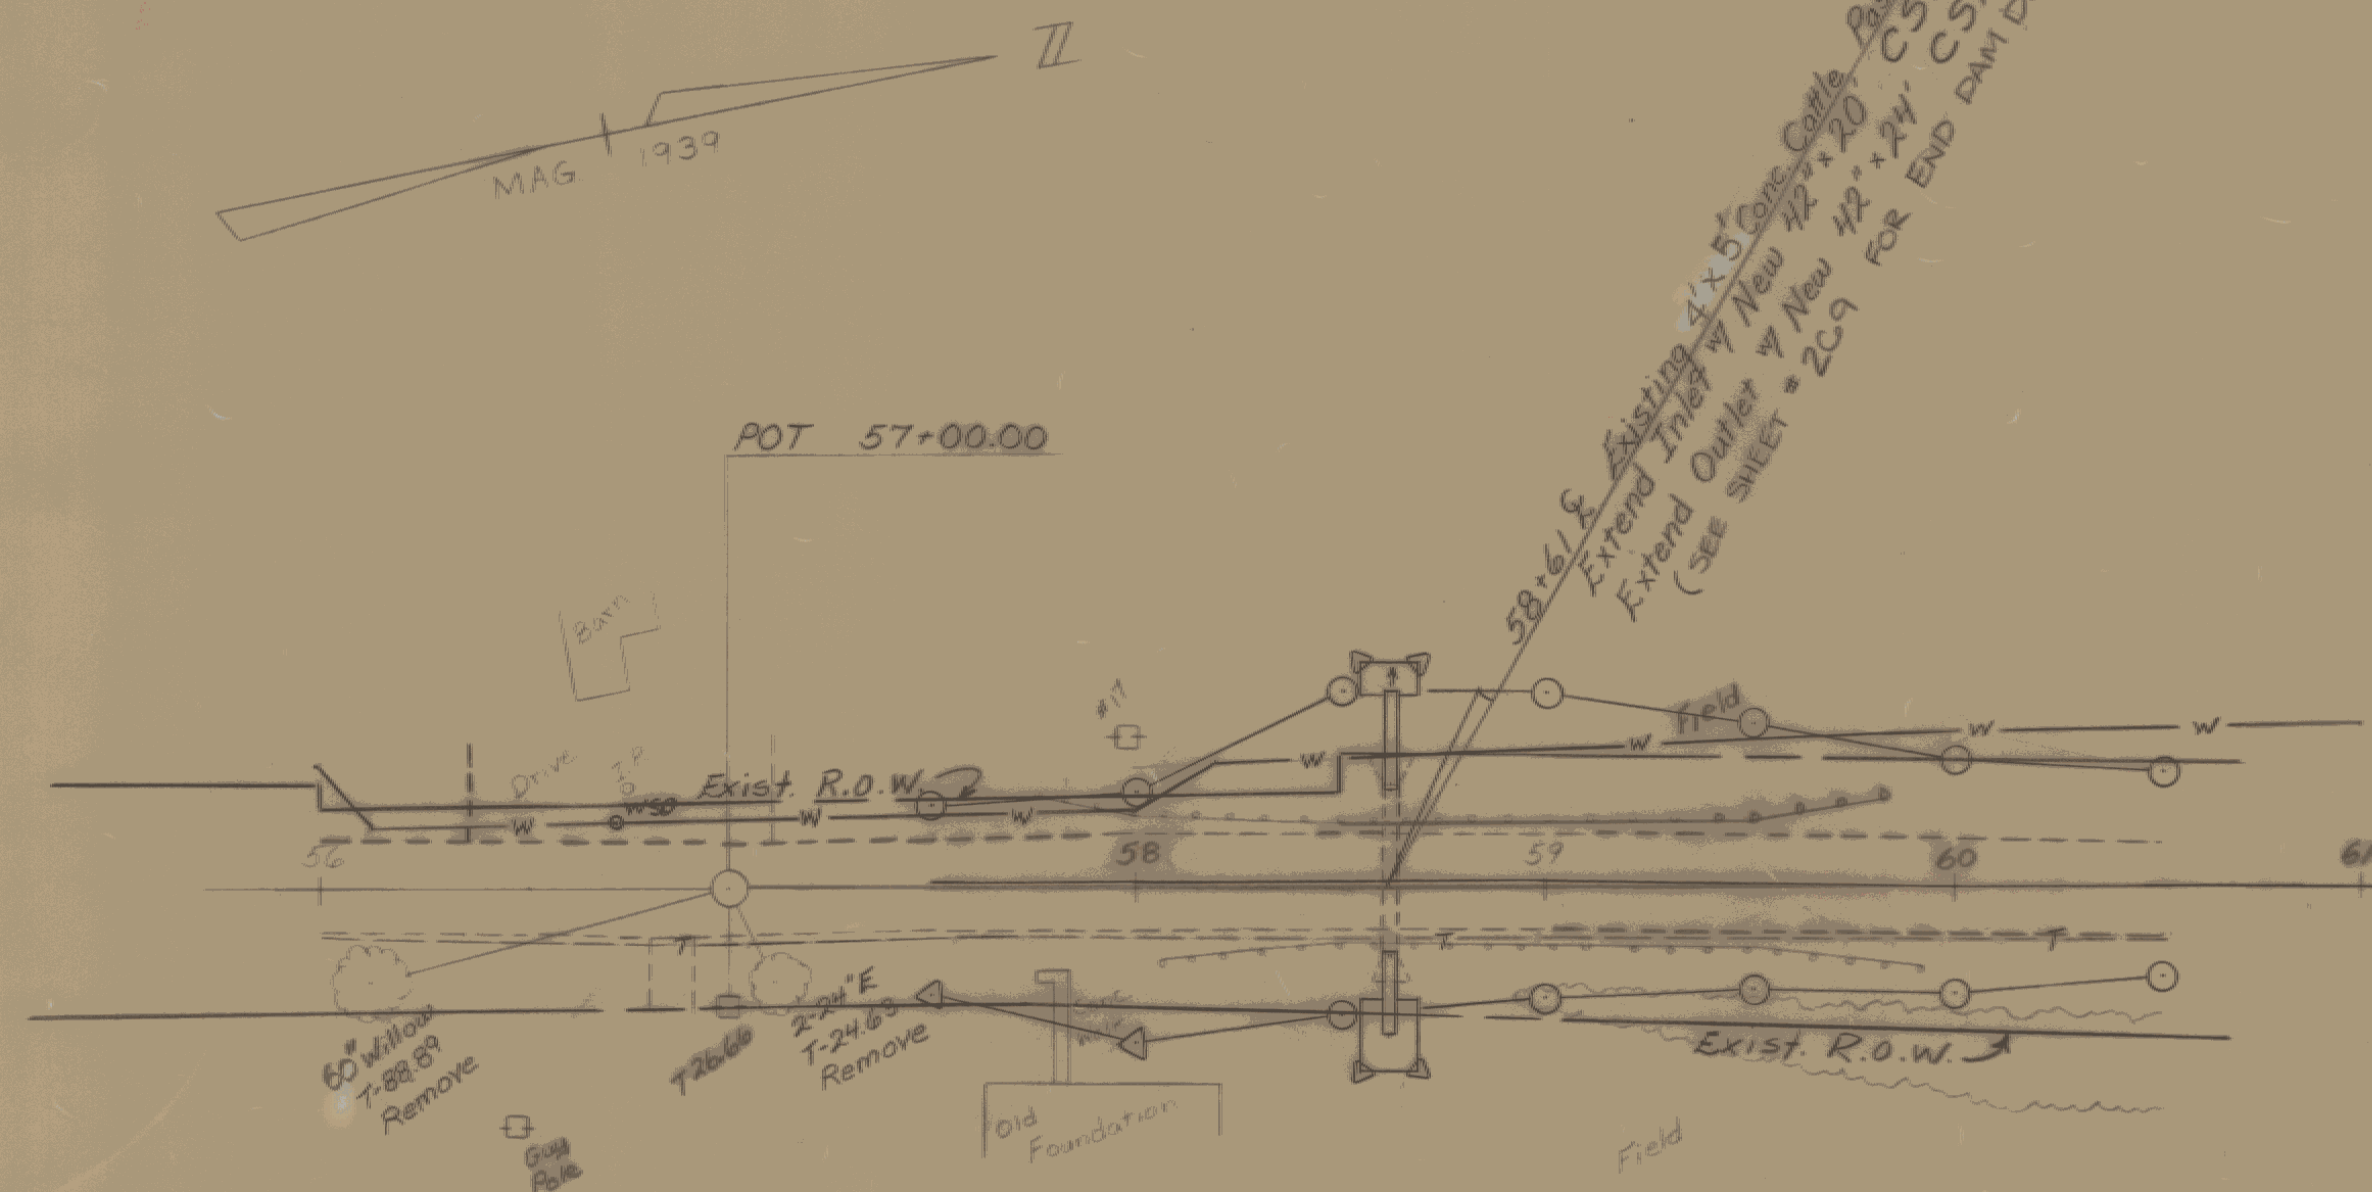

NOTE: EXIST. BURIED TELEPHONE CABLE - 25 ft.
APPROX. LOCATION - 1' RT. OF RT. EDGE OF PAVE.

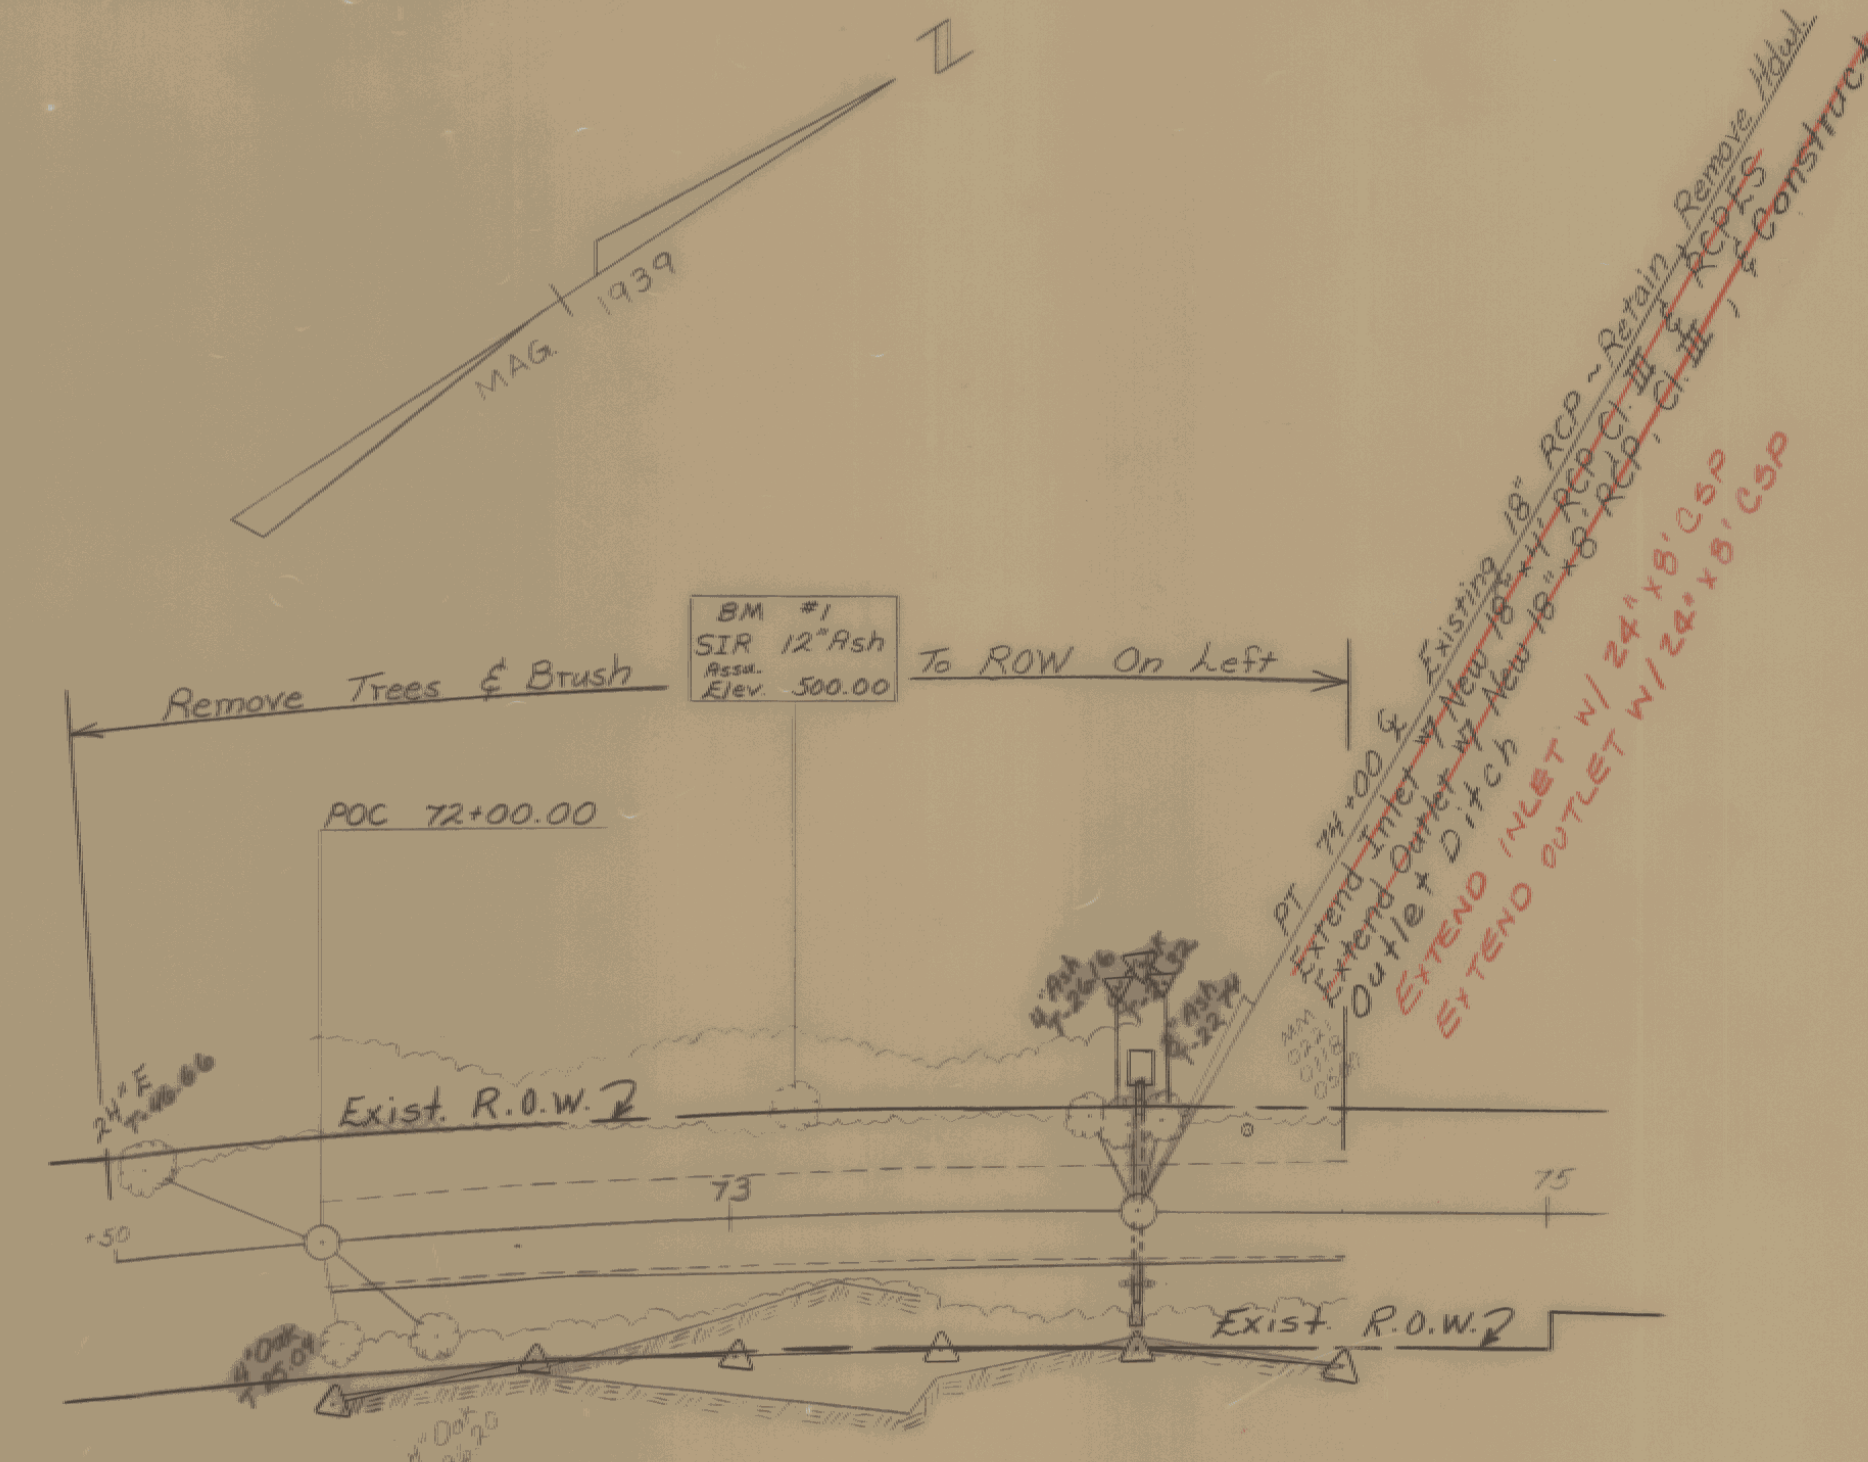

Survey:
Degree of Curve: 2°-30'-00"

SHOREHAM
MM 4.61 ~ MM 4.74 (Sta 56+0 ~ 60+50) See Sheets 126/128 of 420
MM 4.95 ~ MM 5.00 (Sta. 71+50 ~ 74+50) See Sheets 128/129 of 420

CLEARING & GRUBBING

Rt.
72+00 ~ 75+00
(To Const. Limits)

50 Feet
Scale

Scale in Feet
100 50 0

SHOREHAM - BRIDPORT - ADDISON

FO17-1(2)

SHEET 127 of 420

SHEET 127 OF 477