


REMOVAL OF EXISTING FENCE (NON-PART)
146+90 - 148+0 RT.

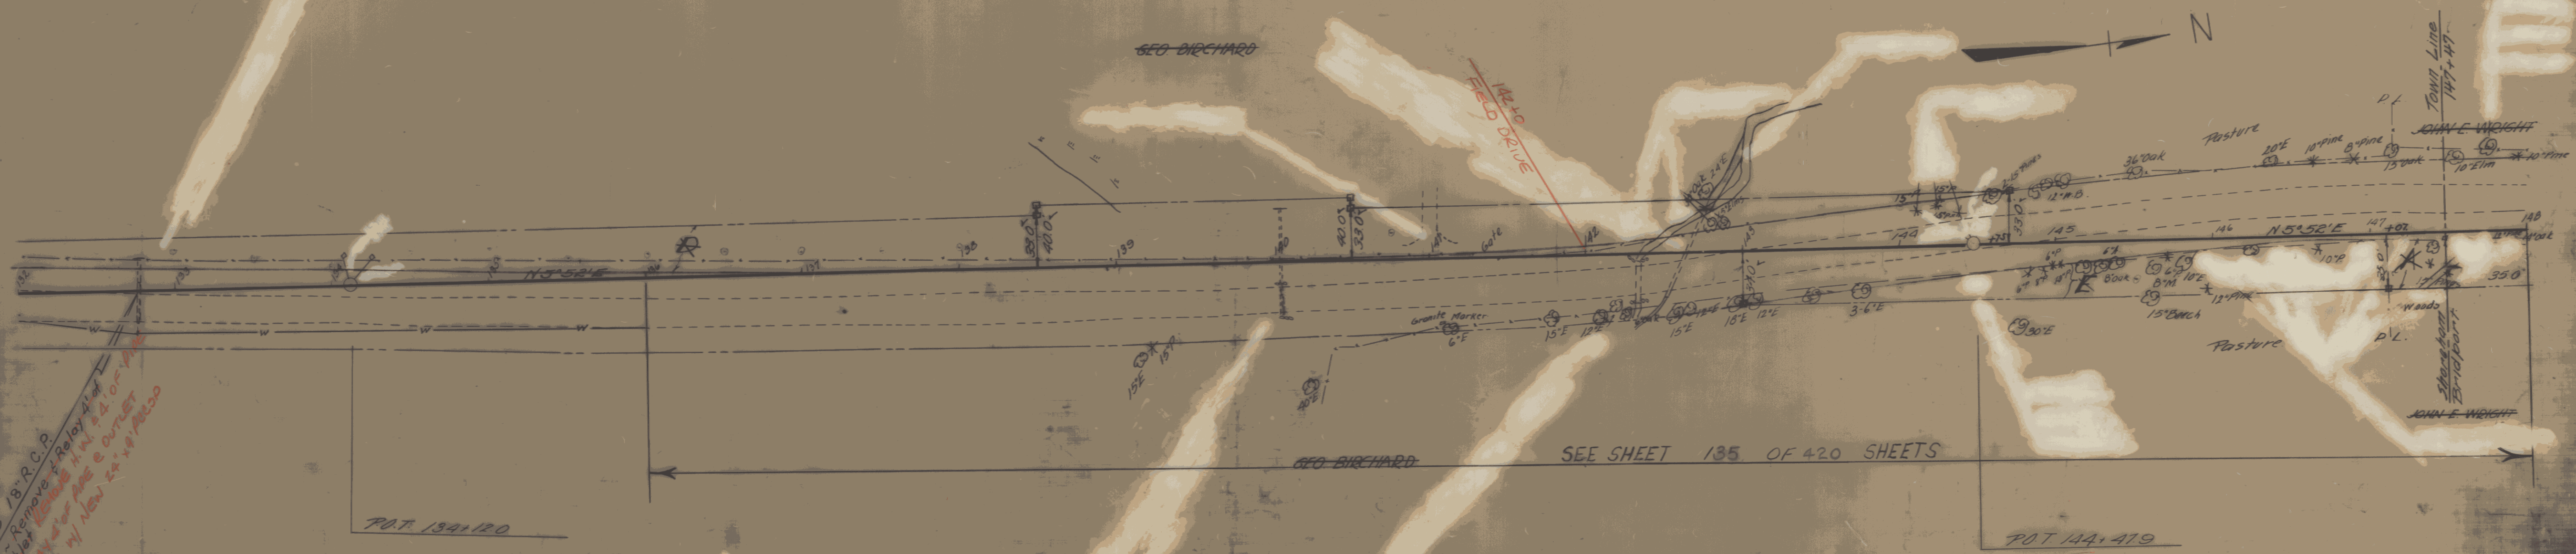

132+76 18" R.C.P.
Rejoin - Remove & Rejoin
Pipe at Outlet
Extend 10' for 10' of
Extension w/ New 24" R.C.P.

SHOREHAM 132+00~136+00
MM 6.09 ~ 6.17

PARCEL	INSTRUMENT	DATE	GRANTOR	GRANTEE	RECORDED	REMARKS
D-E	A	9-7-38	GEORGE & LILA BIRCHARD	STATE	BOOK 21 PAGE 125-30	Channel Change
A	W.D.	9-7	JOHN E. WRIGHT	STATE	BOOK 21 PAGE 38-40	Channel Change

