

BREAKAWAY CABLE TERMINAL

LT.	RT.
282+04 ~ 282+29 ✓	280+79 ~ 281+04 ✓
286+92 ~ 287+17 ✓	285+92 ~ 286+17 ✓
	281+29 ~ 281+54 ✓
	285+92 ~ 286+17 ✓

GEOTEXTILE FABRIC FOR SILT FENCE

LT.	RT.
281+50 ~ 285+50 ✓	282+50 ~ 287+00 ✓

TEMPORARY TRAFFIC BARRIER

LT.	RT.
282+00 ~ 286+00 ✓	282+00 ~ 286+00 ✓

STEEL BEAM GUARD RAIL

LT.	RT.
282+29 ~ 283+79 ✓	281+04 ~ 283+79 ✓
284+42 ~ 286+92 ✓	284+42 ~ 286+92 ✓

TBM
SW Corn
144 W
As EL 501.5

BRIDGE RAILING - HEAVY DUTY STEEL BEAM / FASCIA MOUNTED


LT.	RT.
284+04.25 ~ 284+16.75 ✓	284+04.25 ~ 284+16.75 ✓

REMOVAL AND DISPOSAL OF GUARD RAIL

LT.	RT.
283+04 ~ 285+07 ✓	283+04 ~ 285+07 ✓
282+88 ~ 284+00 ✓	282+88 ~ 284+97 ✓

HEAVY DUTY STEEL BEAM GUARD RAIL

LT.	RT.
283+79 ~ 284+04 ✓	283+79 ~ 284+04 ✓
284+17 ~ 284+42 ✓	284+17 ~ 284+42 ✓

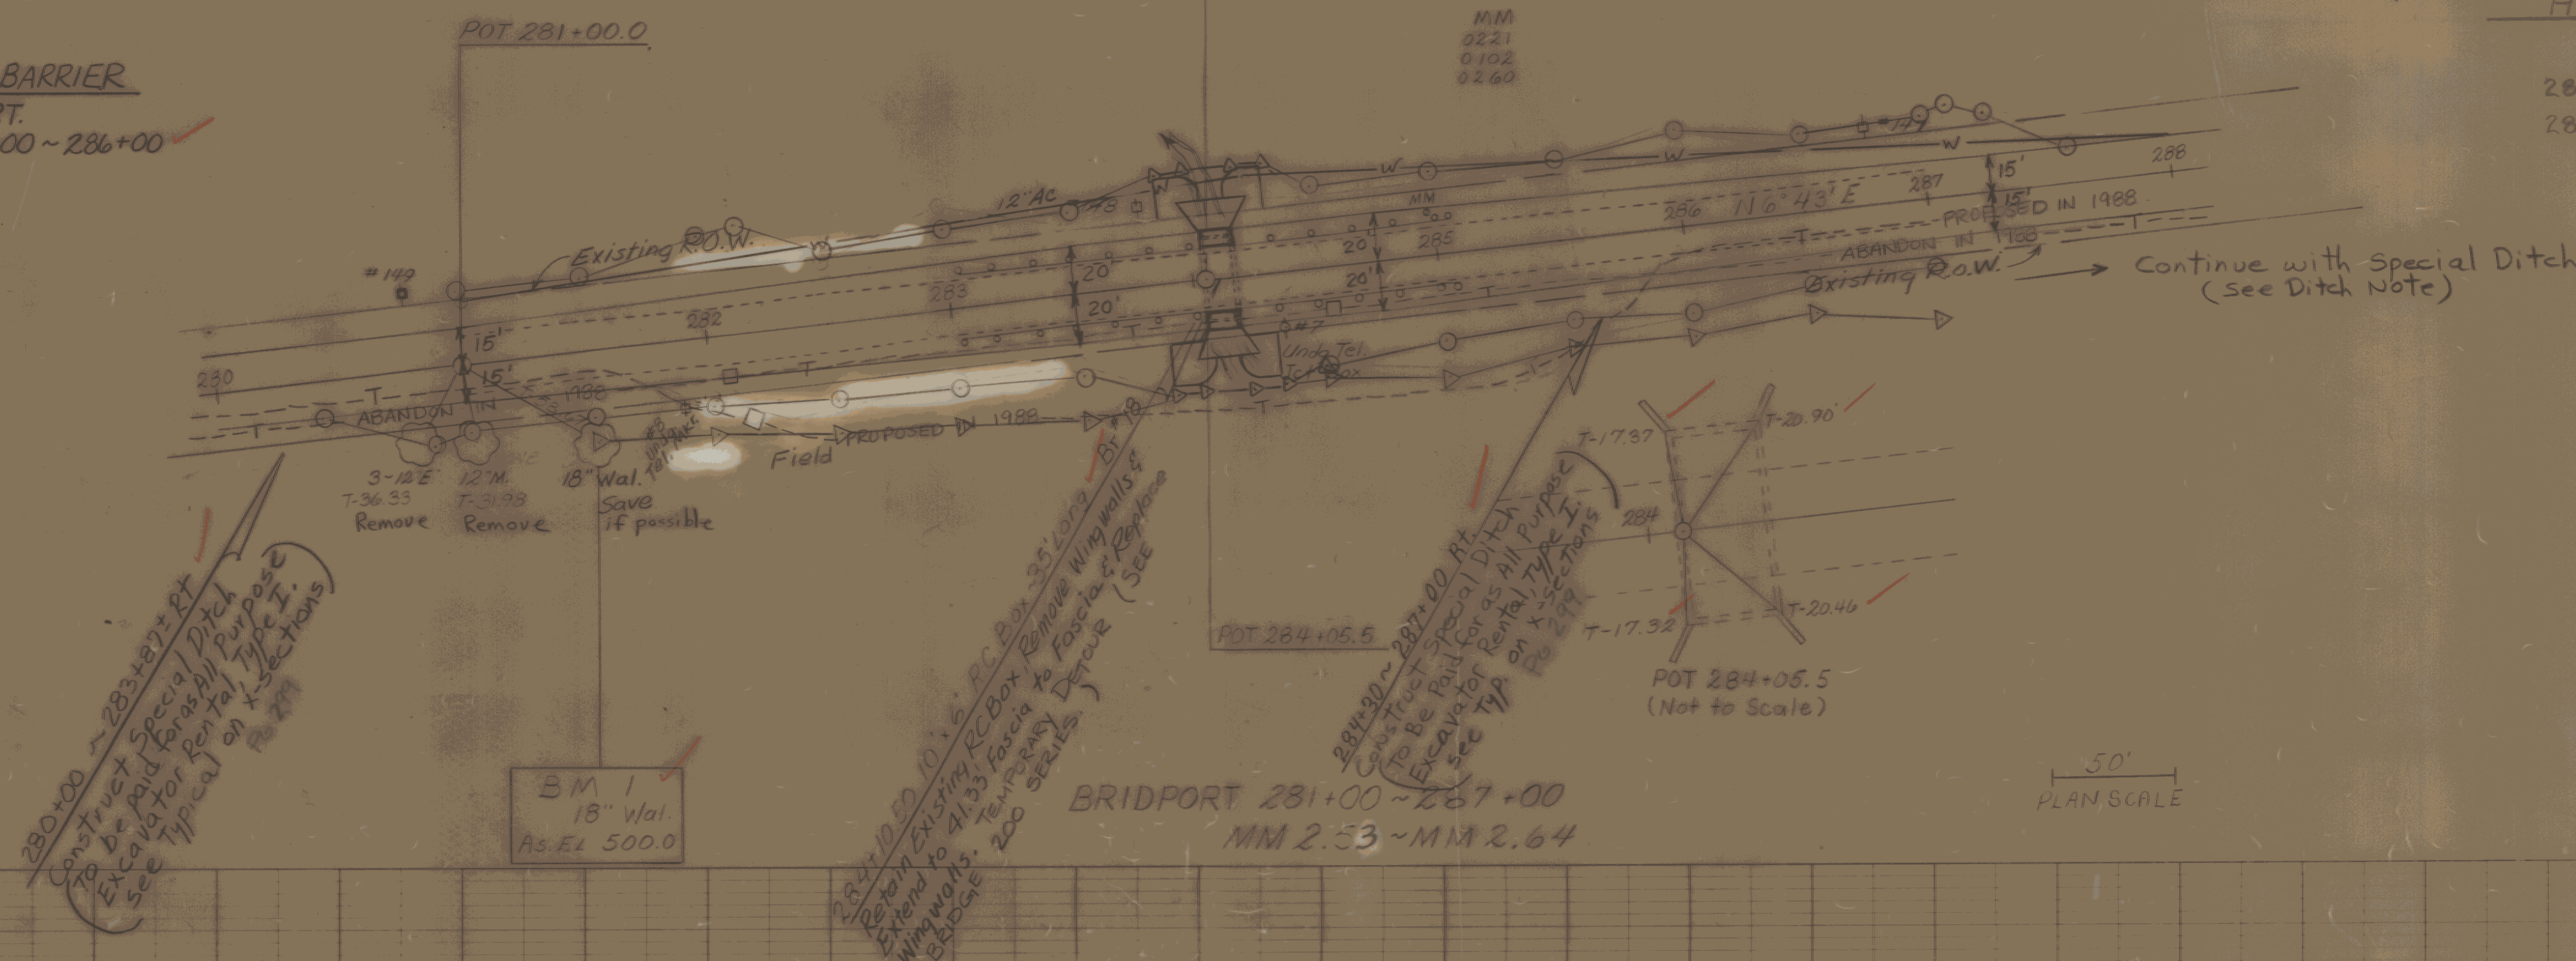

50' PLAN SCALE

10' 50' PROFILE SCALE

SHOREHAM ~ BRIDPORT ~ ADDISON
FO 17-112
Sheet 148 of 420
SHEET 148 OF 477