




BRIDPORT 296+00 ~ 302+72
 MM 2.81 ~ MM 2.94

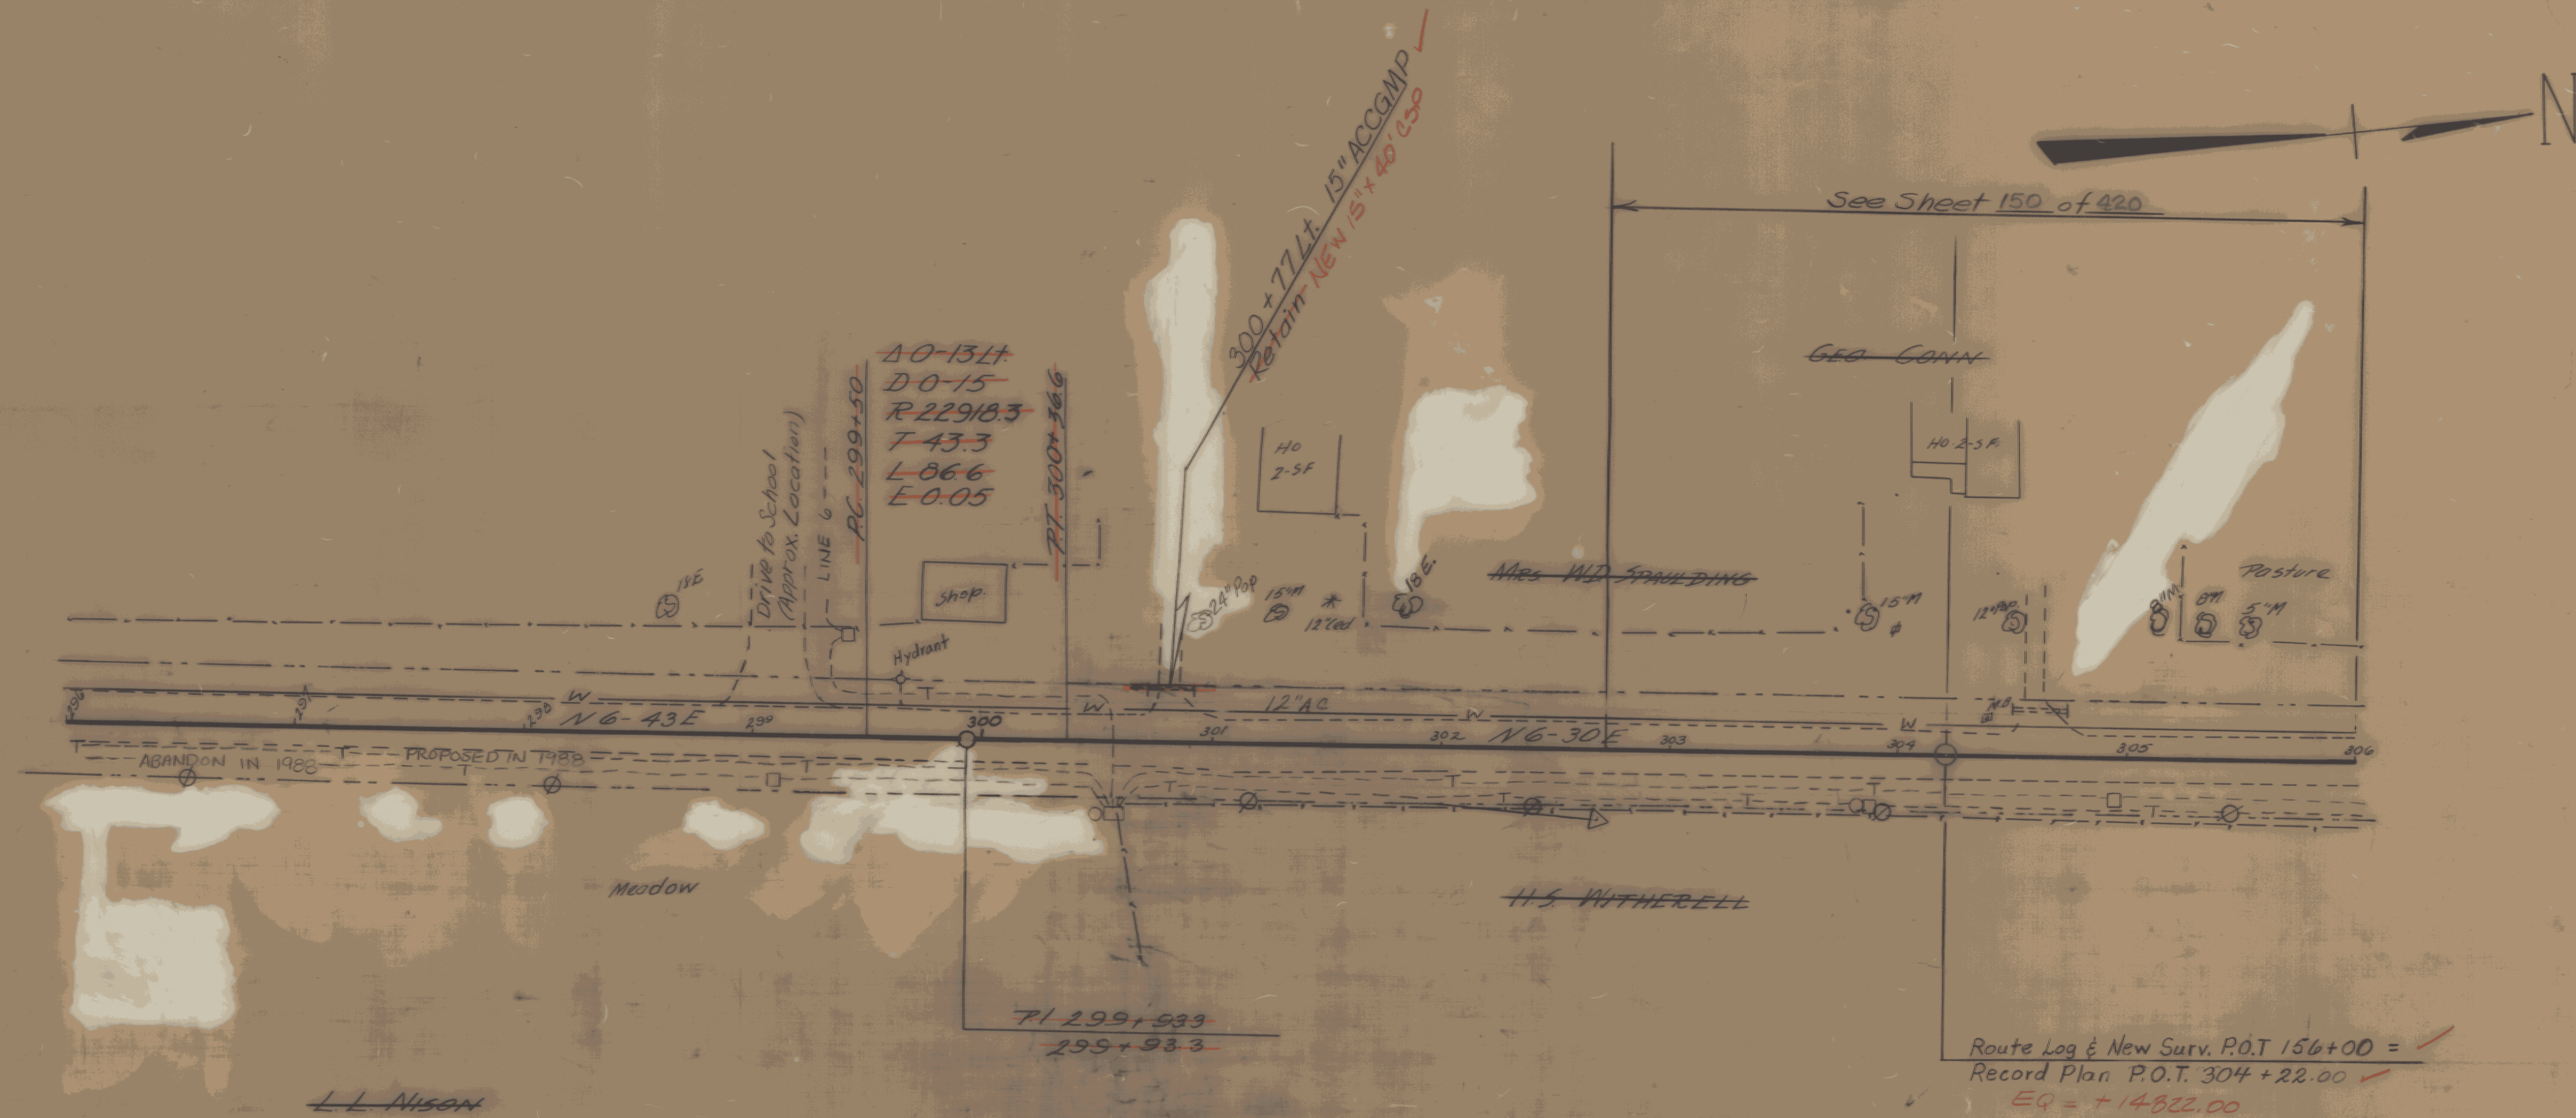