


PARCEL	INSTRUMENT	DATE	GRANTOR	GRANTEE	RECORDED BOOK PAGE DATE	REMARKS
A1	W.D.O.E.	10-10-46	WADE A. WALKER	ST. OF VT.	20-615-616-10-10-46	
A2	W.D.O.E.	11-21-46	L.R. & HAZEL B. PAYNE	"	20-620-629-11-23-46	

5 18(3) 1946 117

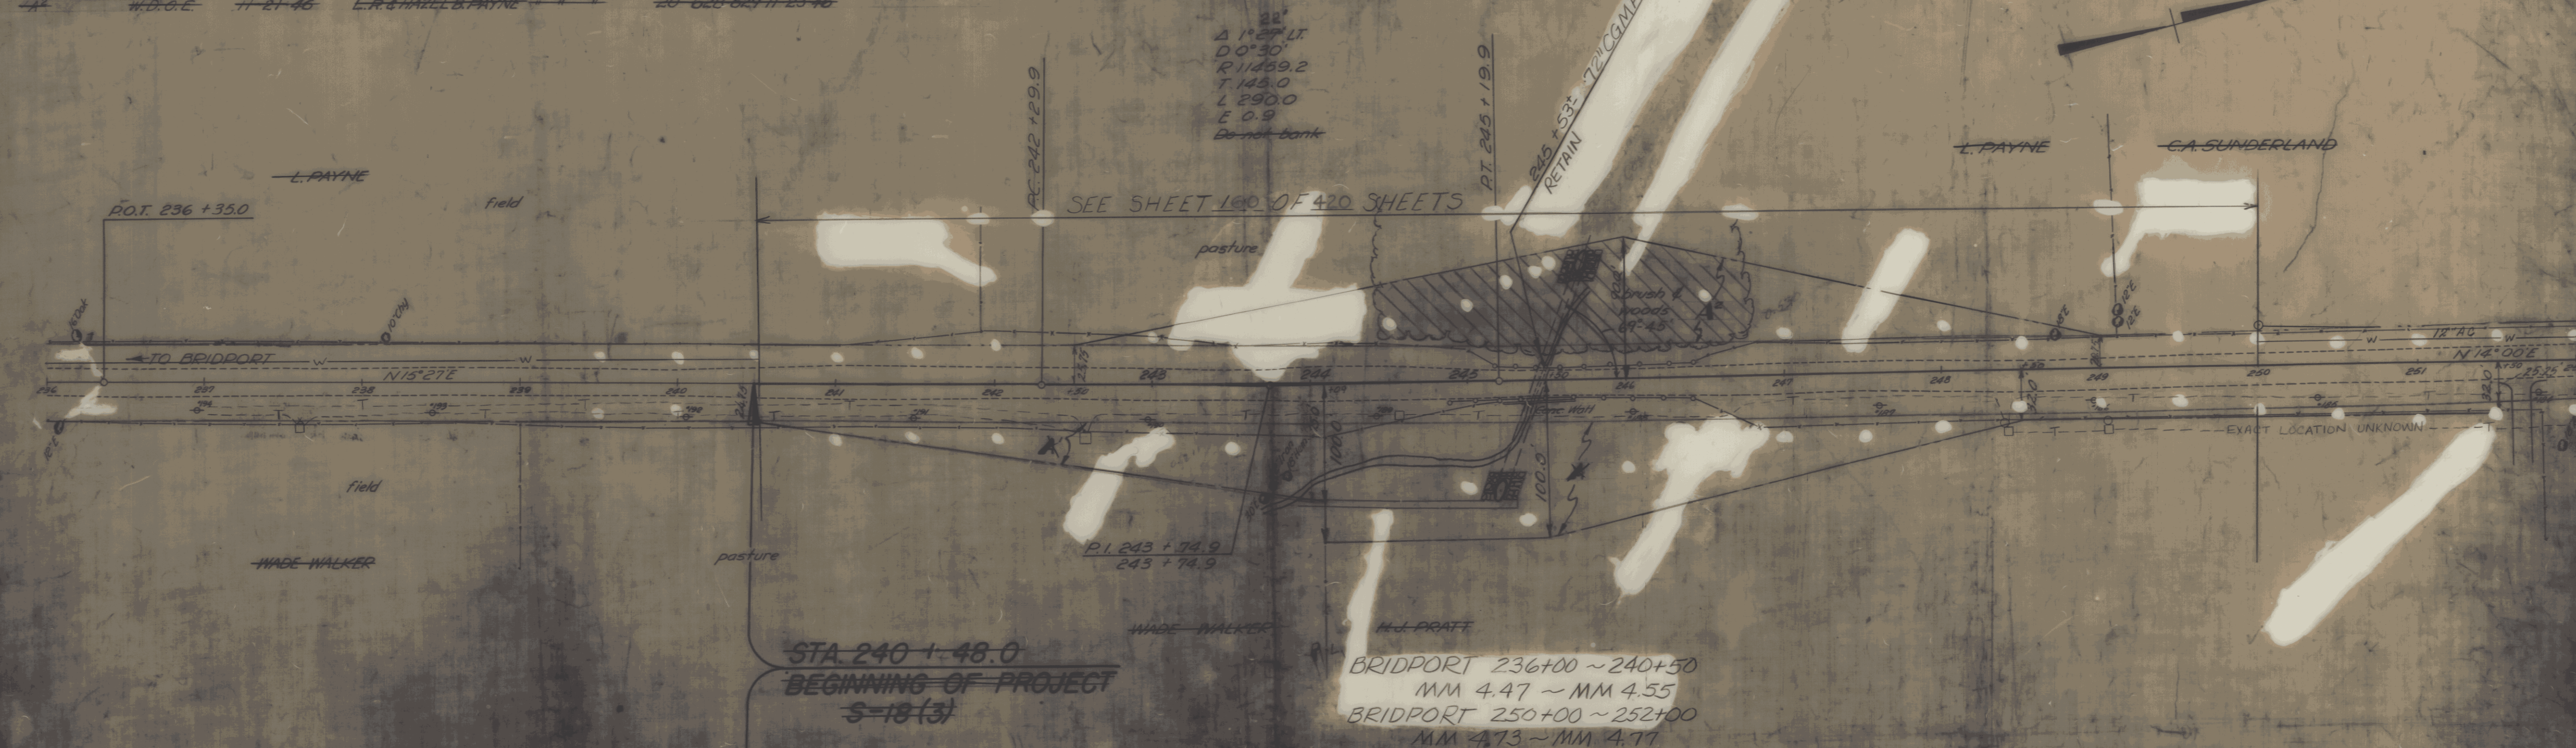

STA 240 + 48.0
BEGINNING OF PROJECT
S=18(3)

BRIDPORT 236+00 ~ 240+50
MM 4.47 ~ MM 4.55
BRIDPORT 250+00 ~ 252+00
MM 4.73 ~ MM 4.77

