

DATE	12-22
BY	12-22
REVISION	12-22
NO.	12-22


RELOCATE HAILBOY SINGLE SUPPORT
461+13.4
WIRE WIRE FENCE W/ WOOD POSTS (MOD)
461+75 - 472+80 RT
REMOVAL OF EXISTING FENCE (NON-PART)
461+75 - 472+80 RT

FIELD DRIVE
LT. 463+50 RT. 464+75

PARCEL	INSTRUMENT	DATE	GRANTOR	GRANTEE
A-88	W.D.O.E.	10-1-46	BERTHA P. CARR	ST. OF VT.
A-88	W.D.O.E.	10-1-46	THOS. E. & LUCIENNE MURRAY	"
A-2	W.D.O.E.	10-1-46	SEWARD SMITH	"

RECORDED	ADDISON	REMARKS
BOOK	PAGE	DATE
29	253-254	10-19-46
29	249-250	10-19-46
29	245-246	10-19-46

518(3) 1946 20 117

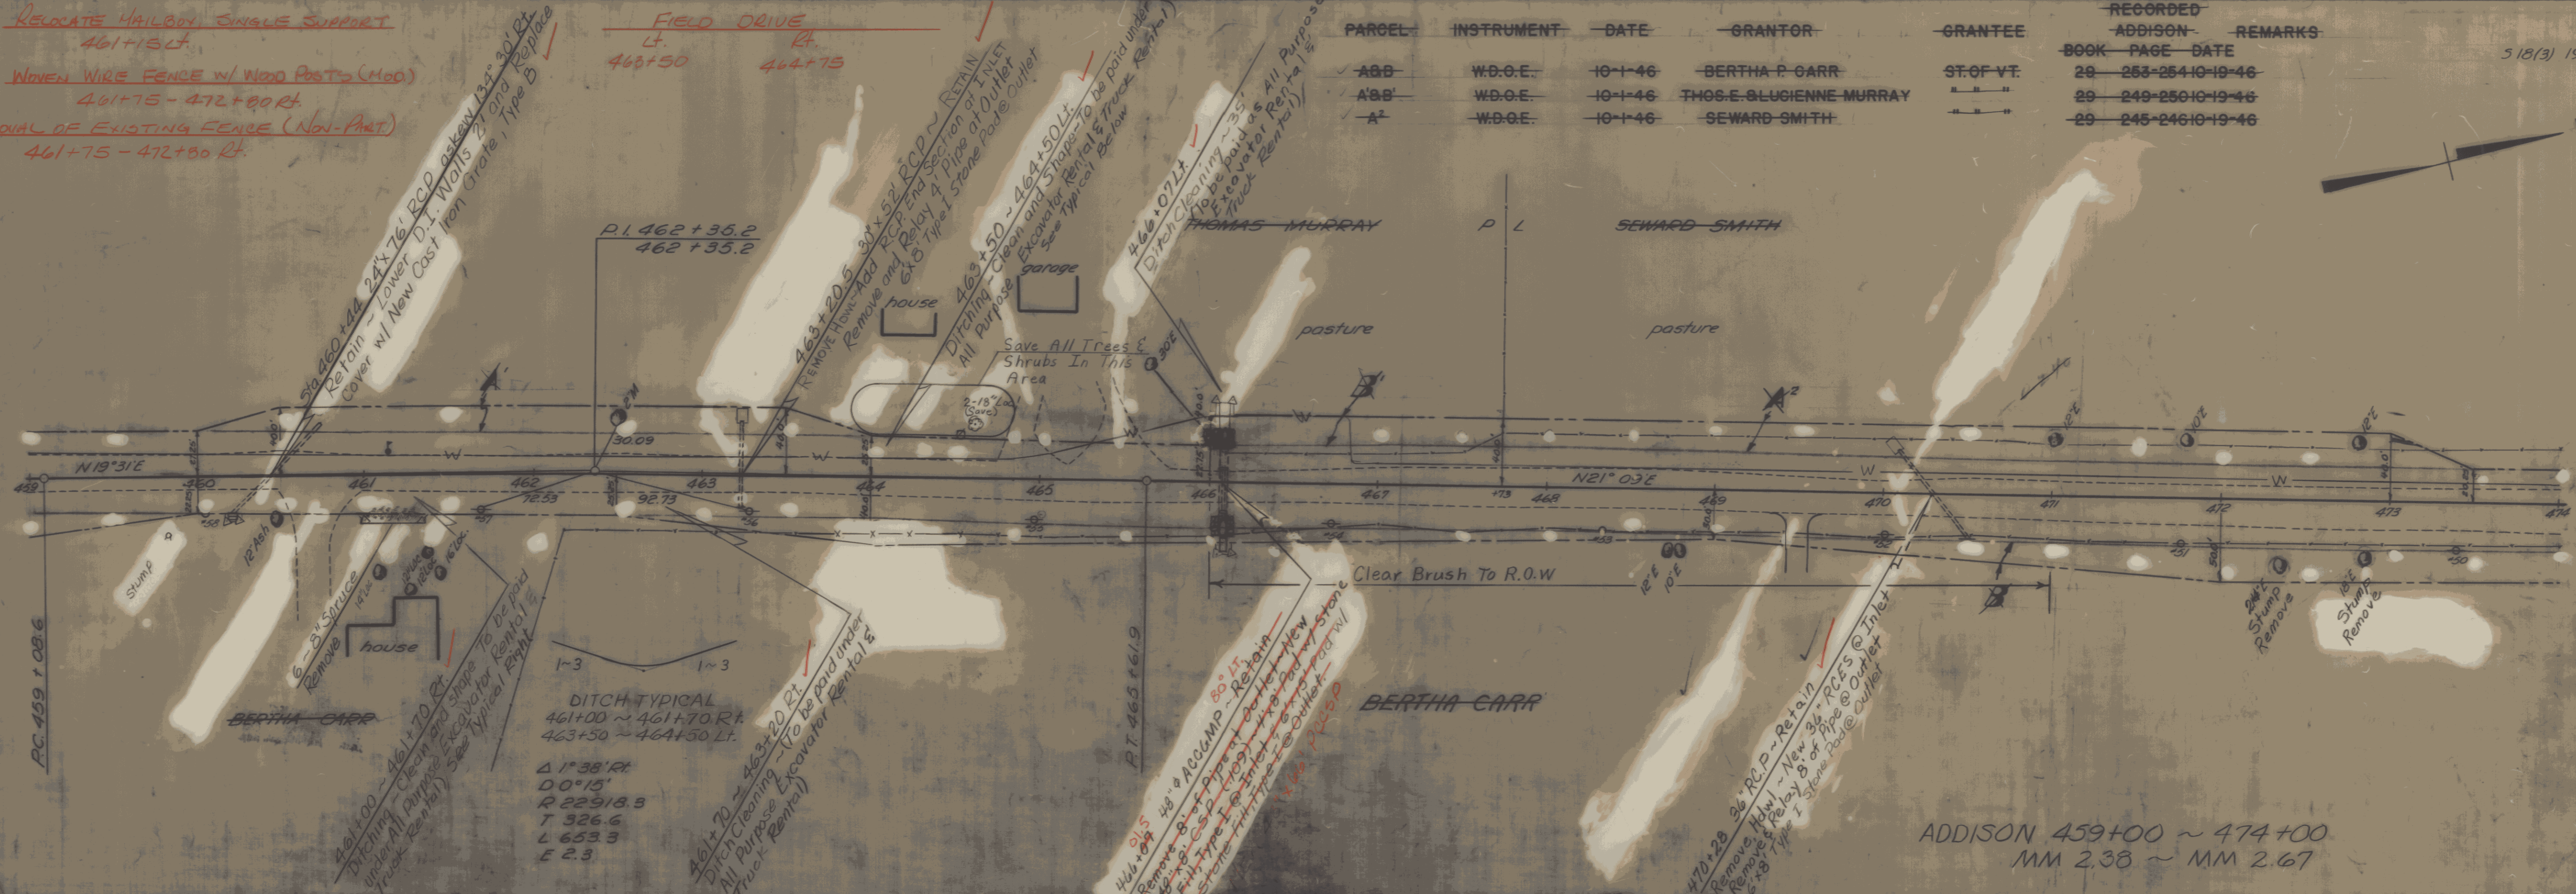

ADDISON 459+00 ~ 474+00
MM 2.38 ~ MM 2.67

