
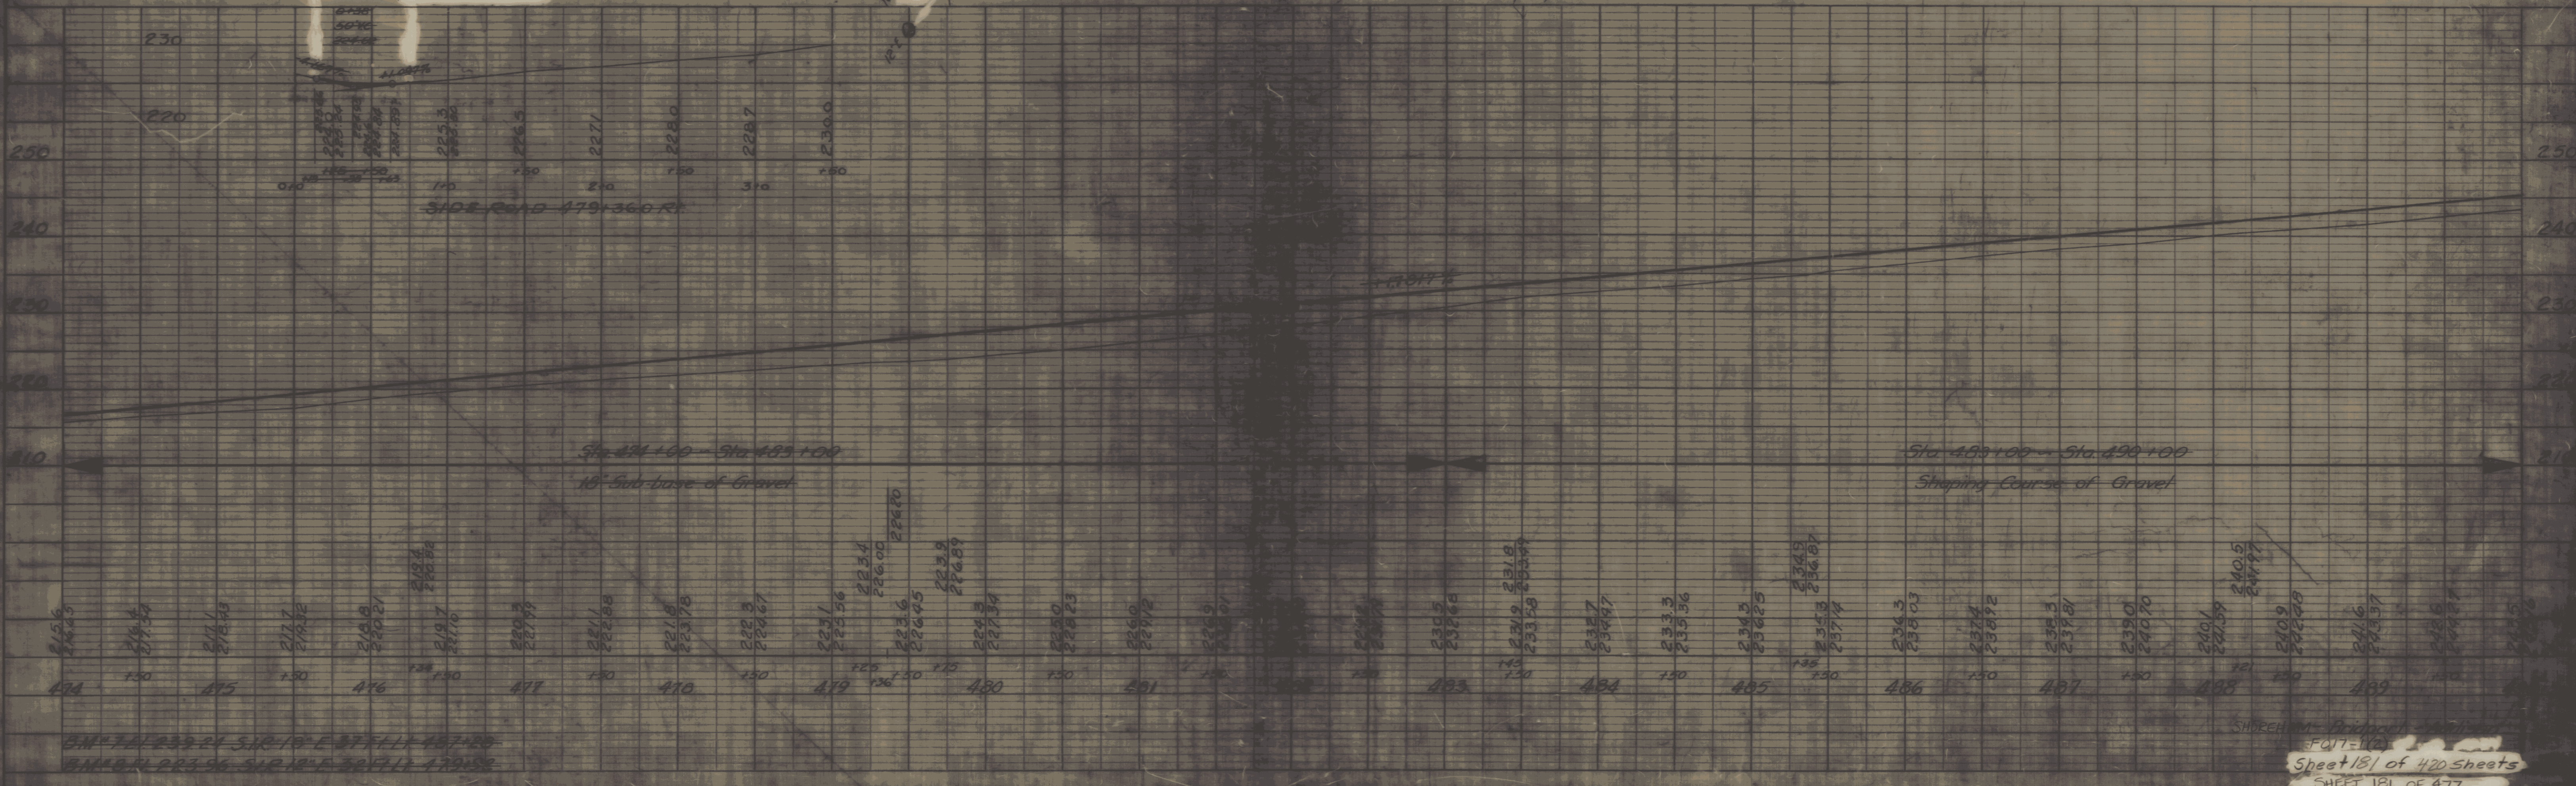


DATE	10/19/46
BY	W.D.O.E.
REVISION	1
NO.	1
DATE	10/19/46
BY	W.D.O.E.
REVISION	1
NO.	1

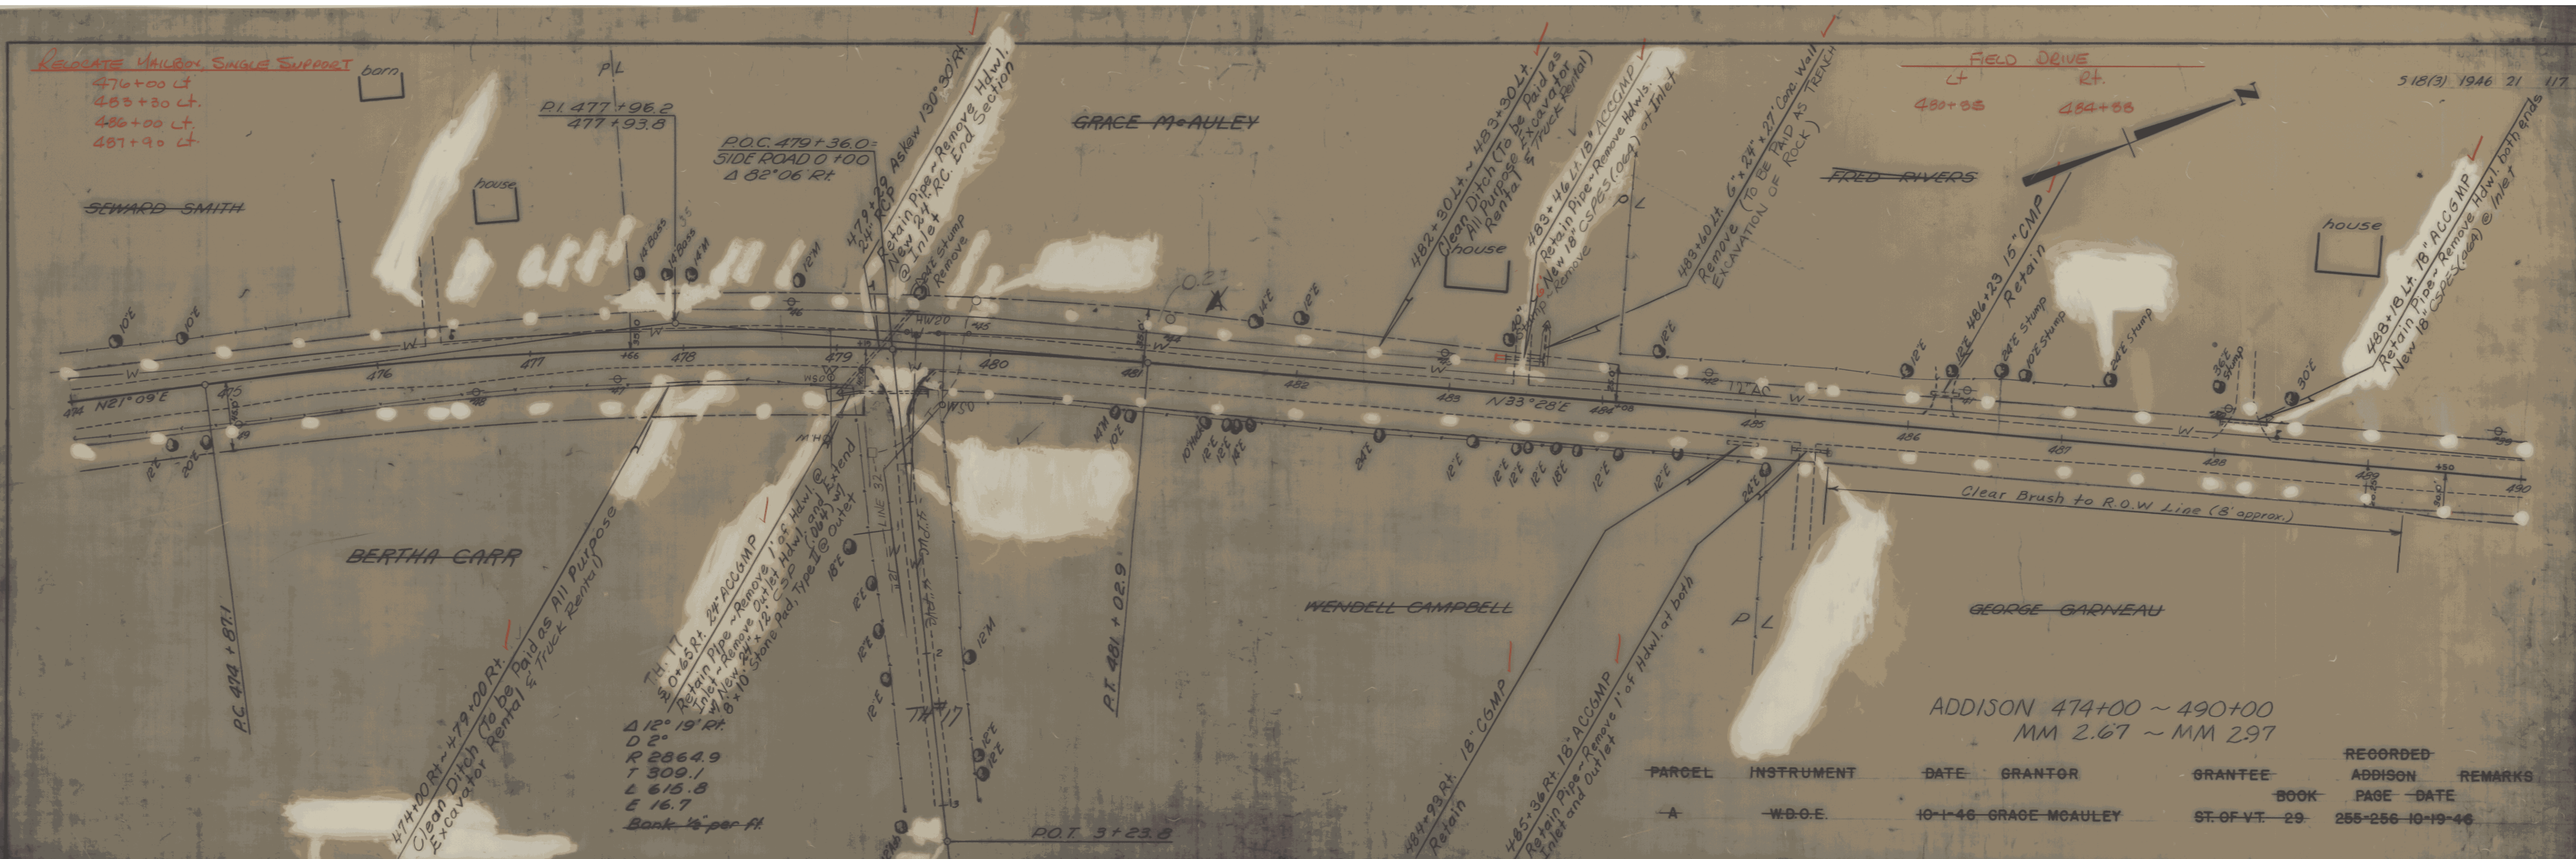

ADDISON 474+00 ~ 490+00
MM 2.67 ~ MM 2.97

PARCEL	INSTRUMENT	DATE	GRANTOR	GRANTEE	BOOK	PAGE	REMARKS
A	W.D.O.E.	10-1-46	GRACE MCAULEY	ST. OF VT.	29	255-256	10-19-46