


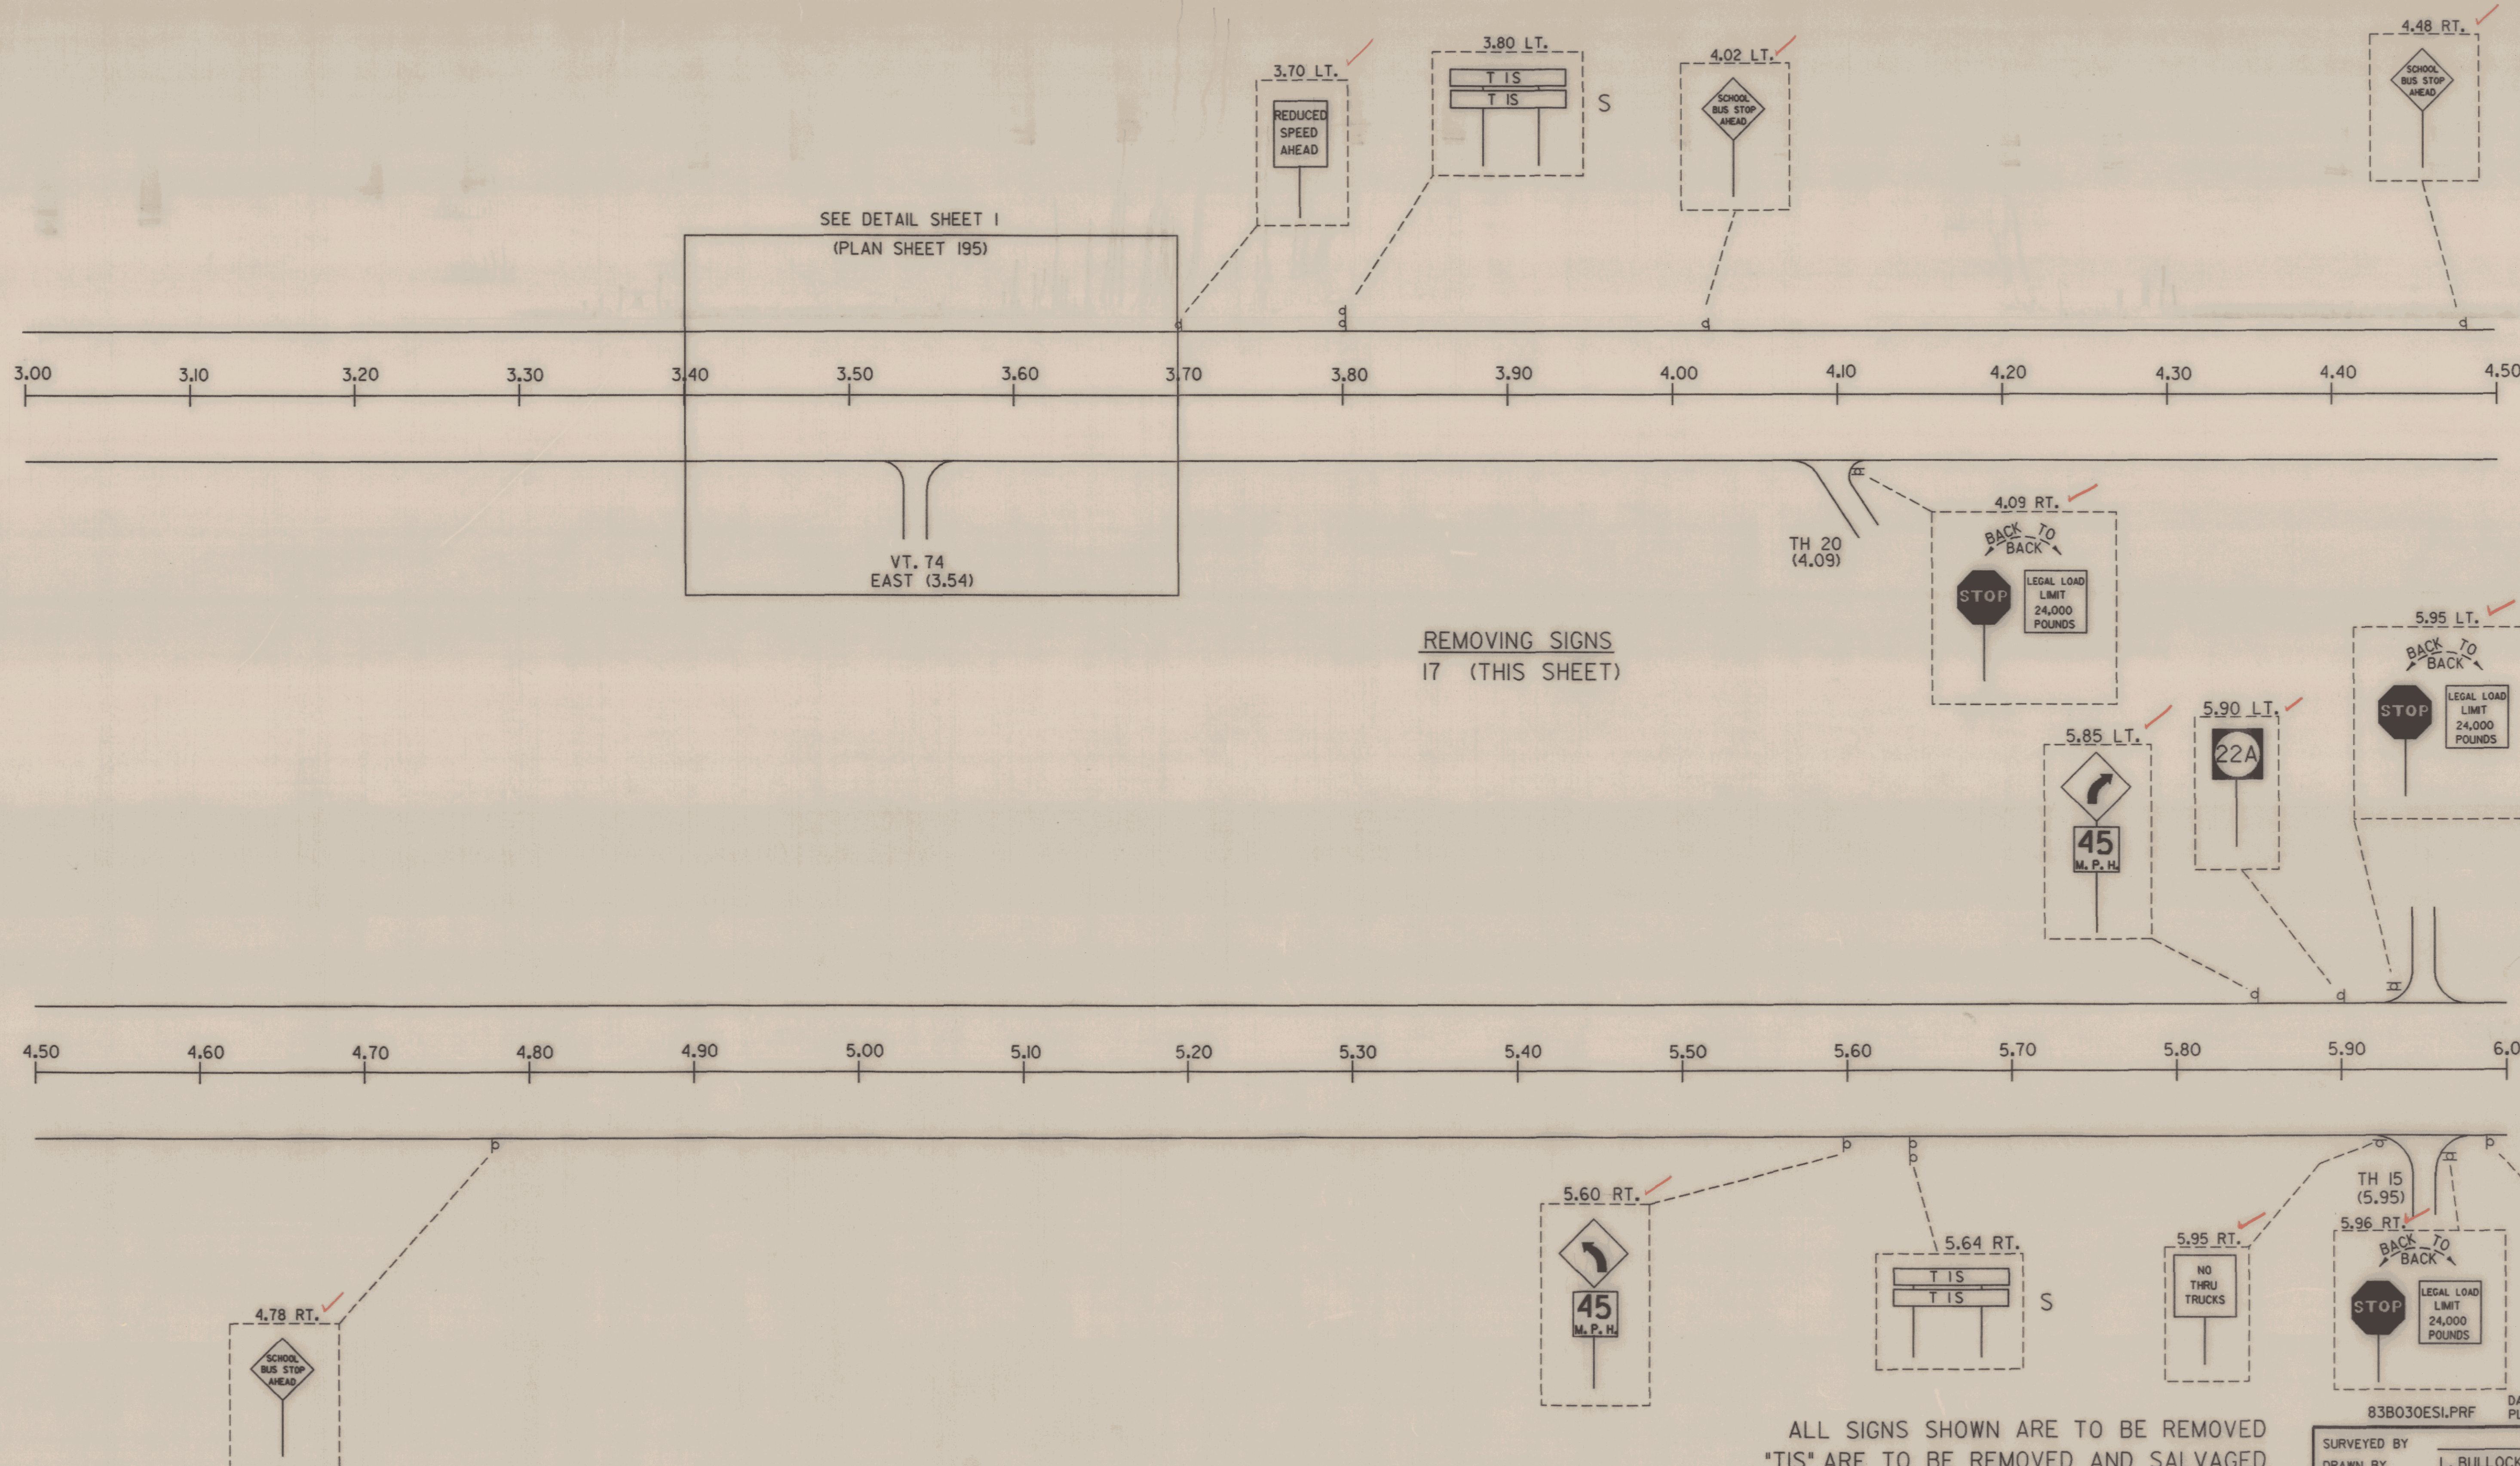

REMOVING SIGNS
17 (THIS SHEET)

ALL SIGNS SHOWN ARE TO BE REMOVED
"TIS" ARE TO BE REMOVED AND SALVAGED

SHOREHAM EXISTING SIGNS

DATUM
VERTICAL NGVD 1929
HORIZONTAL N/A

0 0.05 0.10
SCALE IN MILES

83B030ESI.PRF DATE PLOTTED 29-DEC-1989
SURVEYED BY DATE
DRAWN BY L. BULLOCK DATE 3/89
SQUAD LEADER J. PERKINS
DESIGN FILE NO. ZG04150,63183B030.DGN
PROJ. NAME SHOREHAM-BRIDPORT-ADDISON
PROJ. NO. F 017-1(2)
SHEET 190 OF 420 SHEETS