
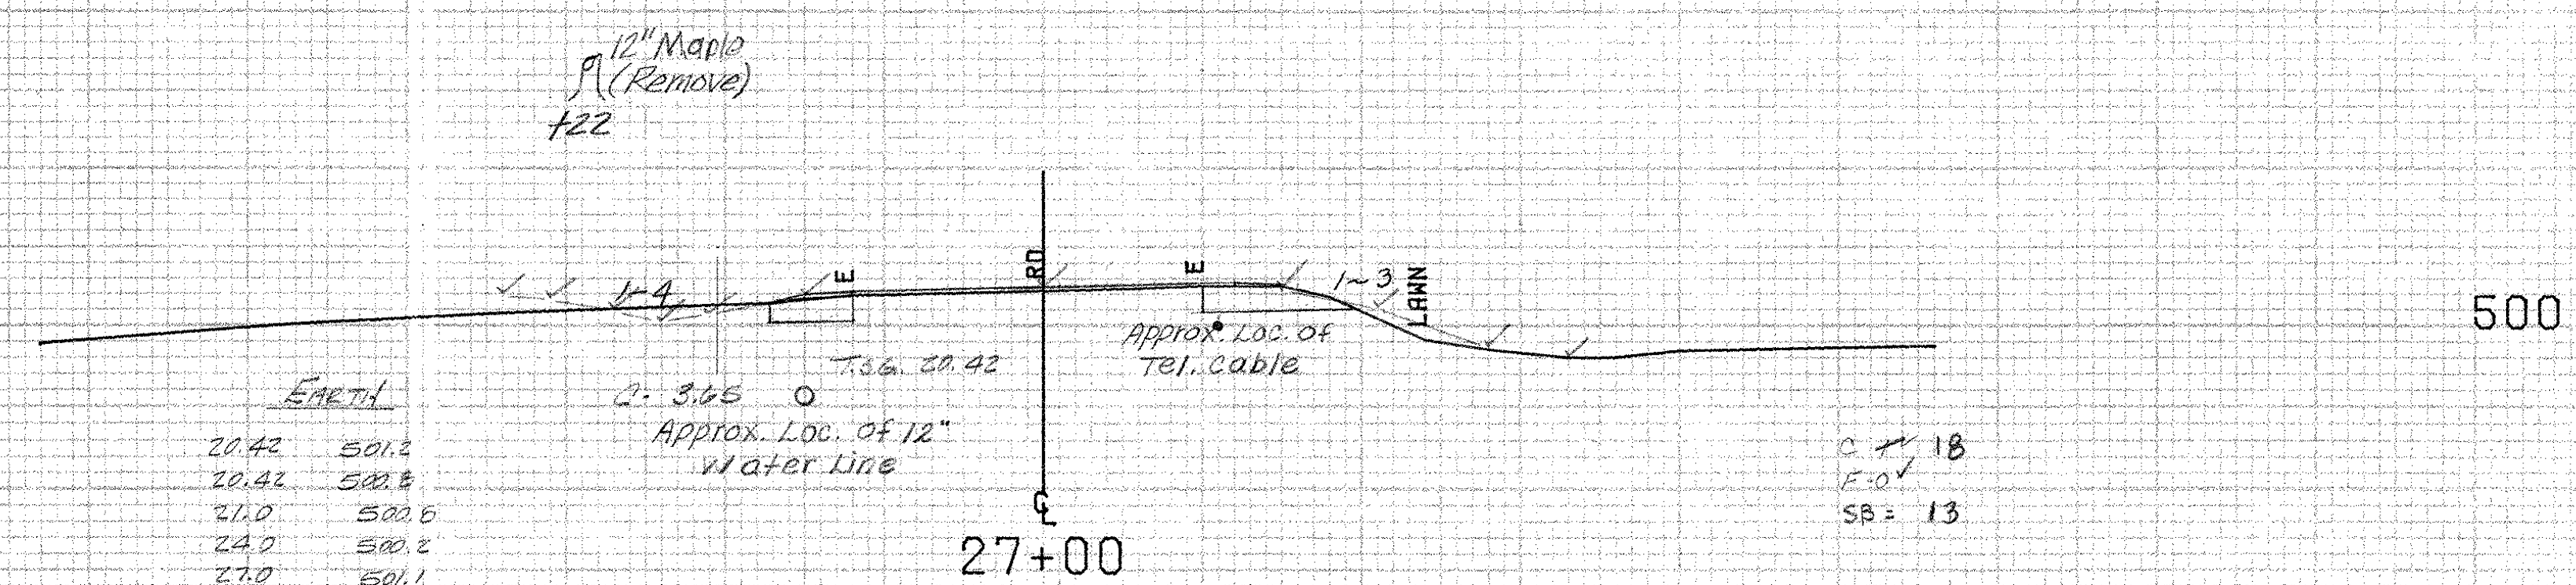
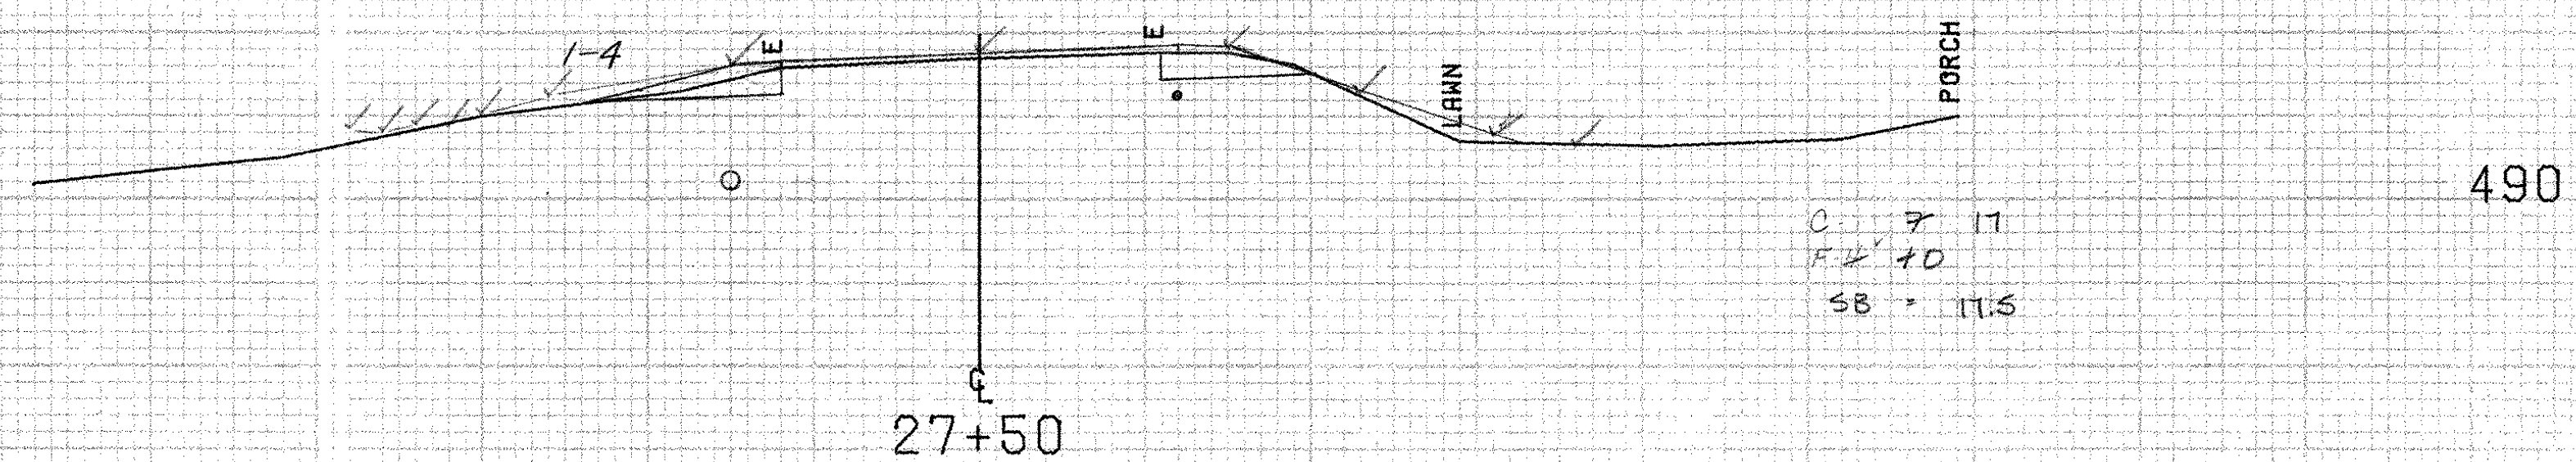
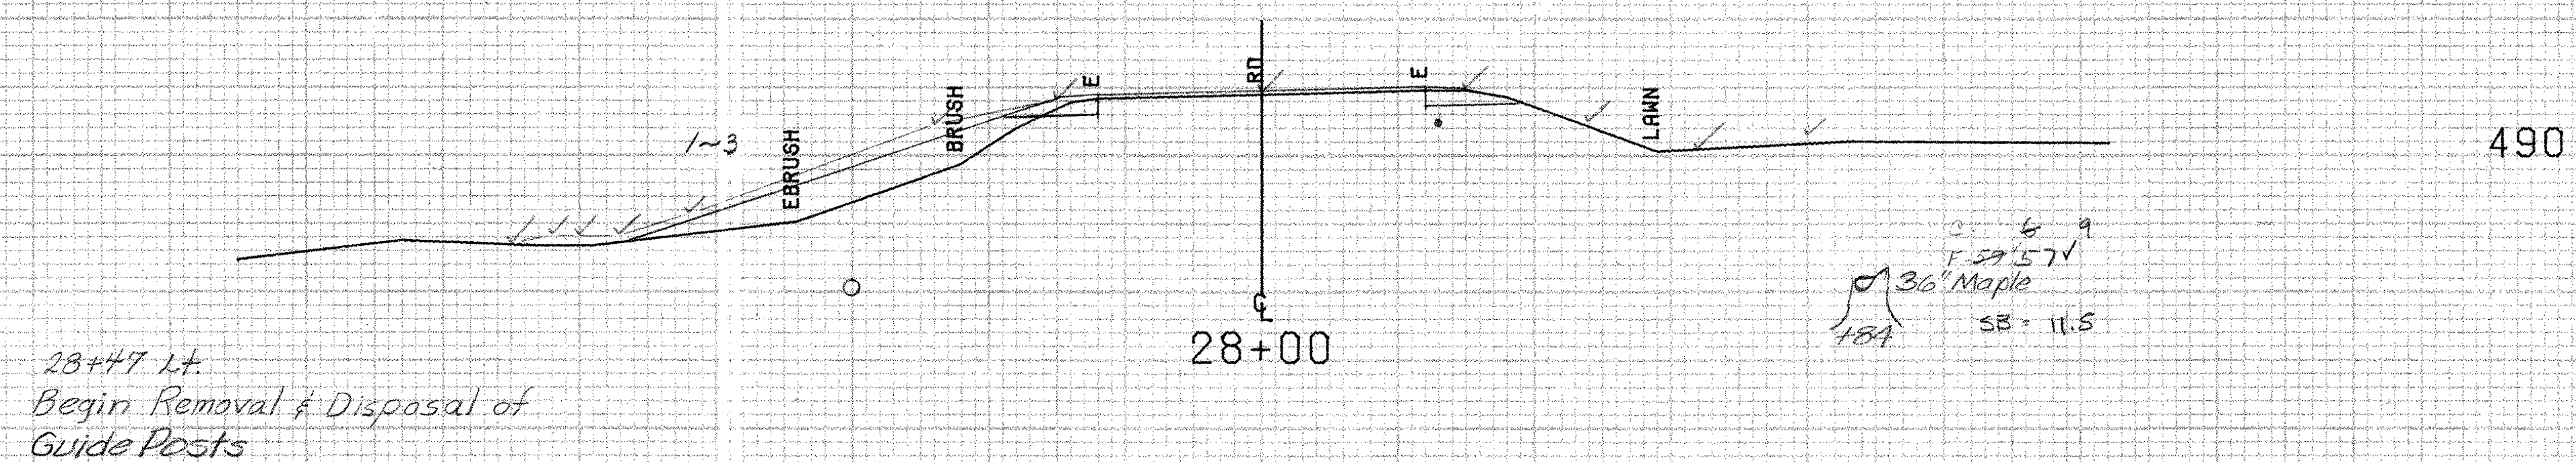
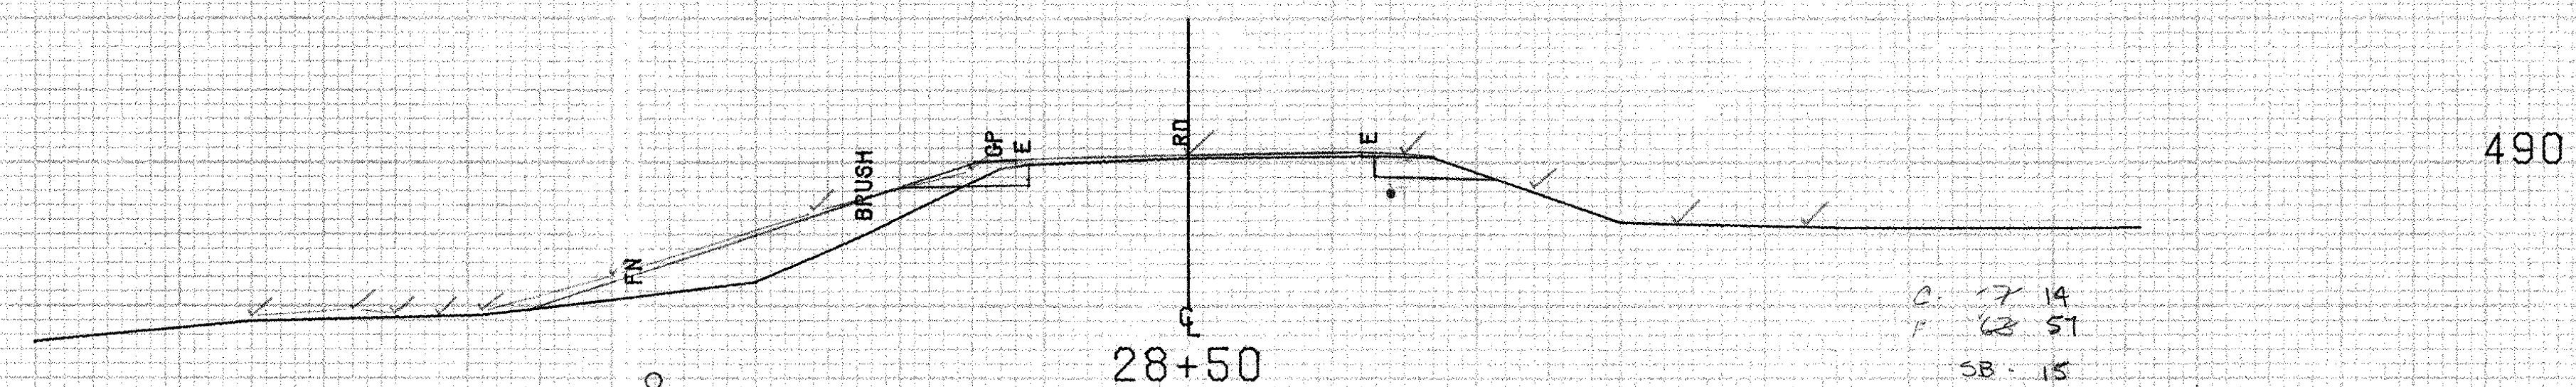


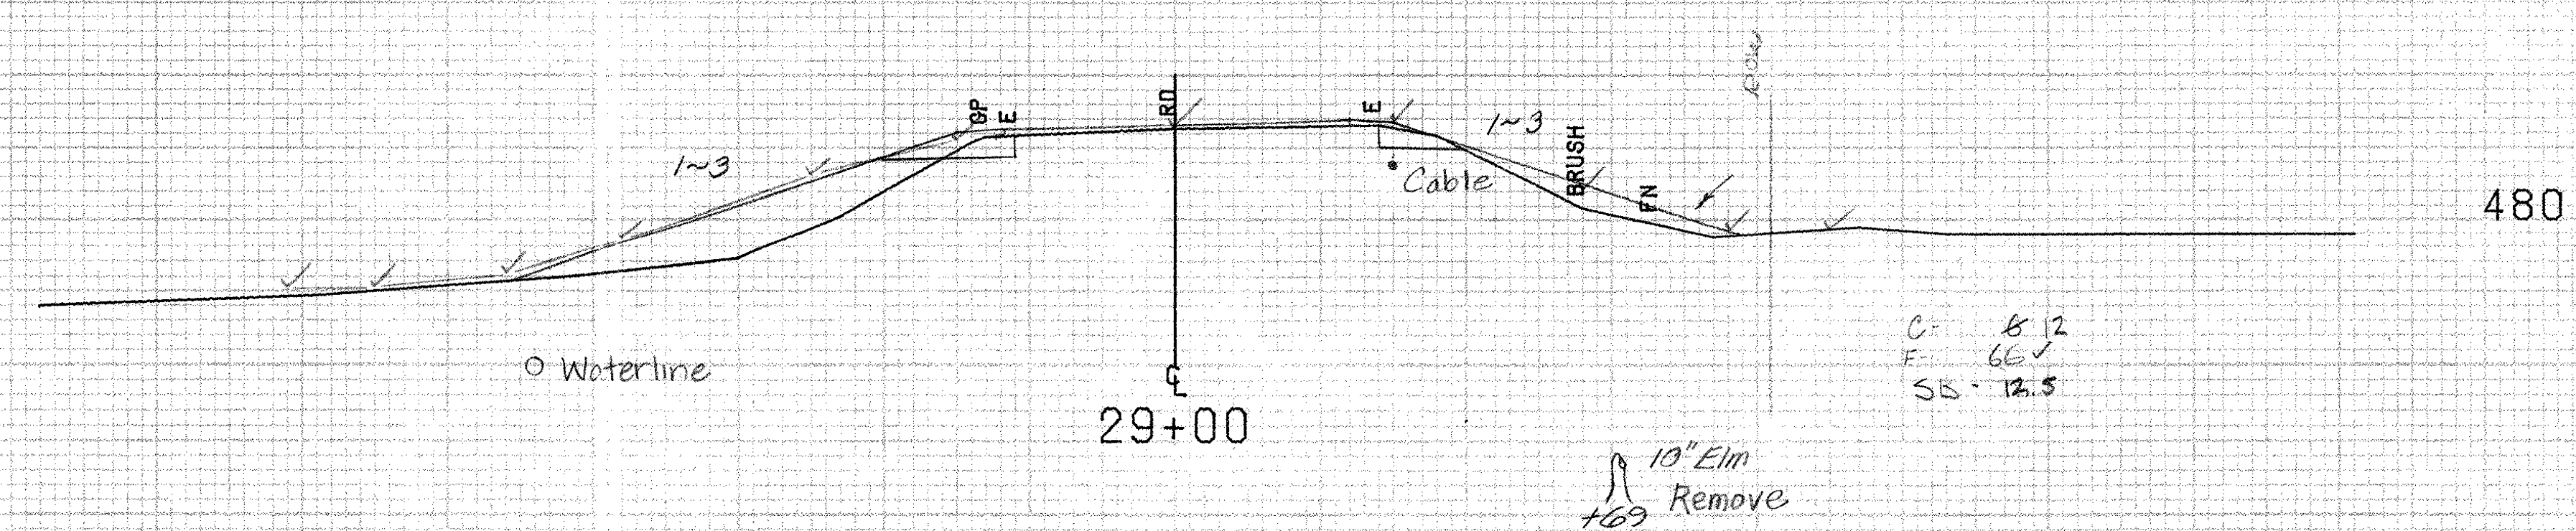

Shoreham MM 4.09 ~ MM 4.18

FROM STA.	27+00	TO STA.	29+00
PROJECT NAME	SHOREHAM-ADDISON	MAIN1	
NO.	F017-1(2)	PLOTTED	01/09/85
SURVEYED BY	FANTONI	DEC	1984
SHEET	252 OF 420 SHEETS	SHEET	257 OF 477

SCALE 1" = 10 FEET