


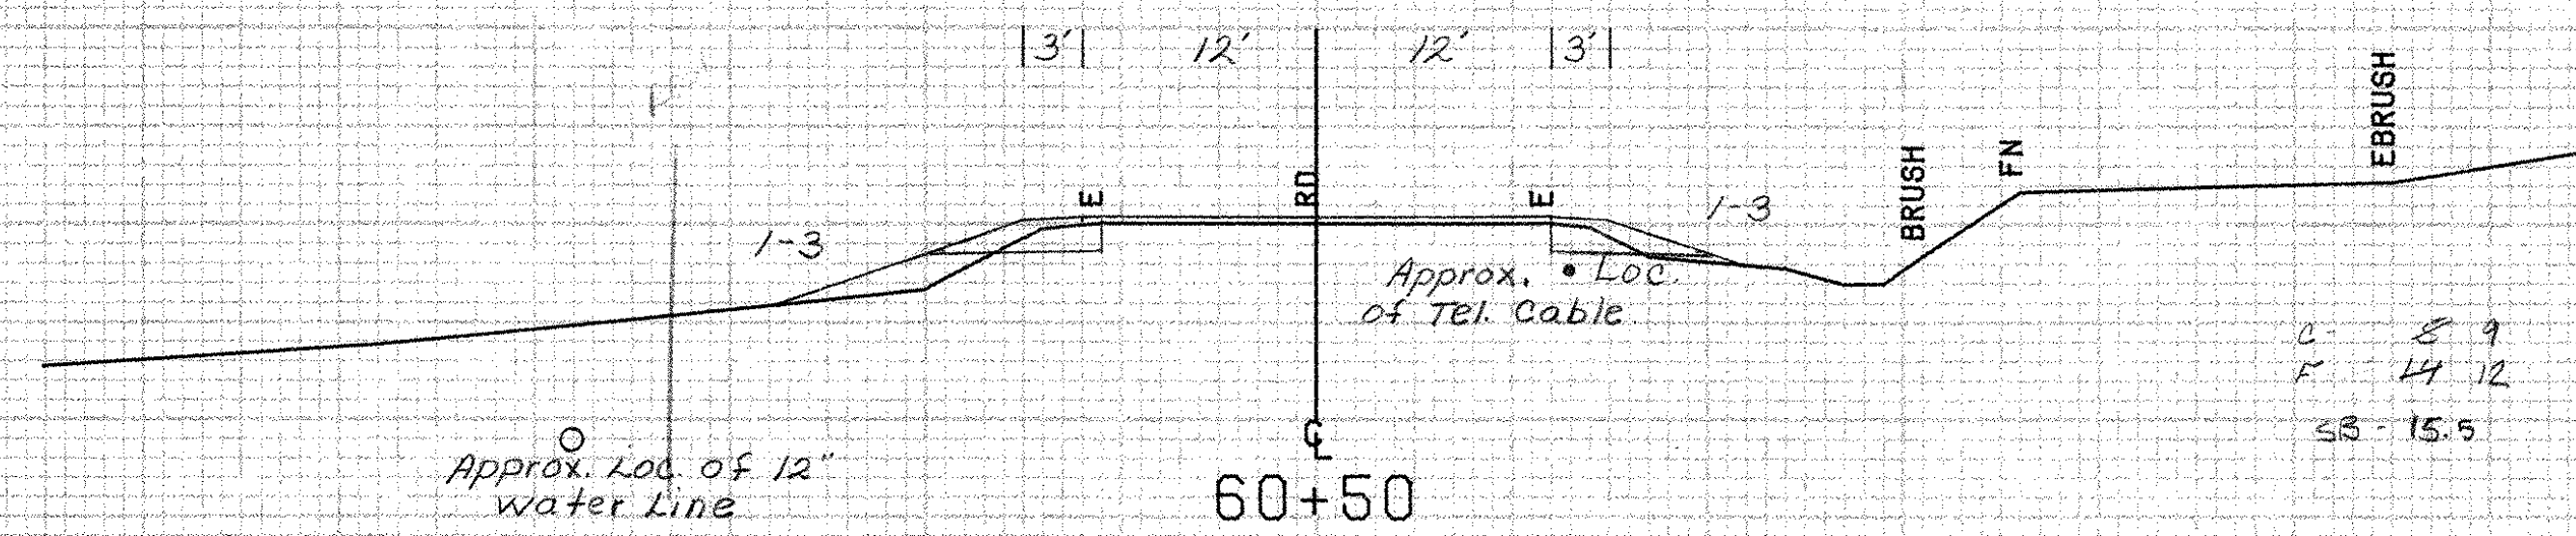

510

SCALE 10 FEET

SHOREHAM MM 4.61 ~ MM 4.74			
FROM STA.	60+50	TO STA.	60+50
PROJECT NAME	SHOREHAM-BRIDPORT-ADDISON		
SURVEYED BY	FANTONI	DEC 1984	PLOTTED 01/16/85
SHEET 270	OF 420 SHEETS	3x6 FT	270 OF 477