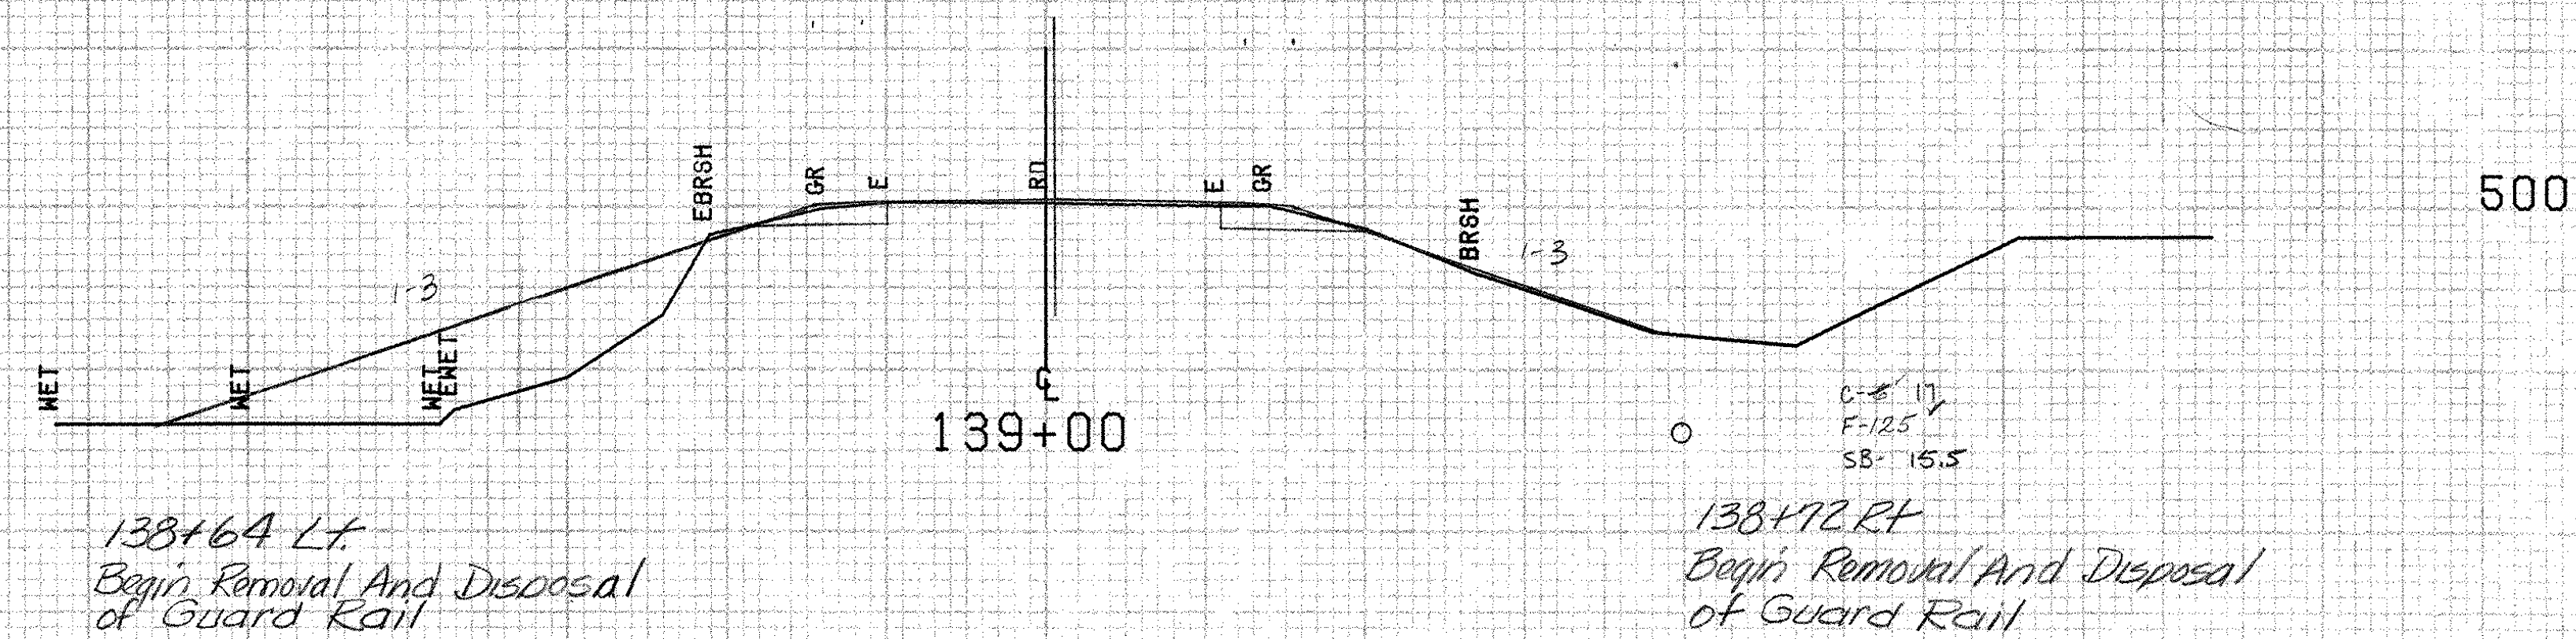
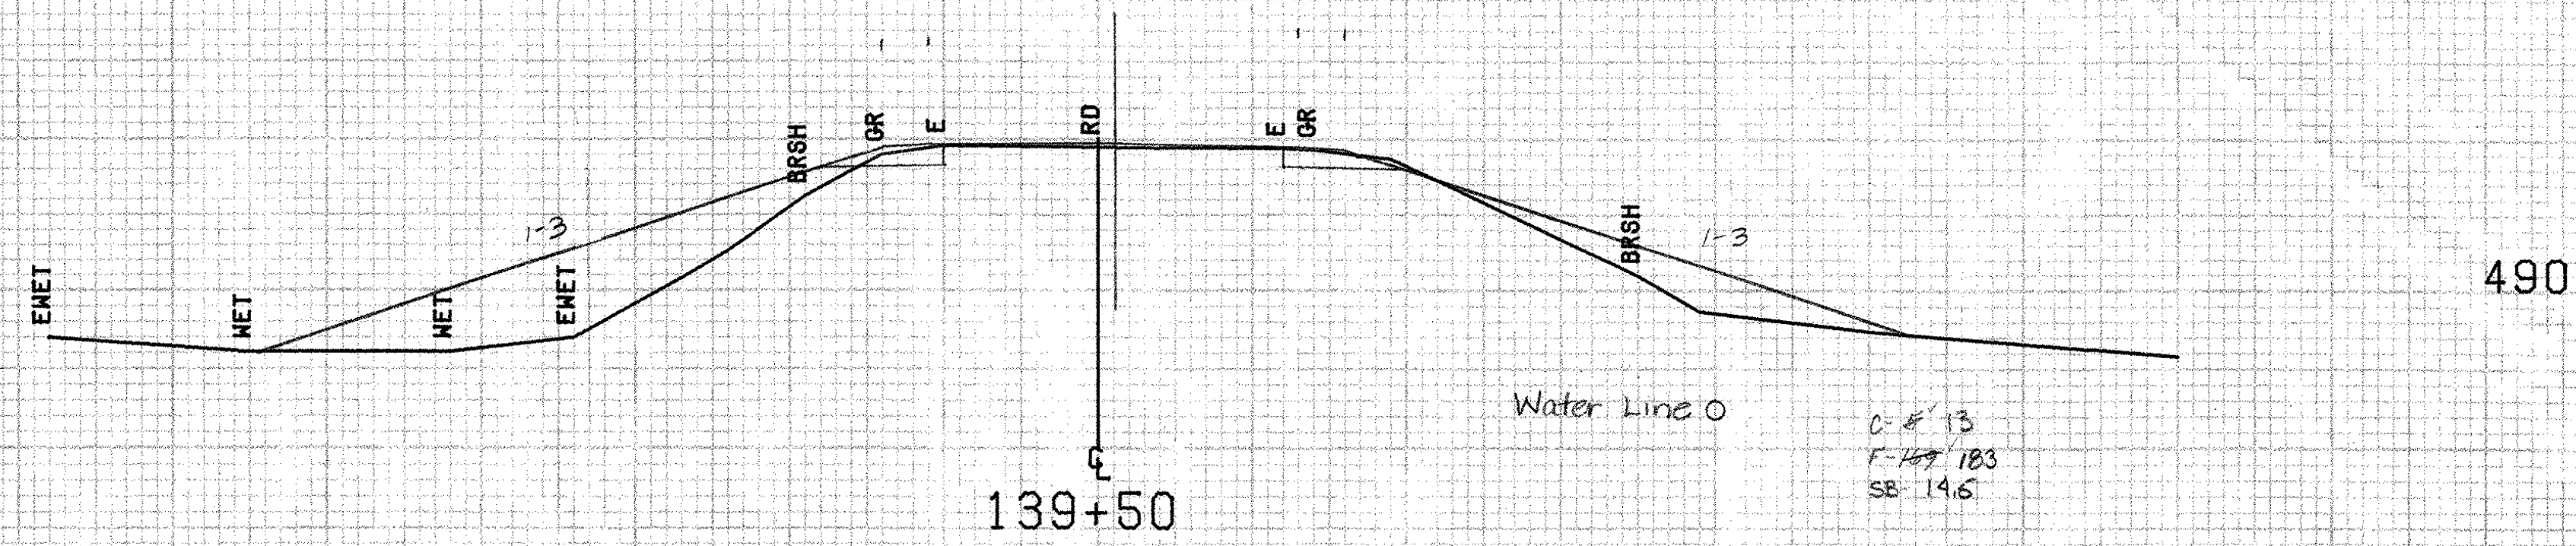


SHOREHAM ~ BRIDPORT MM 6.17 ~ MM 0.07

FROM STA.	138+00	TO STA.	139+50
PROJECT NAME	SHOREHAM-BRIDPORT-ADDISON		
NO.	F017-1(2)	PLOTTED 02/10/84	
SURVEYED BY	FANTONI	JAN 1984	
SHEET	278 OF 420 SHEETS	SHEET 278 OF 477	

SCALE 10 FEET