
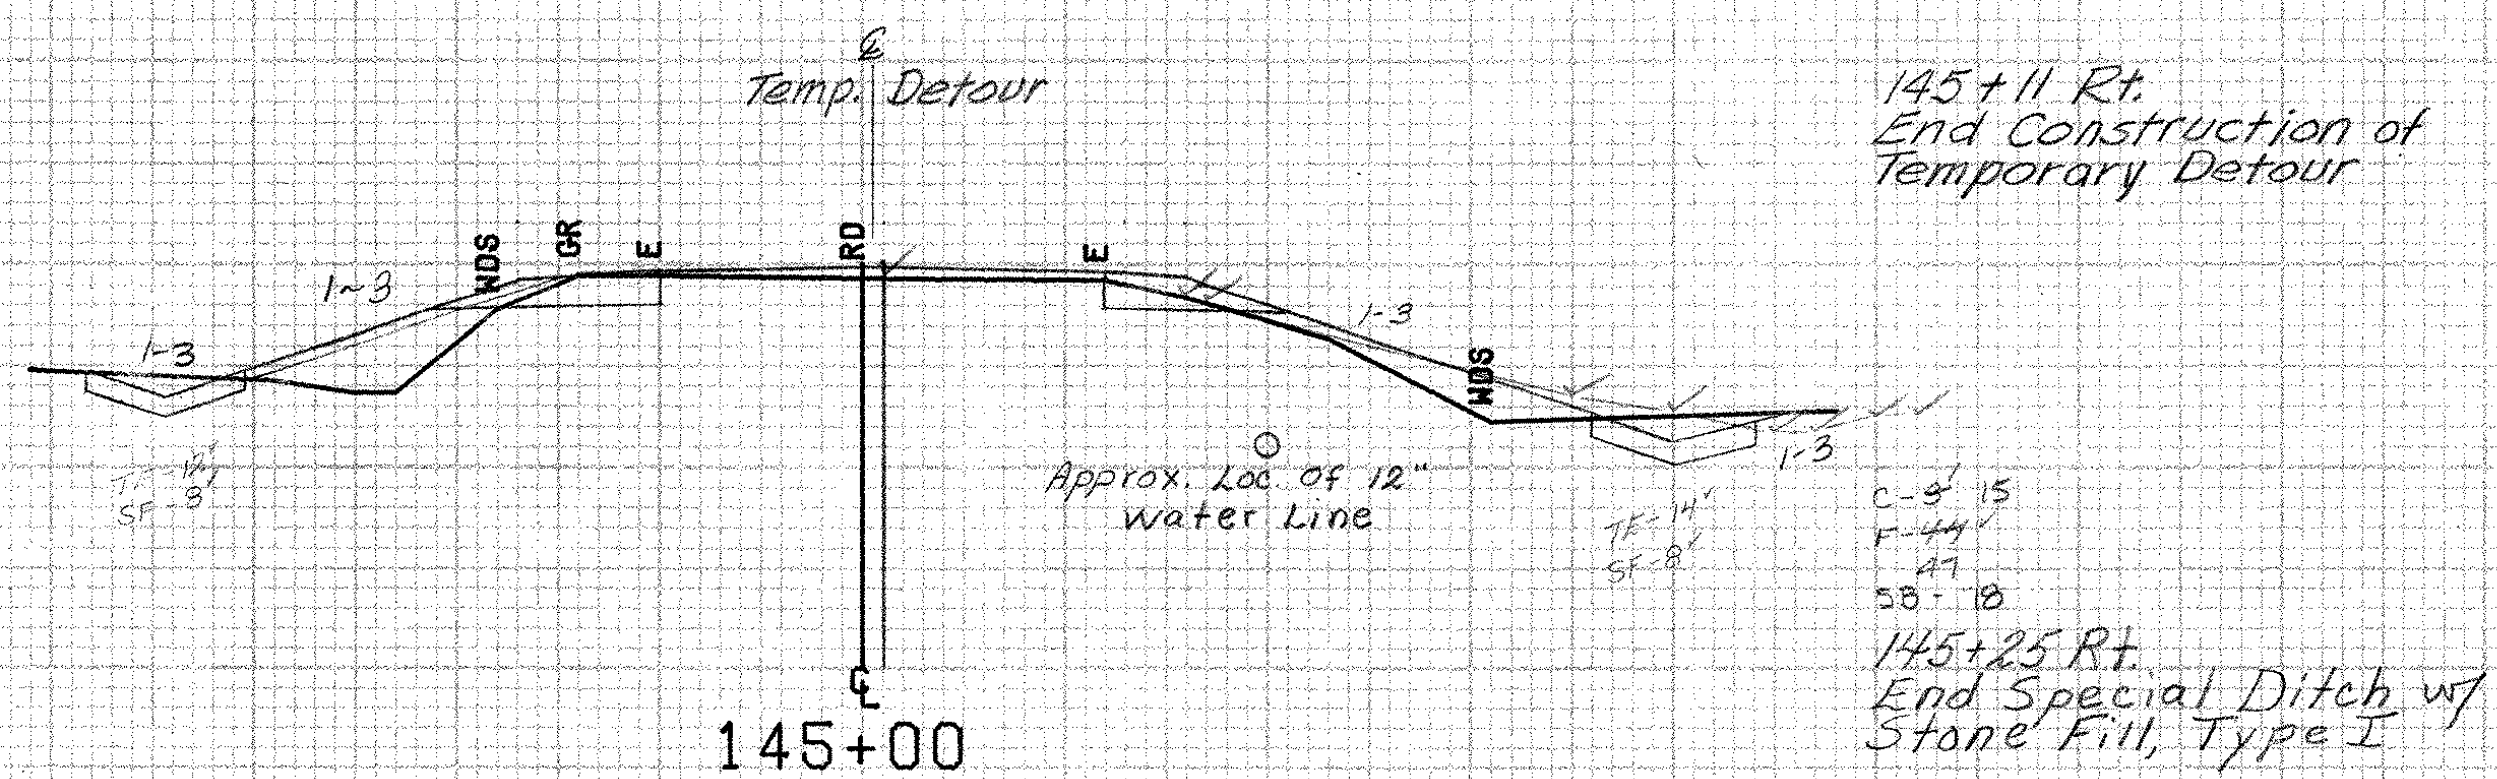
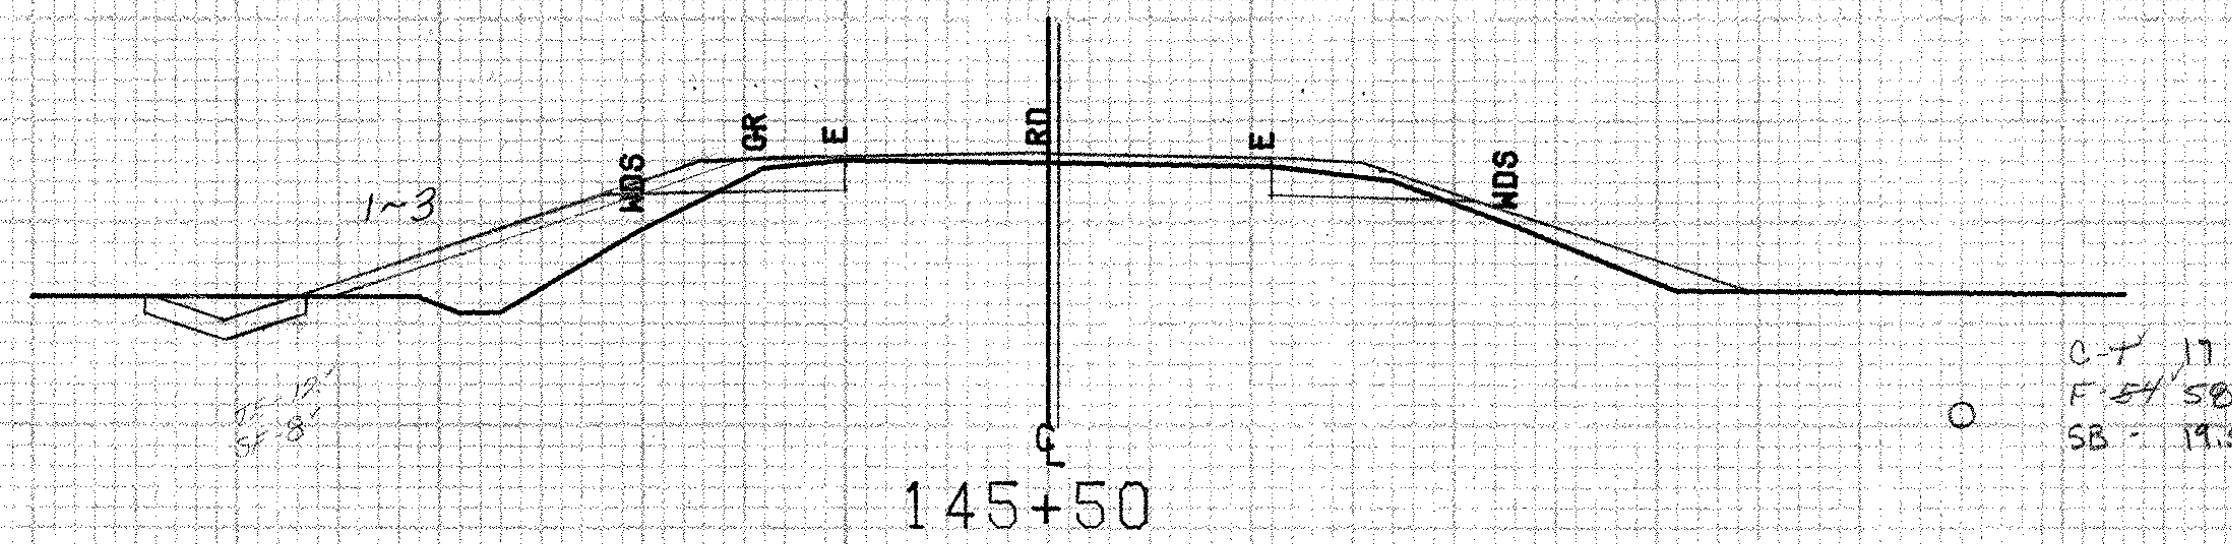
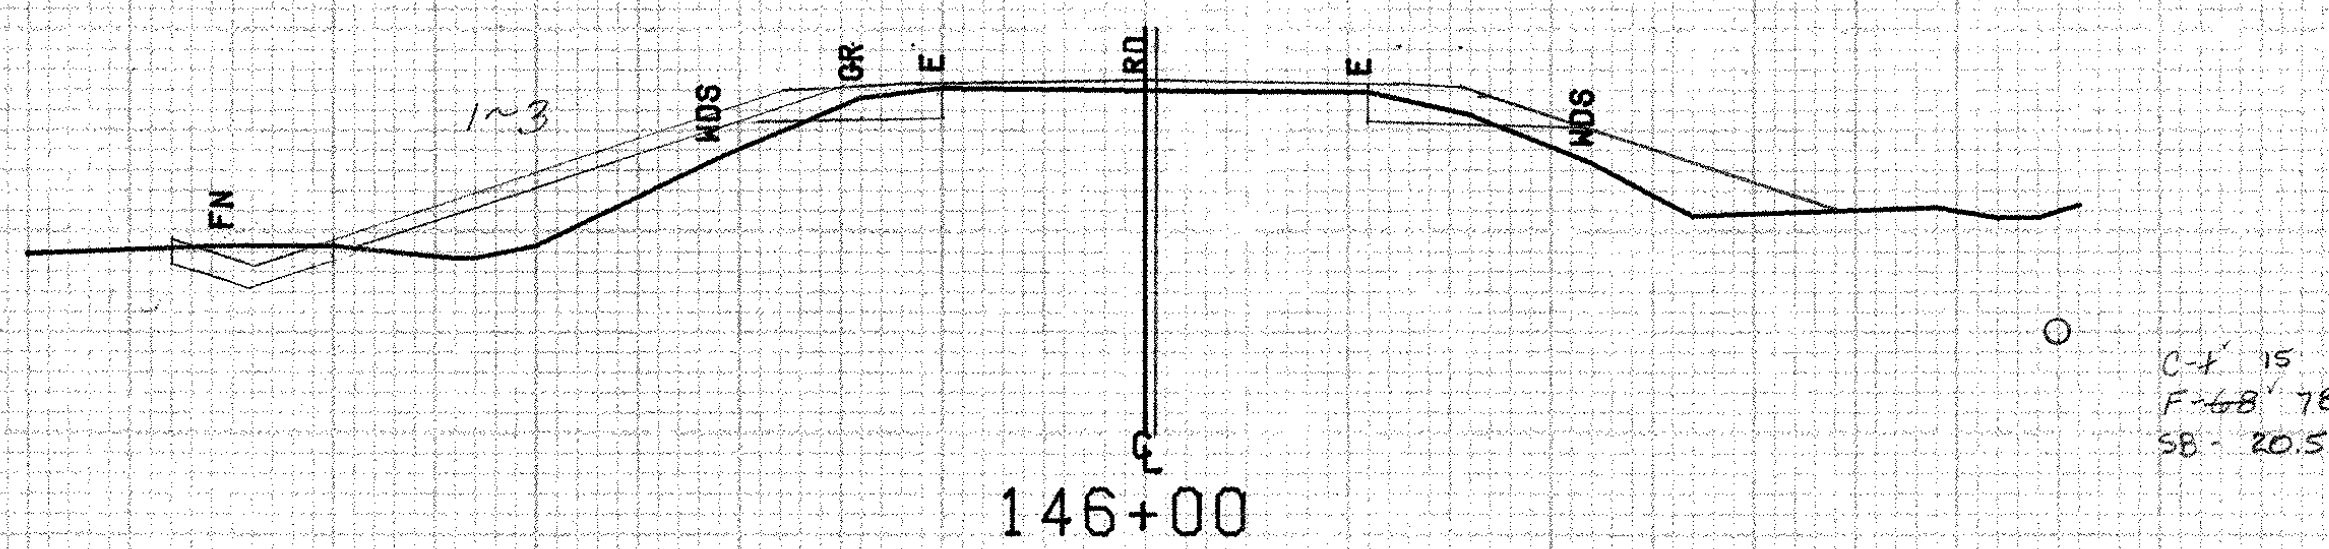
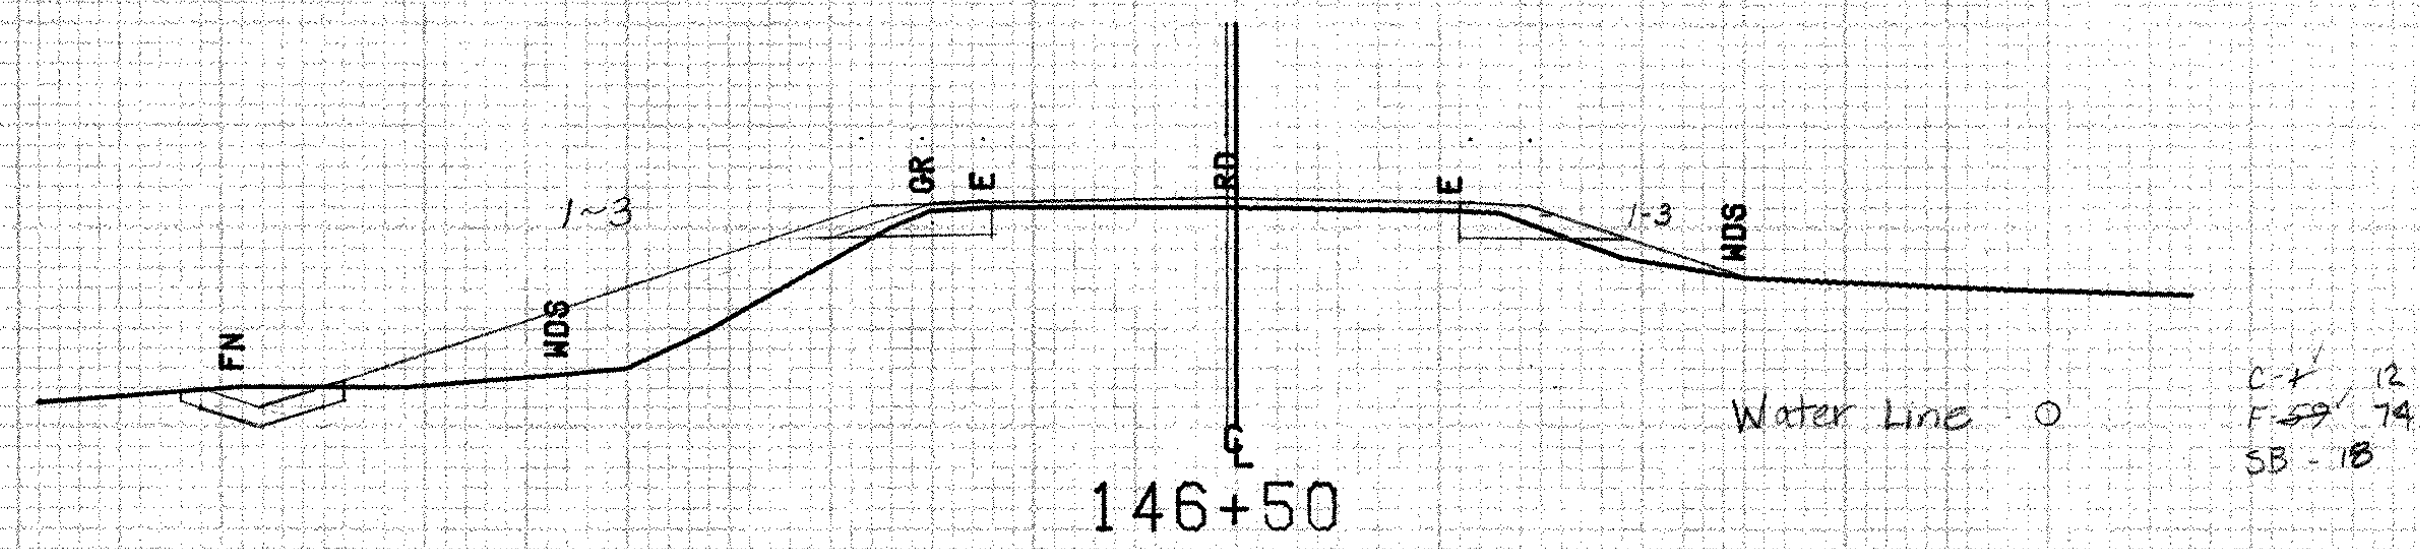


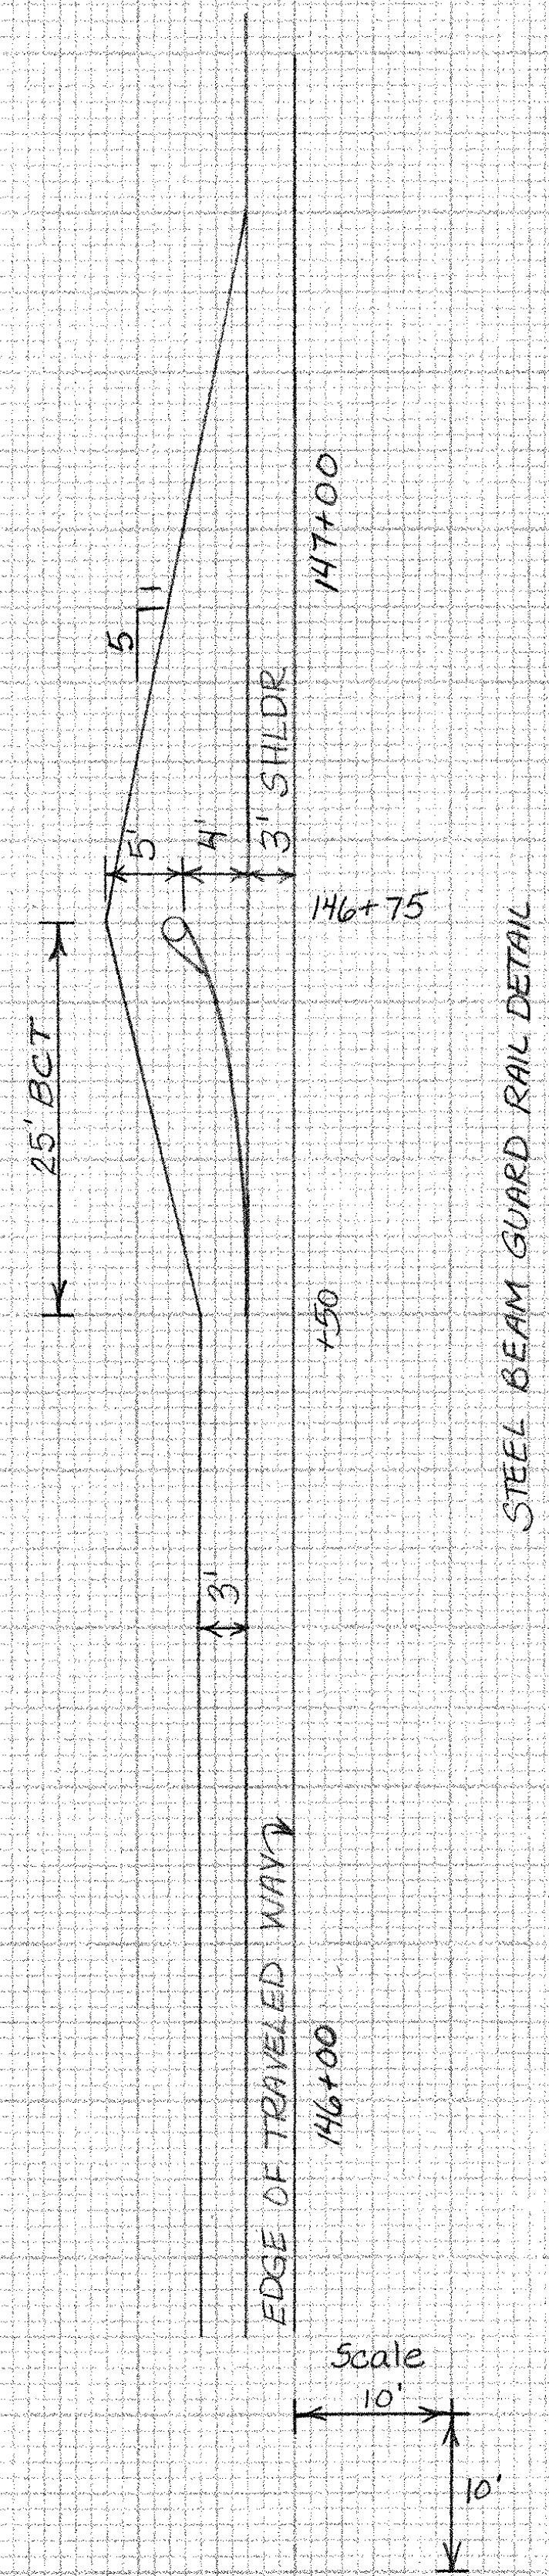

520

510

510

500

SHOREHAM - BRIDPORT MM 6.17 - MM 0.07

|                         |                           |
|-------------------------|---------------------------|
| FROM STA. 145+00        | TO STA. 146+50            |
| PROJECT NAME            | SHOREHAM-BRIDPORT-ADDISON |
| NO. F017-1(2)           | PLOTTED 02/10/84          |
| SURVEYED BY FANTONI     | JAN 1984                  |
| SHEET 282 OF 420 SHEETS | SHEET 282 OF 477          |

SCALE 10 FEET