


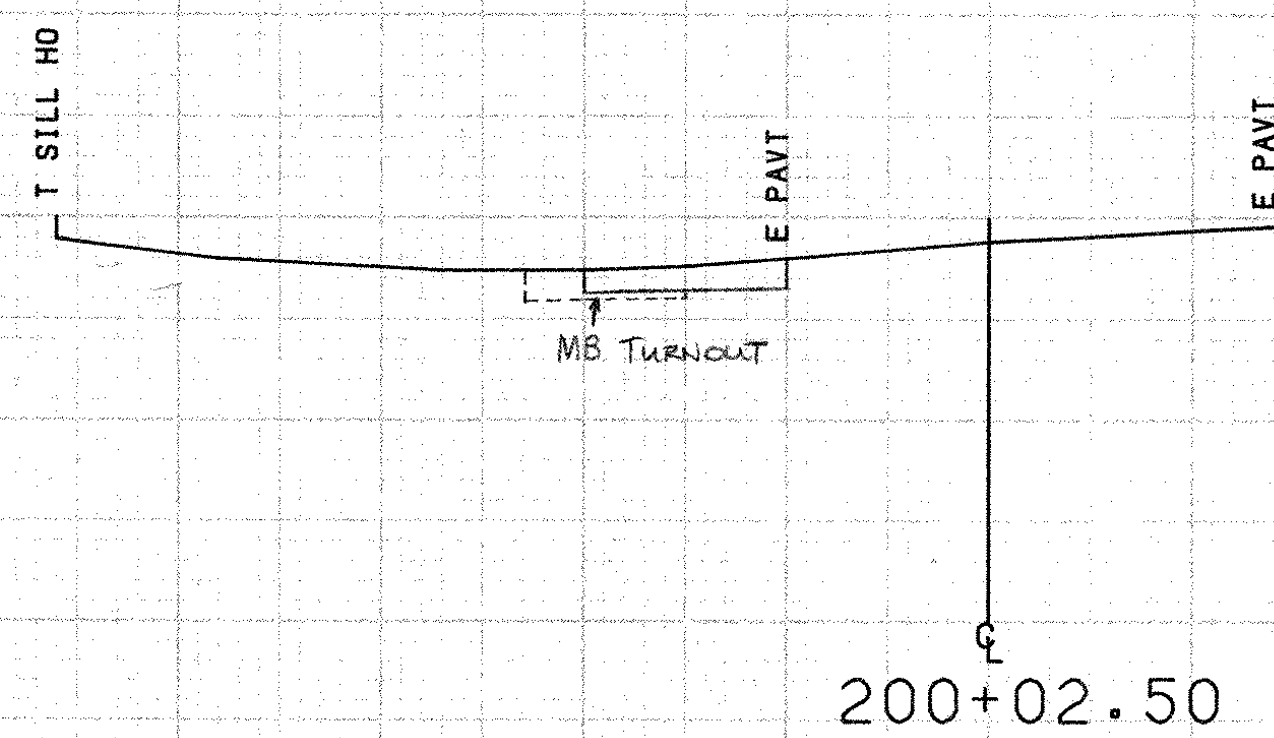

C = 18
T = 0
CB = 17

460

Bridport MM 1.00

SCALE 1" = 10 FEET

FROM STA.	200+02.50	TO STA.	200+02.50
PROJECT NAME	SHOREHAM-BRIDPORT-ADDISON		
NO.	F017-1 (2)	PLOTTED	05/27/88
SURVEYED BY	MOREAU	05/88	0130
SHEET 297 OF 420 SHEETS	SHEET 297 OF 477		