
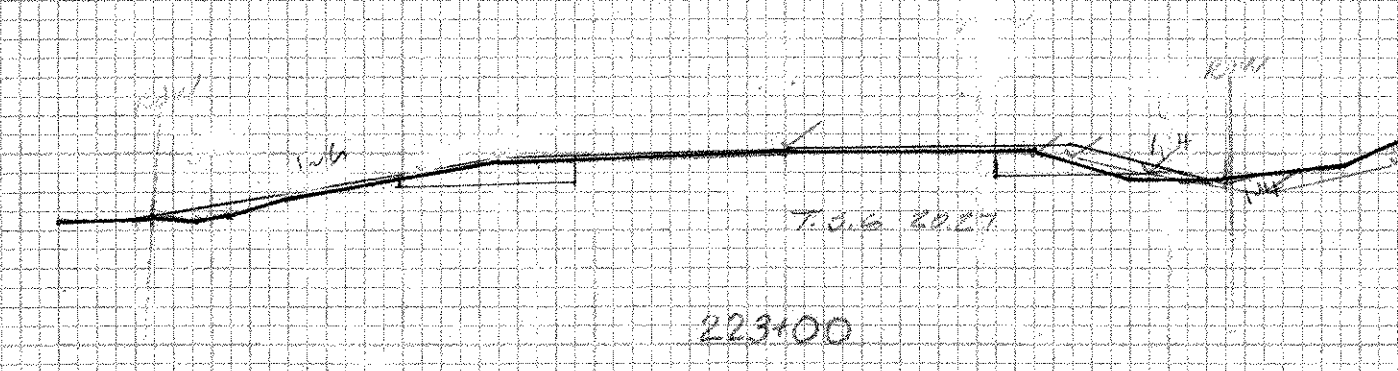
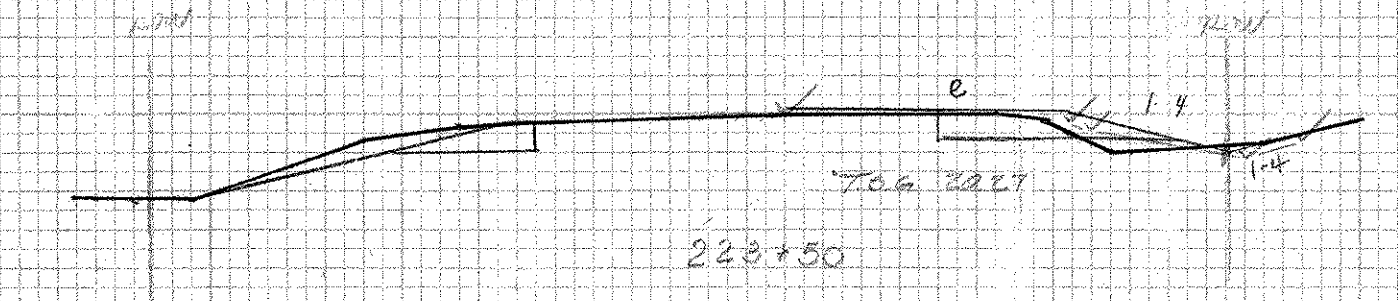
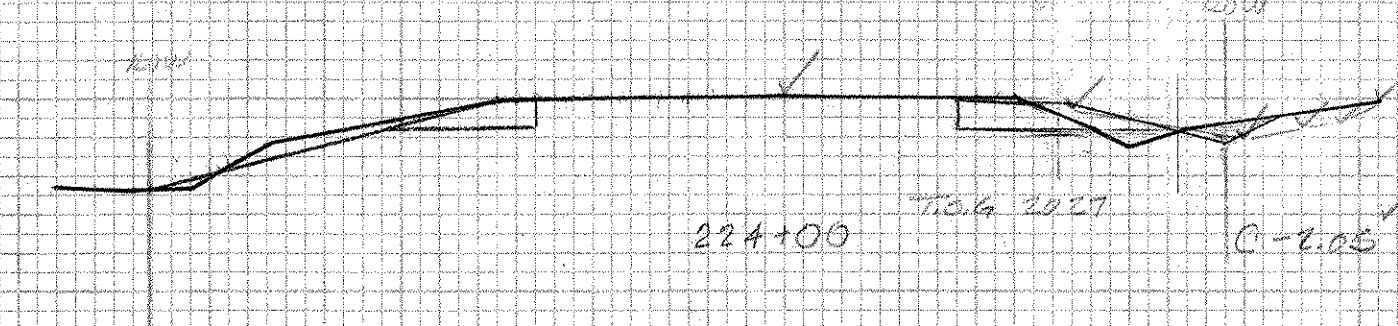
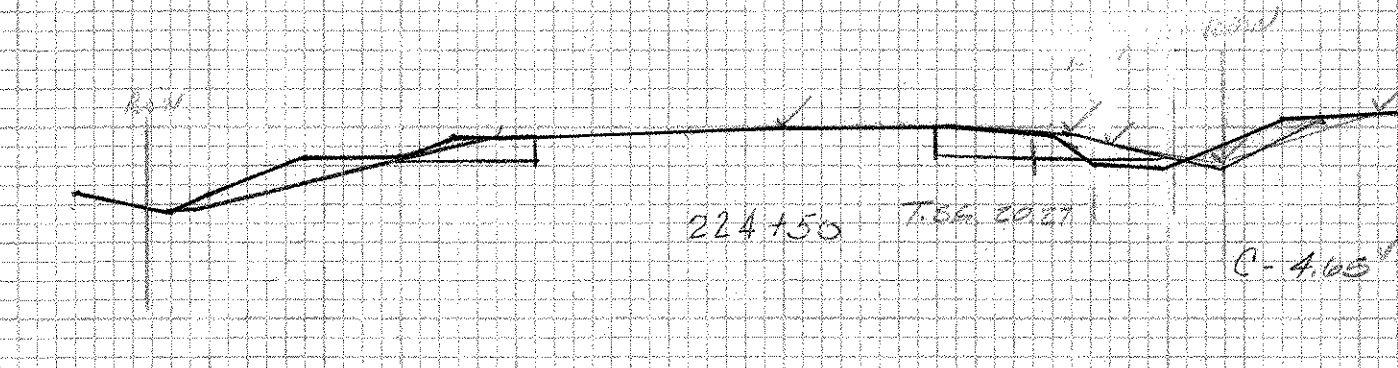
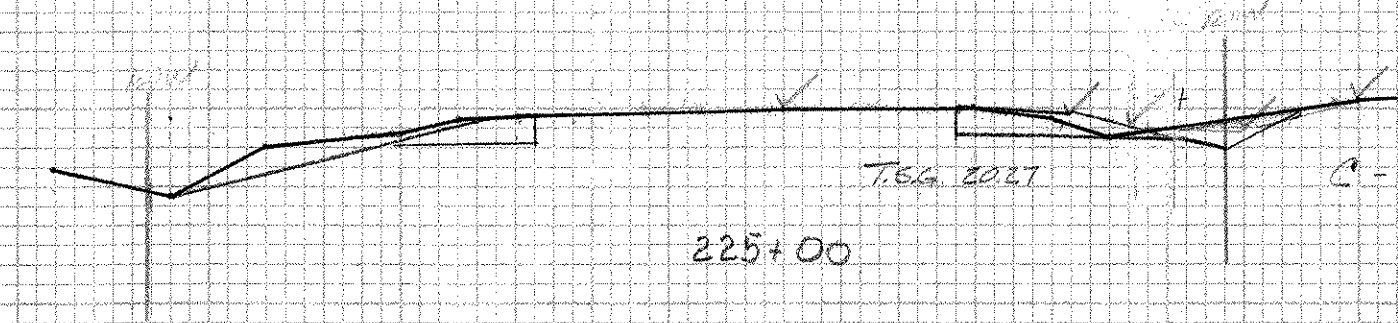
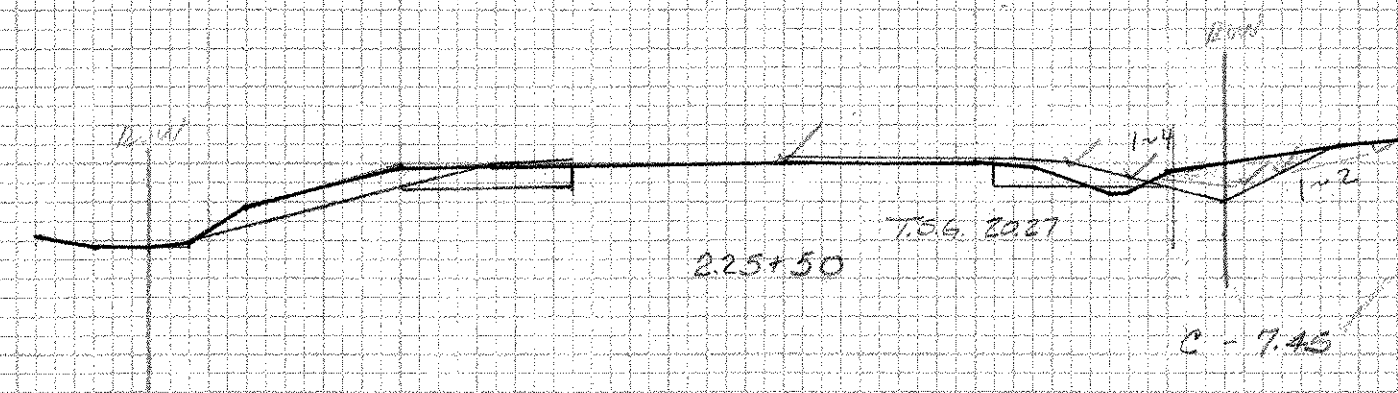
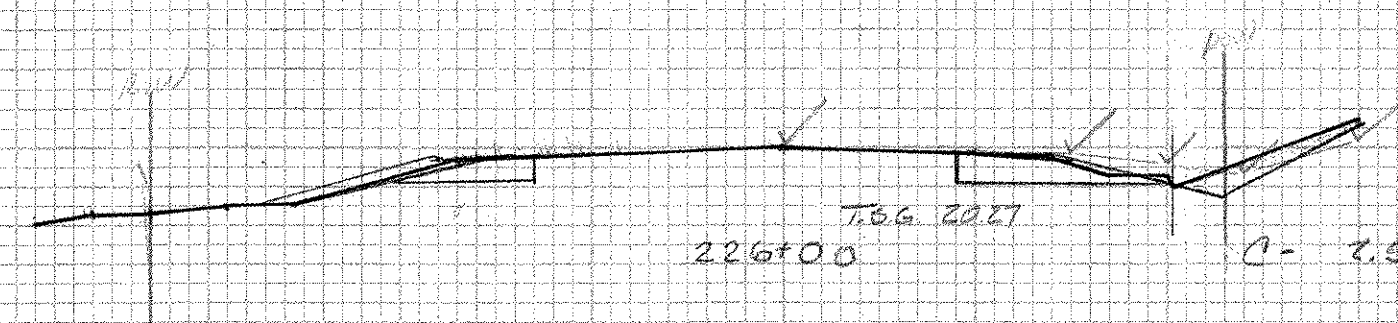
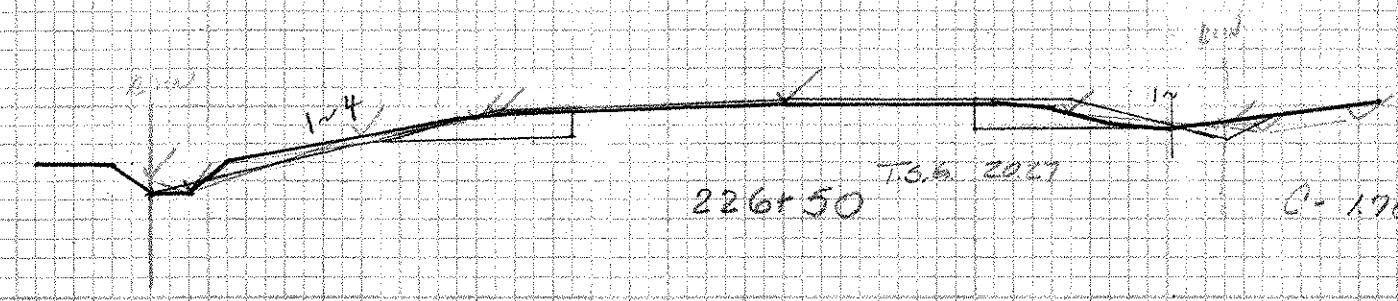


FINAL SURVEY NOTE BOOK NO.	DATE	BY
	SURVEYED	BY
	PLOTTED	BY
	AREA	CHECKED

ORIGINAL SURVEY NOTE BOOK NO.	DATE	BY
	SURVEYED	BY
	PLOTTED	BY
	AREA	CHECKED

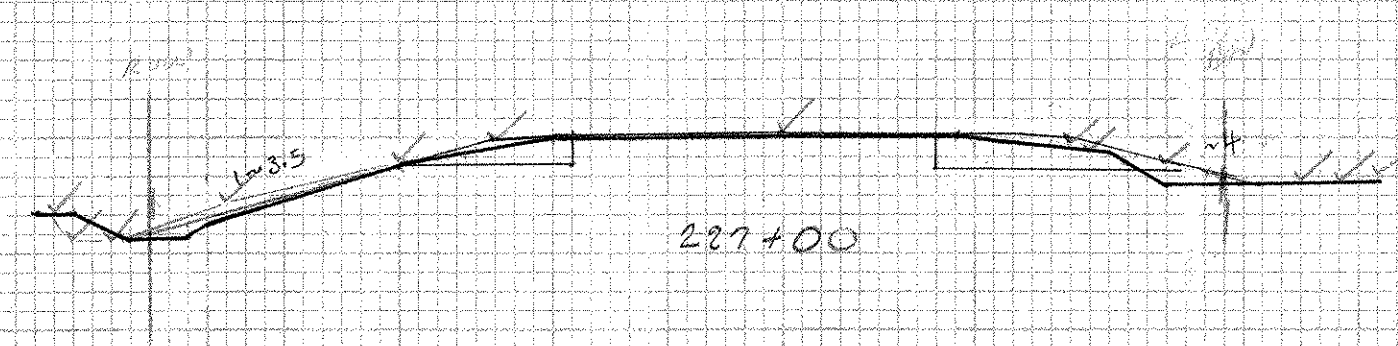

EARTH	
22.0	499.0
25.0	498.6
26.0	499.6
22.0	499.0




EARTH	
22.5	498.5
24.0	498.5
27.0	499.6
30.0	501.0
22.5	498.5

EARTH	
20.27	499.6
20.27	499.1
24.0	498.7
26.0	499.4
29.0	501.0
20.27	499.6

EARTH	
20.27	499.0
24.0	499.0
26.0	499.4
27.0	500.0
20.27	499.0

EARTH	
21.0	498.0
25.0	498.4
25.0	499.0
26.0	500.5
26.0	500.5
21.0	498.0





EARTH	
21.0	498.4
24.0	498.0
26.0	499.1
21.0	498.4

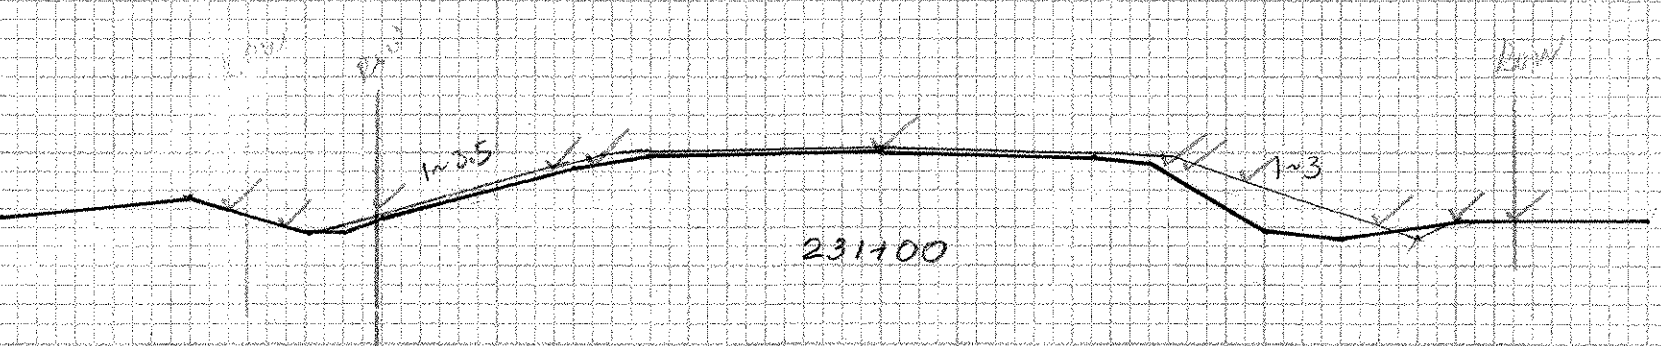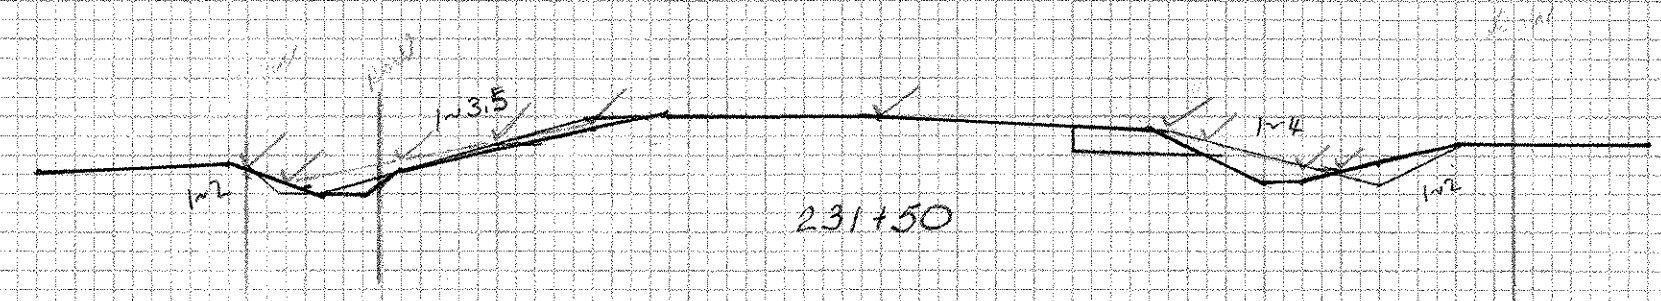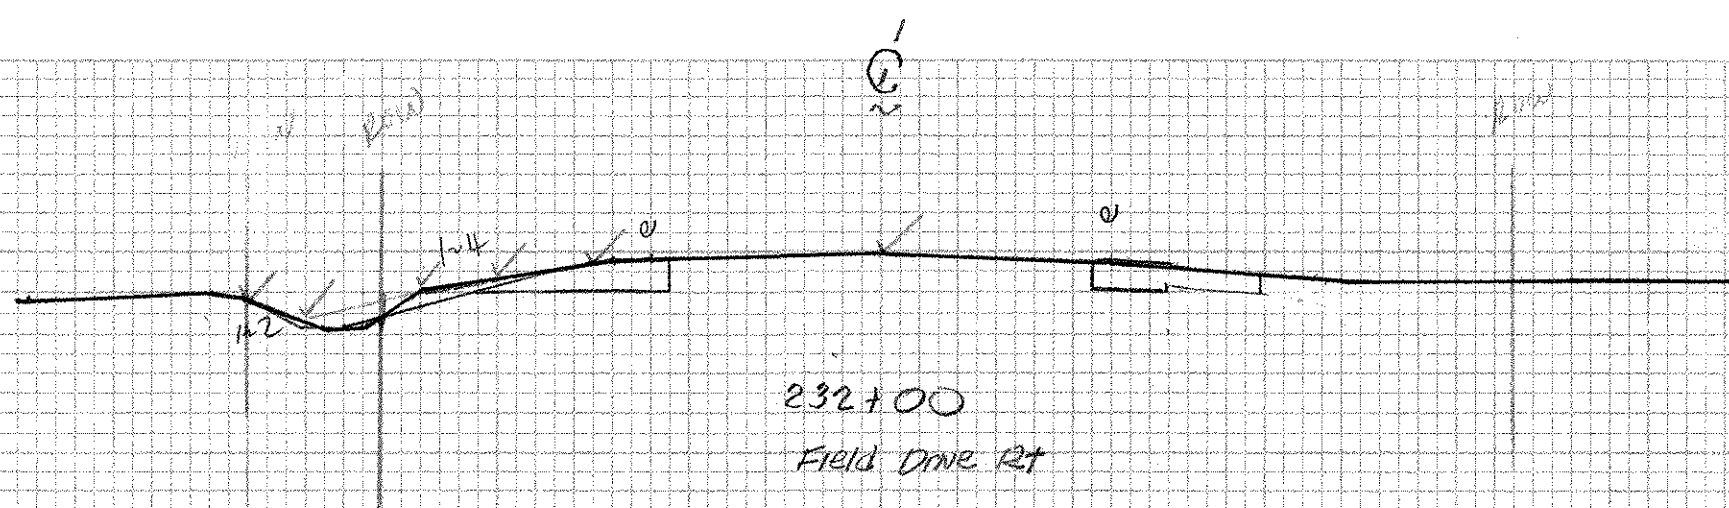

SEE SHEET 298
230+50

SEE SHEET 298
230+00

SEE SHEET 298
229+50

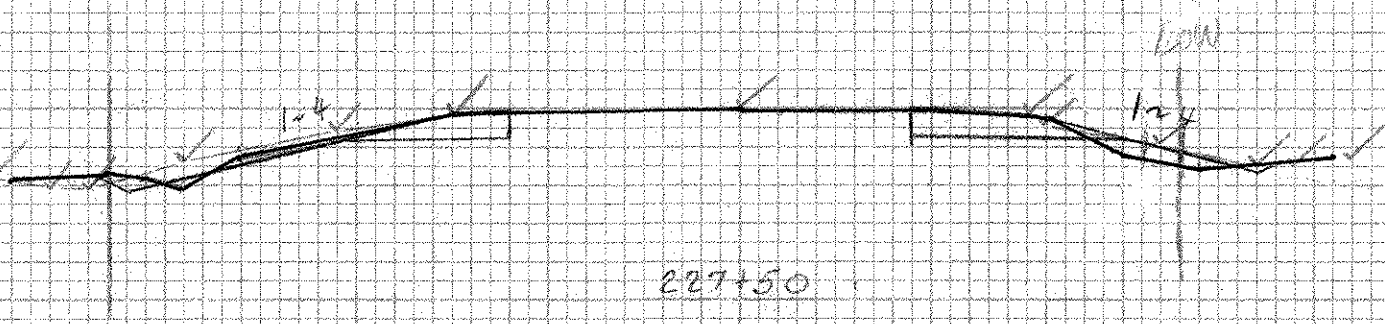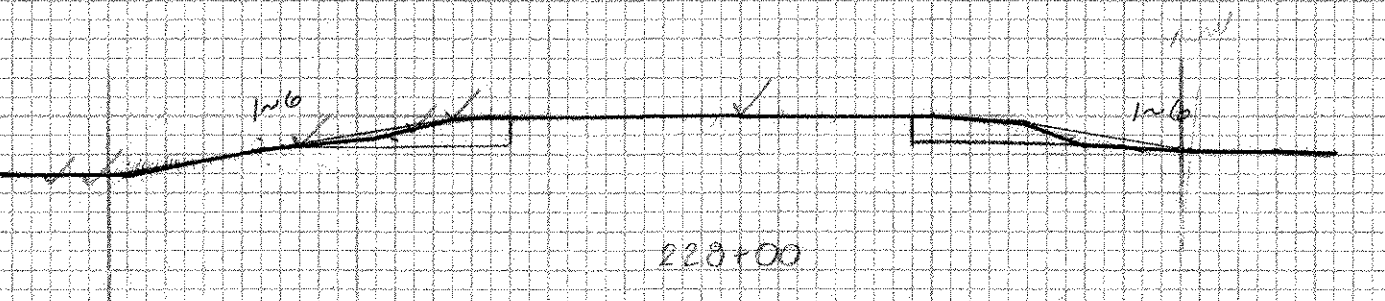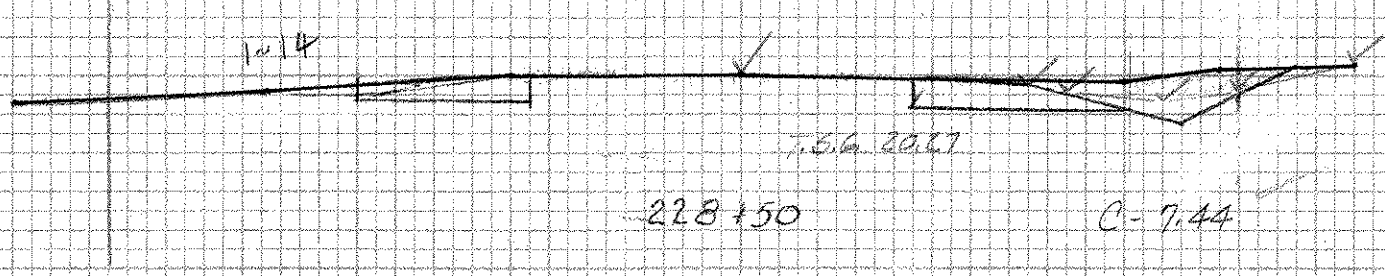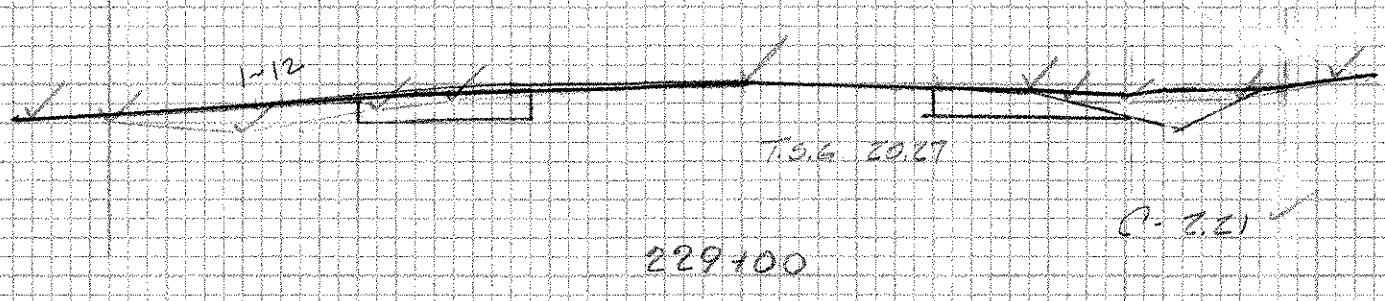

EARTH	
20.27	498.6
24.0	499.4
27.0	499.6
22.0	499.7
20.27	498.6

EARTH	
20.27	498.5
20.27	498.5
22.0	498.5
24.0	498.5
24.0	500.4
25.0	500.5
20.27	498.5

SHUREHAM BRIDPORT-ADDISON
FOIT-1(2)

223+00 - 232+00

Original Sections 24 297-C OF 411
Plotted E. Board