
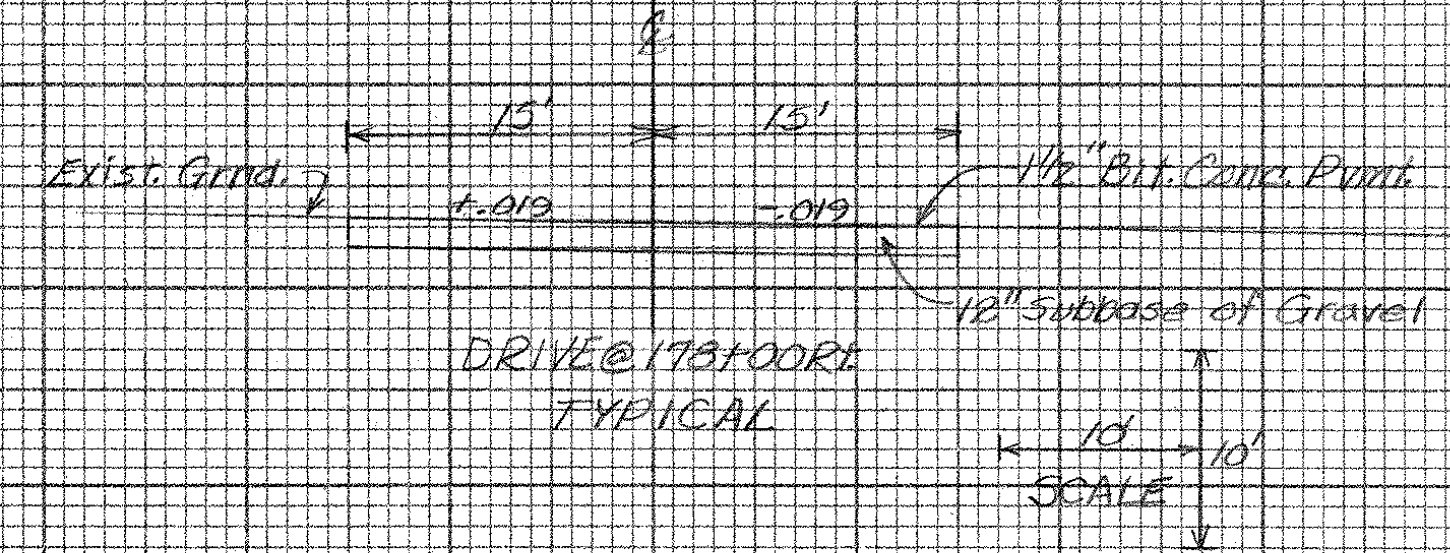
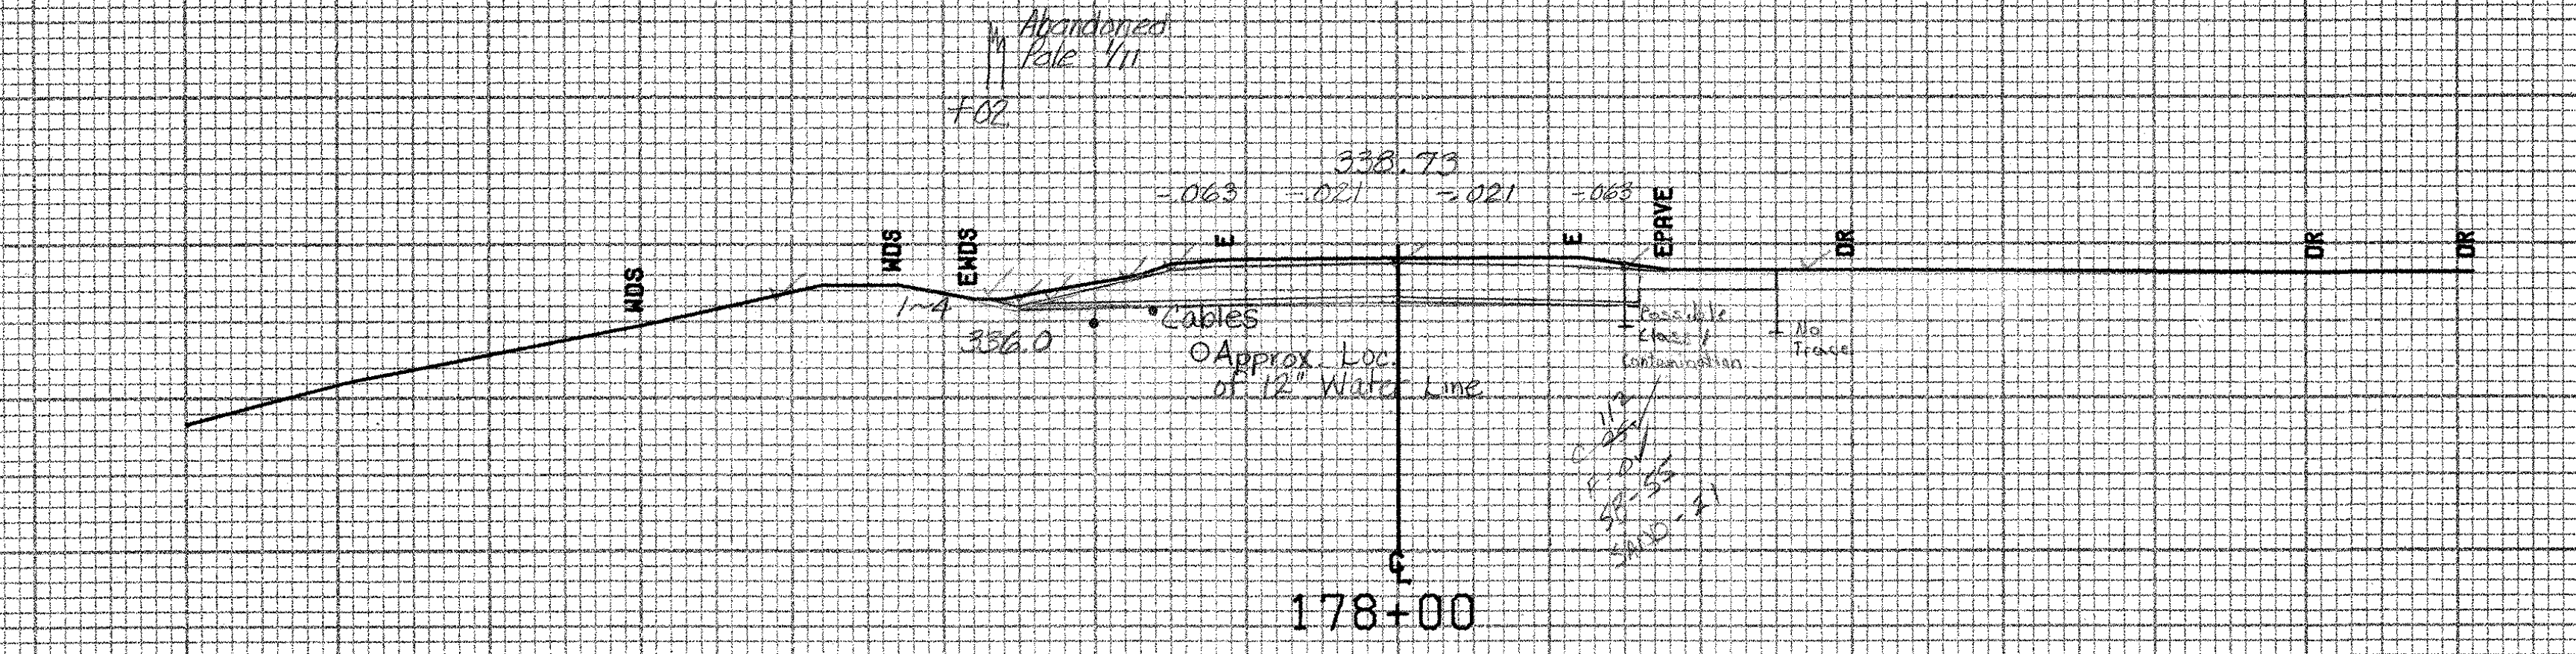
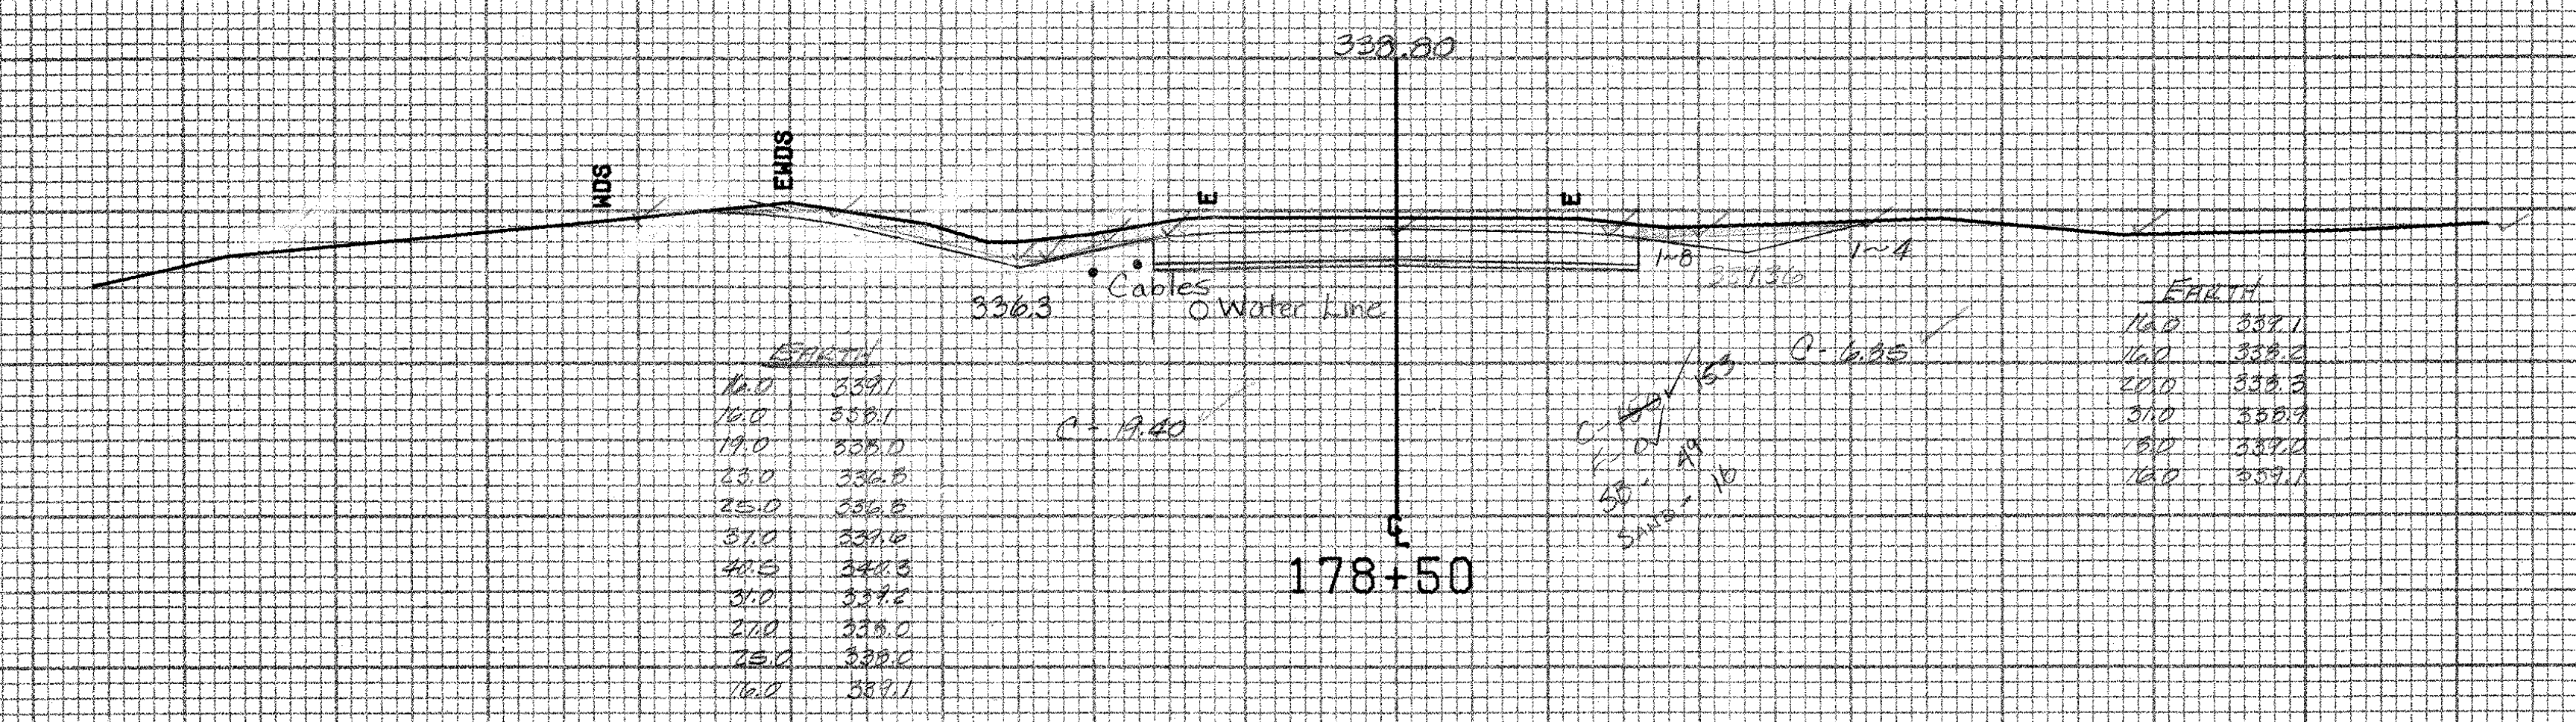


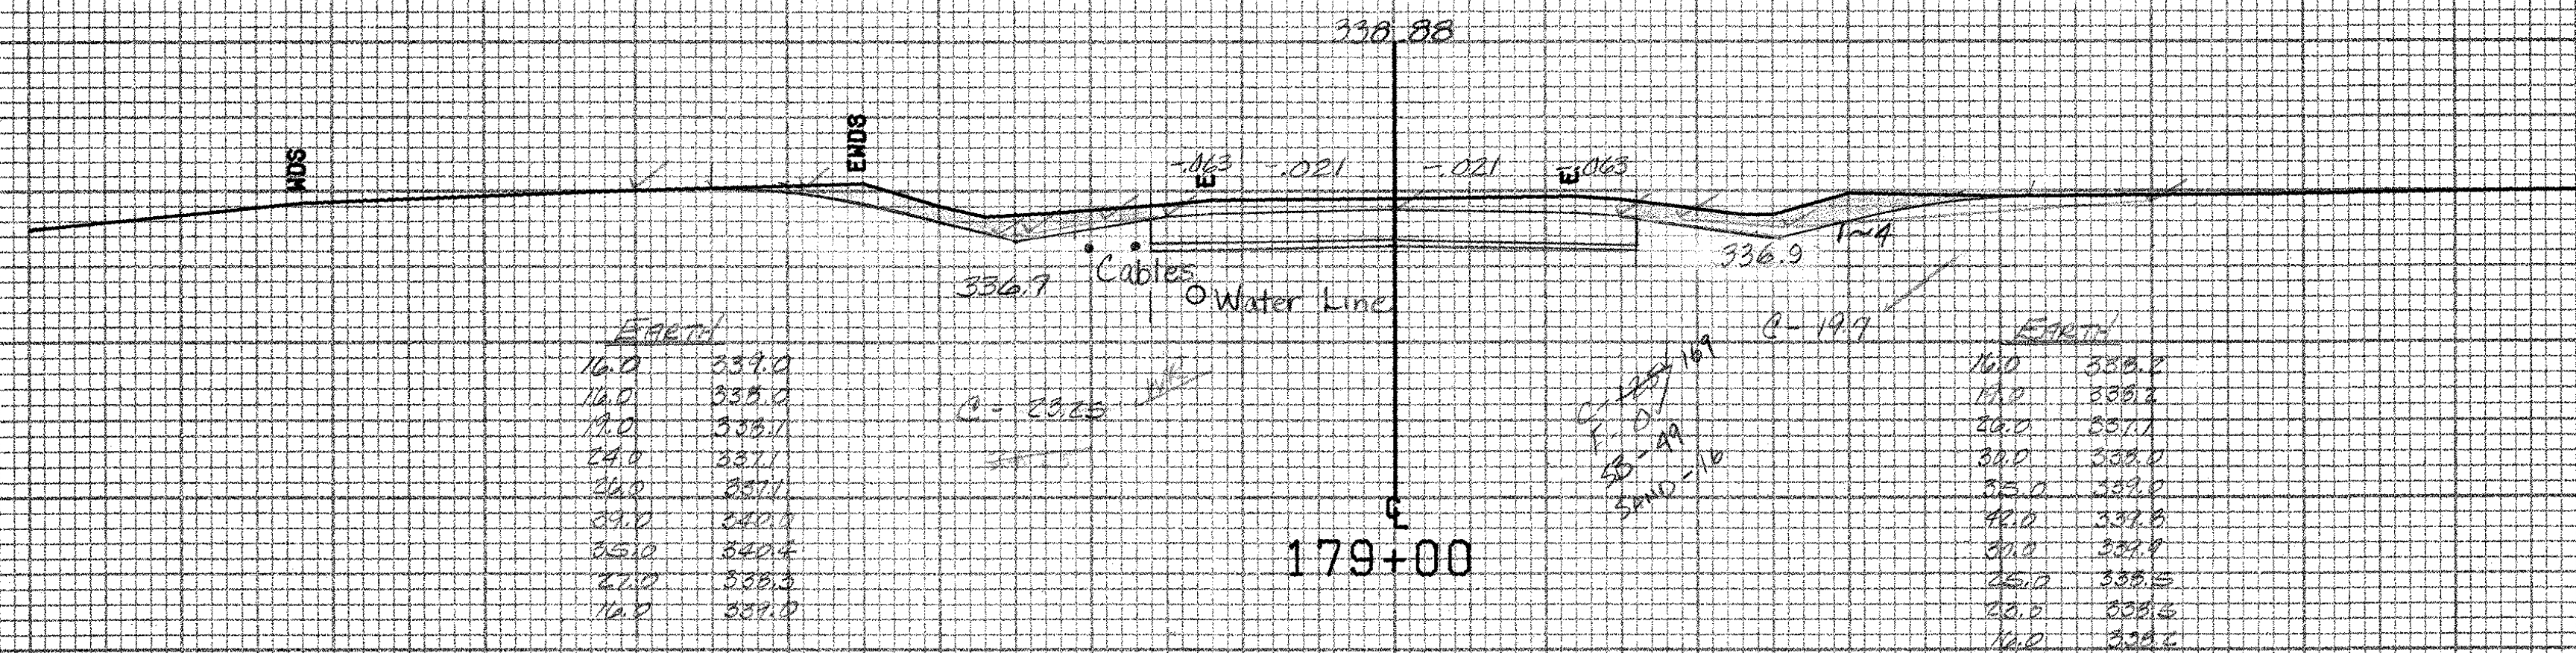

FROM STA.	178+00	TO STA.	179+00
PROJECT NAME	SHOREHAM-BRIDPORT-ADDISON MAIN		
NO.	F017-1(2)	PLOTTED	04/11/85
SURVEYED BY	BUSHEY	FEB	1985
SHEET	325 OF 420 SHEETS	SHEET	325 OF 477

SCALE 1" = 10 FEET