



200+10 Lt.
Construct Drive (78' Paved)



200+00 ~ 201+50 Rt.
Construct Special Ditch w/ Erosion Matting

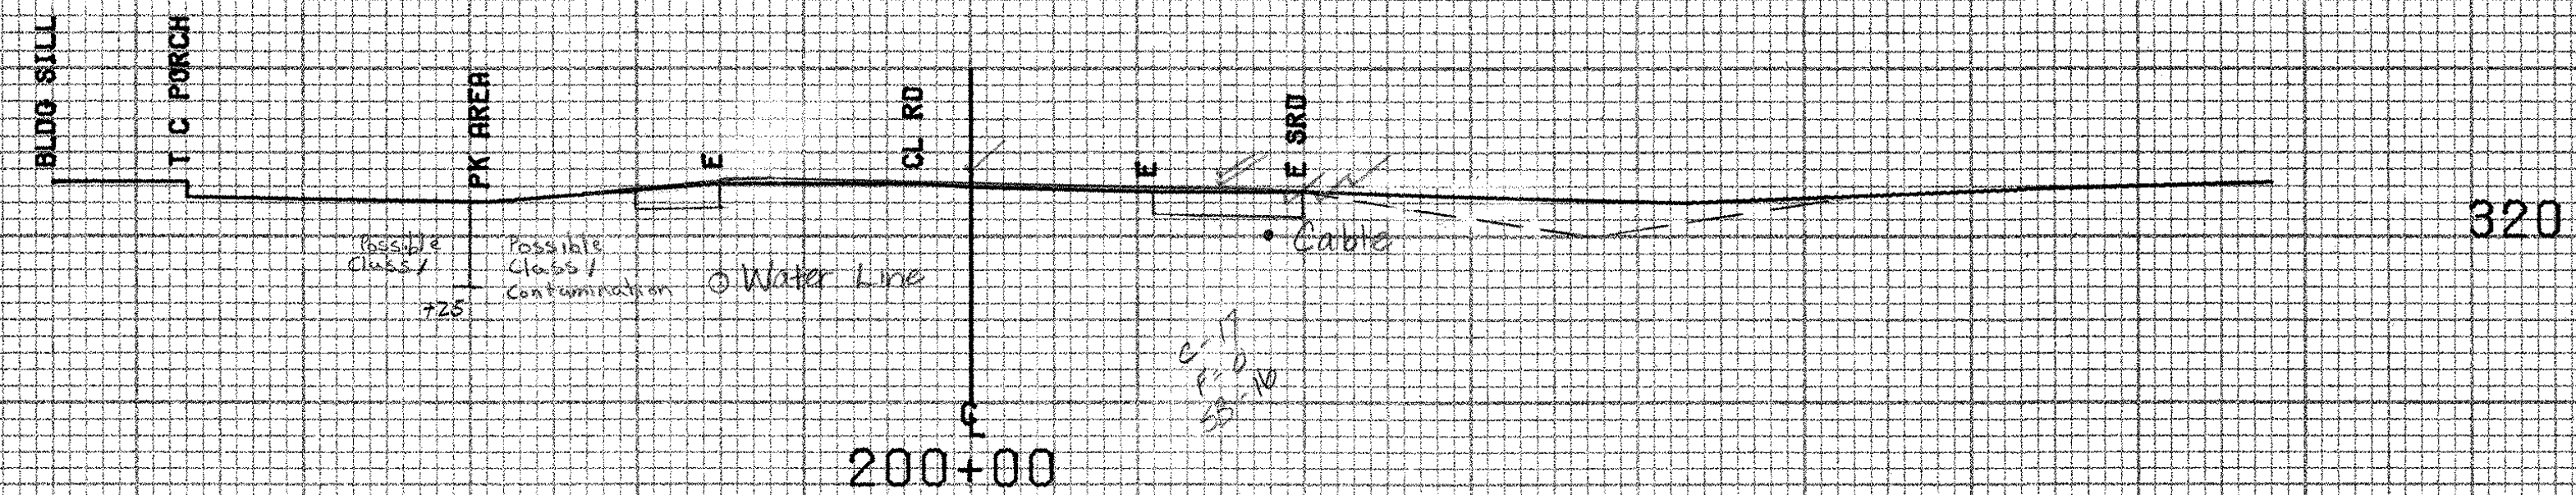

199+80± Rt TH#21

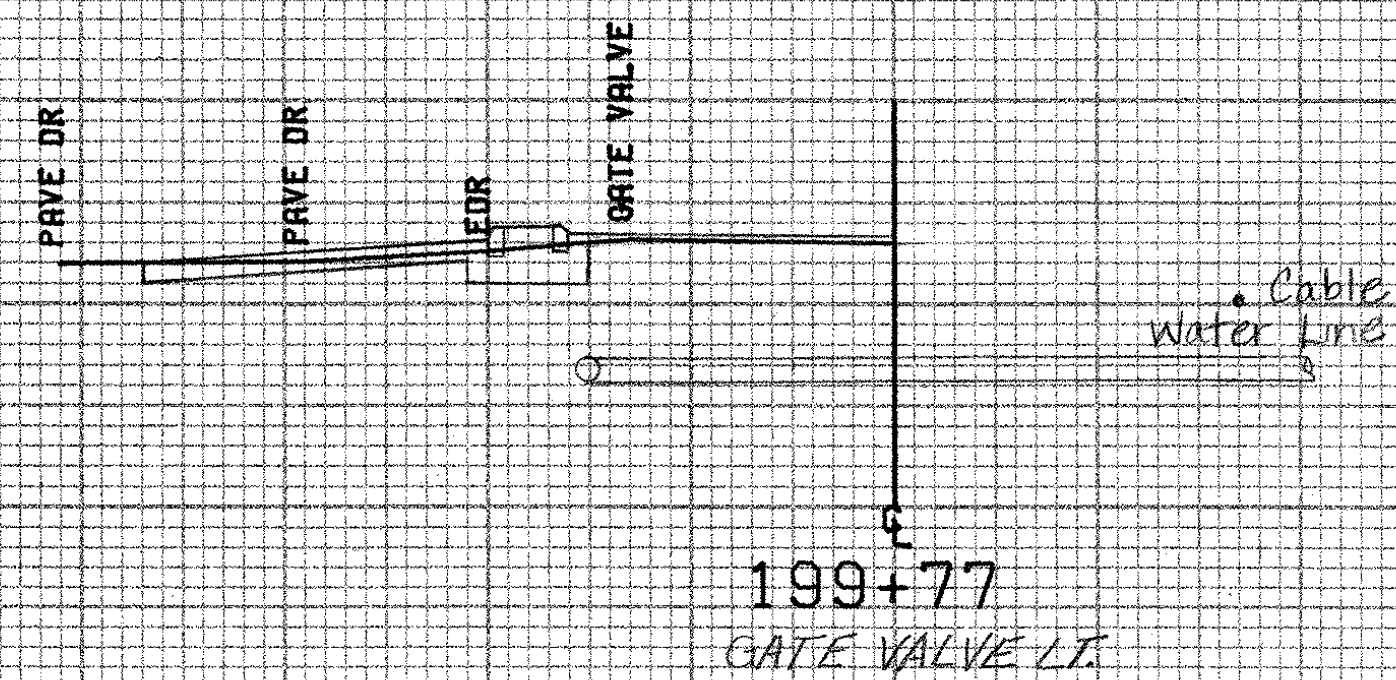

199+72 Lt.
End Cast In Place Cement
Concrete Curb, Type A
(Begins Vt 125, 276+95 Lt.)
See Sheet 320 of 420 for Detail

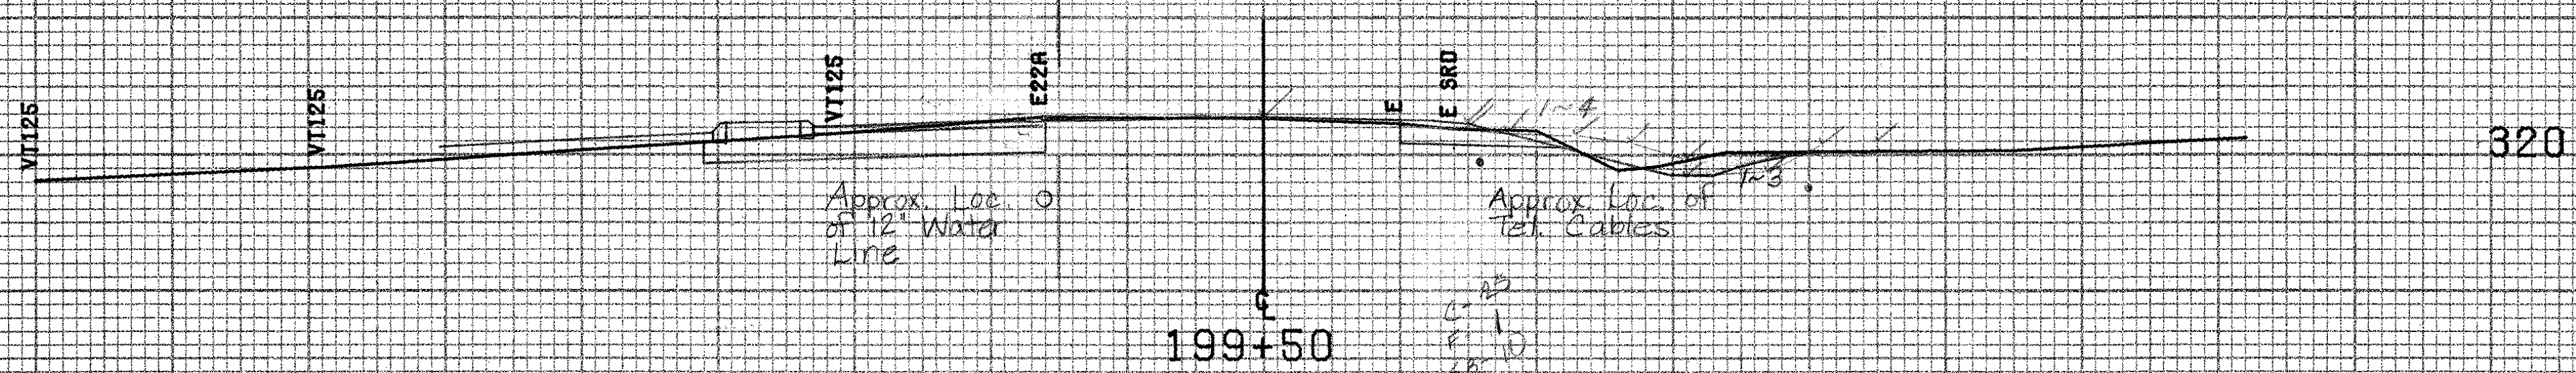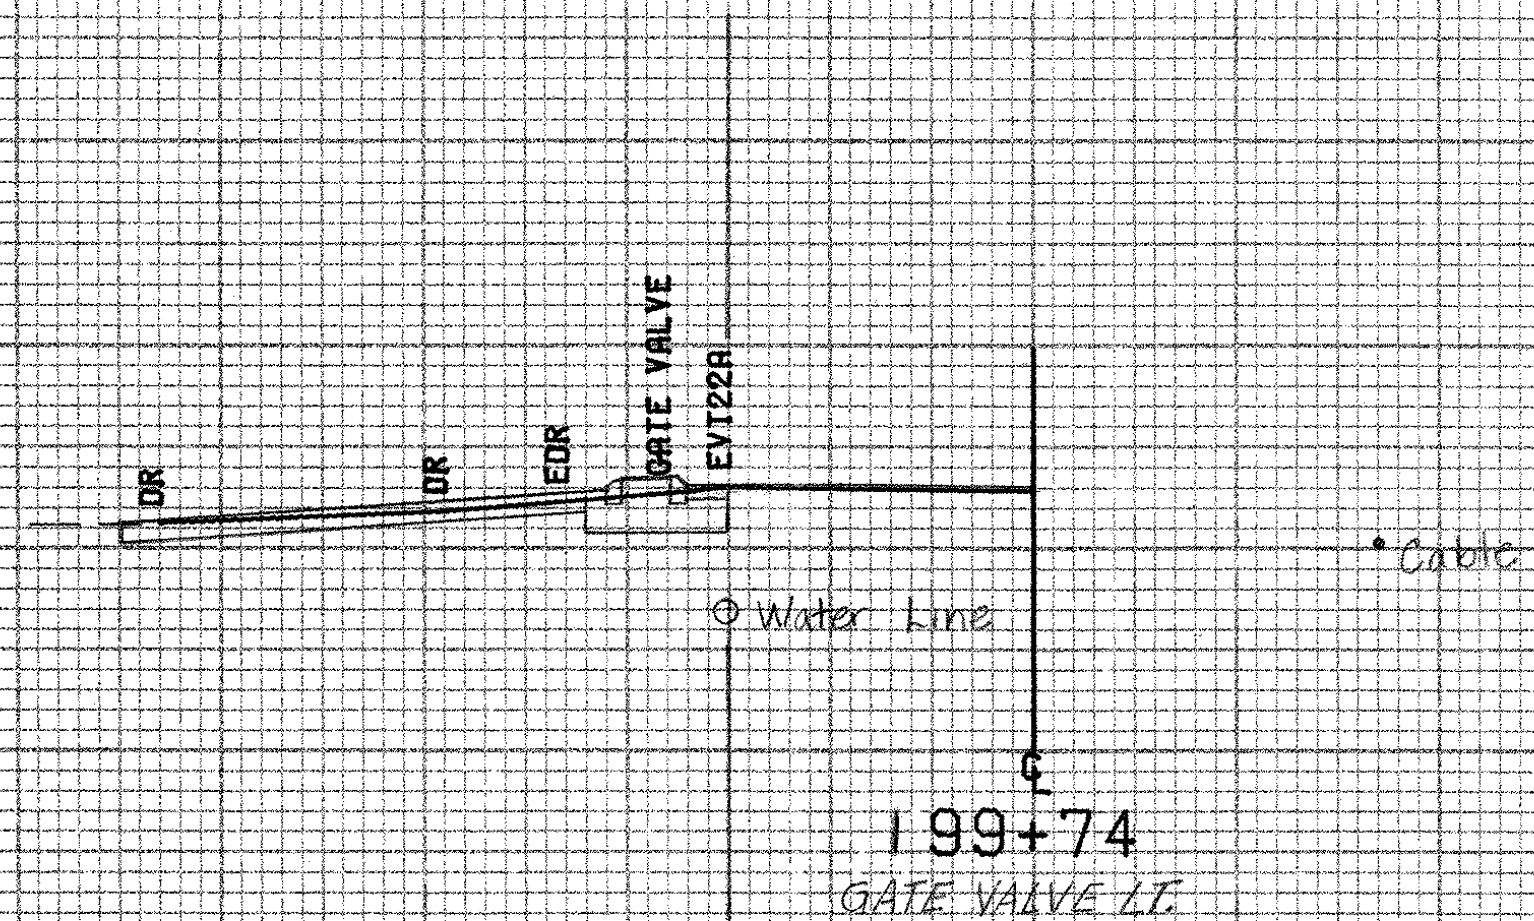

BRIDPORT MM 3.75 ~ MM 3.81

FROM STA.	199+50	TO STA.	200+00
PROJECT NAME	SHOREHAM-BRIDPORT-ADDISON MAIN		
NO.	F017-1(2)	PLOTTED	04/11/85
SURVEYED BY	BUSHEY	FEB	1985
SHEET	333 OF 420 SHEETS	SHEET	333 OF 477

SCALE 1" = 10 FEET