

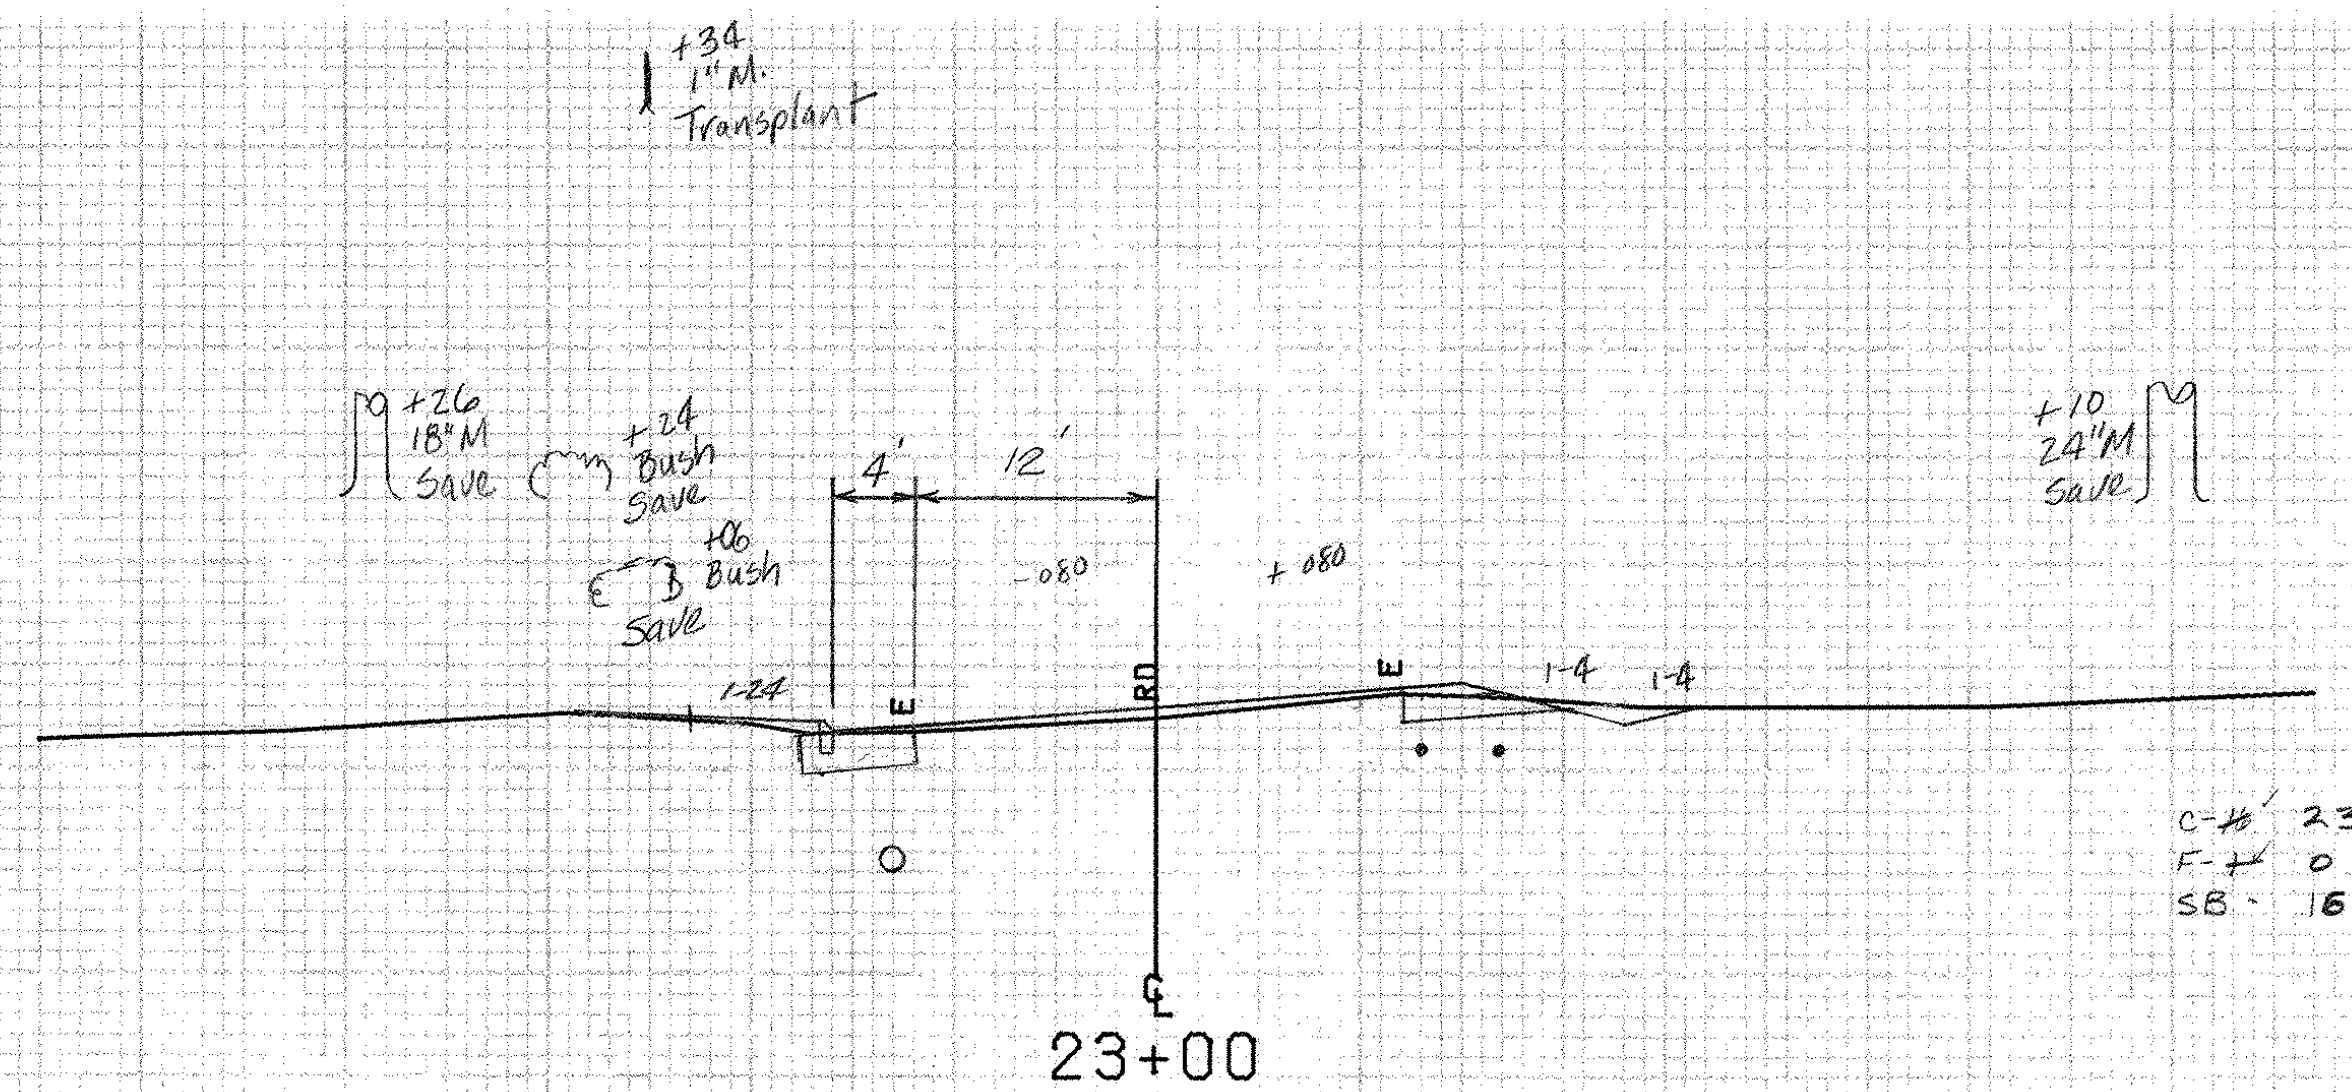


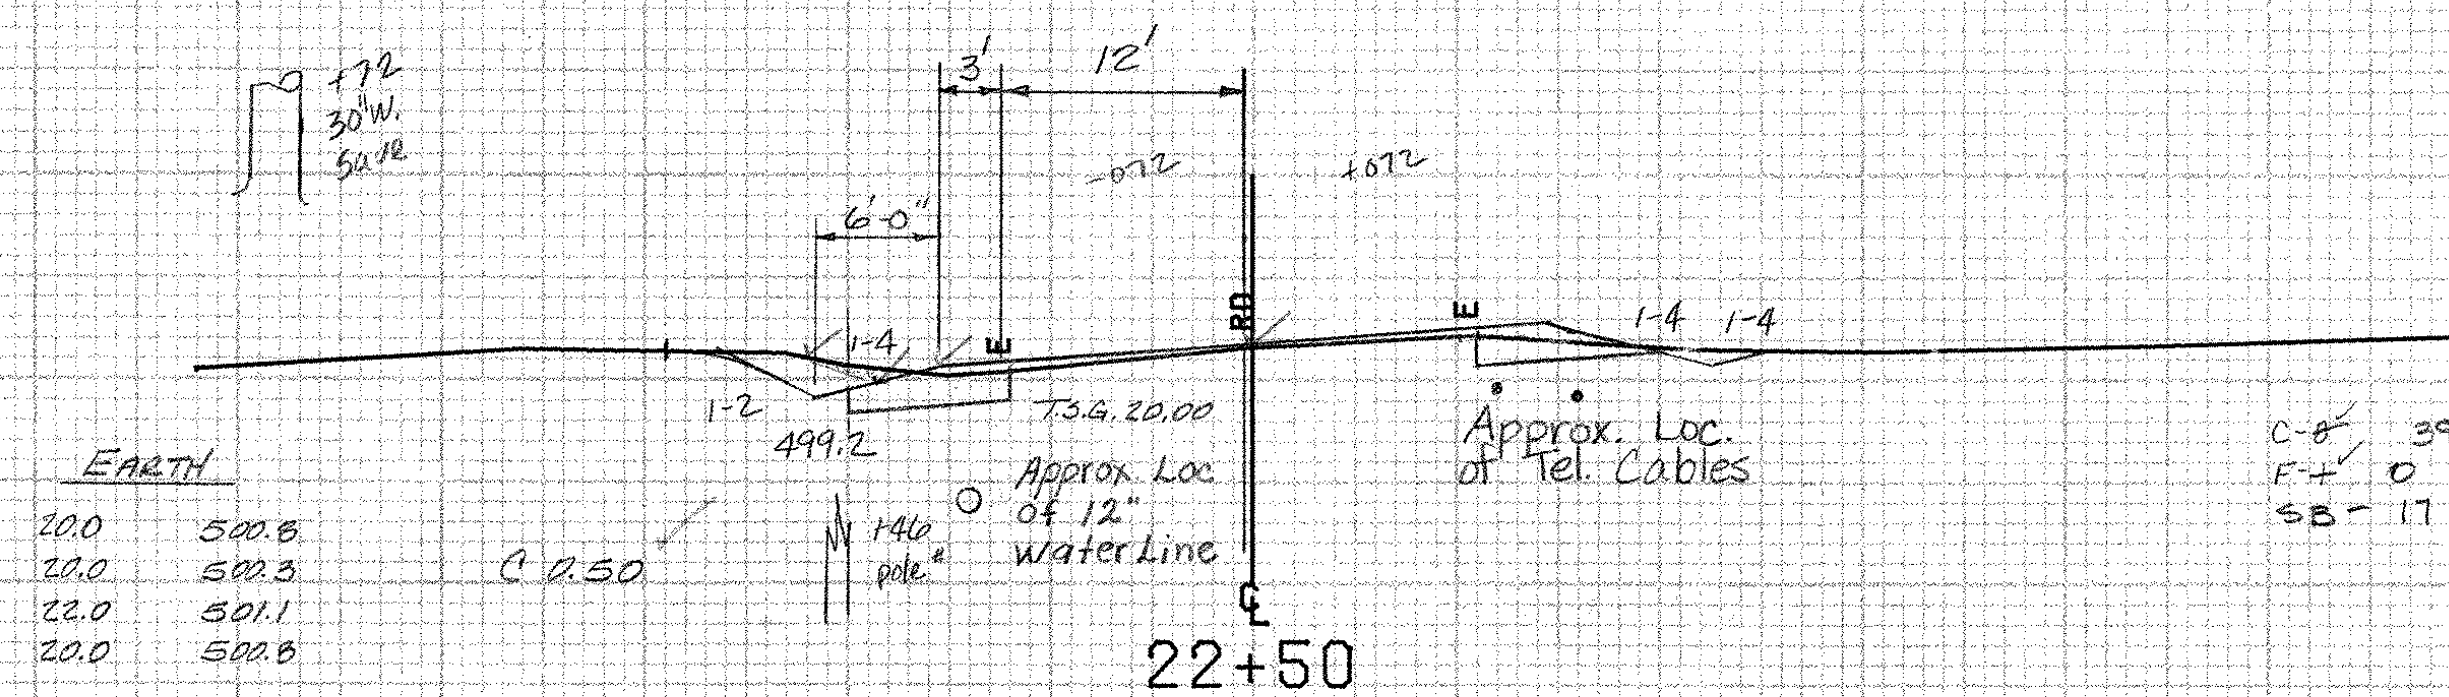


22+75 LT
Begin Cast In Place Concrete
Curb, Type A
End Special Ditch w/ Erosion Matting

22+89 RT
5' Concrete Sidewalk, Remove 6 feet (Common Excav.)
Replace w/ 6' of Portland Cement Concrete Sidewalk, 5 inch

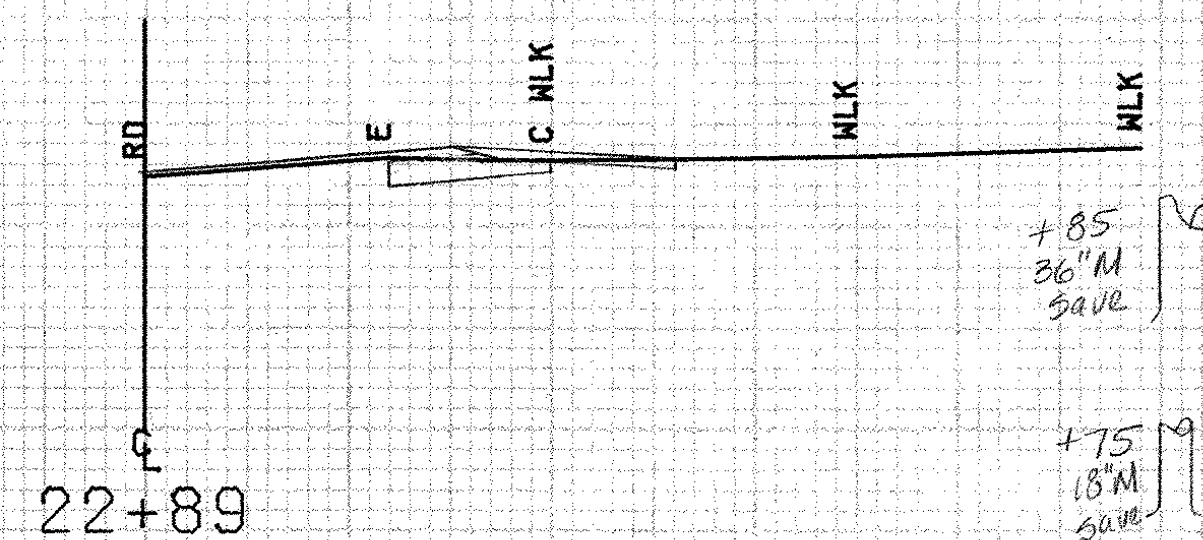

EARTH	
20.0	500.5
20.0	500.3
22.0	501.1
20.0	500.5

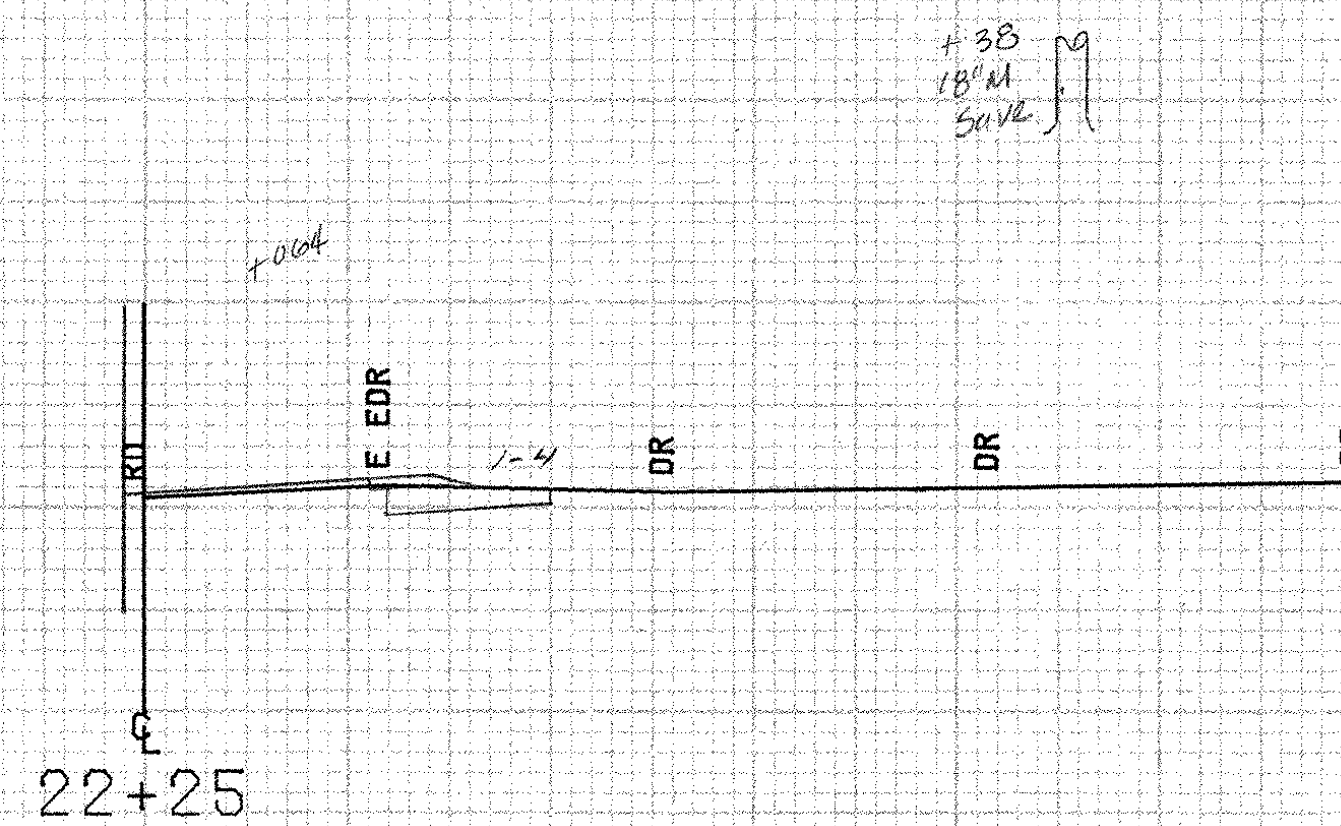

BRIDPORT MM 4.24 ~ MM 4.34

FROM STA.	22+25	TO STA.	23+00
PROJECT NAME	SHOREHAM-BRIDPORT-ADDISON		
NO.	F017-1(2)	PLOTTED	02/14/84
SURVEYED BY	FANTONI	JAN	1984
SHEET	349 OF 420 SHEETS	SHEET	349 OF 477

SCALE 1" = 10 FEET