

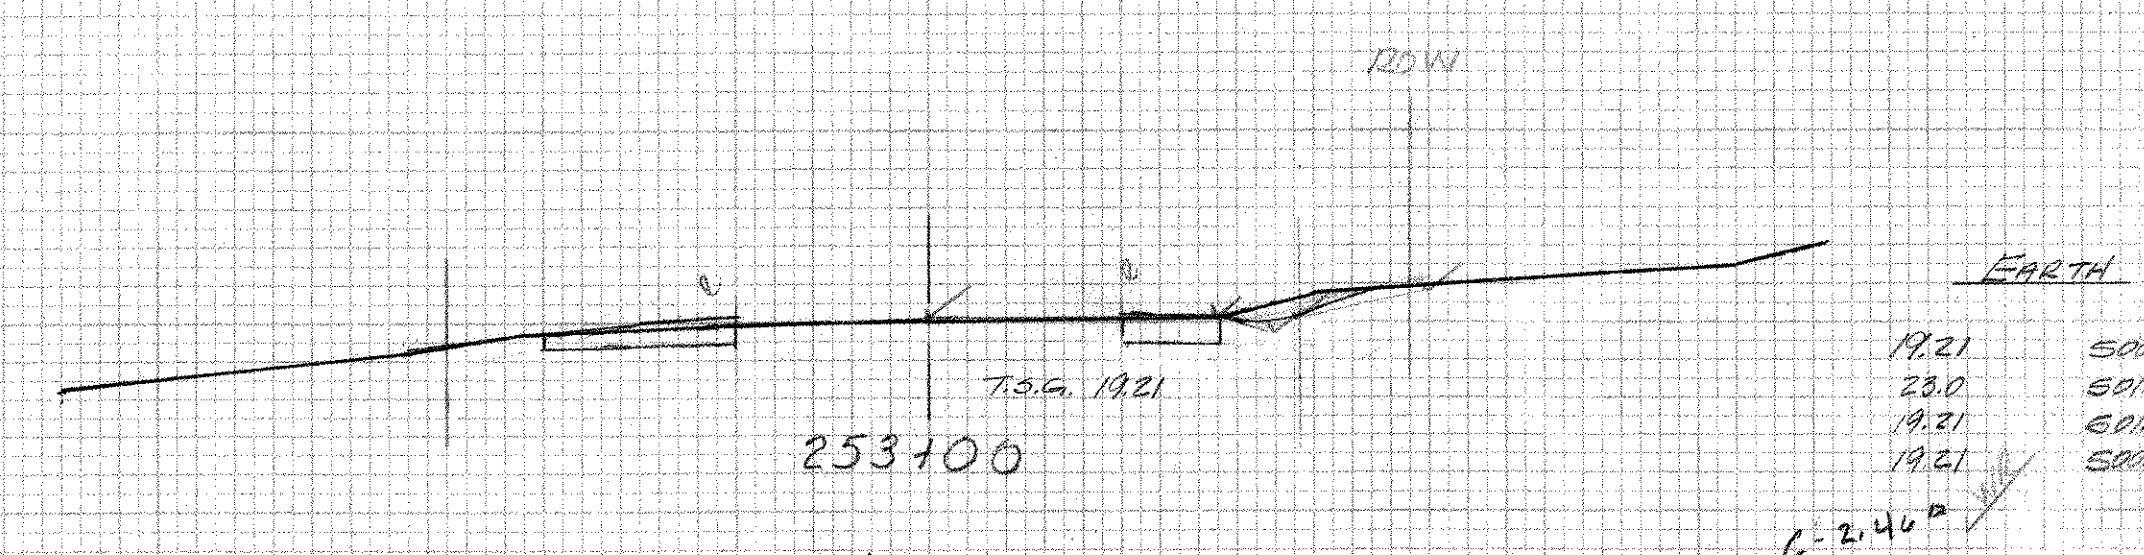
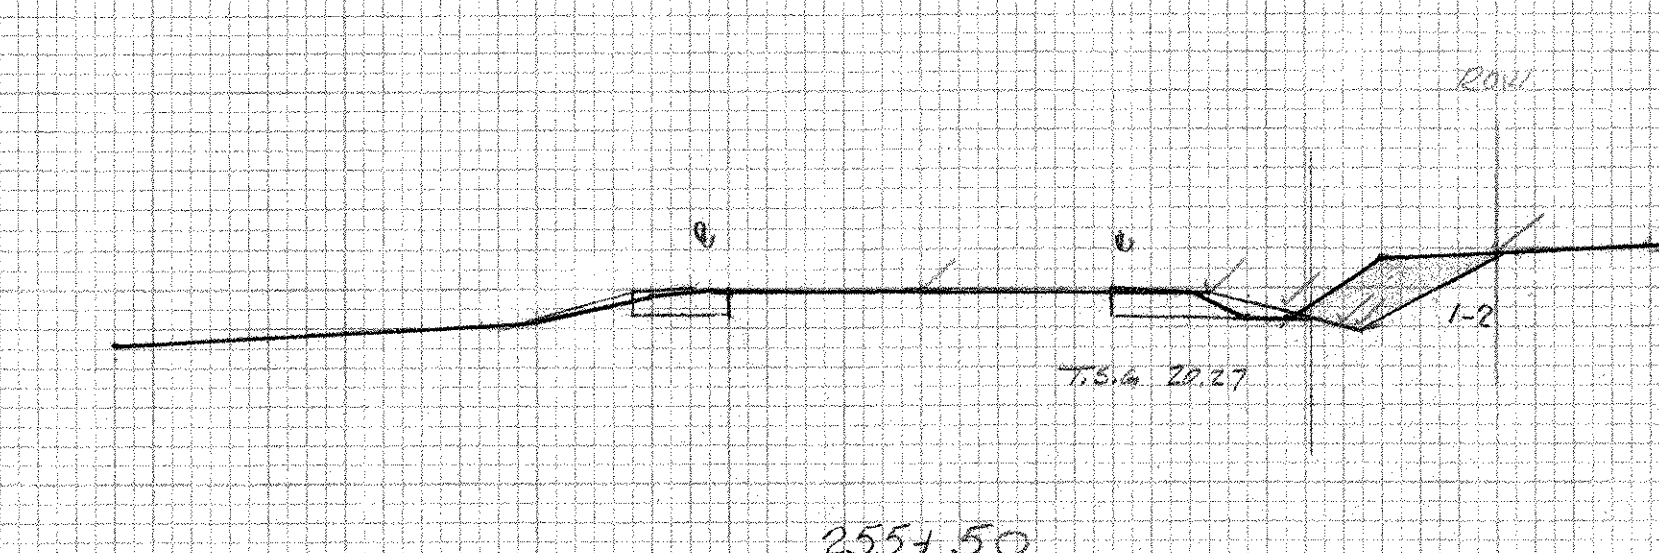
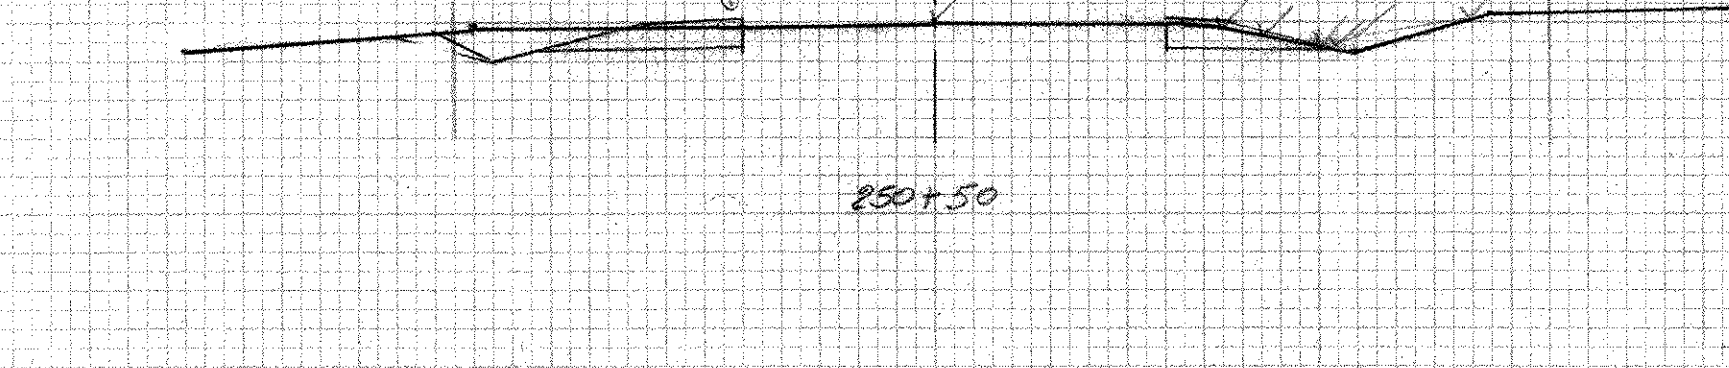
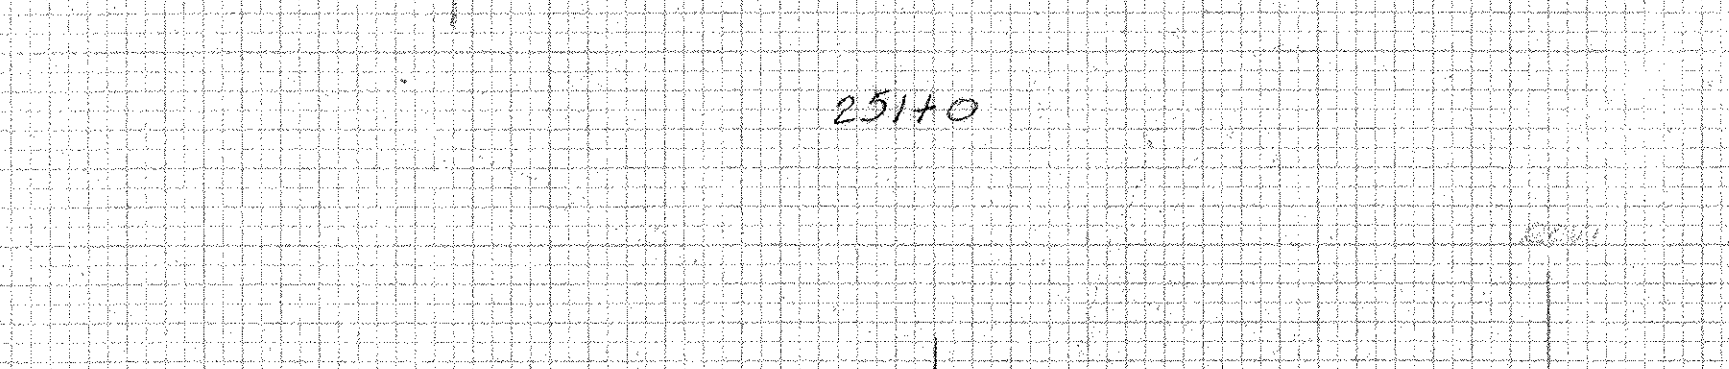
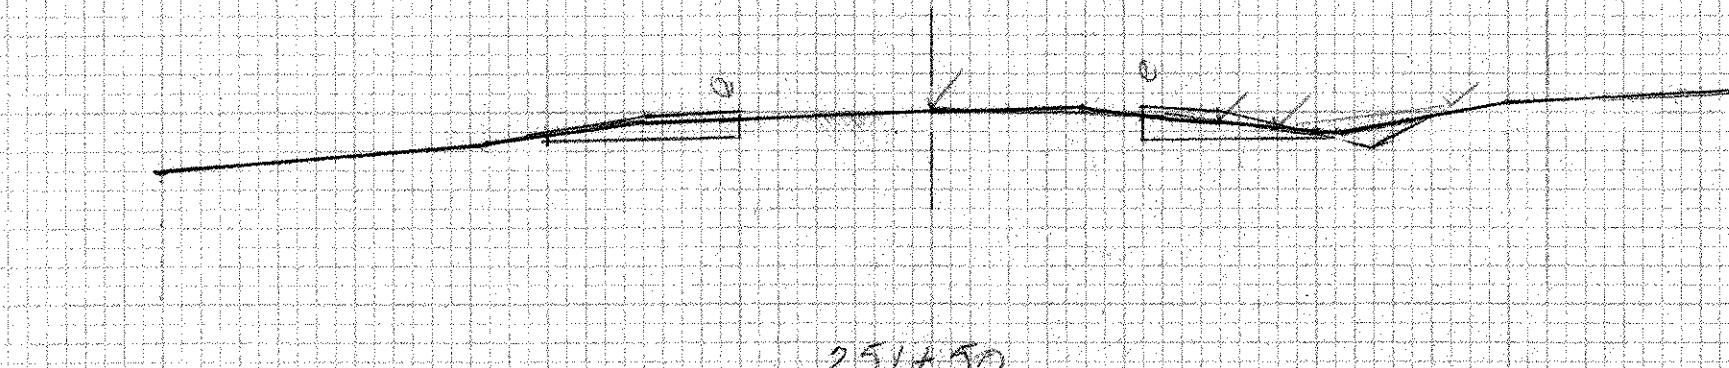


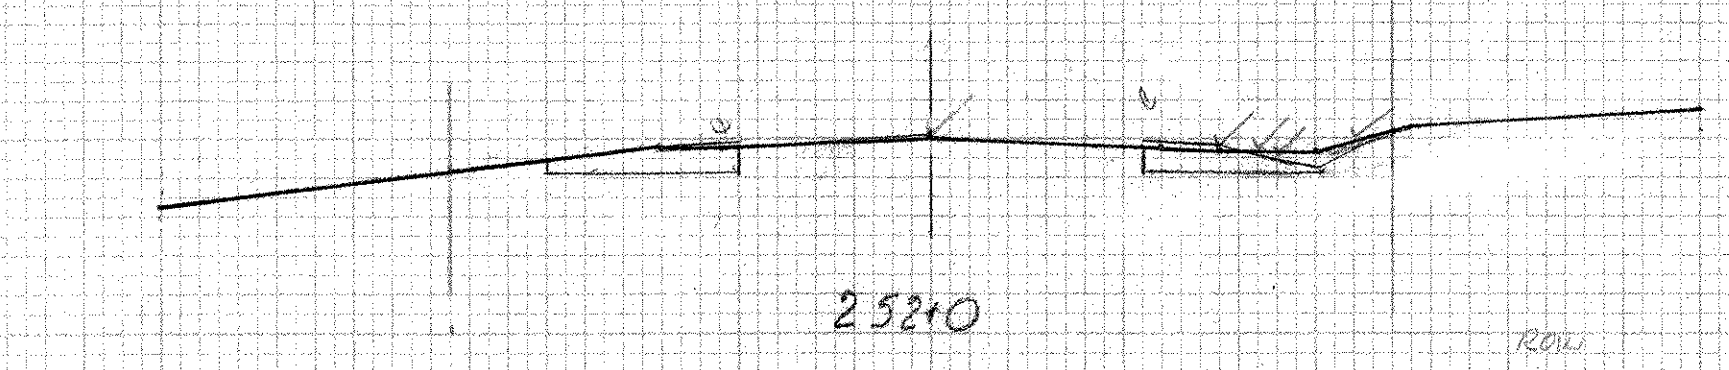


EARTH

19.21	500.0
23.0	501.7
19.21	501.3
19.21	500.0

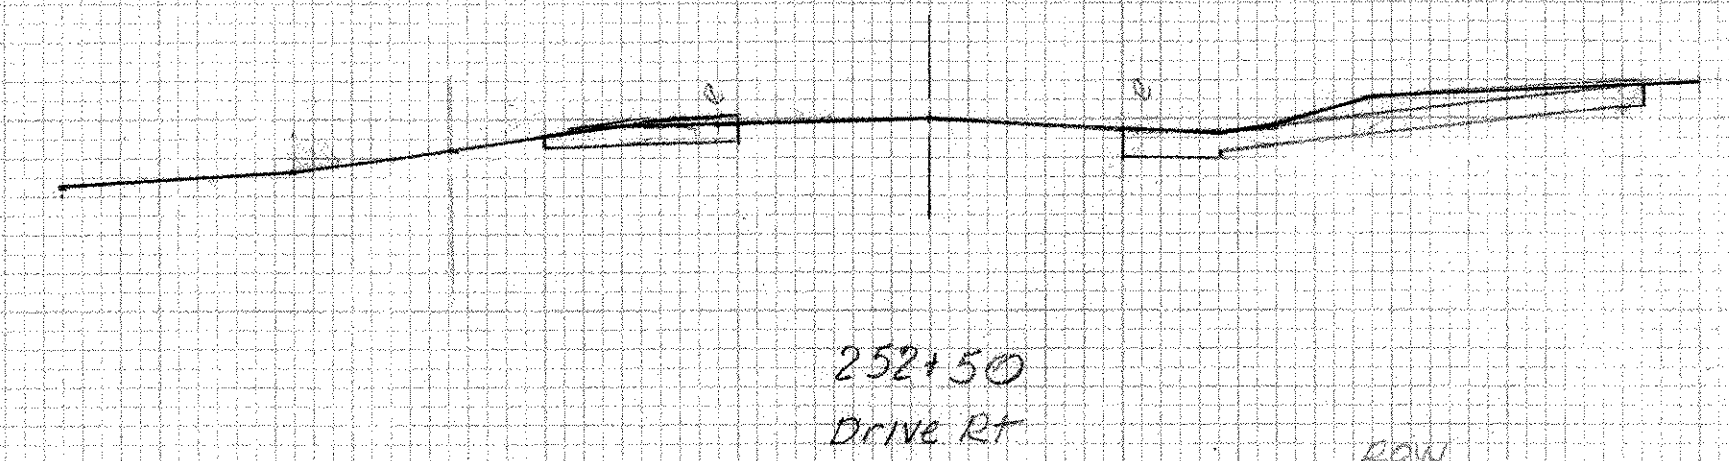



EARTH

20.27	498.4
22.0	498.4
23.0	498.4
30.0	502.0
24.0	501.6
20.27	499.0
20.27	498.4

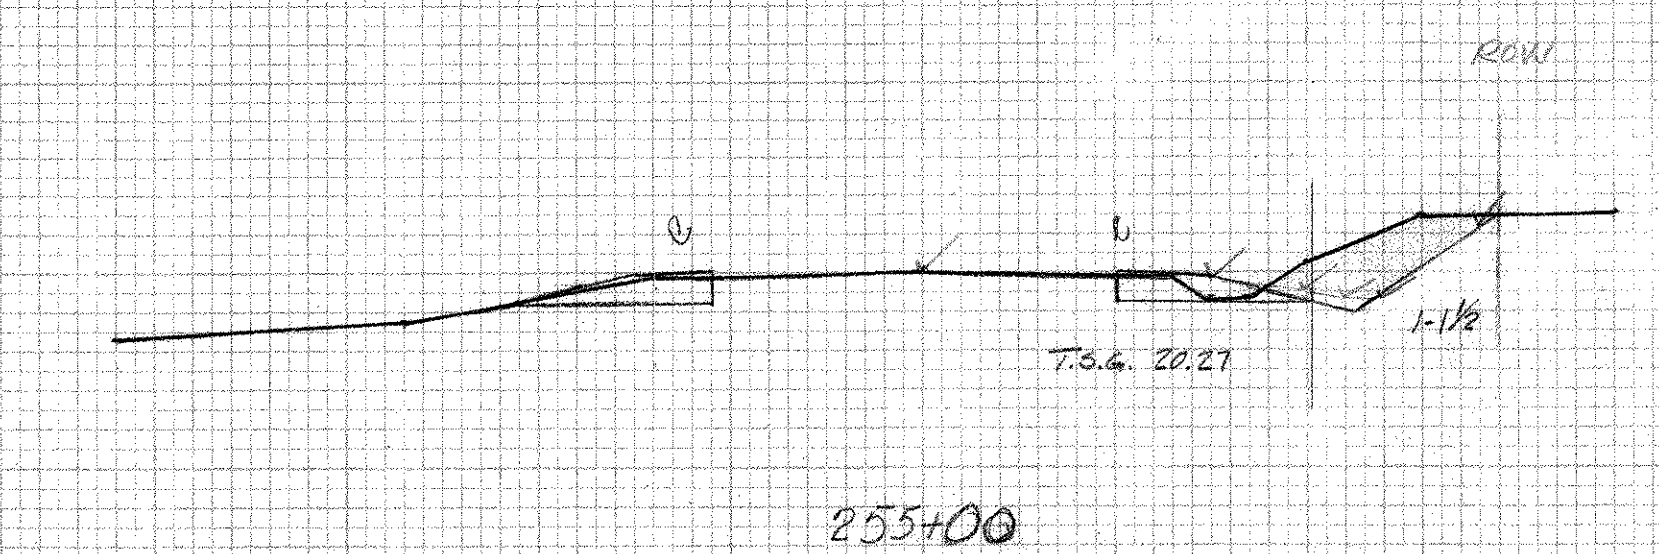


EARTH

20.27	499.0
22.0	498.7
24.0	498.7
30.0	503.0
24.0	502.0
20.27	501.6
20.27	499.0

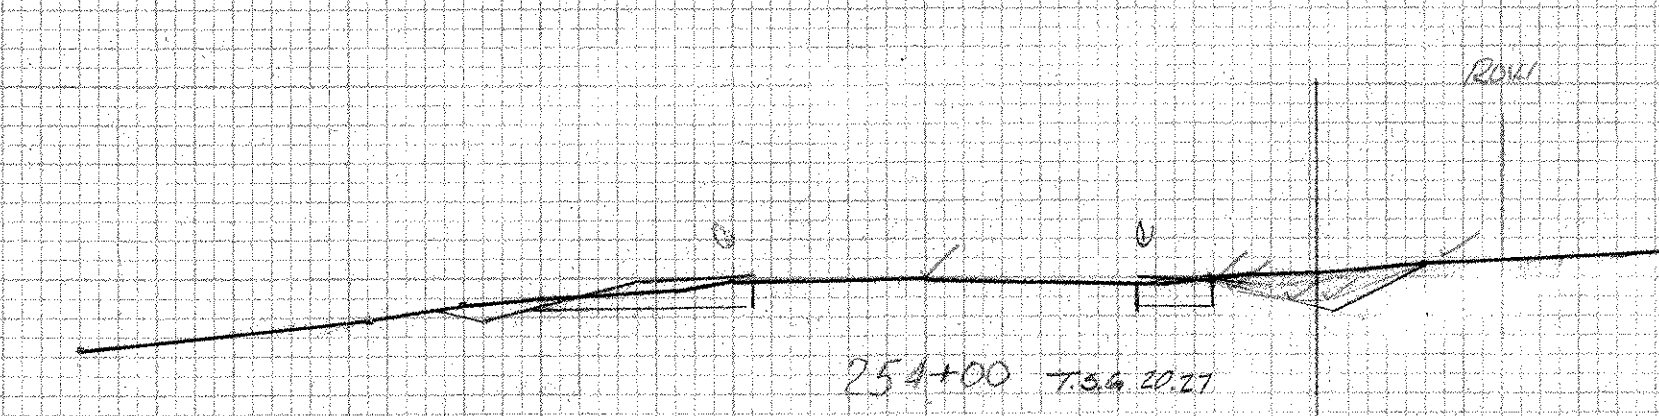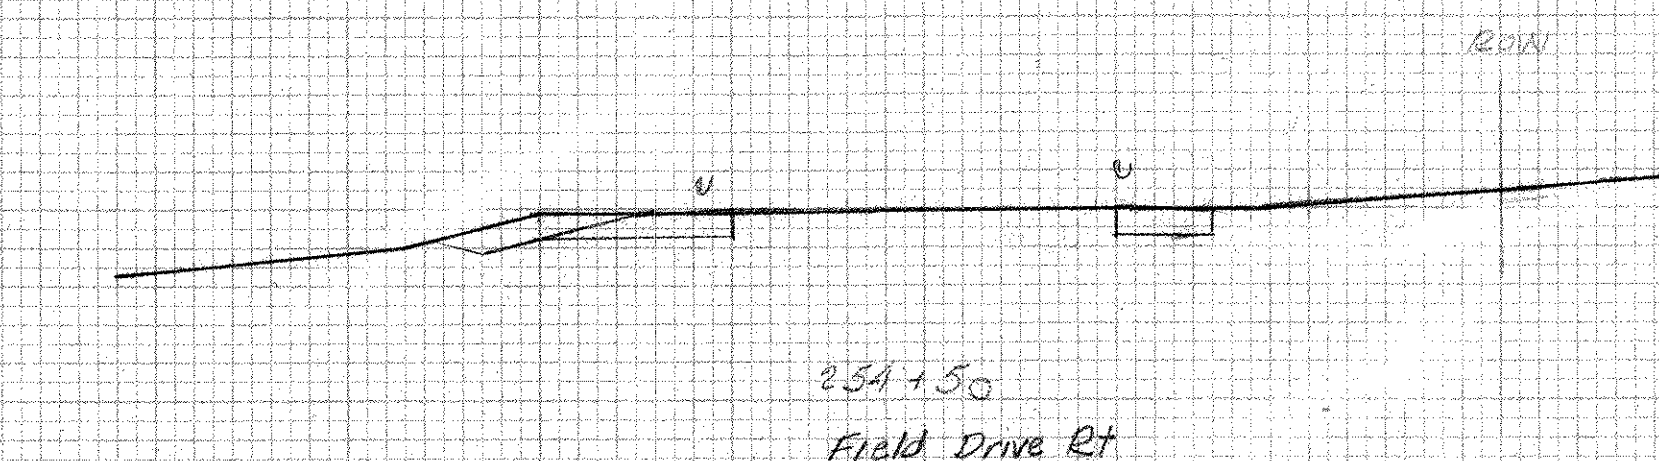

EARTH

20.27	498.5
21.0	498.5
27.0	501.7
20.27	500.2
20.27	498.5

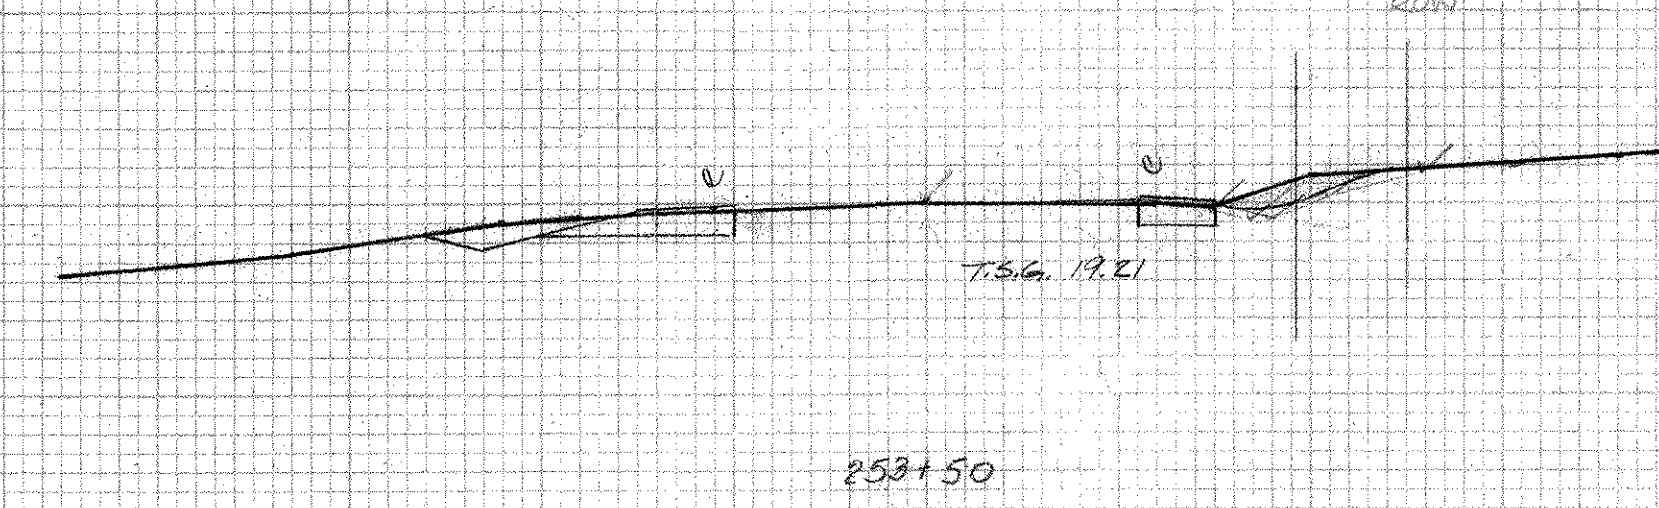

EARTH

19.21	500.0
24.0	501.5
20.0	501.5
19.21	501.2
19.21	500.0

SHOREHAM-BRIDPORT ADDISON
E 017-1(2)
ORIGINAL SCATTERS
Sheet 353-A of 477
250+00 - 255+50

DATE	BY	CHKD
DESIGNED	DRN	CHKD
STATIONED	STATIONED	STATIONED
REMARKS	REMARKS	REMARKS
APPROVED	APPROVED	APPROVED

DATE	BY	CHKD
DESIGNED	DRN	CHKD
STATIONED	STATIONED	STATIONED
REMARKS	REMARKS	REMARKS
APPROVED	APPROVED	APPROVED