




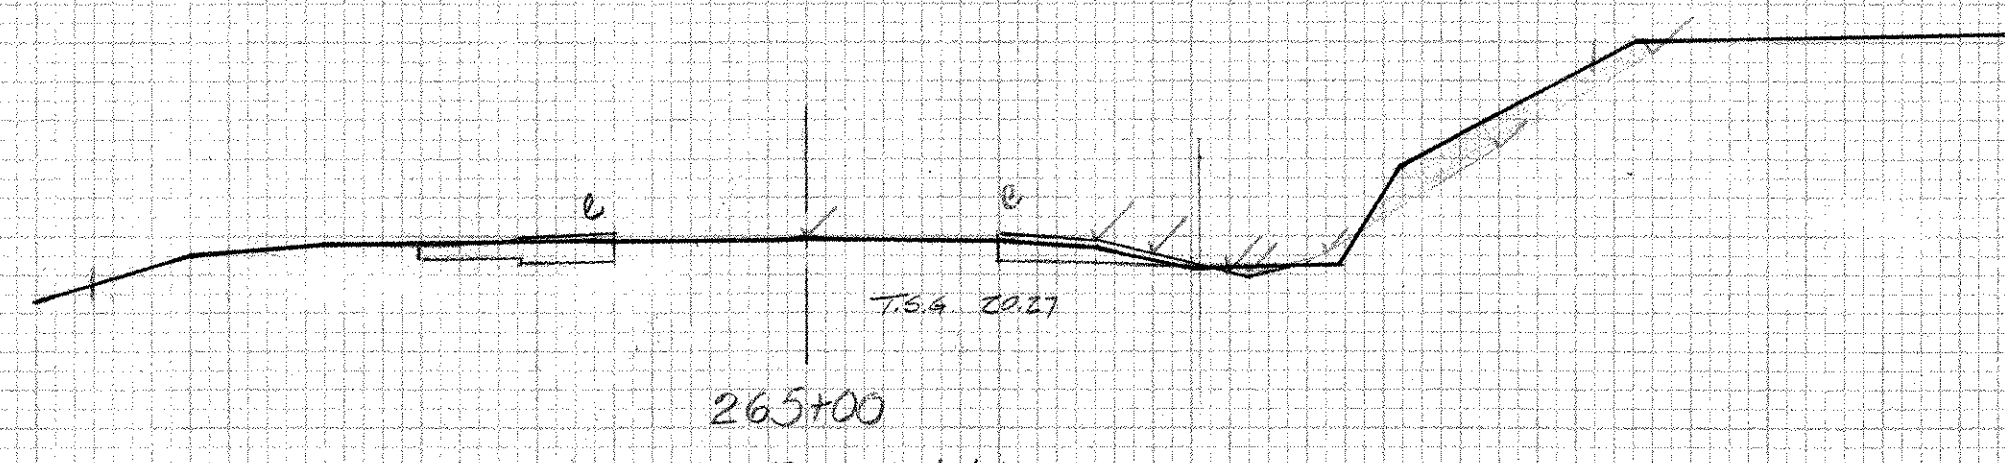


EARTH	
24.0	500.3
30.0	504.6
45.0	510.0
43.0	510.0
31.0	508.8
29.0	501.3

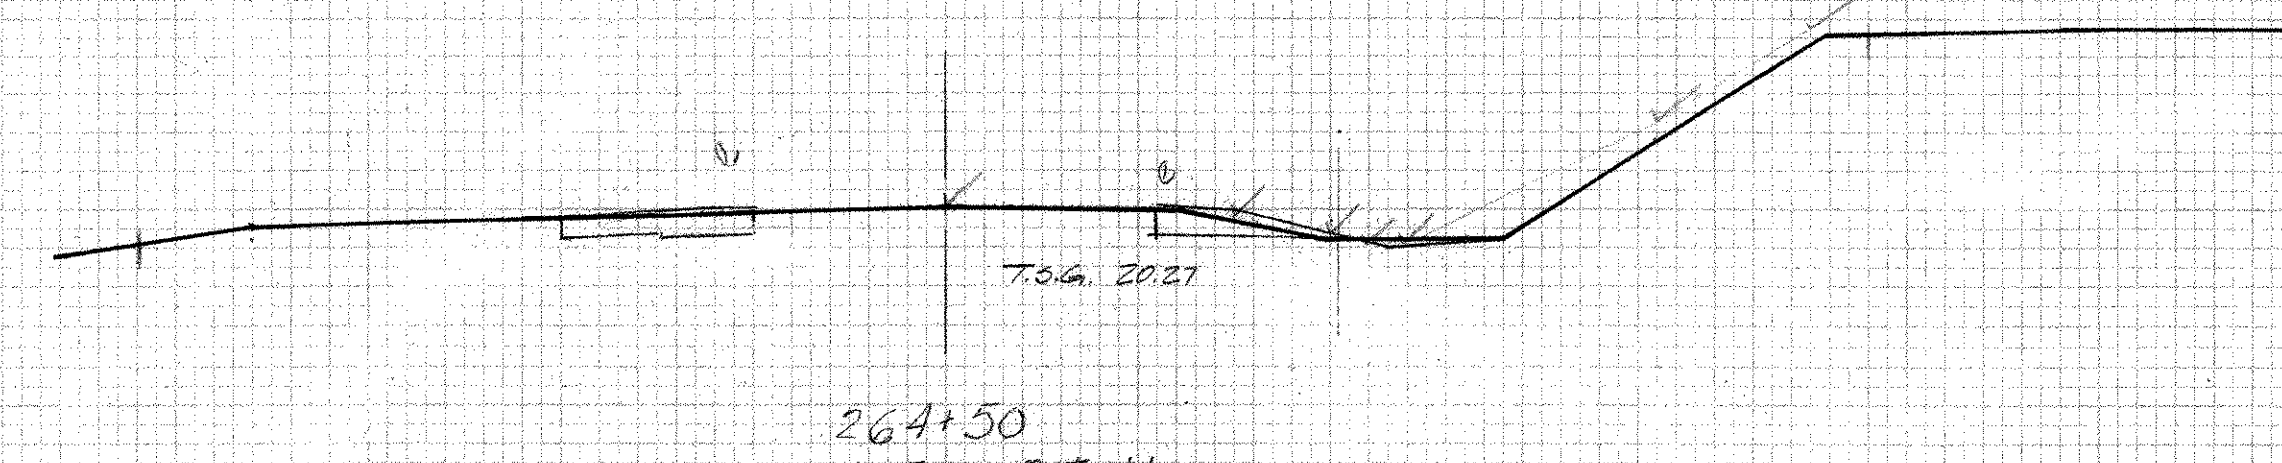


EARTH	
22.0	498.0
23.0	497.7
25.0	497.7
33.0	501.1
41.0	504.6
35.0	503.5
25.0	498.0
22.0	495.0

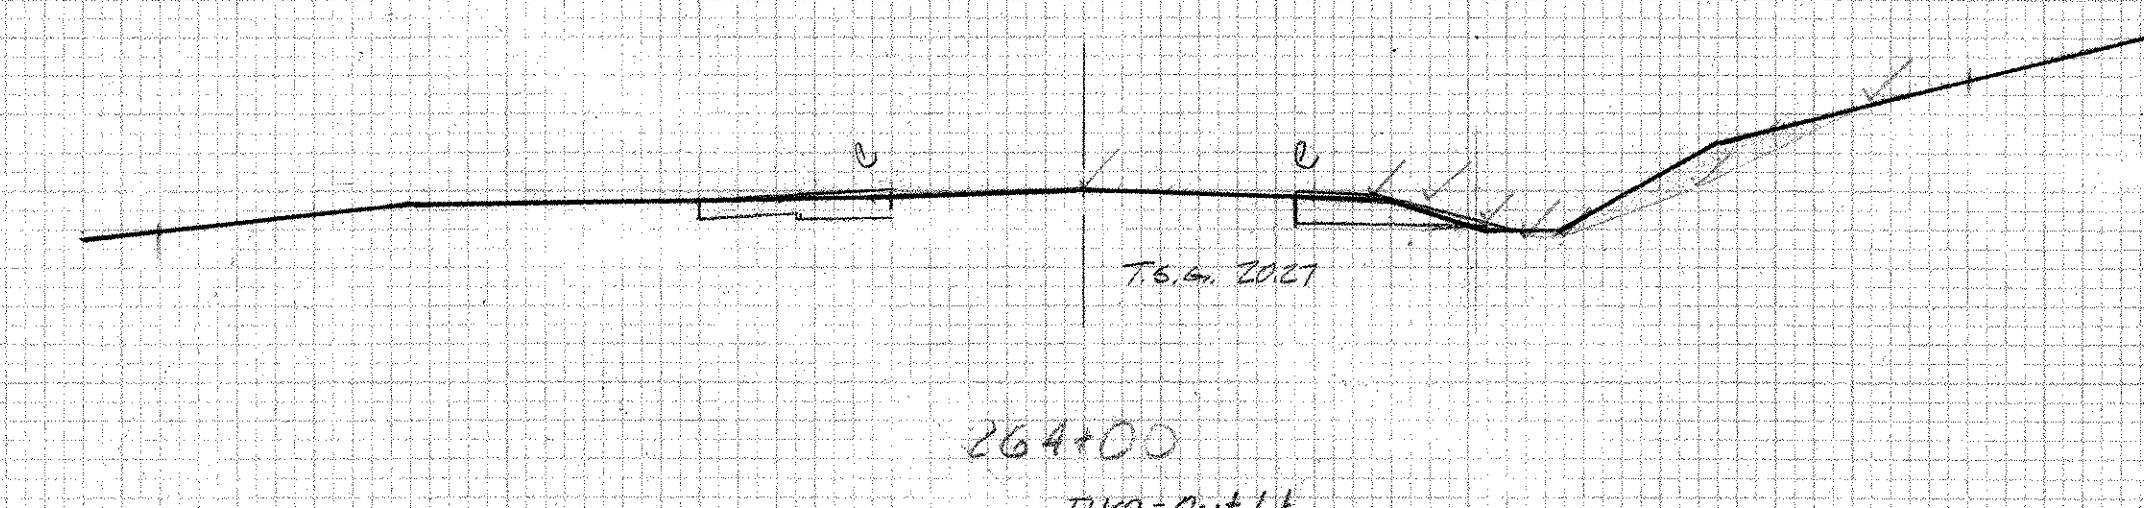



EARTH	
20.0	498.6
24.0	498.1
22.0	498.1
35.0	501.5
38.3	505.5
34.8	503.0
22.4	498.7
20.0	498.6

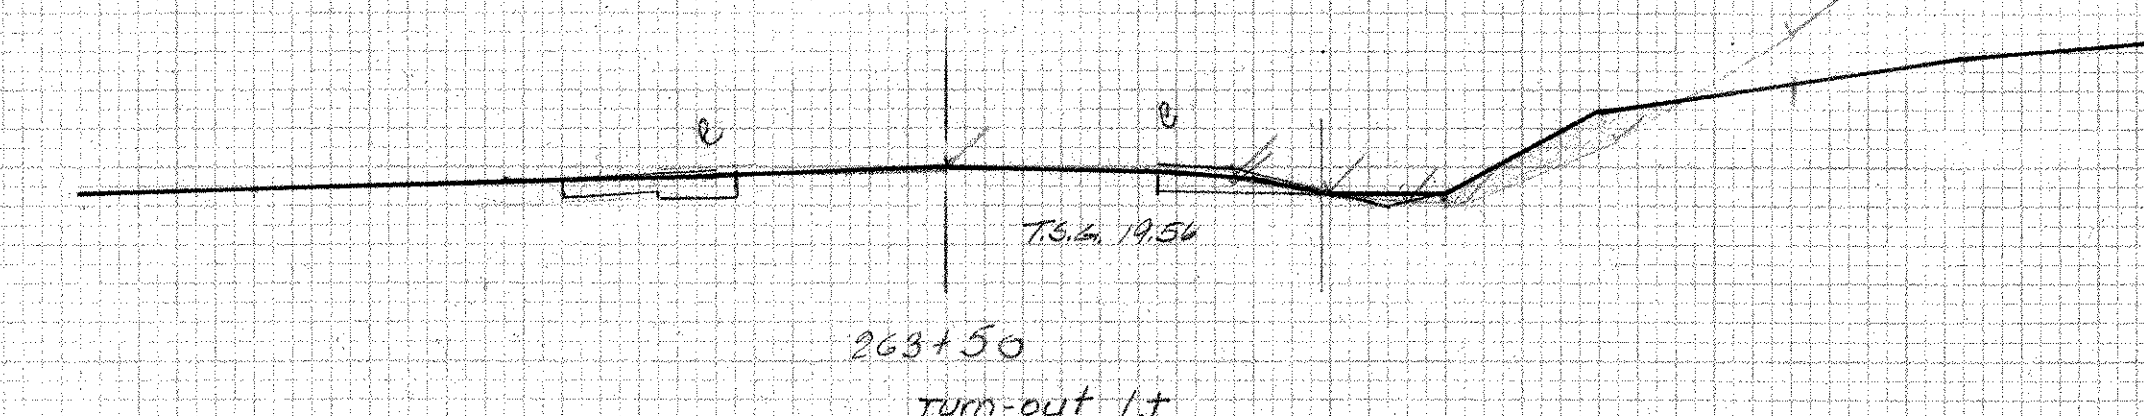


EARTH	
20.0	498.7
23.0	498.5
26.0	498.3
34.0	501.3
40.0	505.5
38.0	505.7
33.0	503.2
26.0	498.7
20.0	498.1

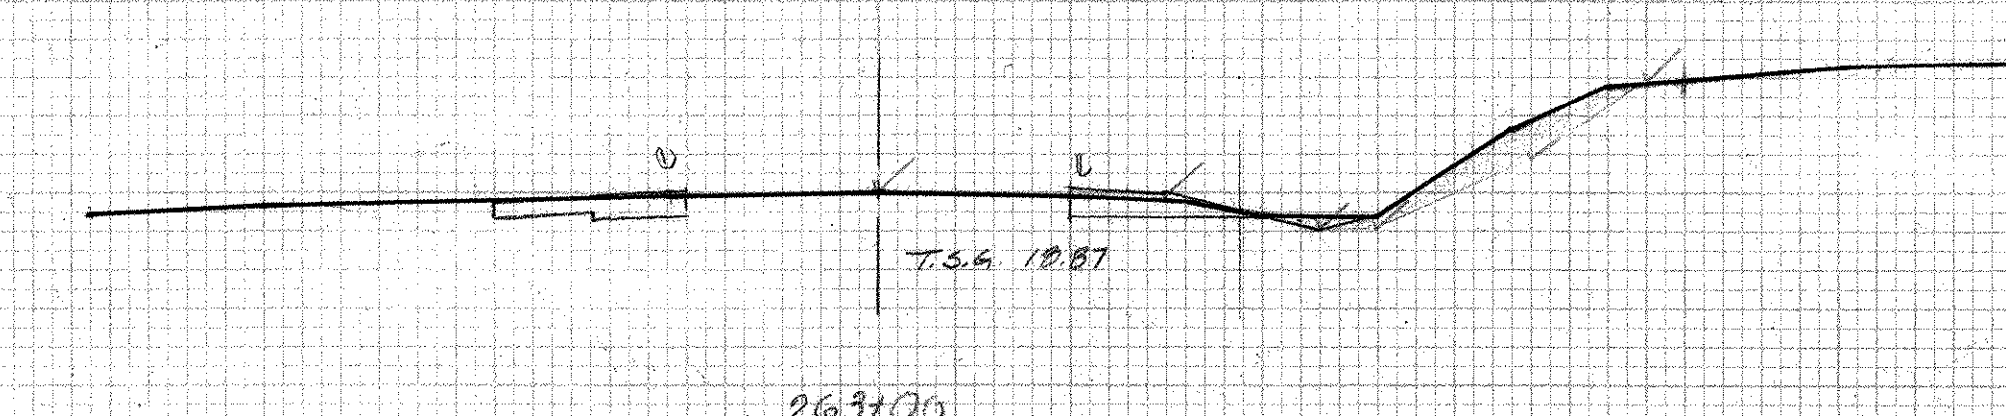


EARTH	
24.0	498.0
26.0	498.0
35.0	501.4
38.0	505.4
28.0	501.6
25.0	498.2
24.0	498.0

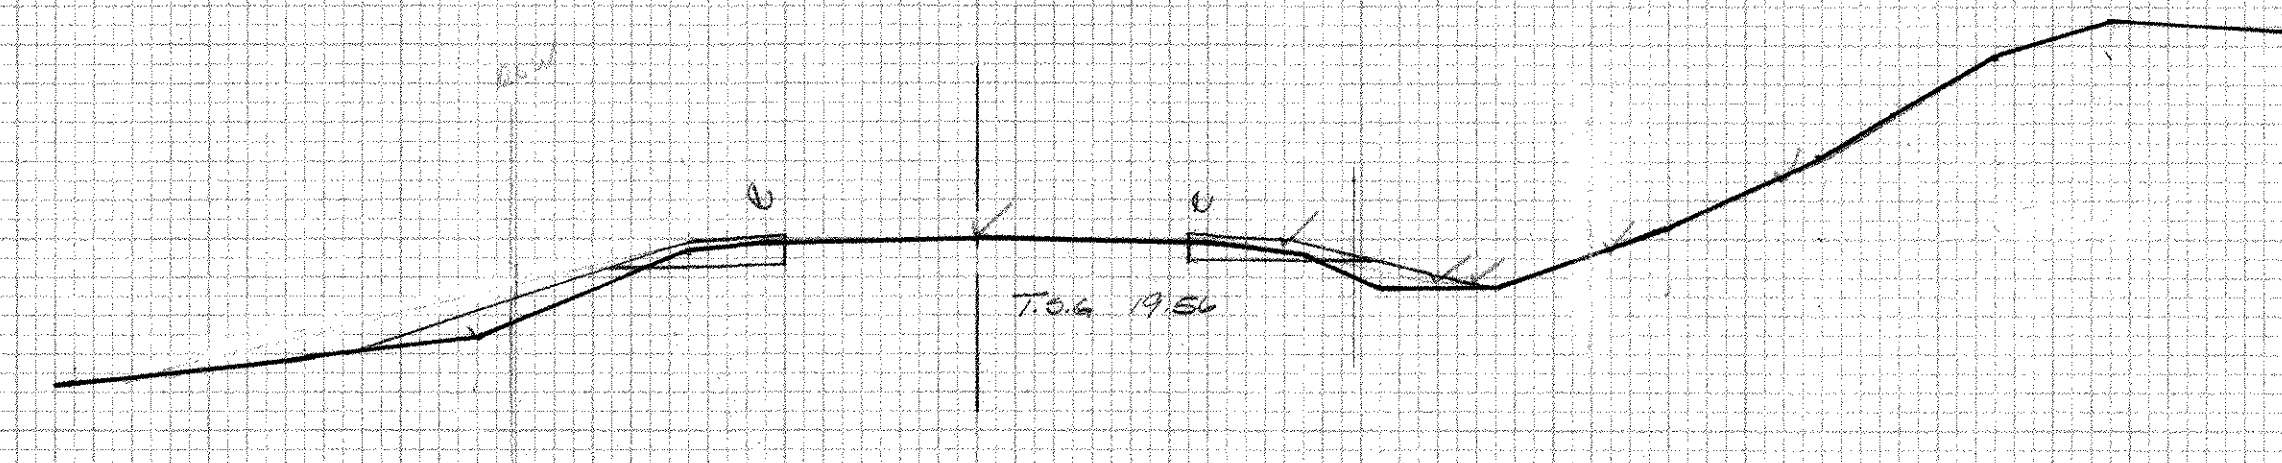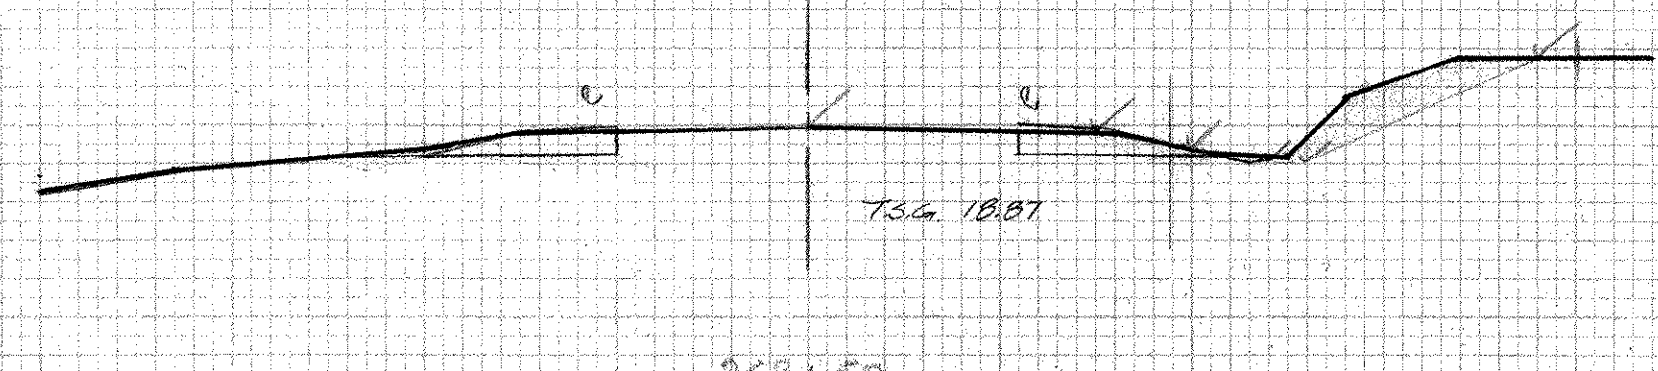


EARTH	
21.0	498.6
23.0	498.1
26.0	498.1
31.0	501.6
35.0	505.1
27.0	498.7
27.0	498.10

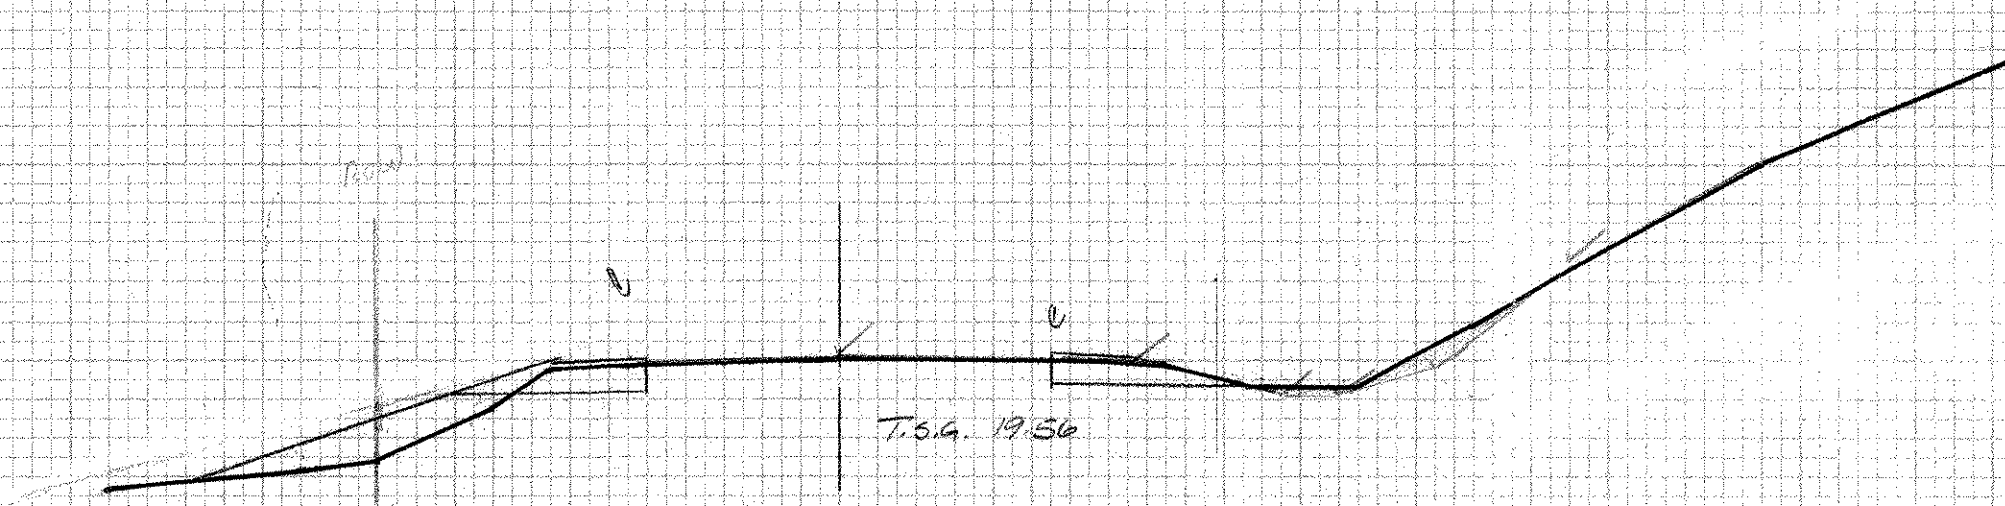


EARTH	
19.50	498.5
23.0	498.1
24.0	498.1
27.0	498.7
33.0	501.2
41.0	503.7
31.0	502.7
24.0	498.0
21.0	498.3
19.50	498.5

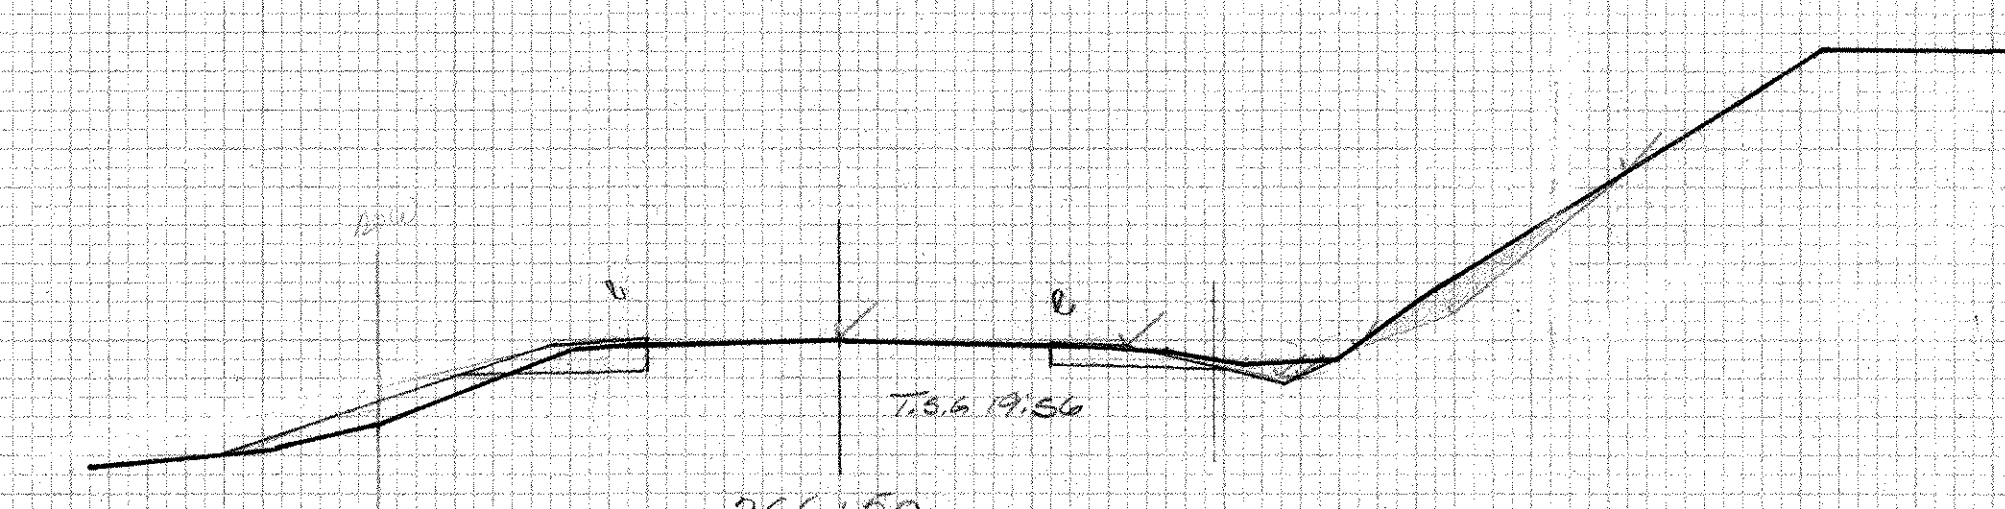

EARTH	
20.27	498.0
22.0	498.6
24.0	498.6
23.0	498.1
35.0	504.1
40.0	507.4
20.27	498.0

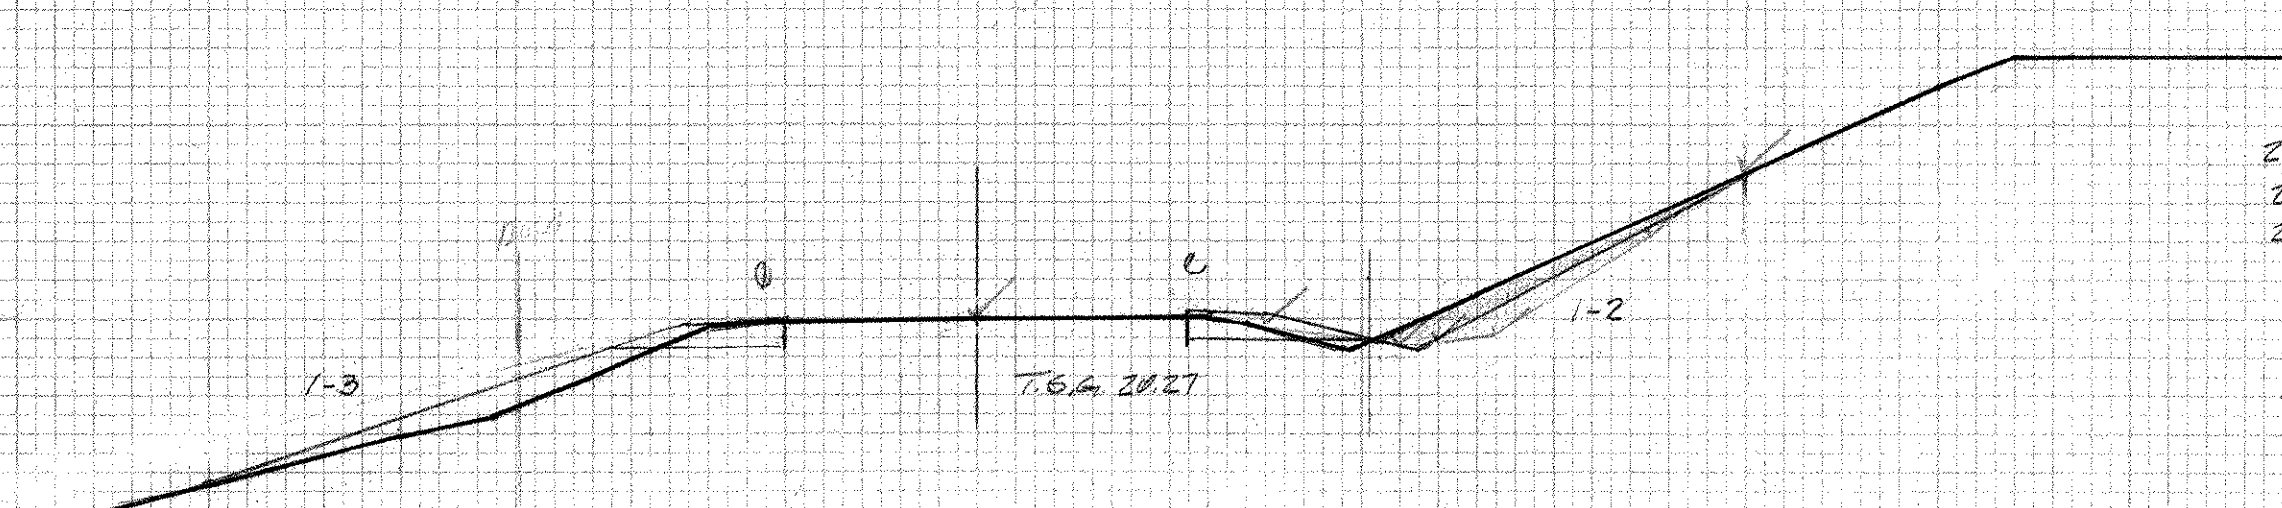

EARTH	
20.27	498.7
23.0	498.2
32.0	504.2
41.0	507.3
39.0	507.1
23.0	498.5
20.27	498.4
20.27	498.7

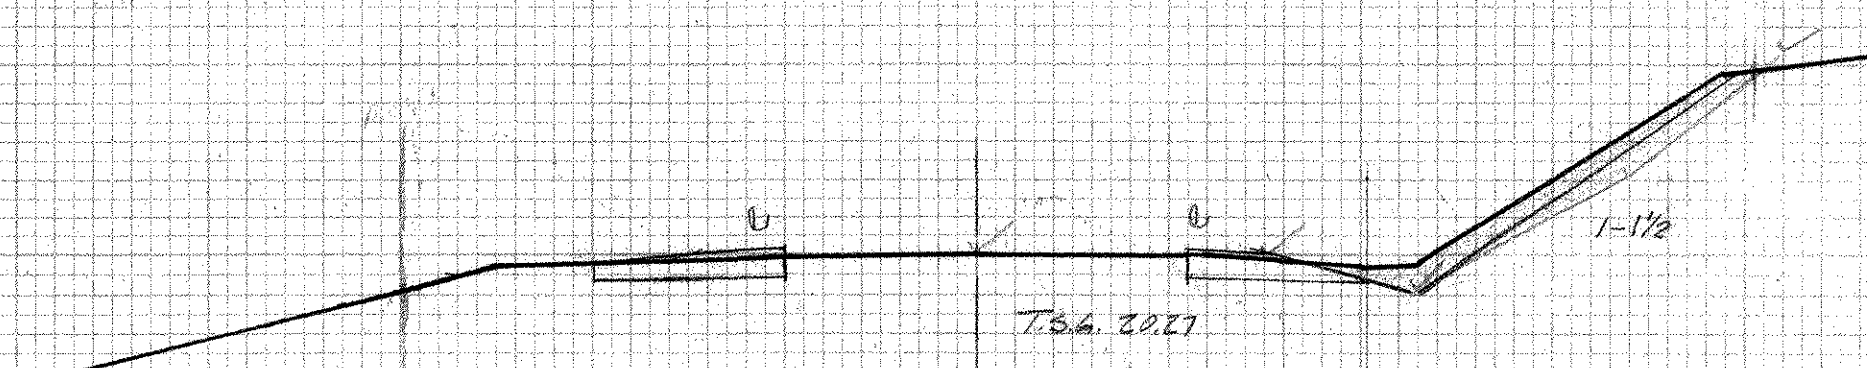

SHOREHAM BRIDGEPORT-ADDIS ON

R 017-112

Original Sections

Sheet 361-A of 477

262+50 ~ 267+50