


EARTH	
22.0	508.0
25.0	508.4
30.0	508.1
40.0	507.0
50.0	506.8
60.0	505.0
72.0	503.0


20.1°

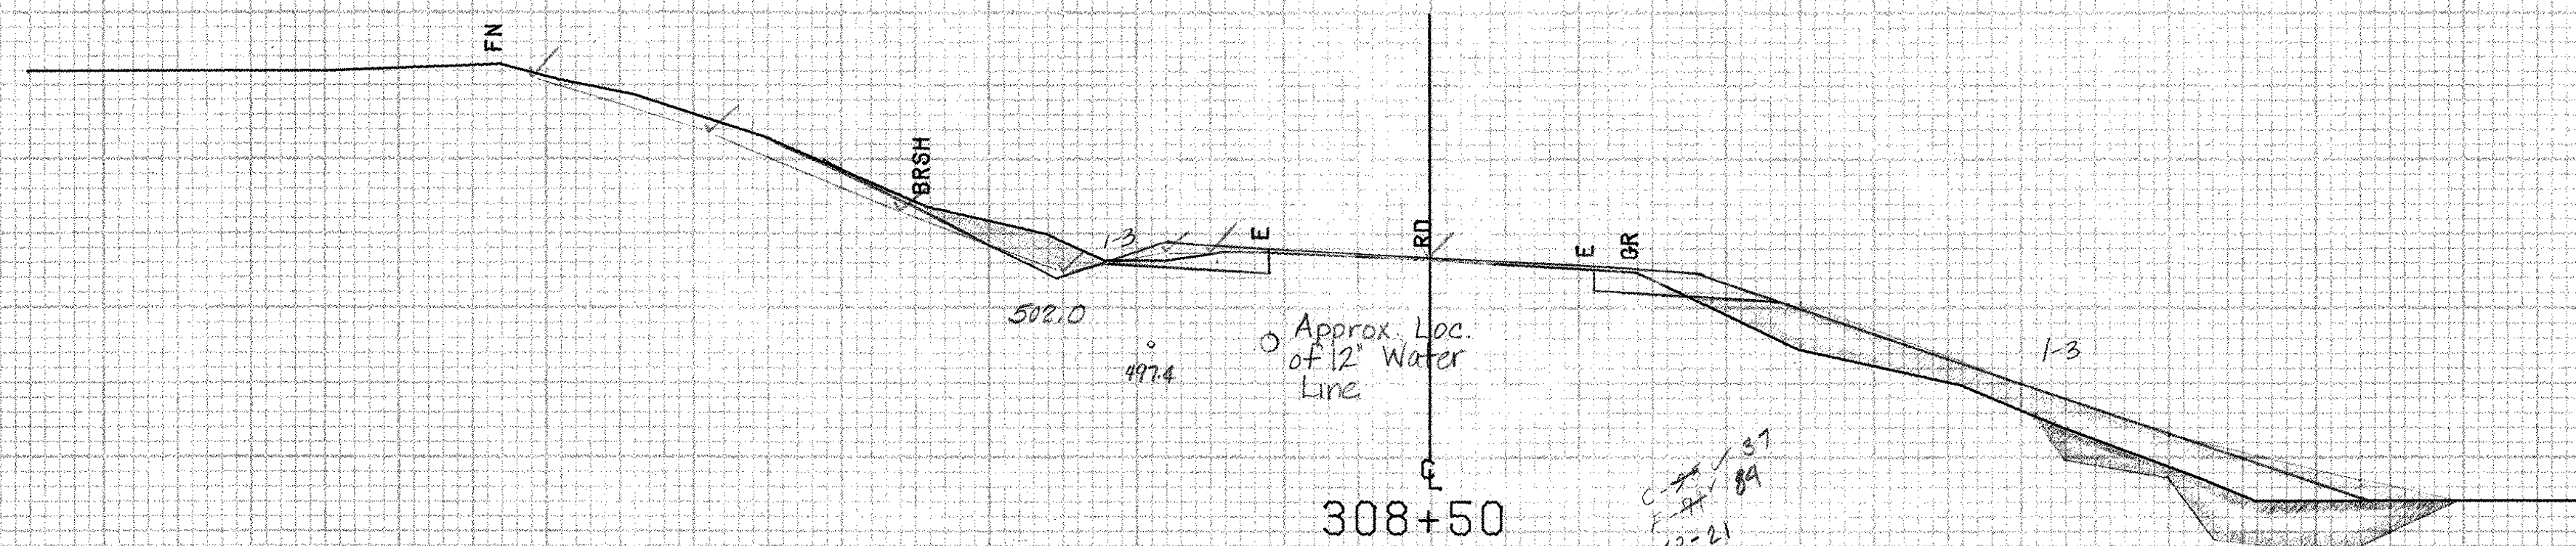

308+00 LT
End Special Ditch w/ Stone Fill Type I
Begin Special Ditch w/ Erosion Matting (Ends @ 312+25 LT.)
Begin 6" x 460' Underdrain (Ends @ 312+50 LT.)

EARTH	
25.0	501.7
27.5	501.0
30.0	502.0
25.0	501.7

2.12

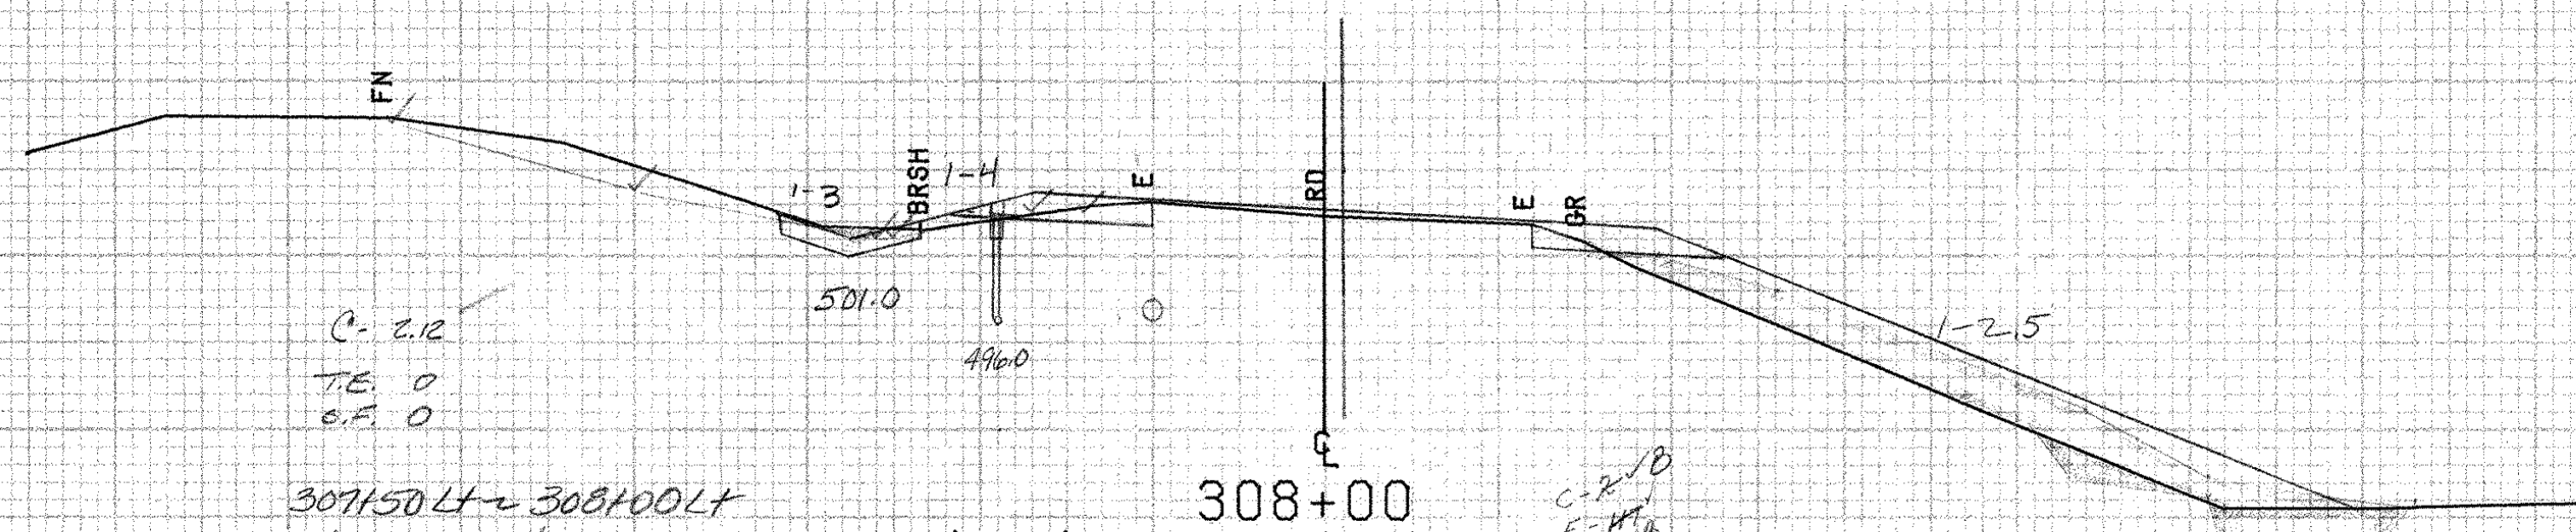


307+50 LT ~ 308+00 LT
New 6" x 60' Underdrain Carrier Pipe
w/ Flushing Basin @ 308+00 LT.

307+74 LT
End Removal & Disposal of
Guard Rail

307+50 LT
Begin Geotextile Fabric for
Filters (Underdrain)

T.E.	
42.0	494.3
43.0	493.0
46.0	495.0
44.0	494.7
42.0	494.3

1.25

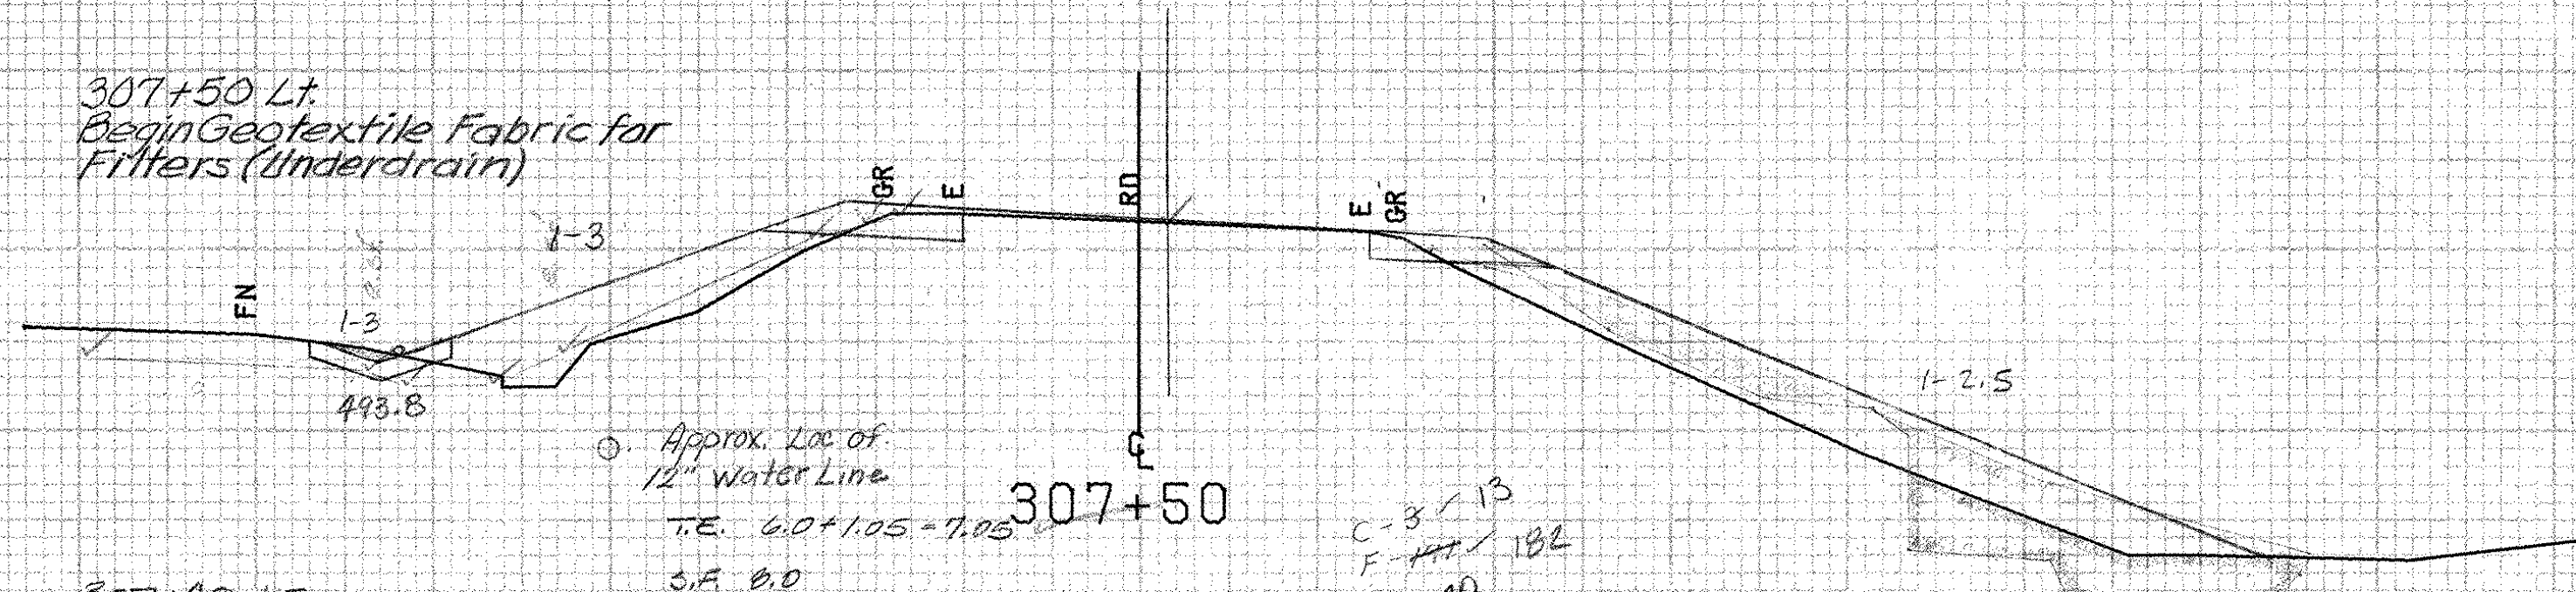

307+40 LT.
END REMOVAL OF EXISTING FENCE
(NON-PART.)

CE UC	
65	487.9
62	484.4
53	484.5
50	485.7
43	489.3
41	492.8
43	493.1
52	488.8
56	487.2
63	487.2
69	487.2
65	487.9

CE UC 487.9

SE	
65	487.9
62	484.4
53	484.5
50	485.7
43	489.3
41	492.8
36	495
25	497.4
18	500.2
25	500.3
40	495.1
50	492.4
63	485.0
69	487.2
65	487.9

SE 487.9

CE UC	
59	482.3
51	482.7
50	480.1
51	485.6
40	485.6
41.5	485.7
69	482.3
49	486.3
42	487.2
40	489.8
49	486.3

CE UC 482.3

SE	
59	482.3
51	482.7
50	480.1
42	487.2
40	489.8
36	491.6
25	492.2
15	500.1
18	500
25	498
40	491.1
50	487.3
57	486.1
62	485.0
59	482.3

SE 482.3

CE UNDERDRAIN	
61	477.9
52	476.1
50	482.7
42	482.3
42	489.7
54.5	480.1
58.5	485.1
64.5	482.9
64	481.8
61	477.9

CE UNDERDRAIN 477.9

SE	
61	477.9
52	476.1
50	482.7
42	482.3
42	489.7
40	491.3
34	491.6
25	495.7
21	498.3
25	497.3
34	493.4
40	491.35
50	487.0
55	483.5
65	483.0

SE 483.0

BRIDPORT MM 5.68 ~ 24.14

FROM STA. 307+50 TO STA. 308+50
PROJECT NAME SHOREHAM-BRIDPORT-ADDISON
NO. F017-1(2) PLOTTED 02/28/84
SURVEYED BY FANTONI
SHEET 371 OF 472 SHEETS
FEBRUARY 84

SCALE 1" = 10 FEET