


FINAL SURVEY	DATE	
	BY	
NOTE BOOK	SURVEYED	
	PLATTED	
No.	TEMPERATURE	
	WIND DIRECTION	

EARTH

20.27	499.6
20.27	498.7
22.0	498.5
22.0	498.3
22.0	498.0
22.0	498.3
22.0	498.5
22.0	498.2
20.27	499.6


4.72

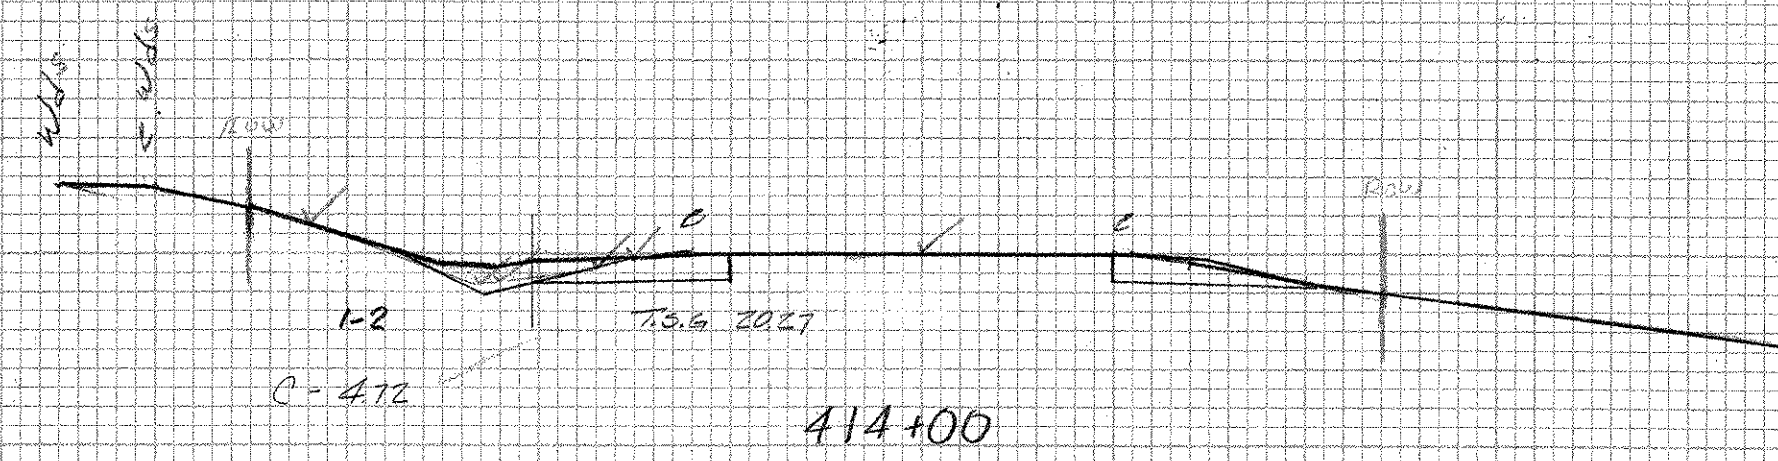

EARTH

21.47	499.6
21.47	498.0
22.0	498.4
22.0	498.2
22.0	498.2
21.47	498.6

9.34

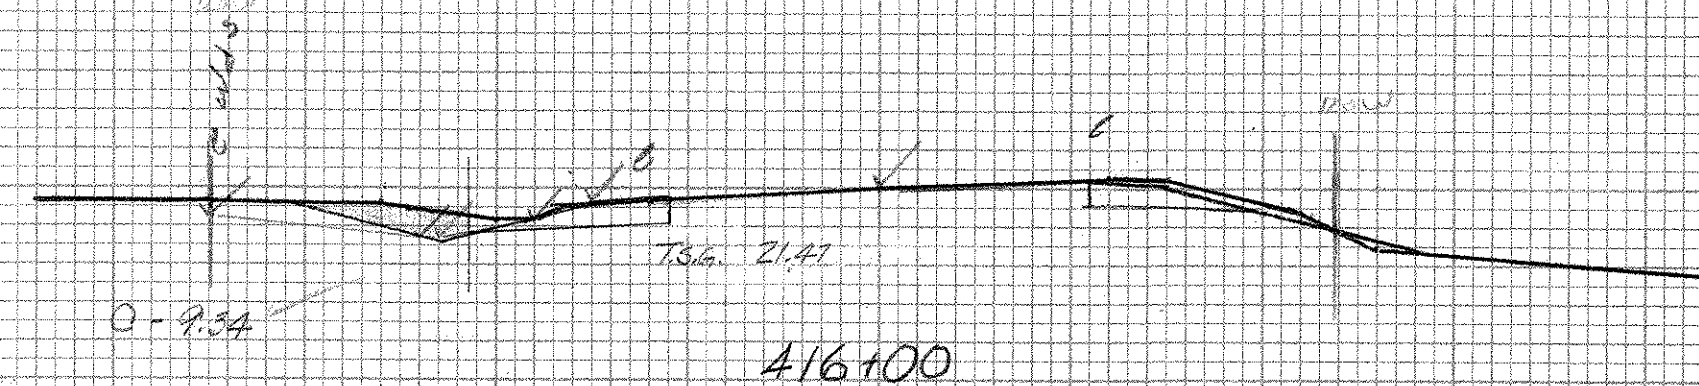


OLD STONE BOX: C 415+80

EARTH

20.27	499.0
20.27	498.1
22.0	498.0
22.0	498.0
22.0	498.0
22.0	498.6
22.0	498.1
22.0	498.7
20.27	499.0


7.73

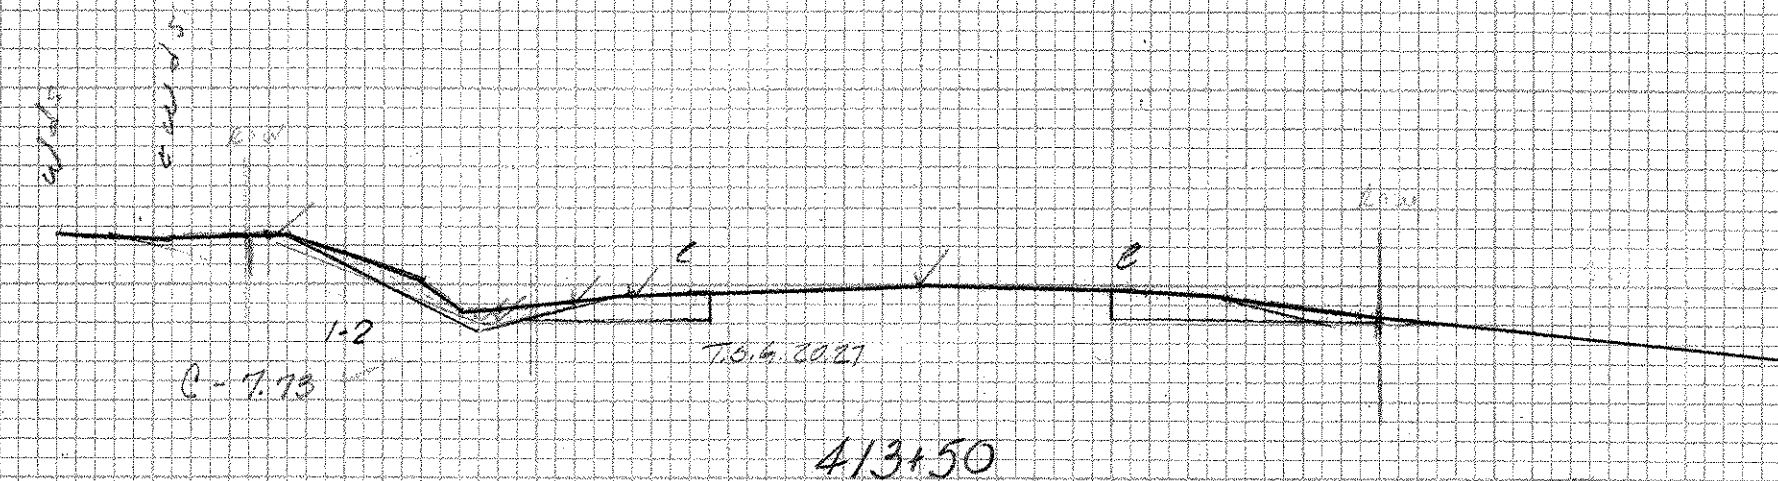

EARTH

20.42	498.4
20.42	498.0
22.0	498.5
22.0	498.0
20.42	498.4


4.06

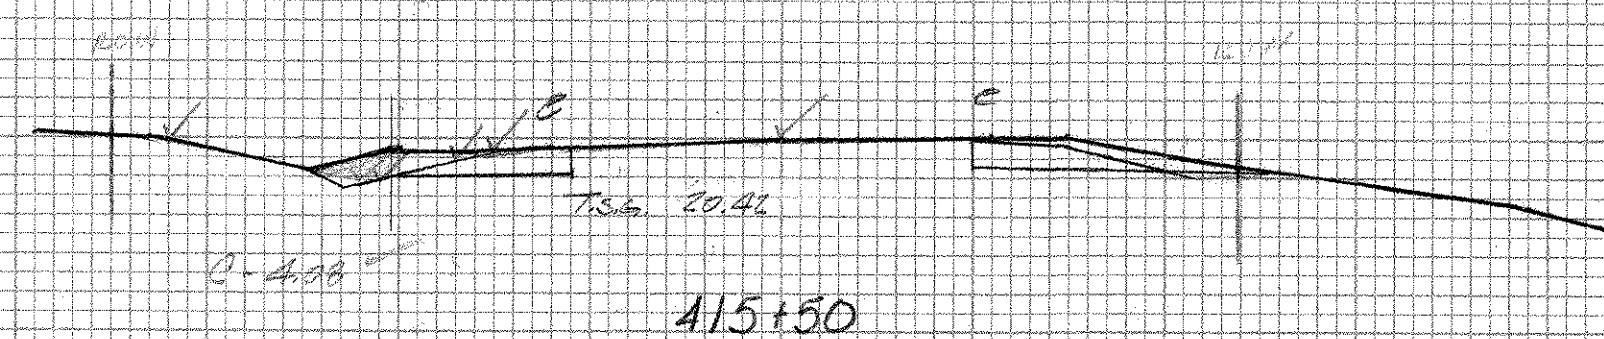

EARTH

20.27	498.5
20.27	498.0
22.0	498.1
22.0	498.1
22.0	498.7
22.0	498.7
22.0	498.4
22.0	498.4
20.27	498.5


5.63

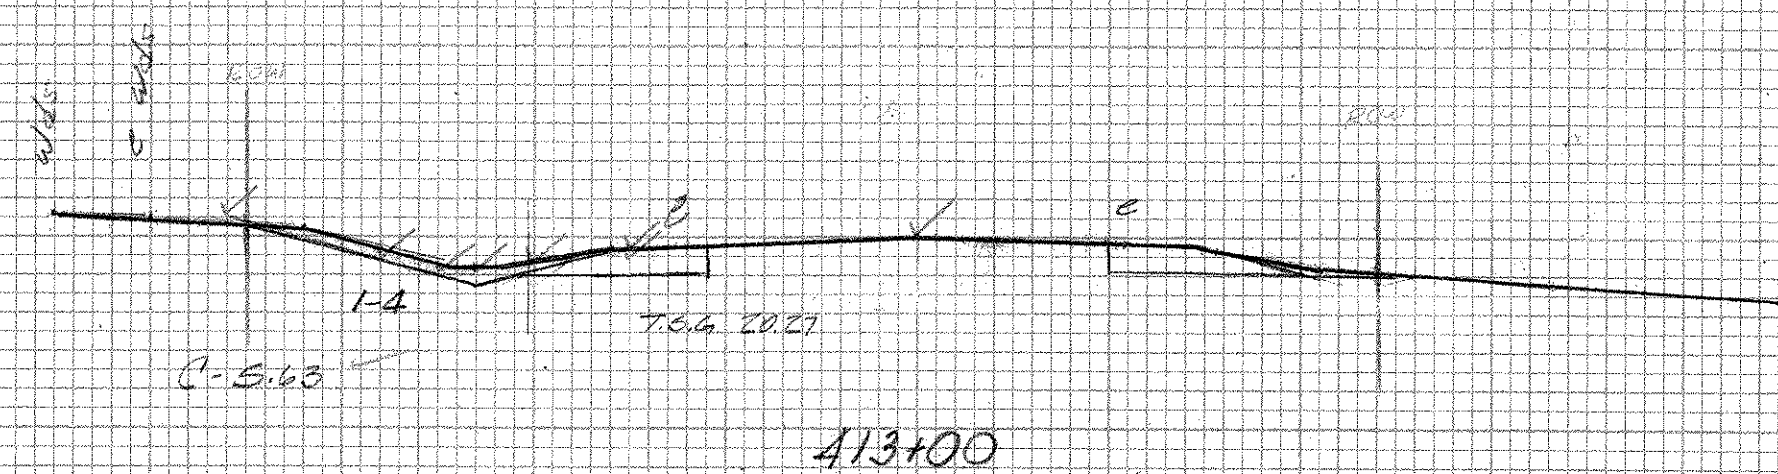

EARTH

20.27	499.4
20.27	498.3
22.0	498.2
22.0	498.6
22.0	498.1
22.0	500.0
22.0	498.4
20.27	499.4


1.39

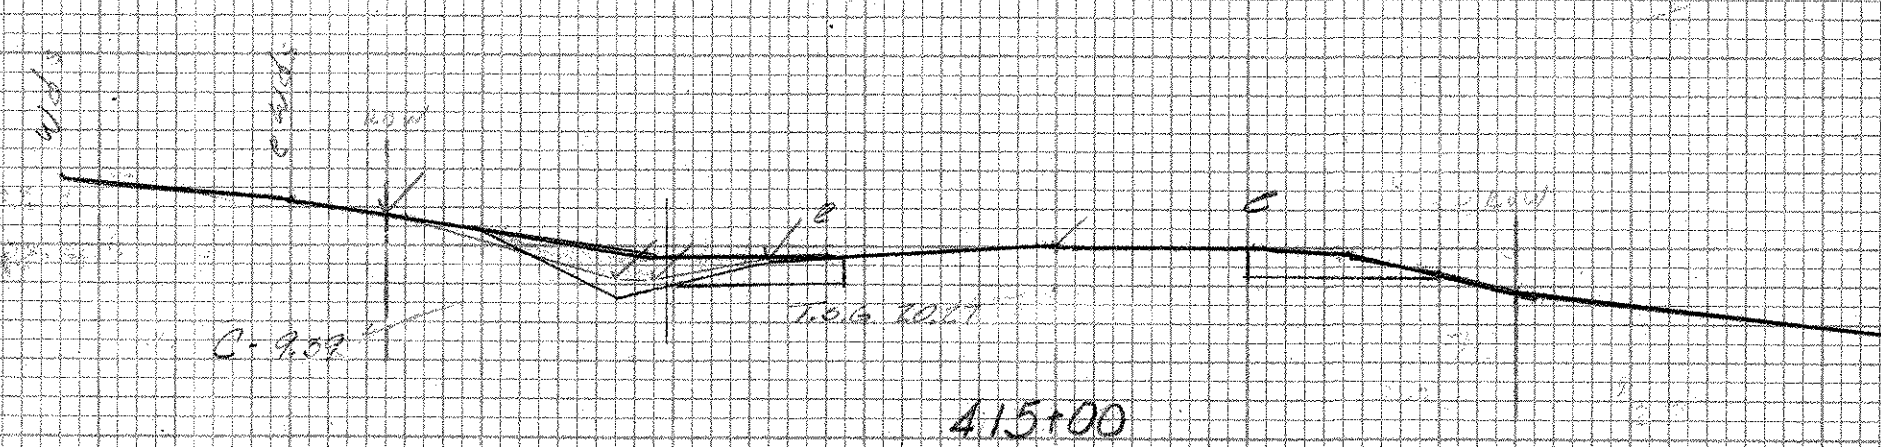

EARTH

20.27	498.5
20.27	498.3
22.0	498.4
22.0	498.4
22.0	498.7
22.0	498.3

3.69

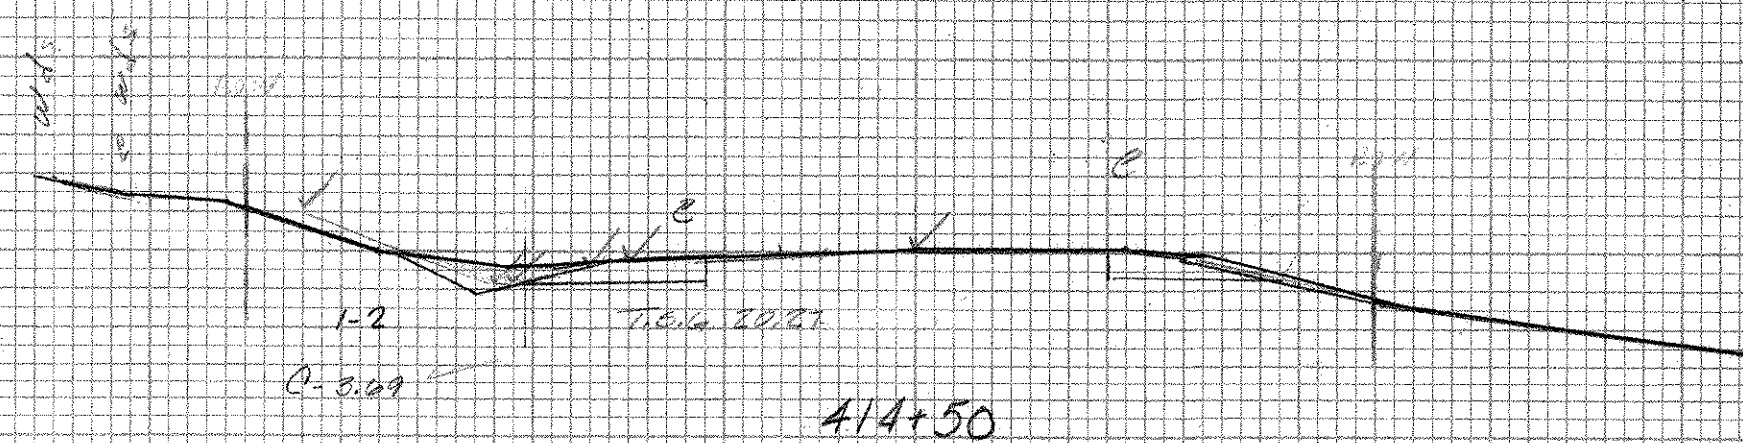

SHOREHAM-BRIDPORT-ADDIS ON
FO17-1(12)
412+50-416+00

ADDITION H.M. 1.32

Plotted R. Russell
sheet 404-G of 477

PLAT 4.56 5.44 9.22
S. R. E. STANDARD