




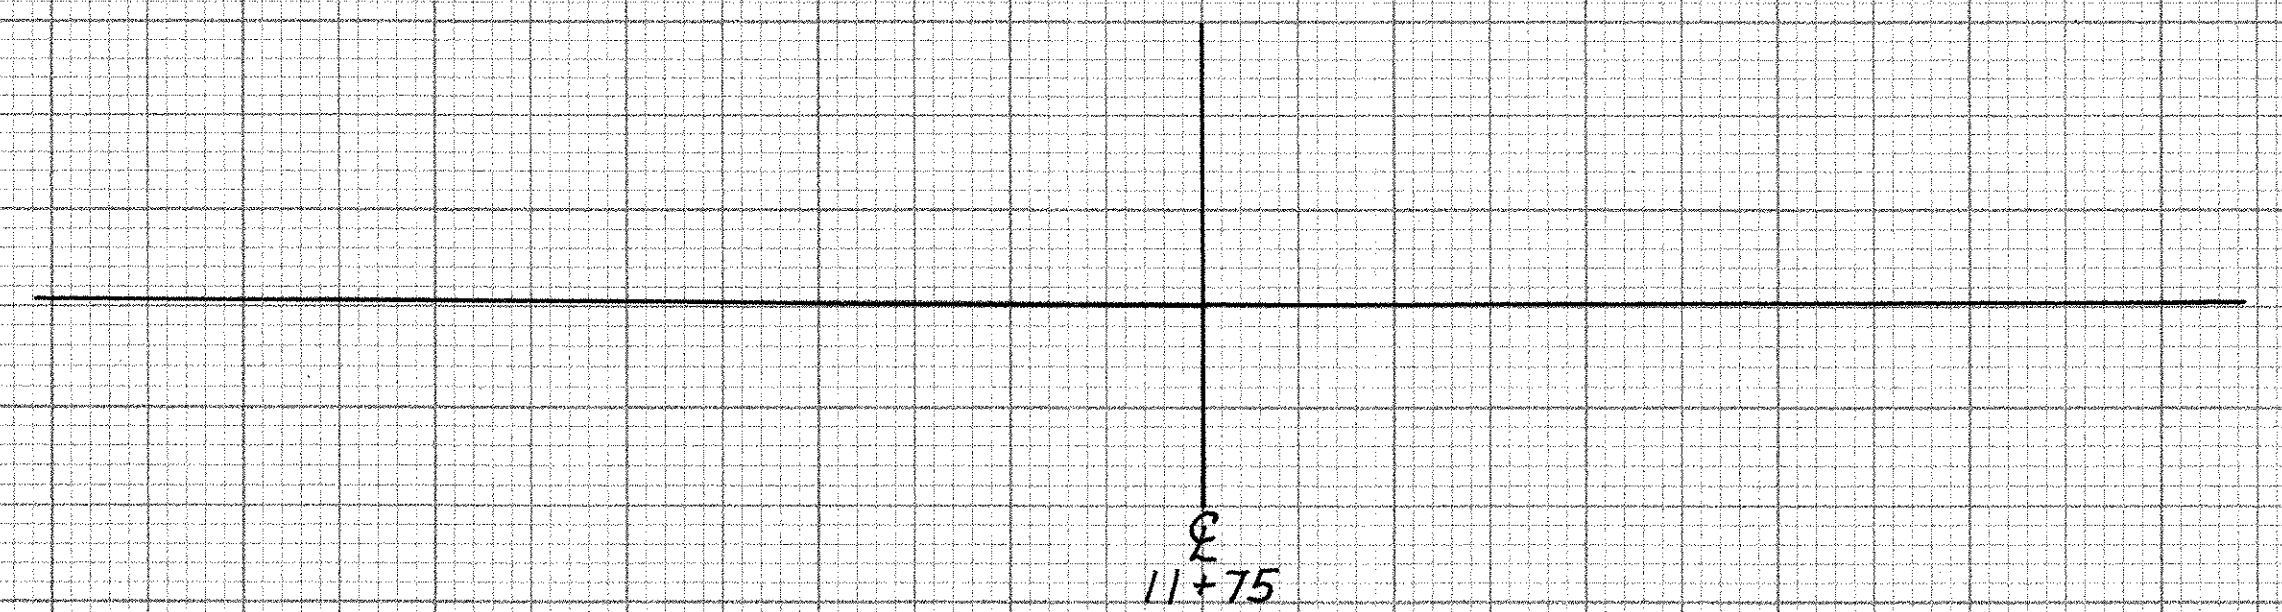

490

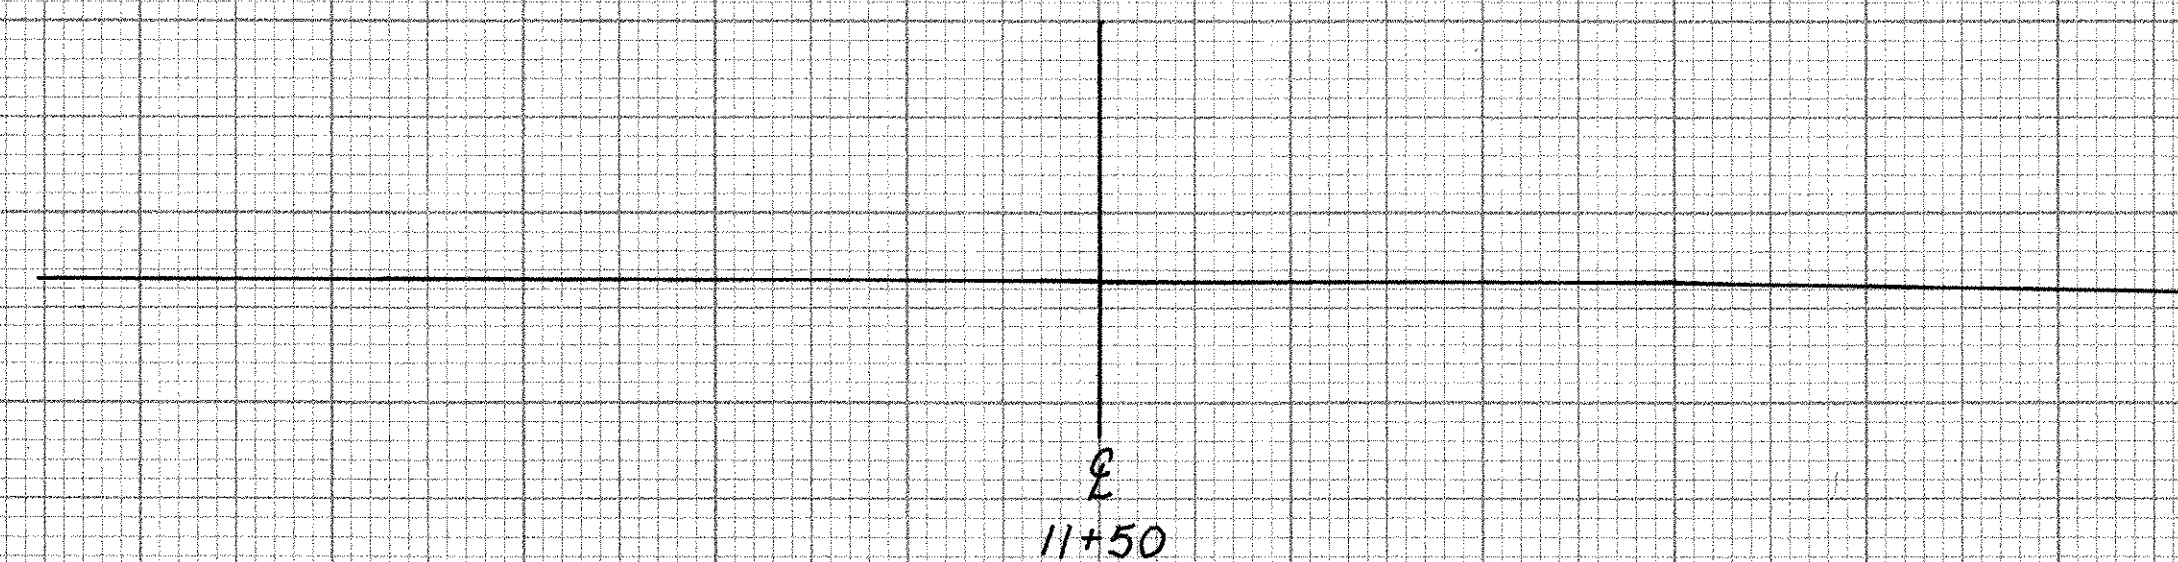


490

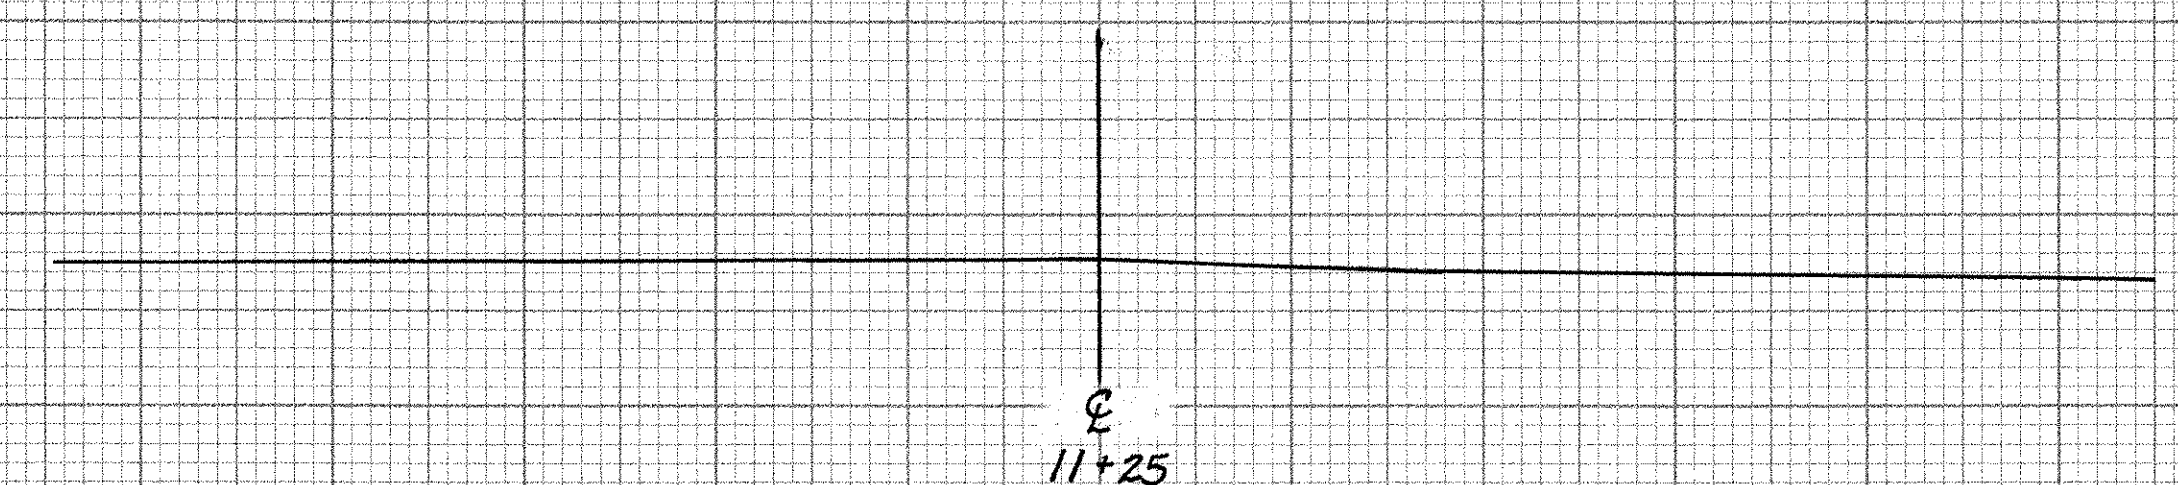

490


11+20
End Construction
End Unclassified Channel Excavation

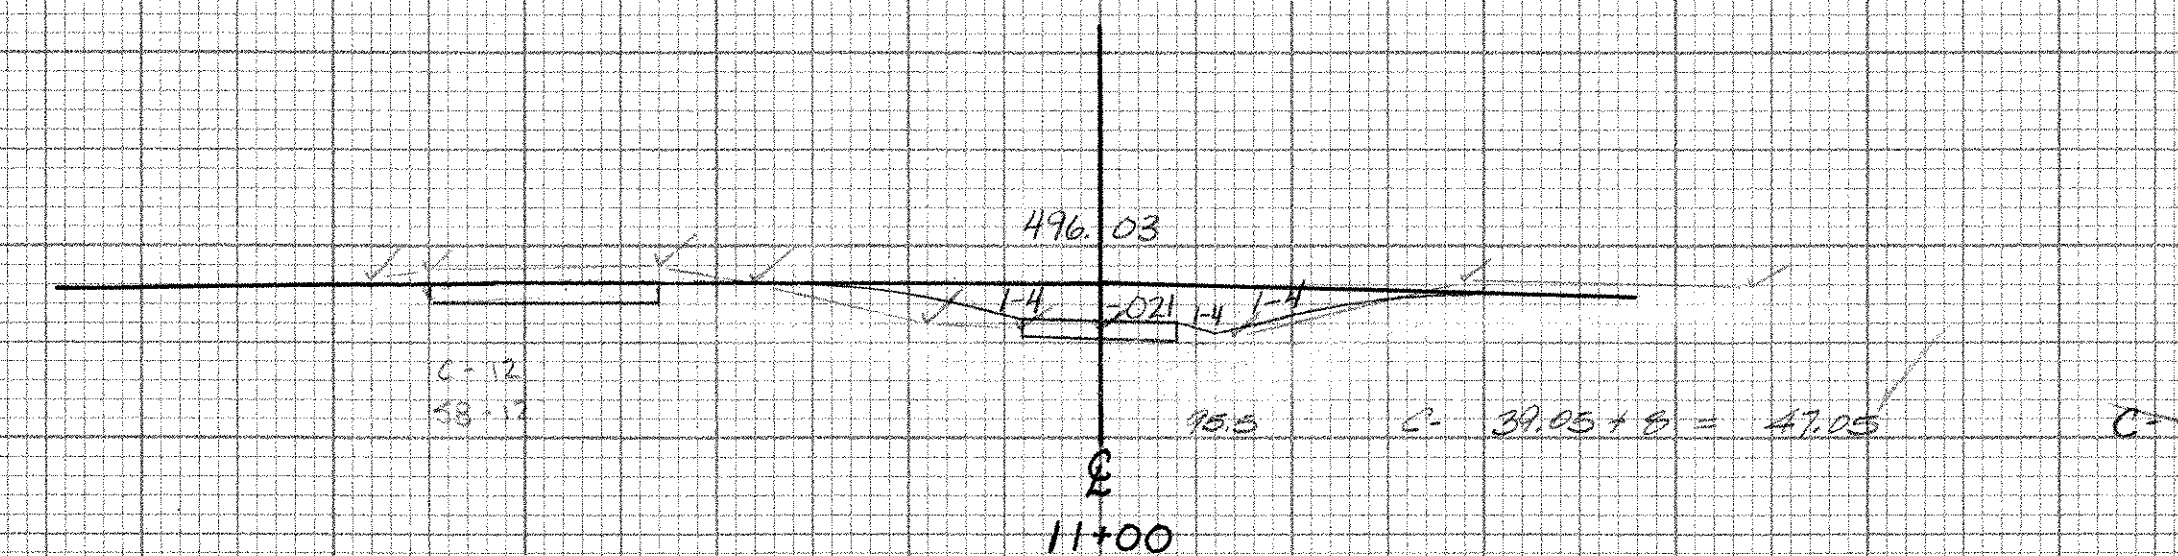

490

CHANNEL

0	496.0
4	496.0
6	495.5
10	497.0
14	497.7
18	498.0
22	497.0
26	496.0
30	496.0

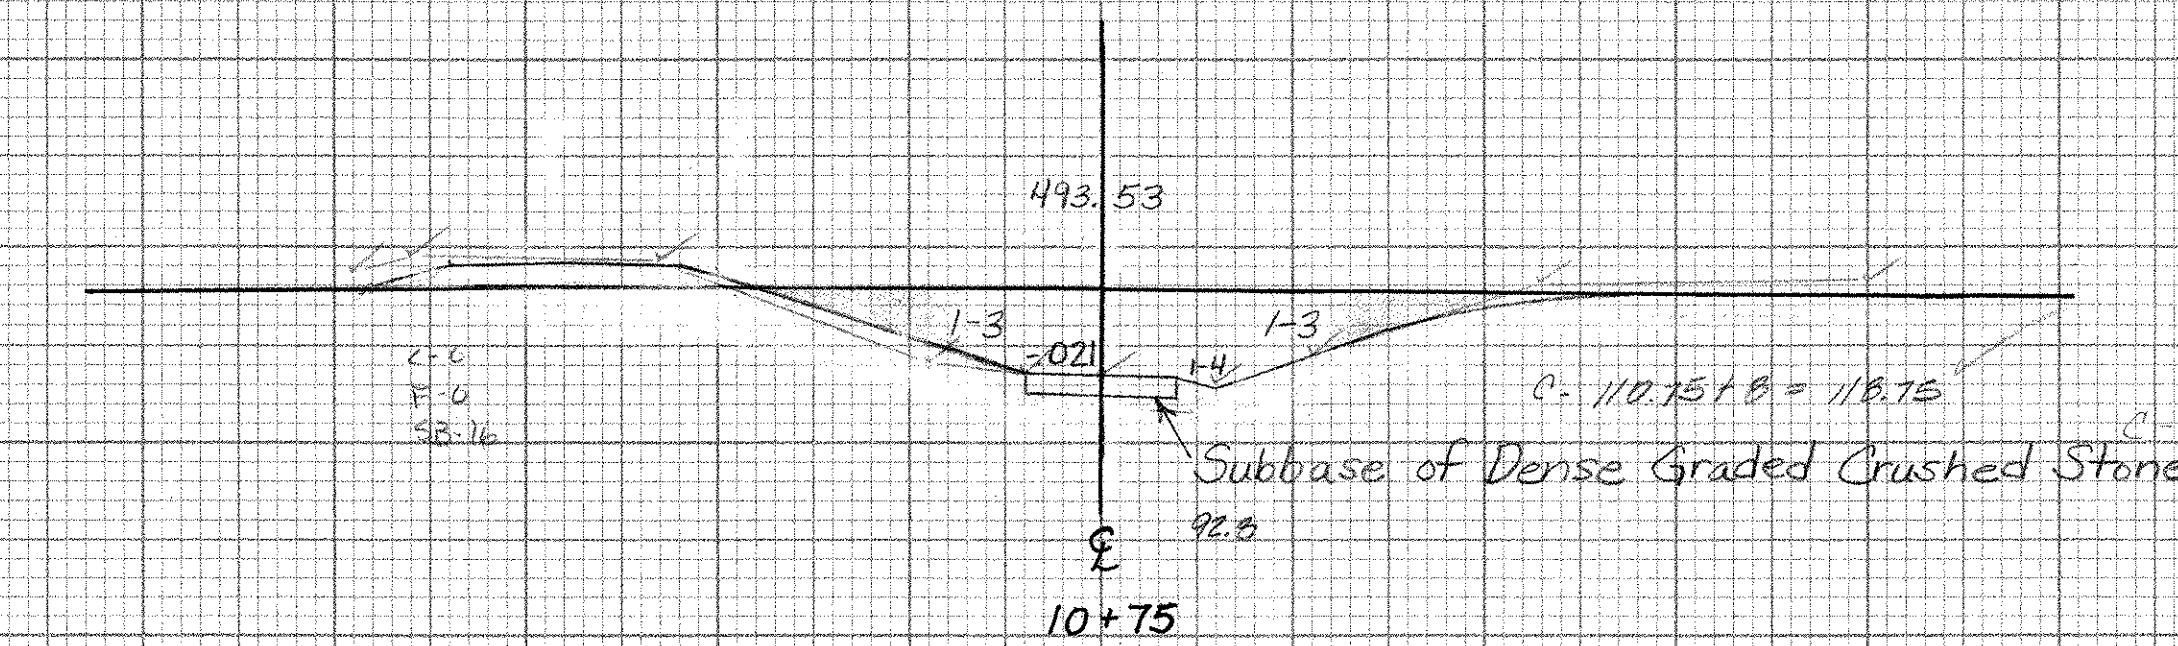

490

CHANNEL

0	493.5
4	493.5
6	493.0
10	494.0
14	494.7
18	495.0
22	495.0
26	495.0
30	495.0

Channel Section of Cattle Pass @
Addison MM 3.09

FROM STA 10+75	TO STA 11+75
PROJECT NAME SHOREHAM-BRIDPORT-ADDISON	
NO. FOIT-1(2)	PLOTTED 05/18/88
SURVEYED BY FANTONI	10/87 0081
SHEET 408 OF 420 SHEETS	SHEET 408 OF 477

SCALE 10 FEET