

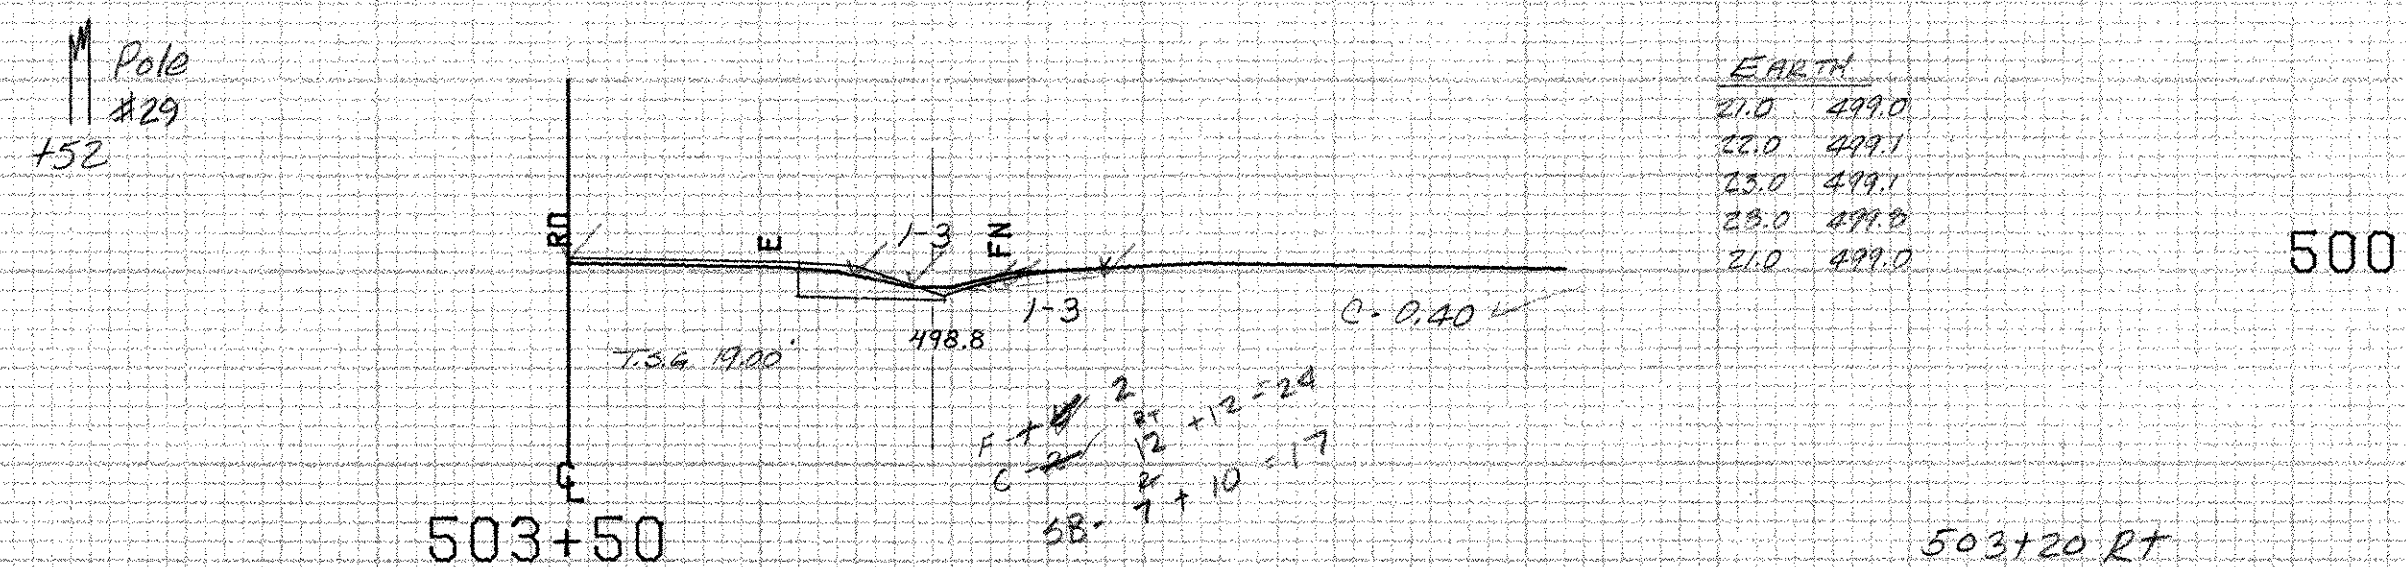
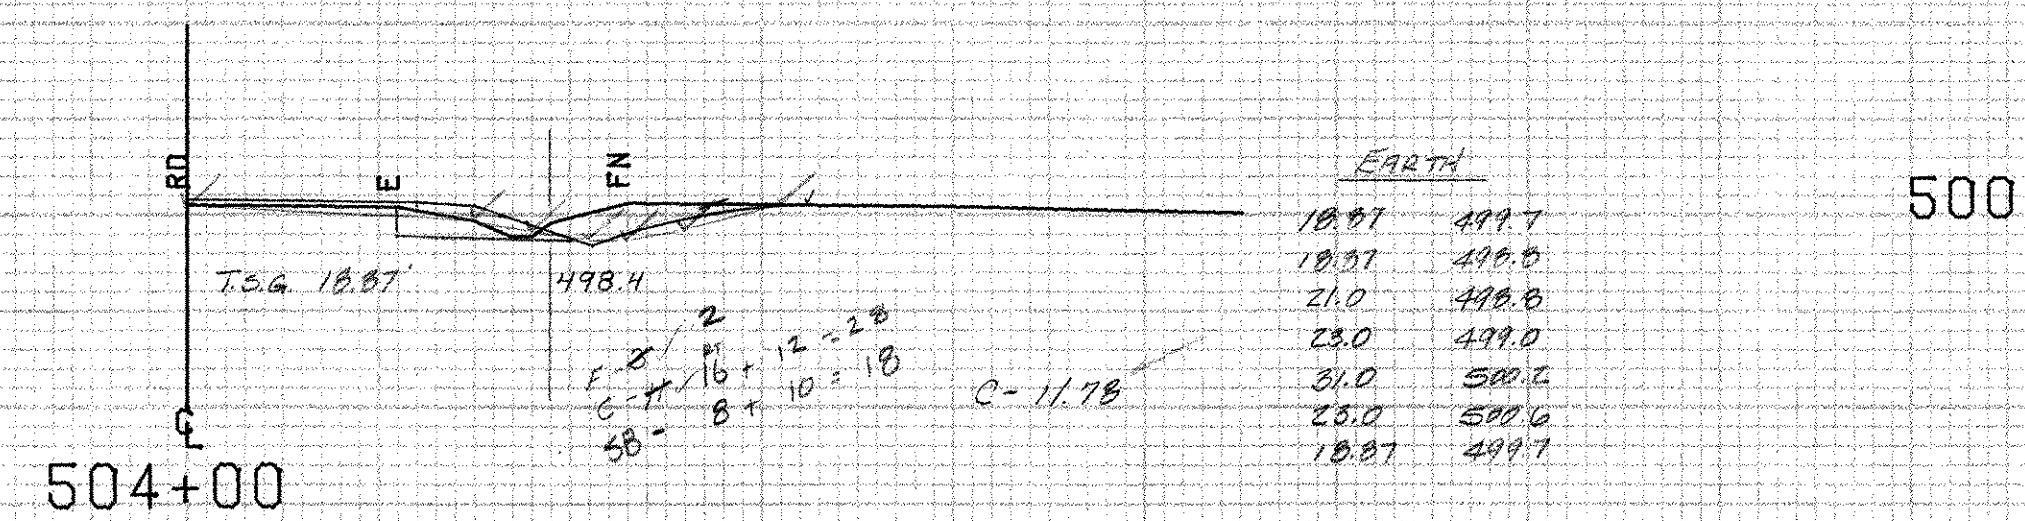
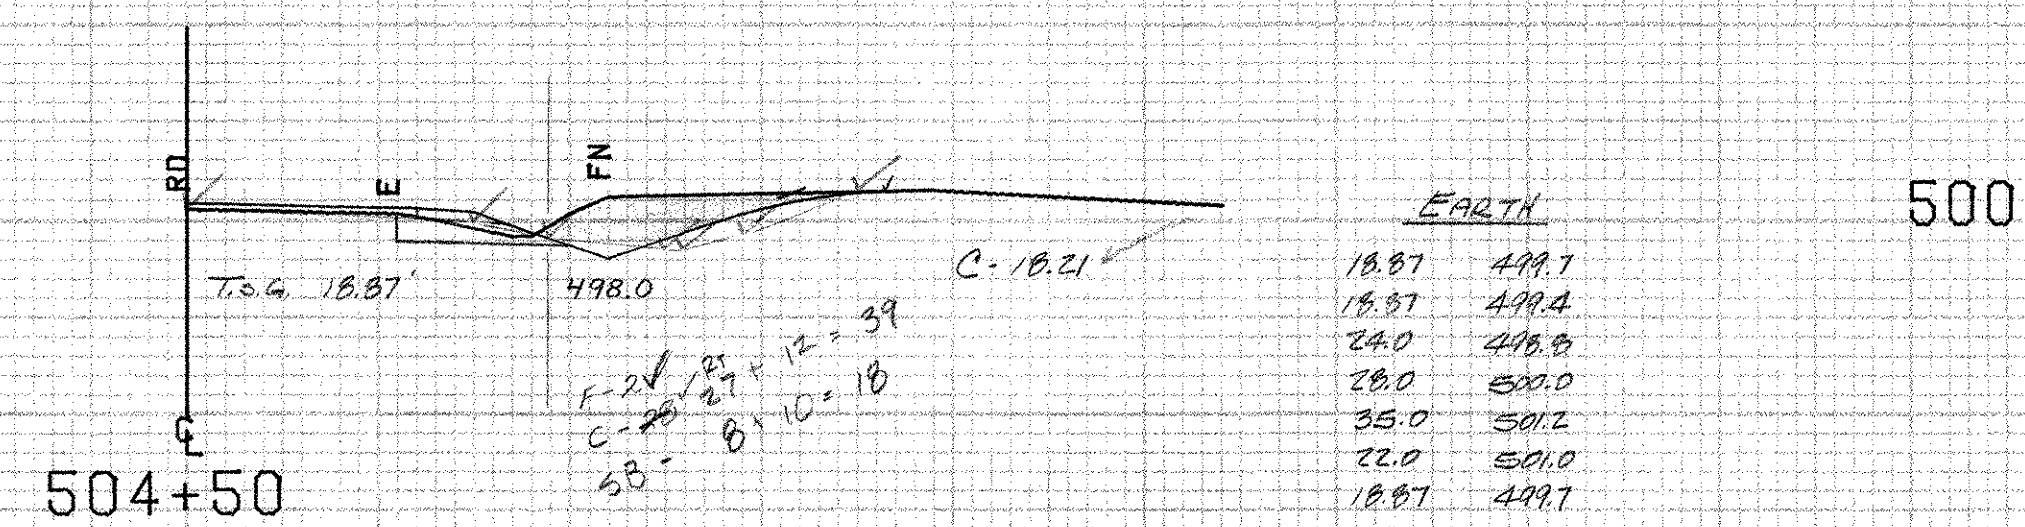


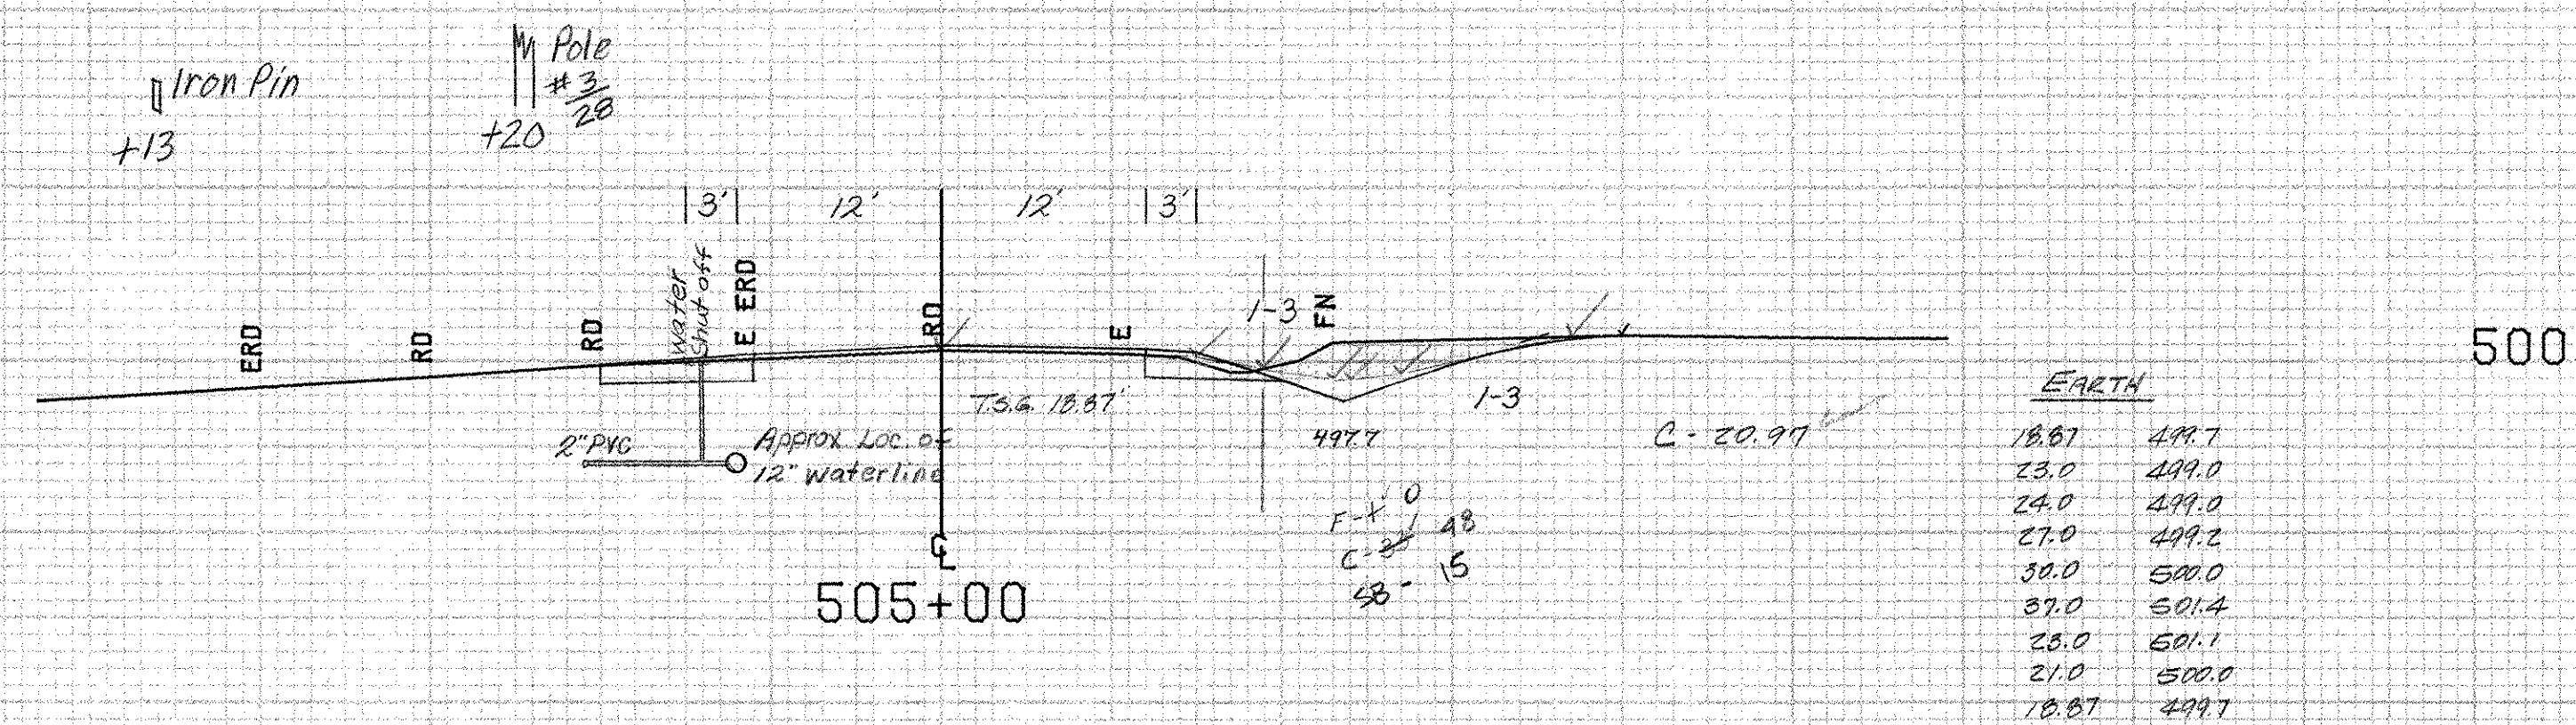

503+20 Rt
Begin Removing & Resetting Fence
Begin Temporary Barbed Wire Fence (4-strand)
BEGIN REMOVAL OF EXISTING FENCE (NON-PART.)

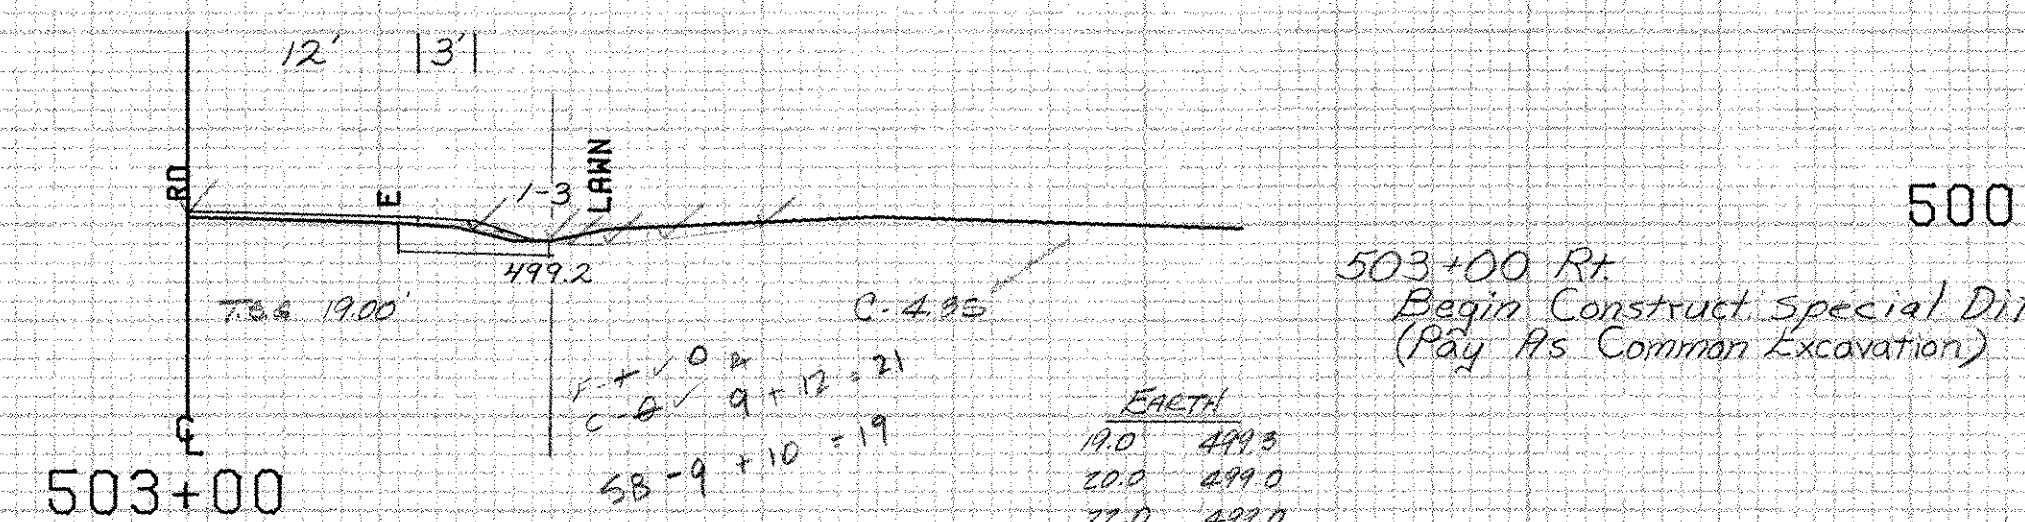

503+00 Rt
Begin Construct Special Ditch
(Ply As Common Excavation)

ADDISON MM 3.21 ~ MM 3.31

FROM STA.	503+00	TO STA.	505+00
PROJECT NAME	SHOREHAM-ADDISON MAIN		
NO.	F017-1(2)	PLOTTED	01/09/85
SURVEYED BY	FANTONI	DEC	1984
SHEET	410 OF 420 SHEETS	SHEET	410 OF 477

SCALE 1" = 10 FEET