

Durable 24" Stop Bar
 VT 17 West 10+19 Lt ✓
 VT 17 East 10+04 Lt ✓
 M 549+83 ~ 550+03 27' RT ✓

Durable Letter in Word Markings
 VT 17 West 10+28 Lt (STOP) ✓
 VT 17 East 10+13 Lt (STOP) ✓
 M 549+85 ~ 549+92 36' RT (STOP) ✓

Temporary 24" Stop Bar*
 VT 17 West 10+19 Lt
 VT 17 East 10+04 Lt
 *USED AS INTERIM MARKING ONLY

Temporary 4" White Line
 M 549+50 Lt ~ M 550+83 Lt
 M 550+10 Rt ~ M 550+93 Rt
 M 552+14 Lt ~ M 554+98 Lt
 M 552+36 Rt ~ M 555+00 Rt

Temporary 4" Yellow Line (DBL)
 M 549+00 Rt ~ 549+65 Rt
 M 551+80 Rt ~ 555+00 Rt
 VT 17 West 10+20 Lt ~ 12+00 Lt
 VT 17 East 10+05 Lt ~ 11+50 Lt
 M 550+05 Rt ~ 551+38 Rt
 M 549+83 28 Rt ~ 48' Rt






Durable 12" Yellow Lines
 M 551+91 Lt ~ 552+53 Lt (Island, as shown) ✓
 M 552+93 Lt ~ 553+18 Lt (Island, as shown) ✓

Durable 4" White Line
 M 550+93 Rt ~ Vt 17 East 10+50 Rt ✓
 Vt 17 East 10+50 Lt ~ 552+36 Rt ✓
 M 550+83 Lt ~ Vt 17 West 10+65 Rt ✓
 Vt 17 West 10+50 Lt ~ 552+14 Lt ✓

Painted Curb
 VT 17 East 10+50 Lt ~ M 552+33 Rt ✓

M 552+74 Rt ~ 553+06 Rt (Island) ✓
 M 553+46 Rt ~ 553+75 Rt ✓
 M 553+58 Lt ~ 554+07 Lt (Island) ✓

* YELLOW, PAINT ALL AROUND.

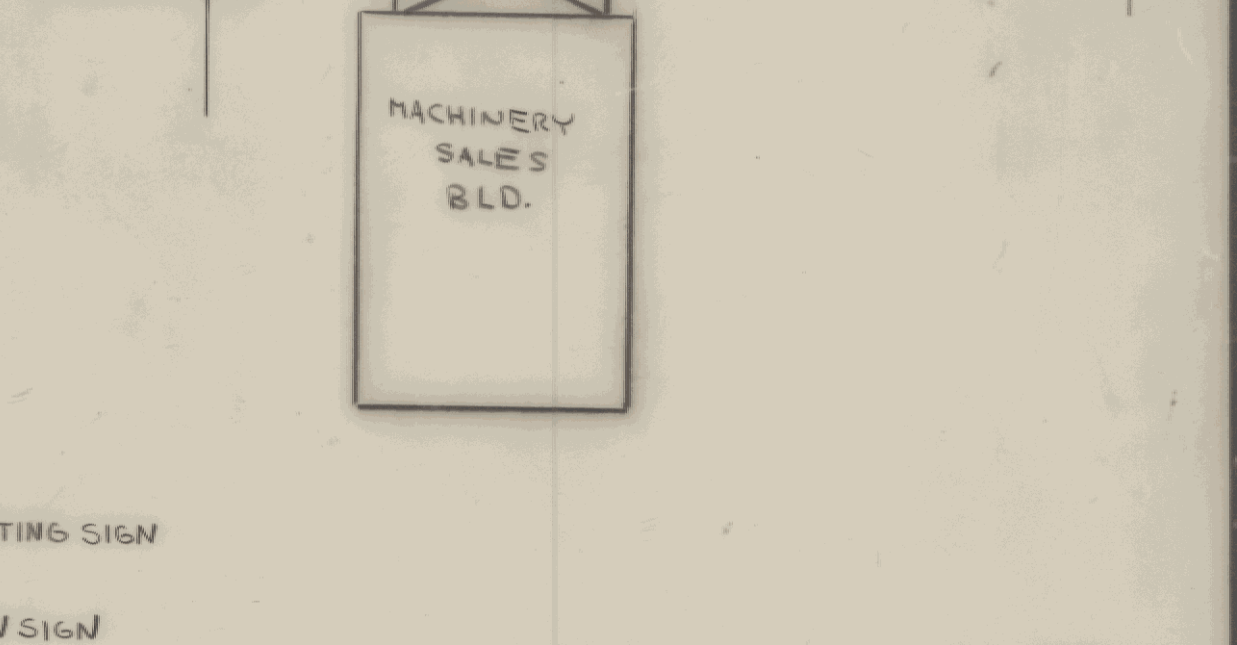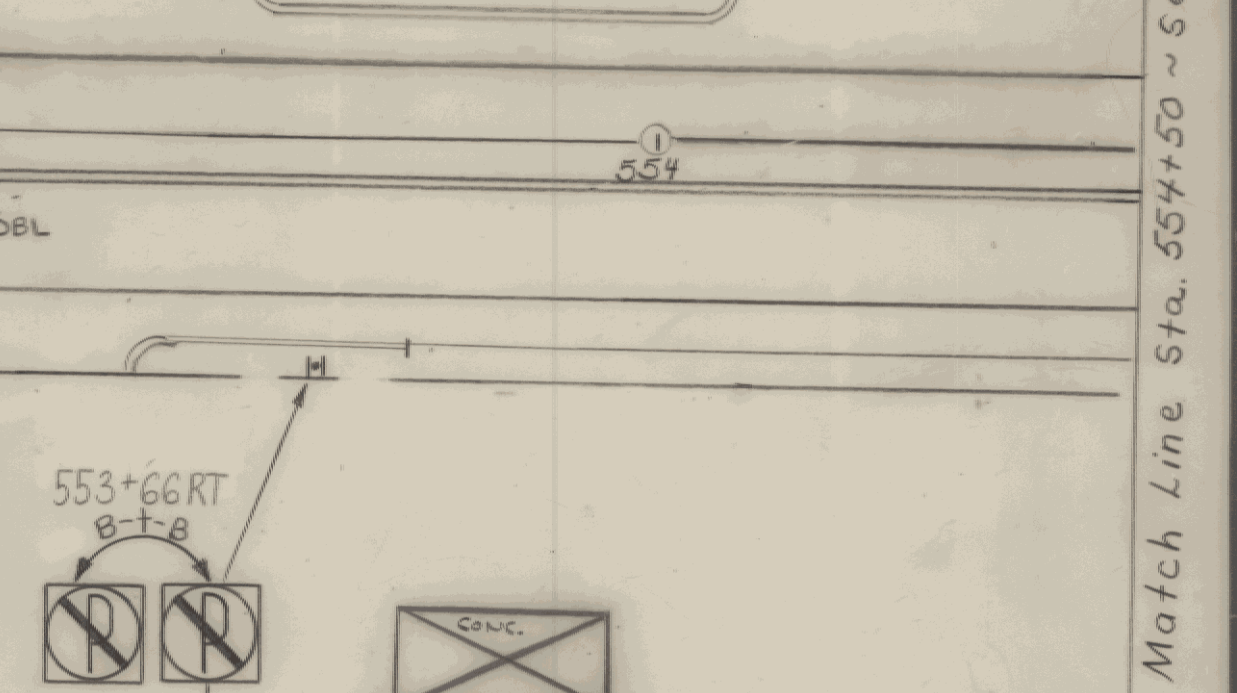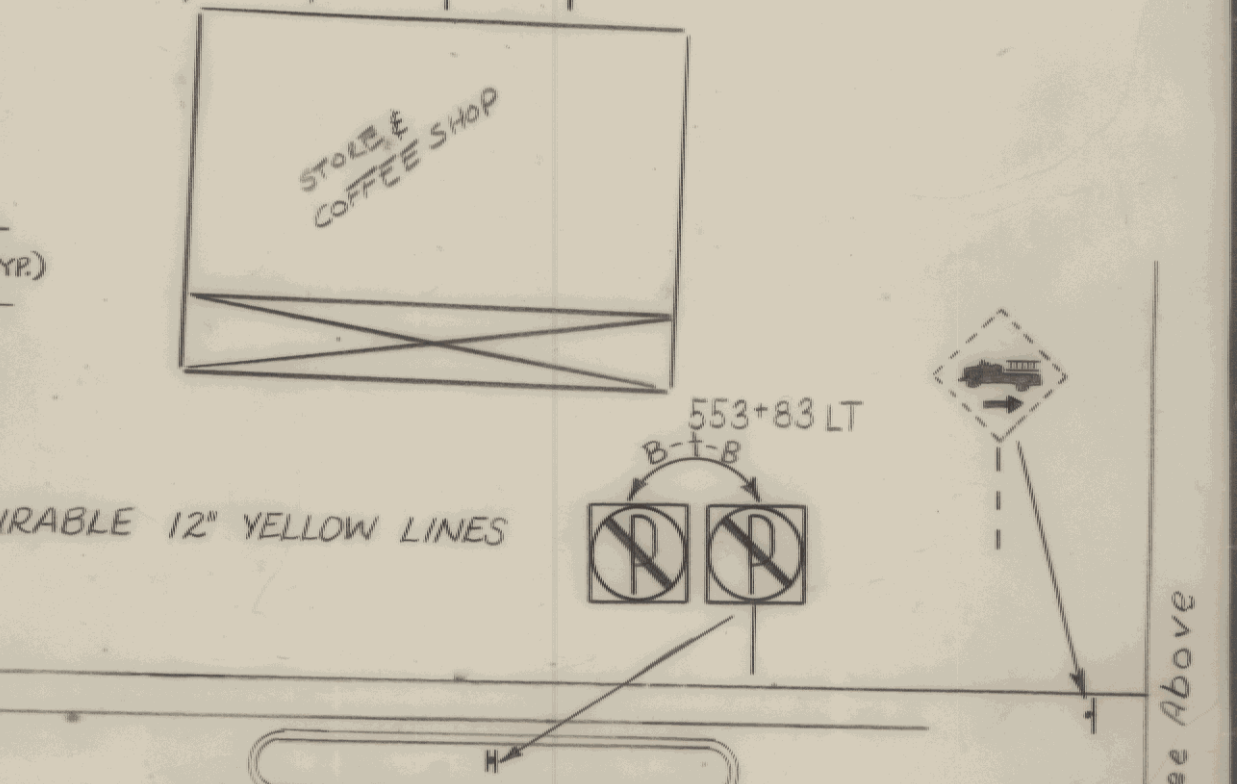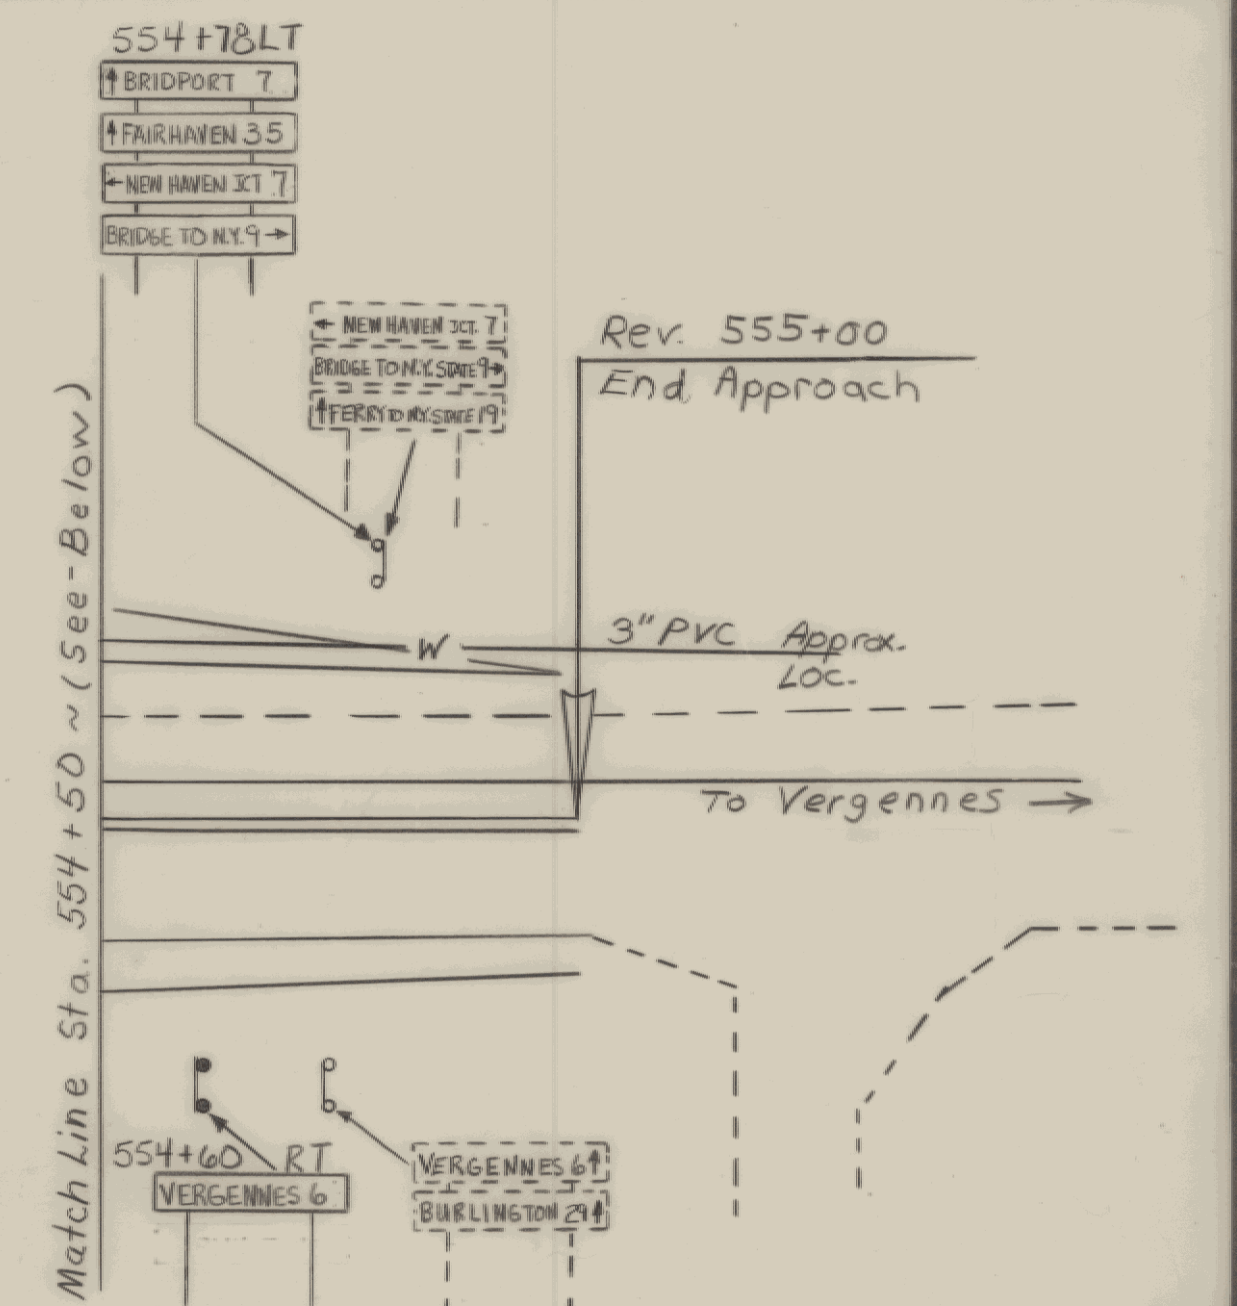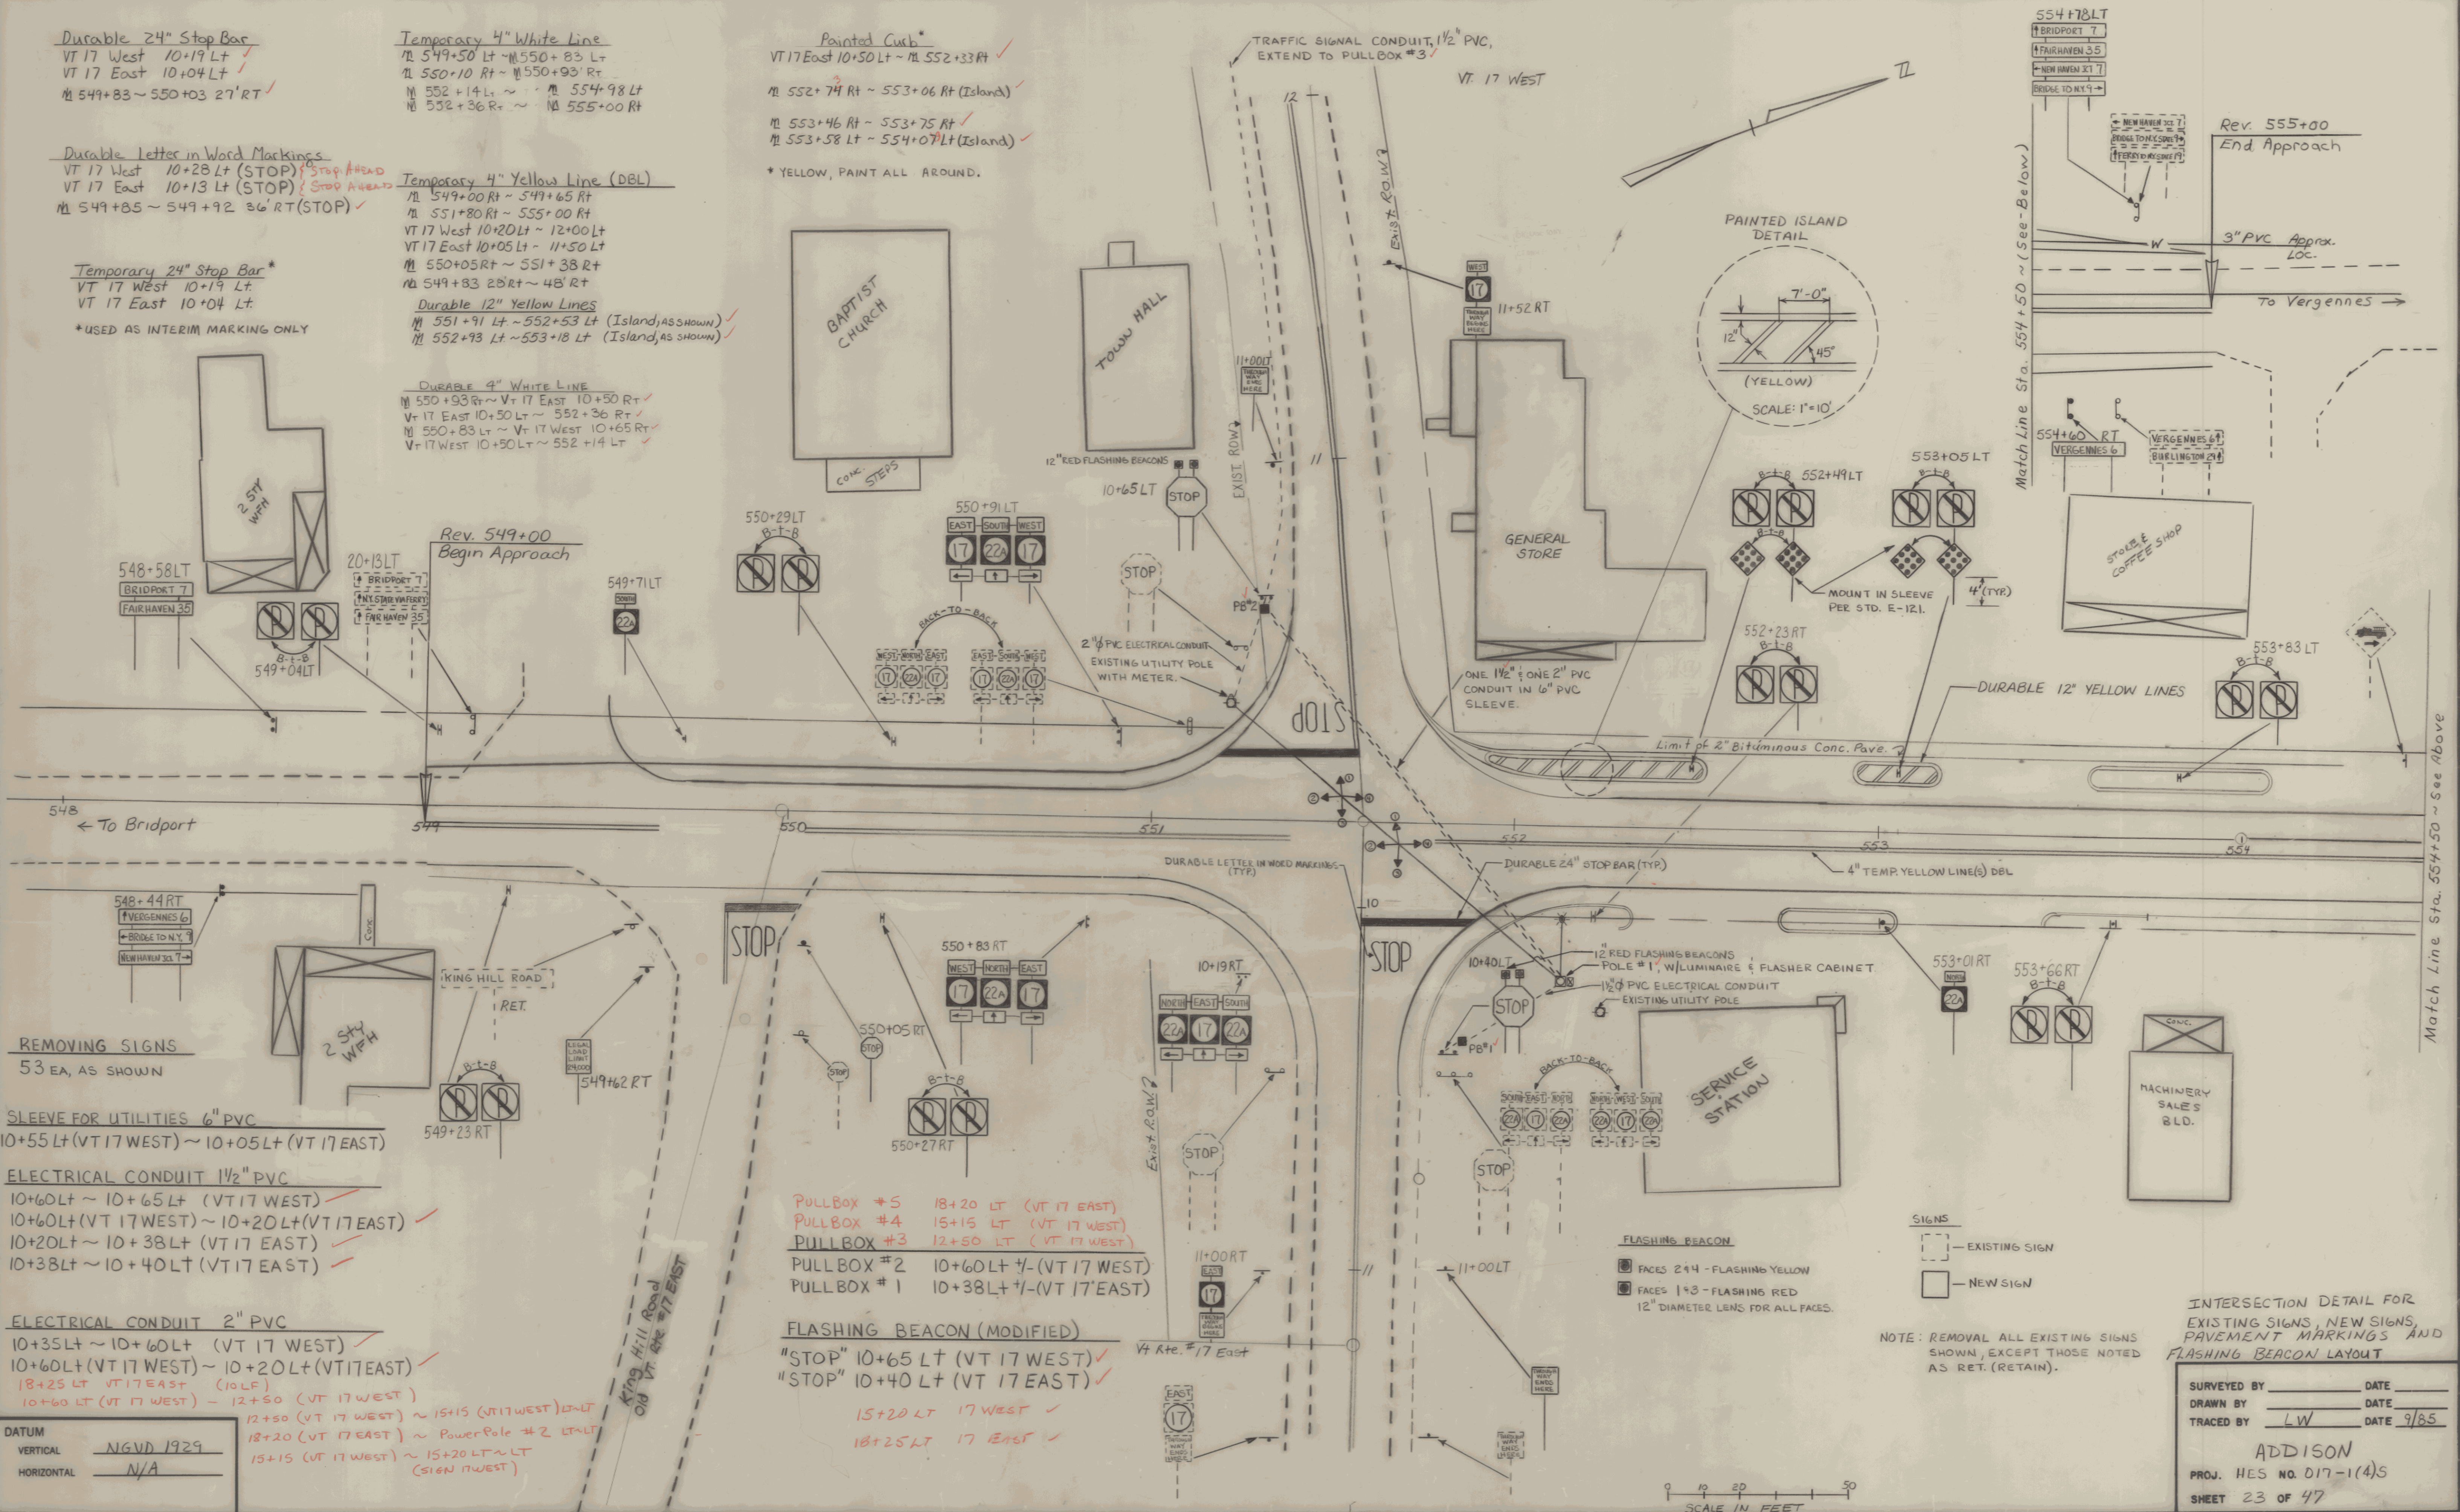

INTERSECTION DETAIL FOR
 EXISTING SIGNS, NEW SIGNS,
 PAVEMENT MARKINGS AND
 FLASHING BEACON LAYOUT

SURVEYED BY _____ DATE _____
 DRAWN BY _____ DATE _____
 TRACED BY LW DATE 9/85

ADDISON
 PROJ. HES NO. 017-1(4)S
 SHEET 23 OF 47

SHEET 453 OF 477