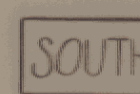
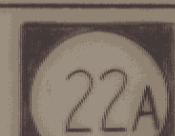
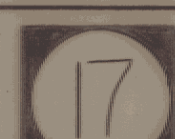
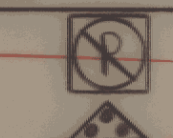
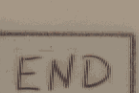
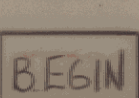


TRAFFIC SIGN SUMMARY SHEET

TRAFFIC SIGN SUMMARY SHEET

MILEMARKER, STATION, OR SIGN NUMBER	SIGN LEGEND	EXISTING SIGNS			NEW AND SALVAGED SIGNS				EXISTING POSTS				NEW SIGN POSTS																REMARKS	PLAN SHEET NUMBER	STD. SHEET NUMBER	
		SIGN DIMENSIONS	SALV. REM.	RET.	"A"	"B"	SALV. SIGN	SALV. T.I.S.	RET.	DRILL	REM.	SALV.	NUMBER OF POSTS	FLANGED CHANNEL LB./FT.			TUBULAR ALUMINUM				TUBULAR STEEL				W SHAPED STEEL		FTG. SIZE					SIGN FRAME
														2.0	2.5	3.0	3.0"Ø	3.0"Ø	4.0"Ø	4.0"ØM.	3"Ø	3.5"Ø	4.0"Ø	5.0"Ø	POST SIZE	WEIGHT	24"	30"				
549+71 LT.	 	24x12 30x24			2.00 5.00								1			12 X															E-136	
550+27 RT.	 	24x24 24x24			4.00 4.00								1			12 X													MOUNT BACK-TO-BACK		E-143	
550+29 LT.	 	24x24 24x24			4.00 4.00								1			12 X													MOUNT BACK-TO-BACK		E-143	
550+05 RT.		30x30			6.25								1			12 X															E-143	
550+83 RT.	WEST  	24x12 24x24 21x15			2.00 4.00 2.19								2																		E-136	
550+83 RT.	NORTH  	24x12 30x24 21x15			2.00 5.00 2.19												16 X 16											X			"	
550+83 RT.	EAST  	24x12 24x24 21x15			2.00 4.00 2.19																										"	
550+91 RT.	EAST  	24x12 24x24 21x15			2.00 4.00 2.19																										"	
550+91 RT.	SOUTH  	24x12 30x24 21x15			2.00 5.00 2.19								2				18 X 18											X			"	
550+91 RT.	WEST  	24x12 24x24 21x15			2.00 4.00 2.19																										"	
552+49 LT.	 	24x24 24x24 18x18 18x18			4.00 4.00 2.25 2.25								+				X												MOUNT SIGNS AND HAZARD MARKERS BACK-TO-BACK. PLACE IN SLEEVE AS SHOWN ON STD. E-121		E-143 E-150	
552+23 RT.	 	24x24 24x24			4.00 4.00								1				12 X												MOUNT BACK TO BACK		E-143	
553+01 RT.	NORTH 	24x12 30x24			2.00 5.00								1				12 X														E-136	
553+66 RT.	 	24x24 24x24			4.00 4.00								1				12 X												MOUNT BACK TO BACK		E-143	
553+83 LT.	 	24x24 24x24			4.00 4.00								1				12 X												MOUNT BACK TO BACK		E-143	
554+60 RT. 554+78 LT.	(SEE SHEET 26)																															
556+48 RT.	 	24x24 24x12			4.00 2.00								1				14 X														E-143 E-140	
556+48 LT.	 	24x24 24x12			4.00 2.00								1				14 X														E-143 E-140	
FINAL POST LENGTHS ARE TO BE DETERMINED IN THE FIELD. POST SIZES ARE COMPUTED BASED ON INFORMATION FURNISHED ON THE STANDARD SHEETS AND THE DESIGN DIVISION'S "SIGN POST DESIGN MANUAL".		TOTALS		EA.		SF.	SF.	EA.	SF.								411 372	121.6 129.2													PREPARED BY <u>DM</u> DATE <u>04/29</u> CHECKED BY <u>DSP</u> DATE <u>06/29</u> DESIGN SUPERVISOR <u>DATE</u> PROJ. ADDISON HES 017-1(4)S TRAFFIC SHEET NO. <u>OF</u> SHEET <u>25</u> OF <u>47</u> SHEETS SUMSHEETS	

553+05 LT
SEE
SHT. 26