




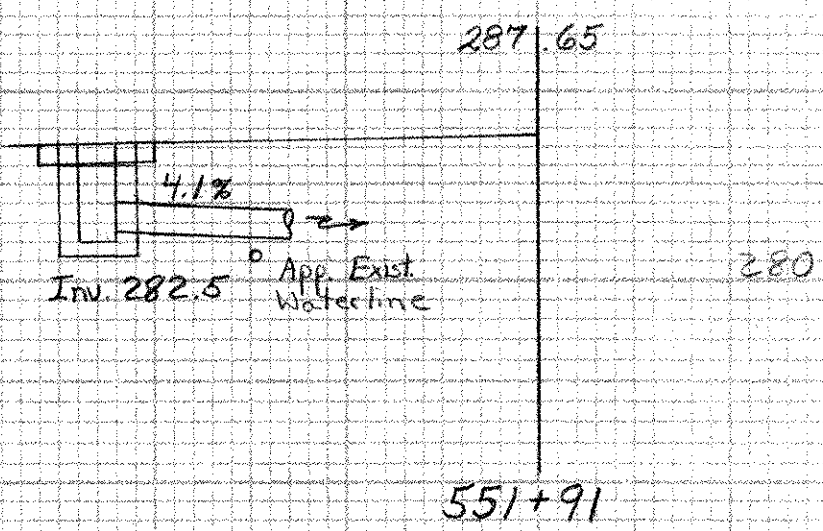

Rev. 551+90 Lt ~ 552+05 Rt.
New 18" x 42' PCCSP (.064), CAPP (.060)
or RCP, Class III Option w/ New RCDI &
C.I. Grate w/ Frame, Type D.

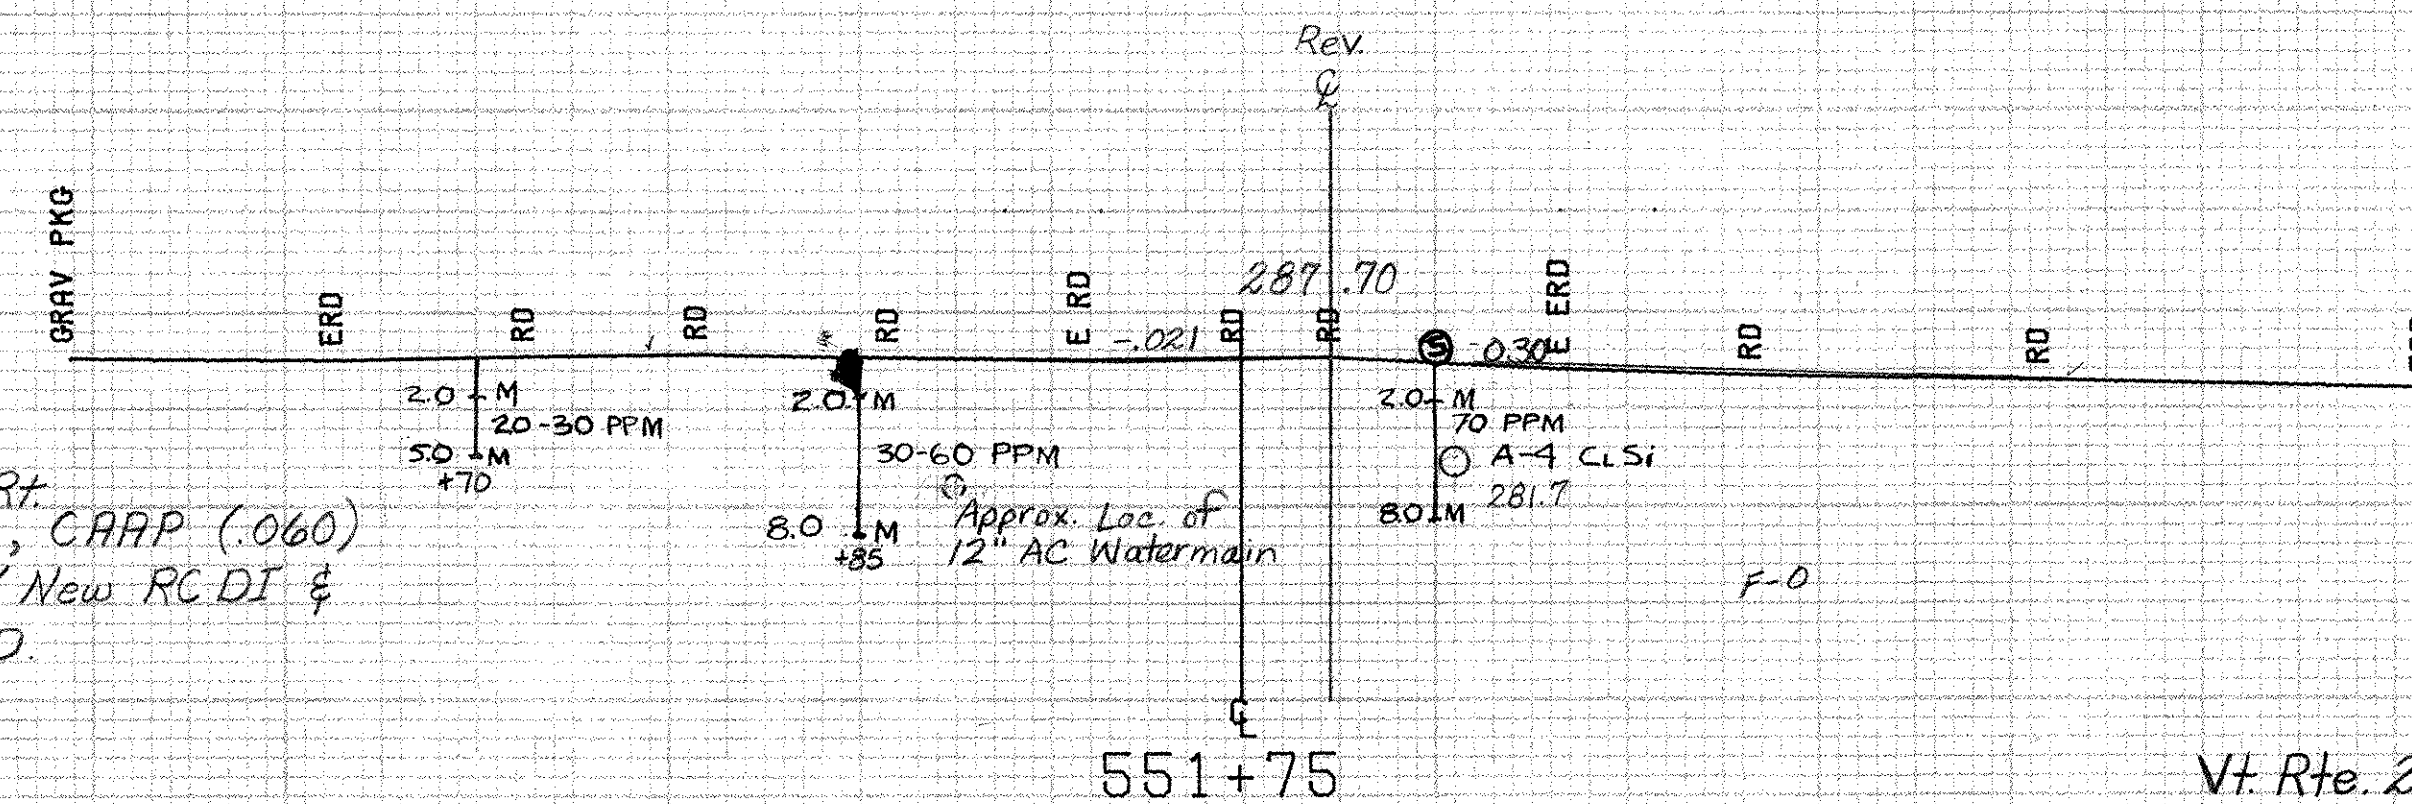


Vt. Rte. 22A Surv. P.T. $551 + 58.44 =$
Vt. Rte. 17 (west) P.O.T. $10 + 00.00 =$
Vt. Rte. 17 (east) P.O.T. $9 + 76.76$

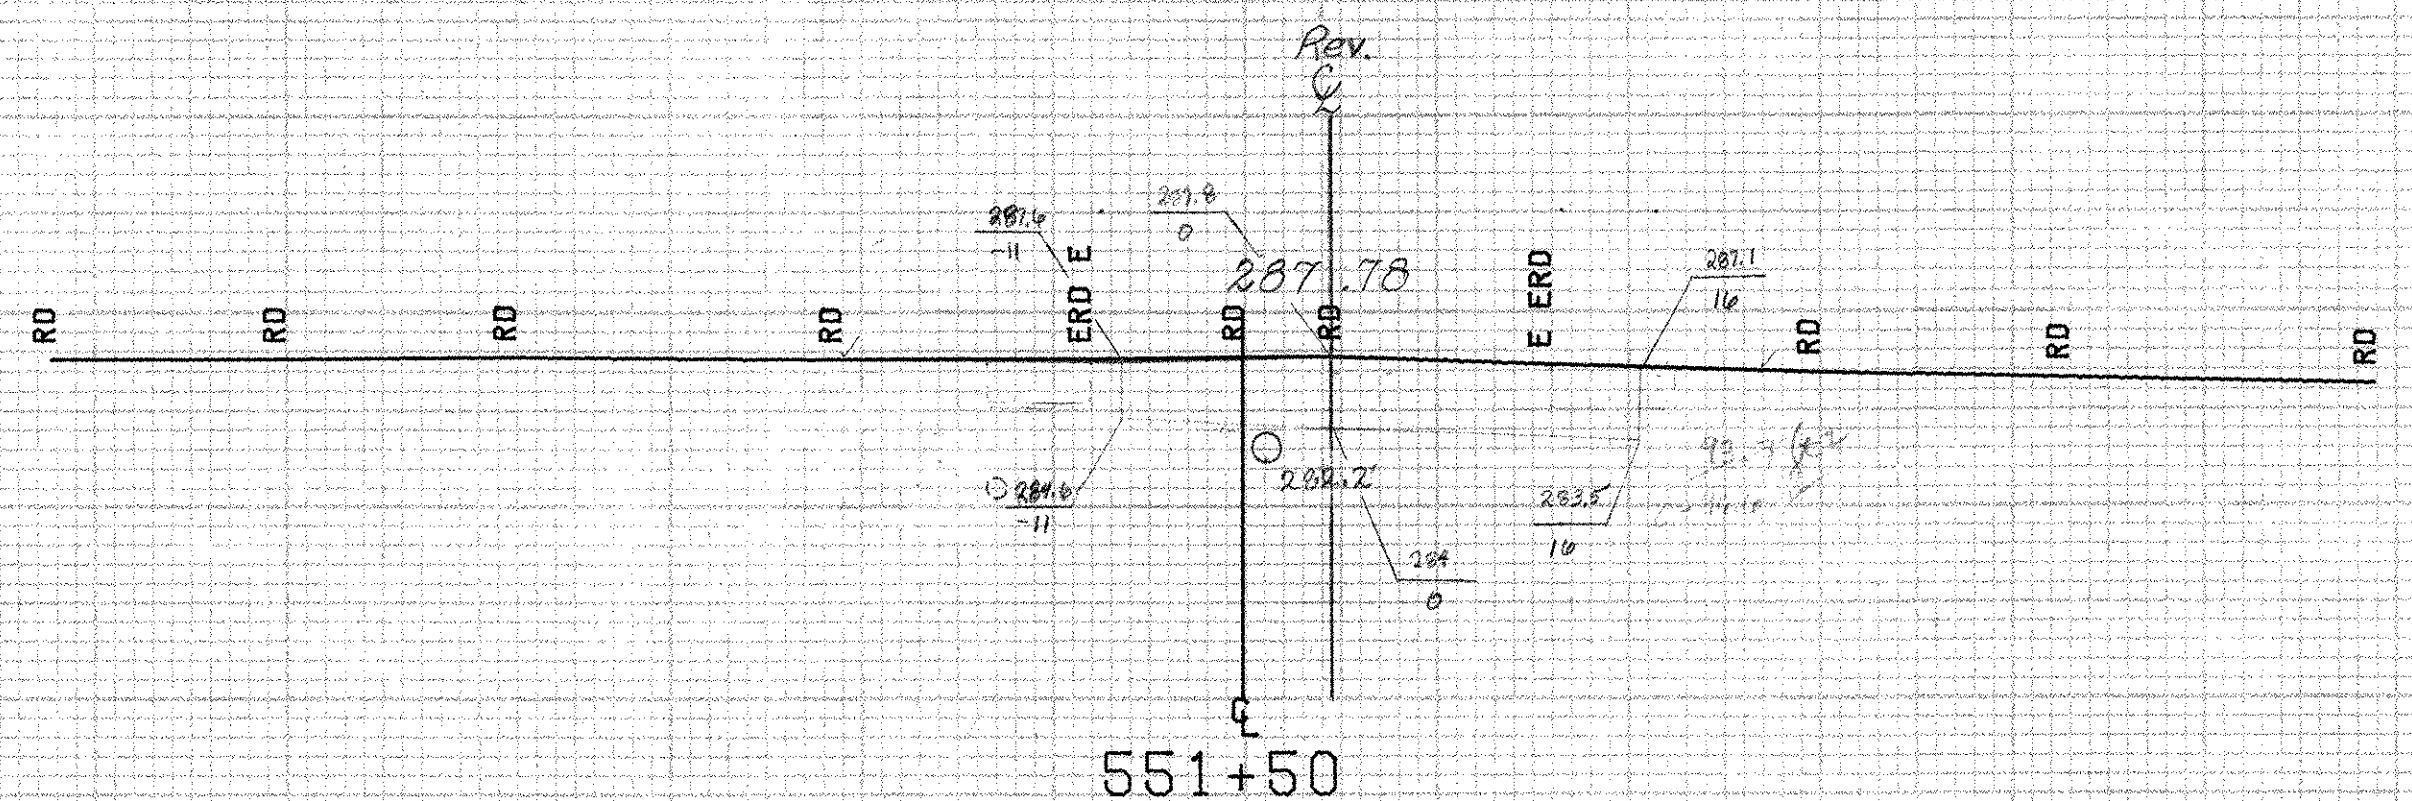

SOA F817-1(2)

SB	RT	
	LT	1/2" x 8" x 1/2" x 1/2"
SAND	RT	
	LT	

28

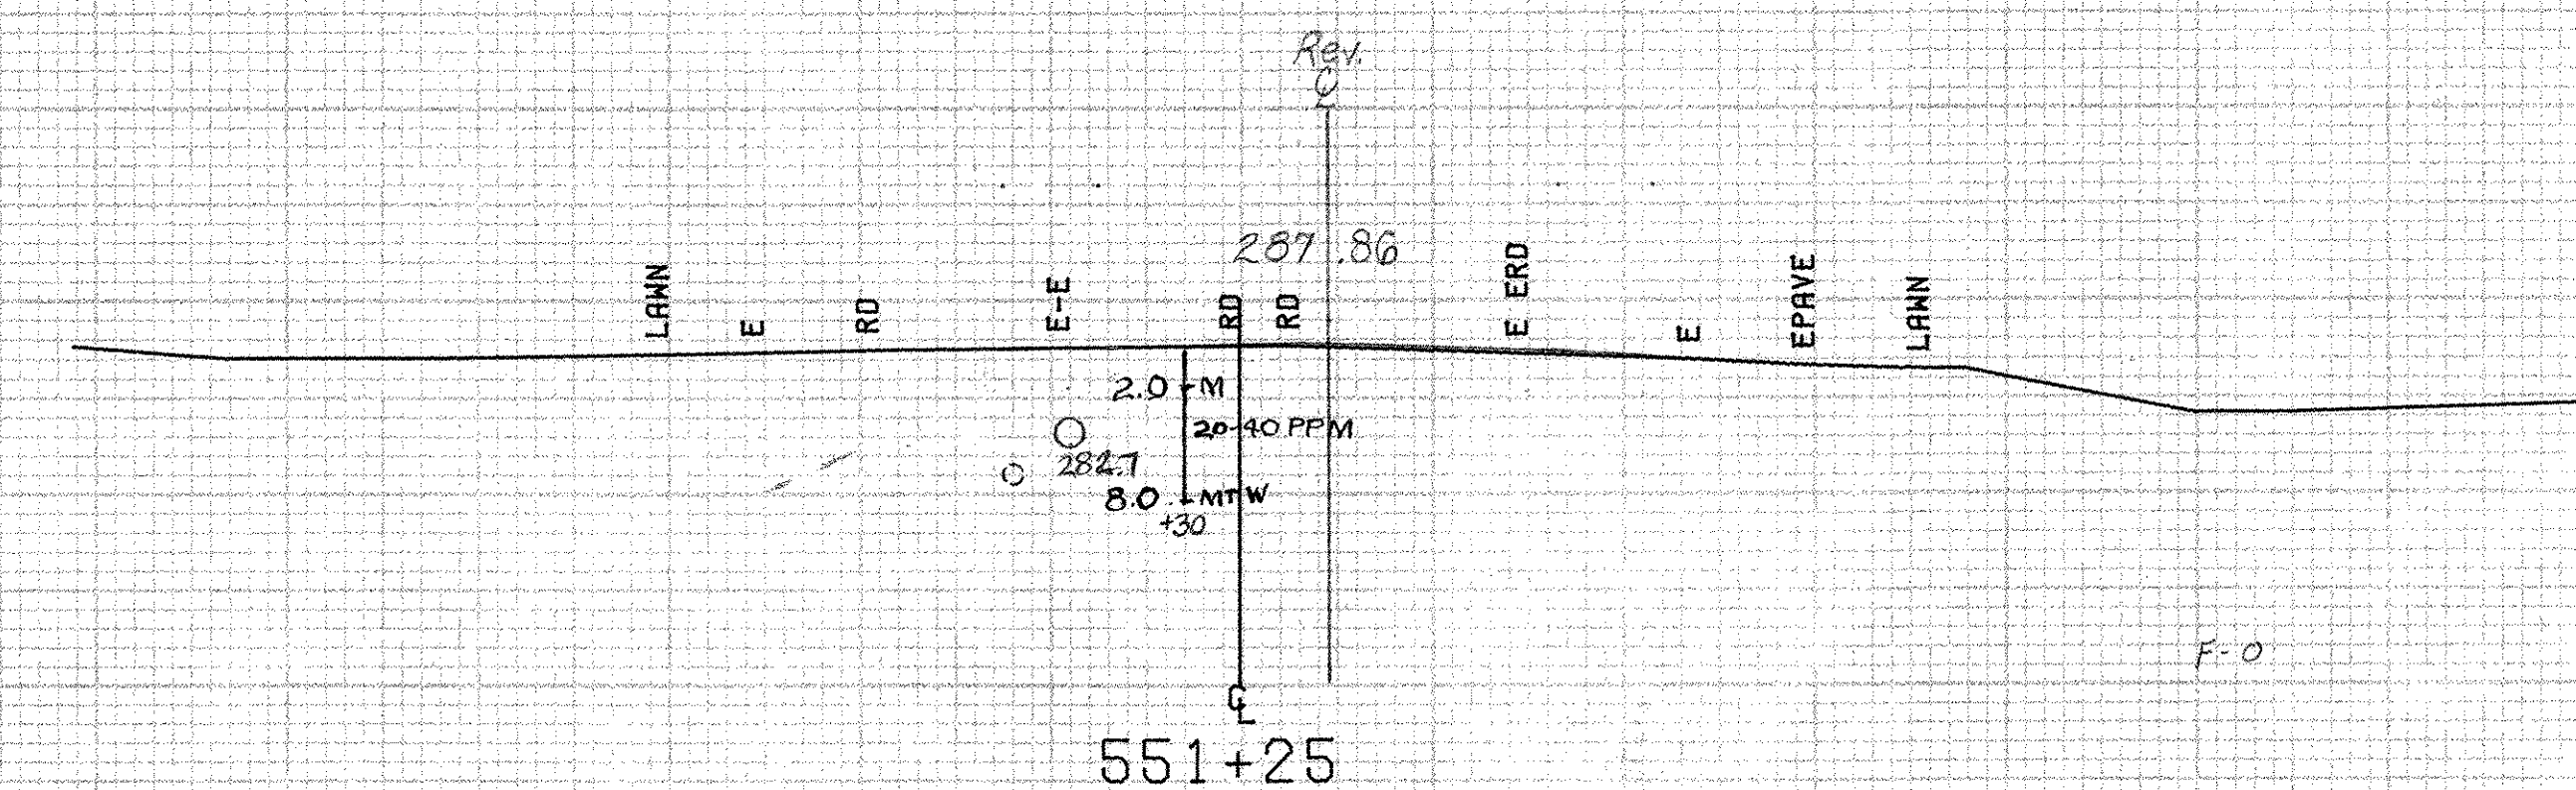

Rev. 551+00 Lt. ~552+05 Rt
New 21"x15"x112" PCCSPA (.064) or
CAAPA (.060) Option w/ New RCDI
& C.I. Grate w/ Frame, Type D

HES OUT-104 ₁₆		
LT		RT
-12	285.0	79
-18	285.14	10.5
-18	28.7	12.5
-20	28.7	18
-22	295.13	
-25	289.8	
-26	287.3	
-32	281.5	

[illegible]

SBA FOIT (KZ)
 SB - RT -
 LT -
 SBA RT -
 LT -

28

551+00
Rev. 551+00
End Box Cut at edges of Exist. Pavement

SHEET 469 OF 477

FROM STA. 551+00	TO STA. 551+75
PROJECT NAME	ADDISON VT22A
NO.	HES017-1(4)S
SURVEYED BY	FANTONI
SHEET 39	OF 42 SHEETS

PLOTTED 11/29/84
SEPT 1984

10 FEET