


HES 017-1(4)S

LT	RT
-11.5 284.9	18 284.9
-11.5 284.9	11.5 285
-15.5 286.6	11.5 287
-11.5 287.1	18 289.9

C=1.75



554+20 LT
Existing 8" CMP ~ Remove
(SHALL BE REMOVED BY COMMON EXCAVATION)
Rev. 554+20 LT
Construct Drive (Gravel) (16' Wide)

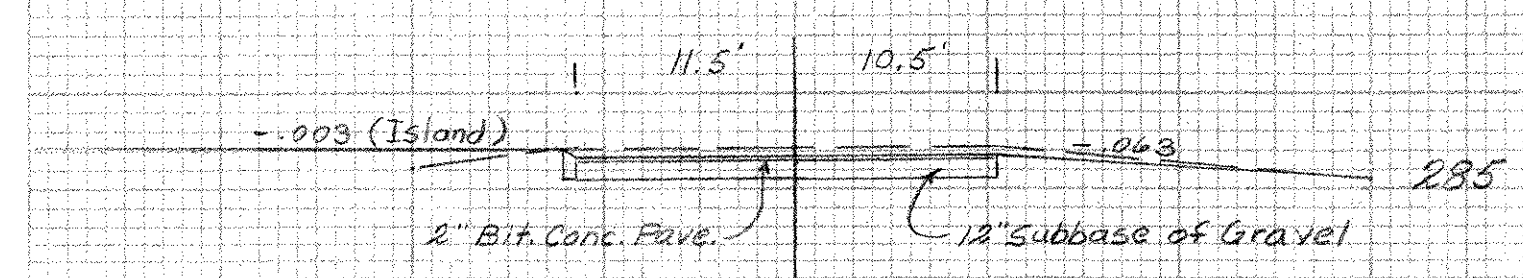

554+00





LT	HES 017-1(4)S	RT
-20 285.4		
-22 285.4		
-23 286.7		
-20 285.8		
-12 285.5		
-10 289.8	19 289.7	
-19 286.7	11.5 287.8	
-19 286.8	11.5 286.8	
-14.5 286.8	19 289.8	
-10 287		

C=11.02

Approx. Loc. of
Exist. 3" PVC
Water Line
Inv. 282.0
4"x4" D.I.

Rev. 554+04 LT
New 2" ~ 28.6 Inch Underdrain
Stubs for Future Project Connection.
Plug As Directed by Engineer in
The Field.

Rev. 554+09 LT
End Cast-in-Place Cement Concrete Curb,
Type A (Island)

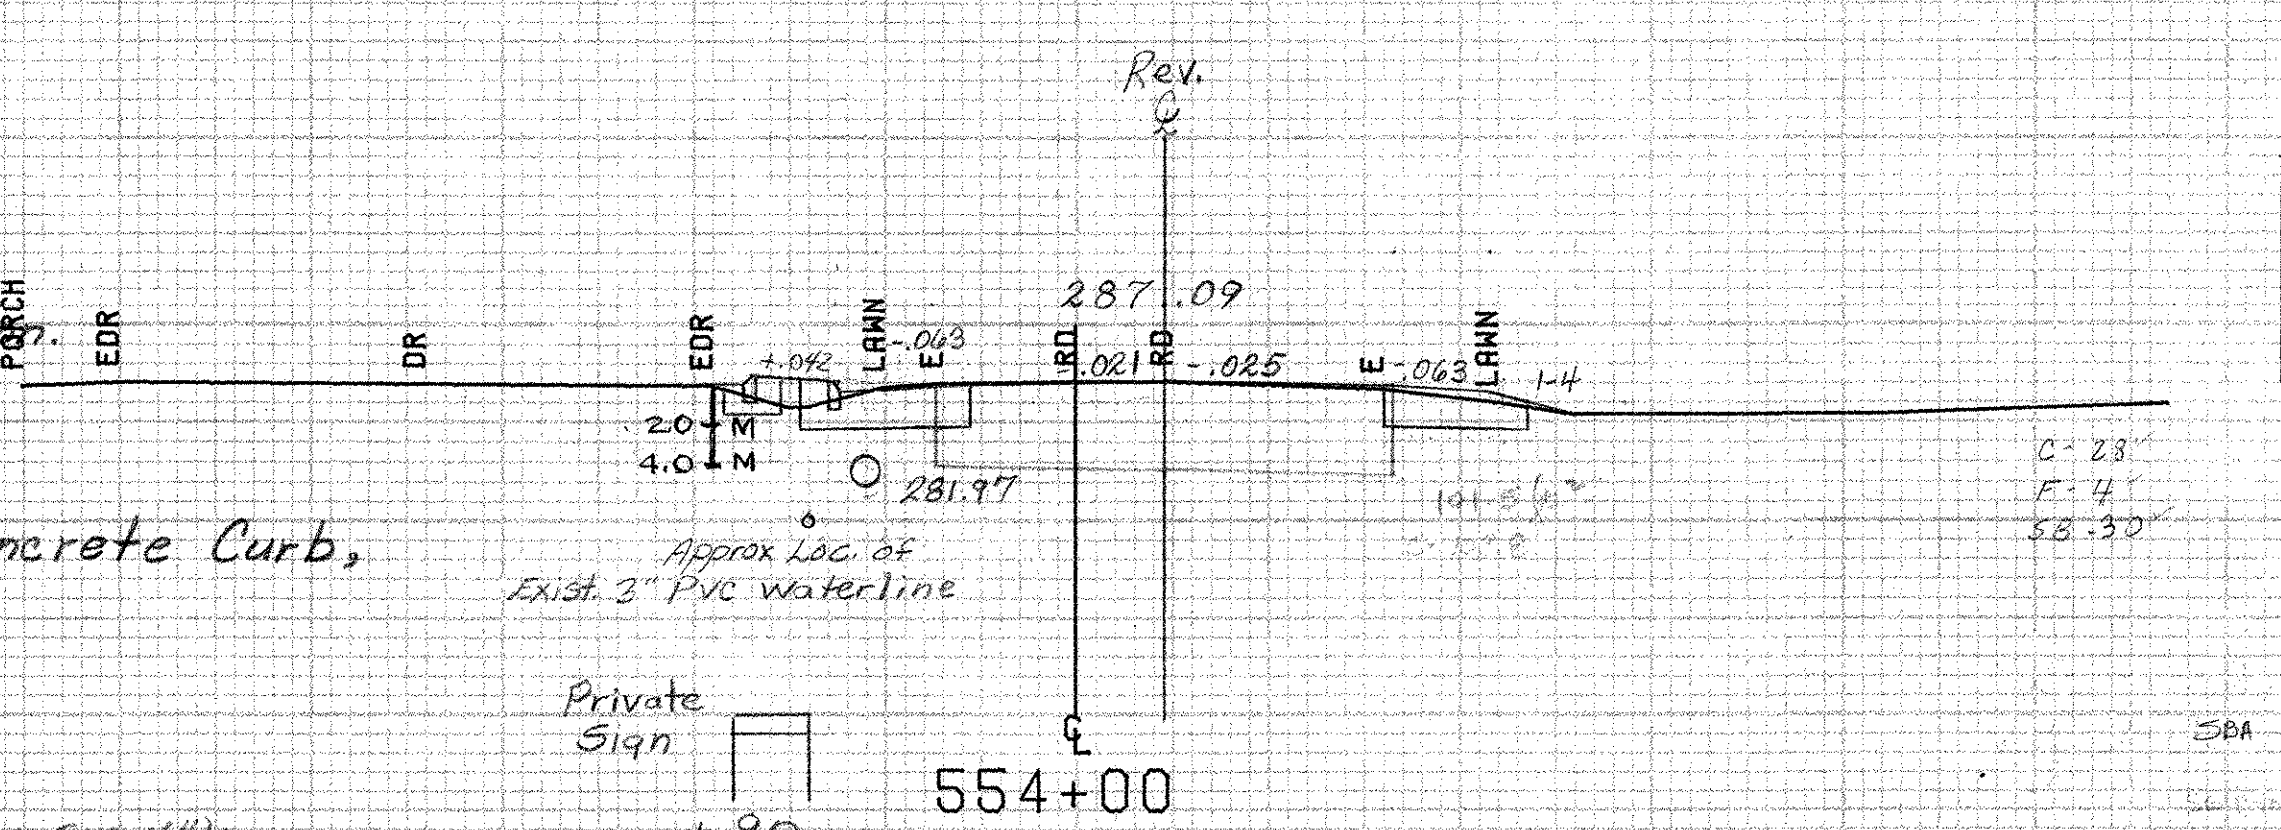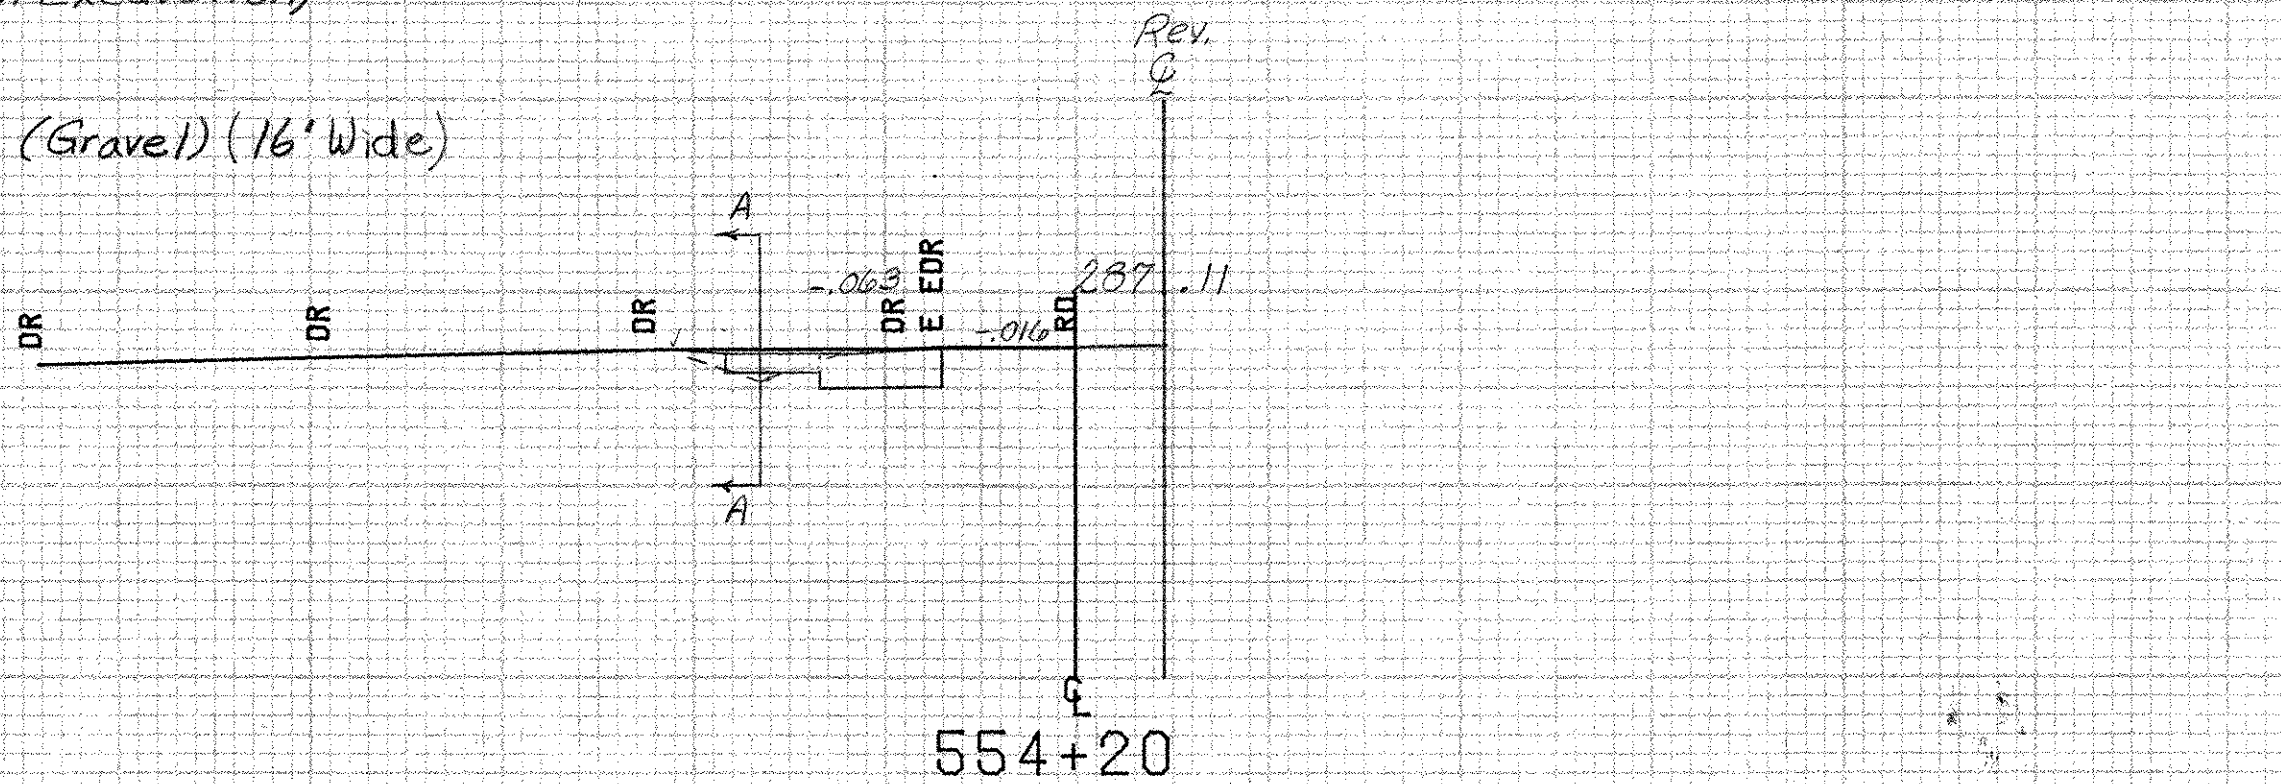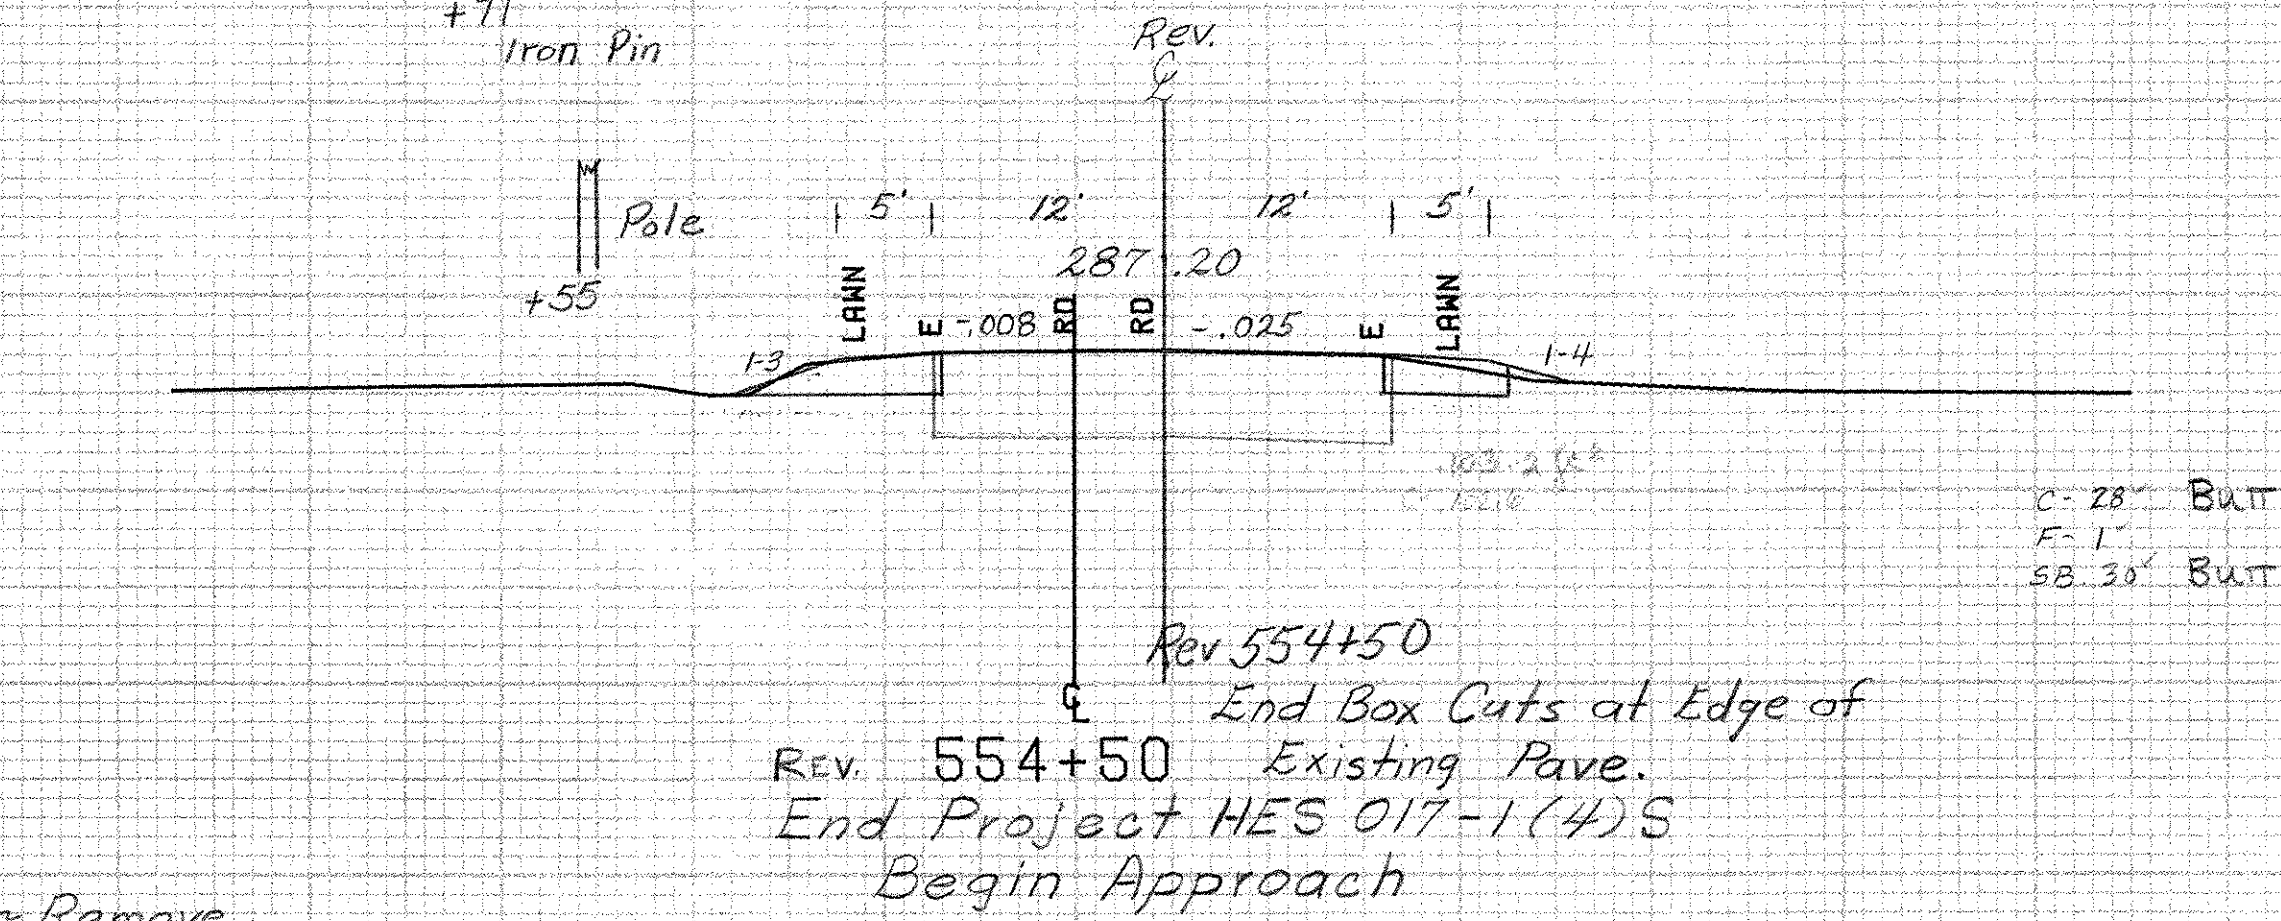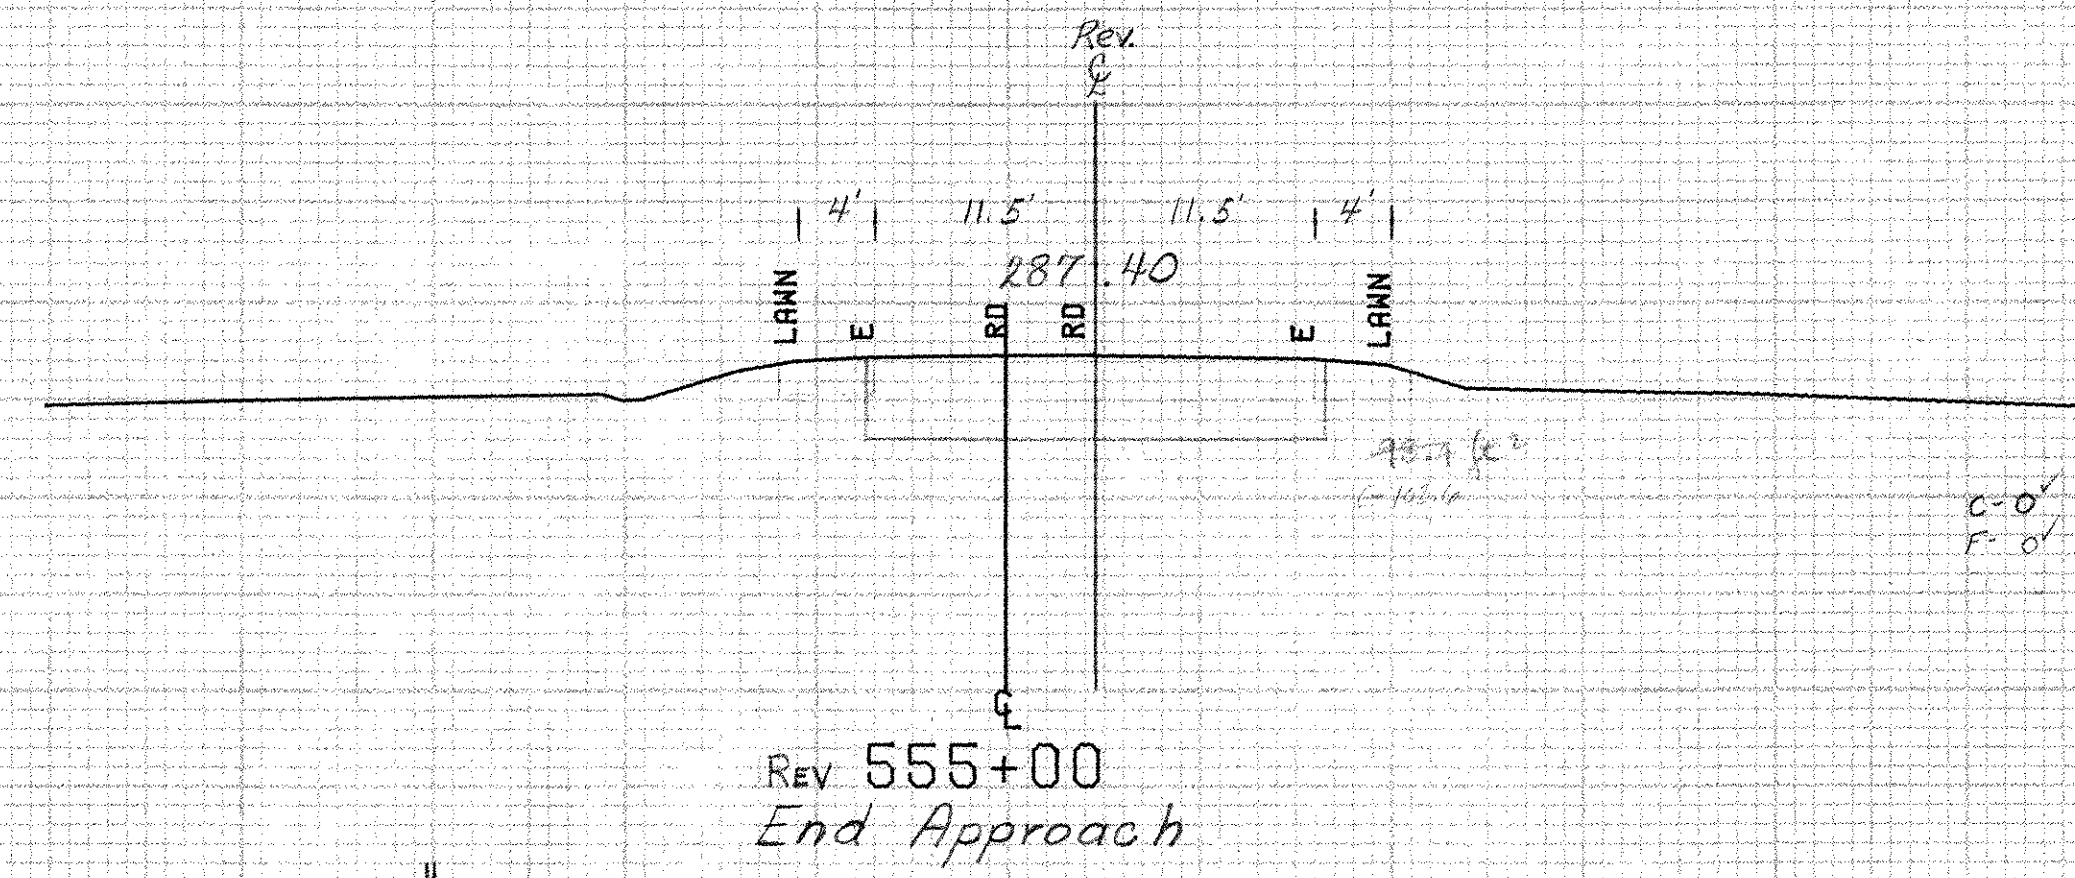

SBA F017-1(2)

SB	RT	285.4
LT	285.4	
SB	RT	286.6
LT	286.6	

FOOT-1(2)
ROADWAY CHECK

12	283
0	283
-12	283
-12	283.2
0	287.4
12	287.1

SBA F017-1(2)

SB	RT	285.4
LT	285.4	
SB	RT	286.6
LT	286.6	

FOOT-1(2)
ROADWAY CHECK

12	283.5
0	283.4
-12	282.7
-12	287.1
0	287.2
12	286.8

SBA F017-1(2)

SB	RT	285.4
LT	285.4	
SB	RT	286.6
LT	286.6	

FOOT-1(2)
ROADWAY CHECK

12	282.2
0	282.7
-12	282.9
-12	282.7
0	287.7
12	286.7

SBA F017-1(2)

SB	RT	285.4
LT	285.4	
SB	RT	286.6
LT	286.6	