


FINAL SURVEY NOTE BOOK No.	BY	DATE
	REVIEWED PLOTTED TEMPERATURE AREAS CHECKED	

ORIGINAL SURVEY NOTE BOOK No.	BY	DATE
	REVIEWED PLOTTED TEMPERATURE AREAS CHECKED	

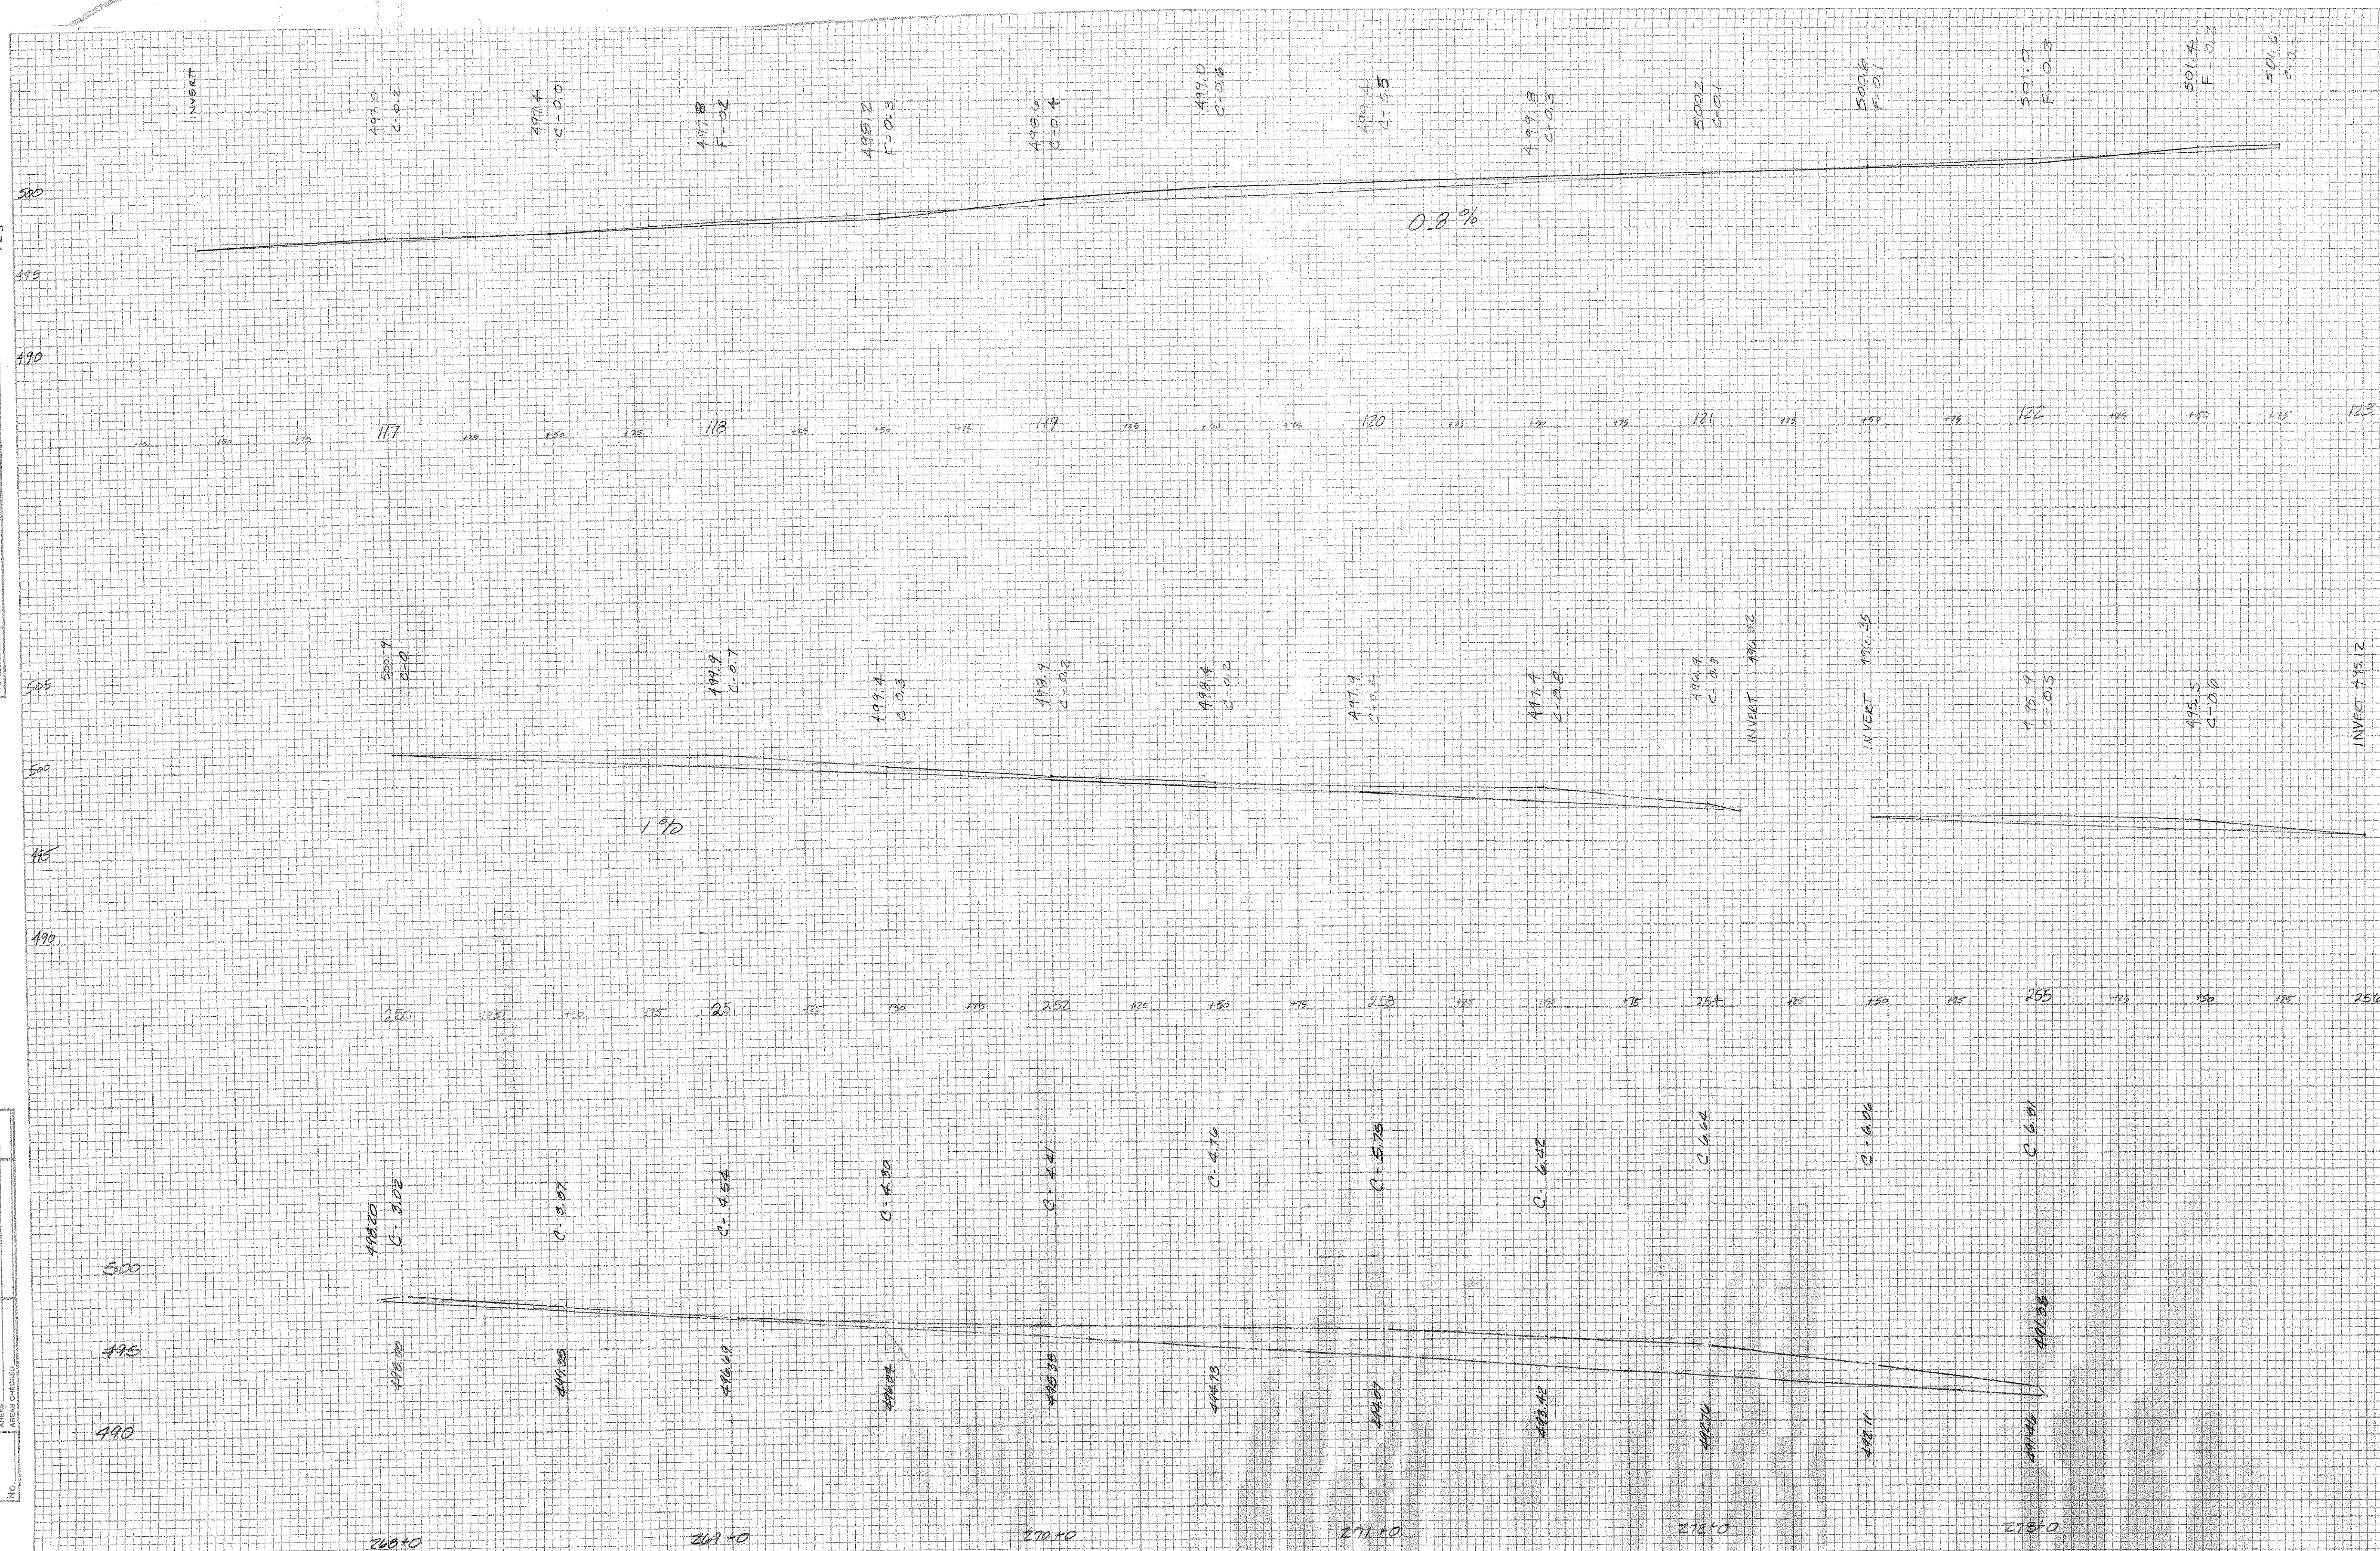

STRENNAM - BRIDPORT - HADEN
F 017-1(2)
DITCH PROFILES