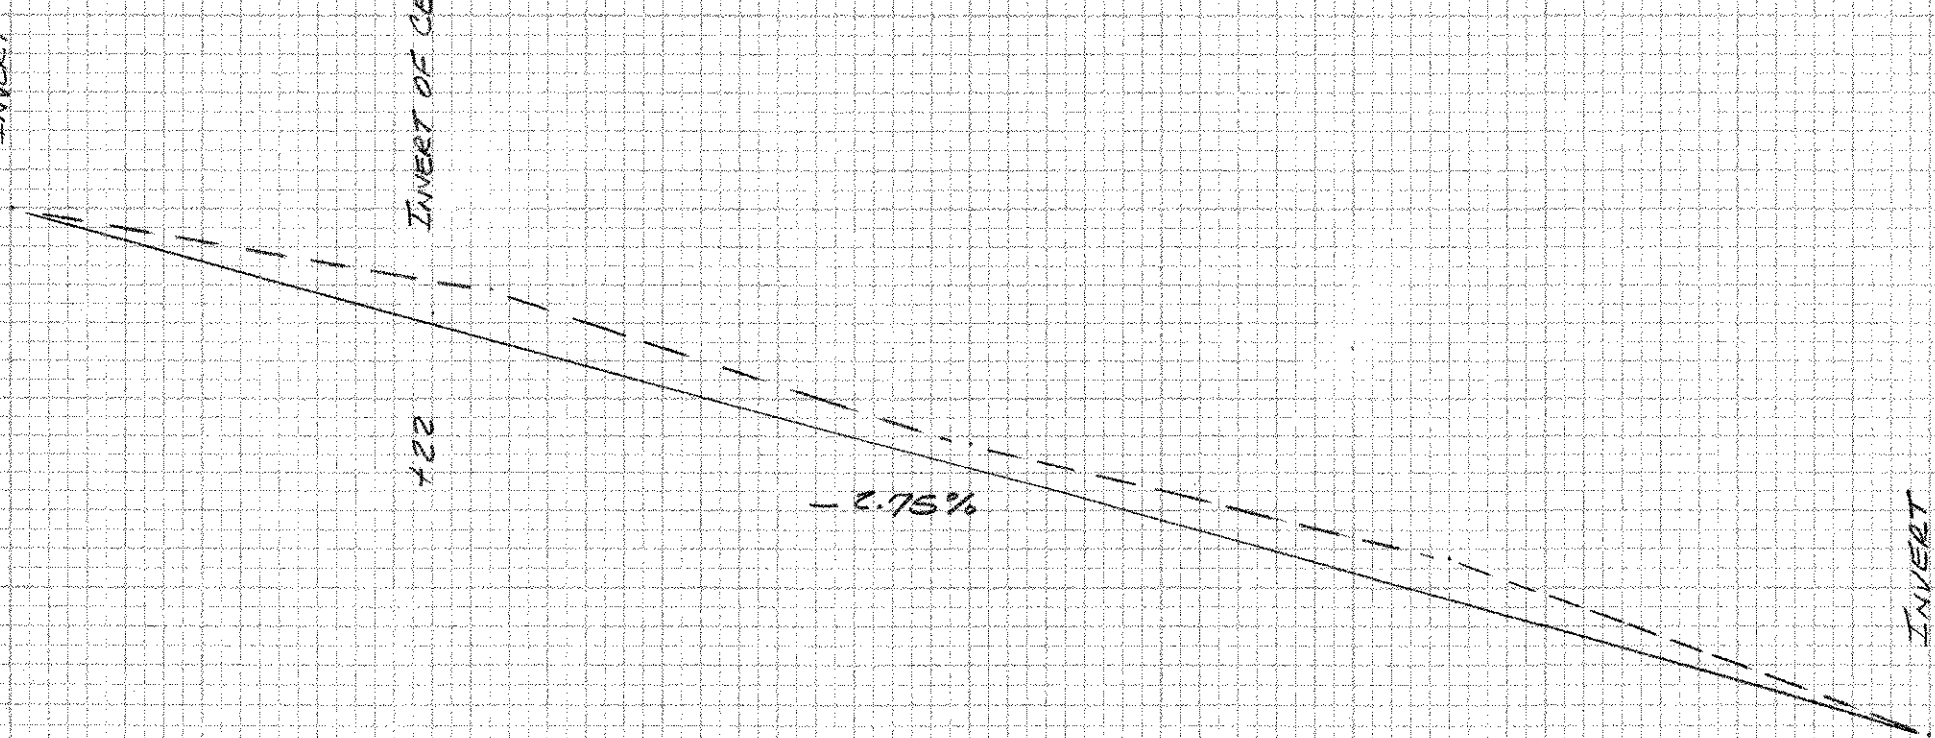
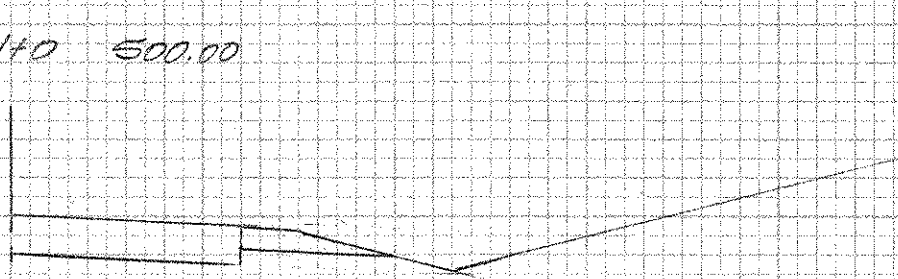
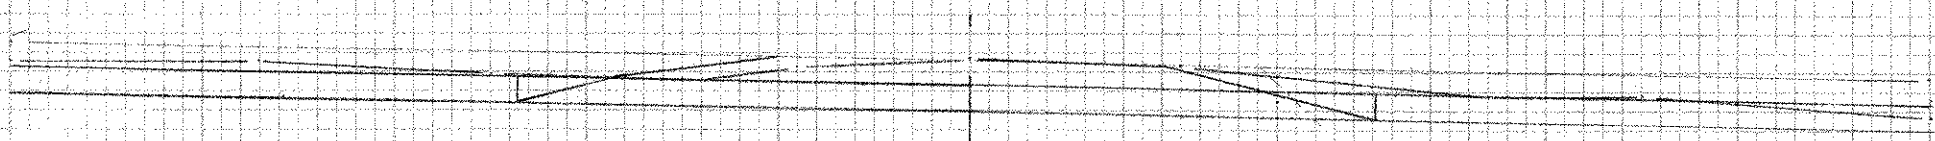
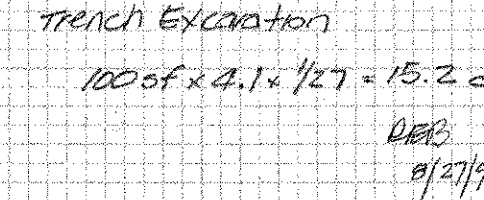
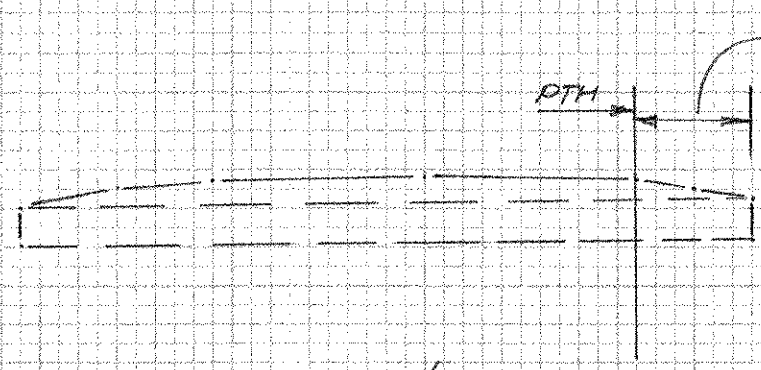


BK 2 p 47

$$2143f \times 4.1 \times 1/27 = 32.5$$

BRIDPORT
HES F 017-112

AMERICAN TRAVEL BOOK	NAME	DATE
BOOKED		
RECEIVED		
LIBRARY		
NAME		
NUMBER CHECKED		