
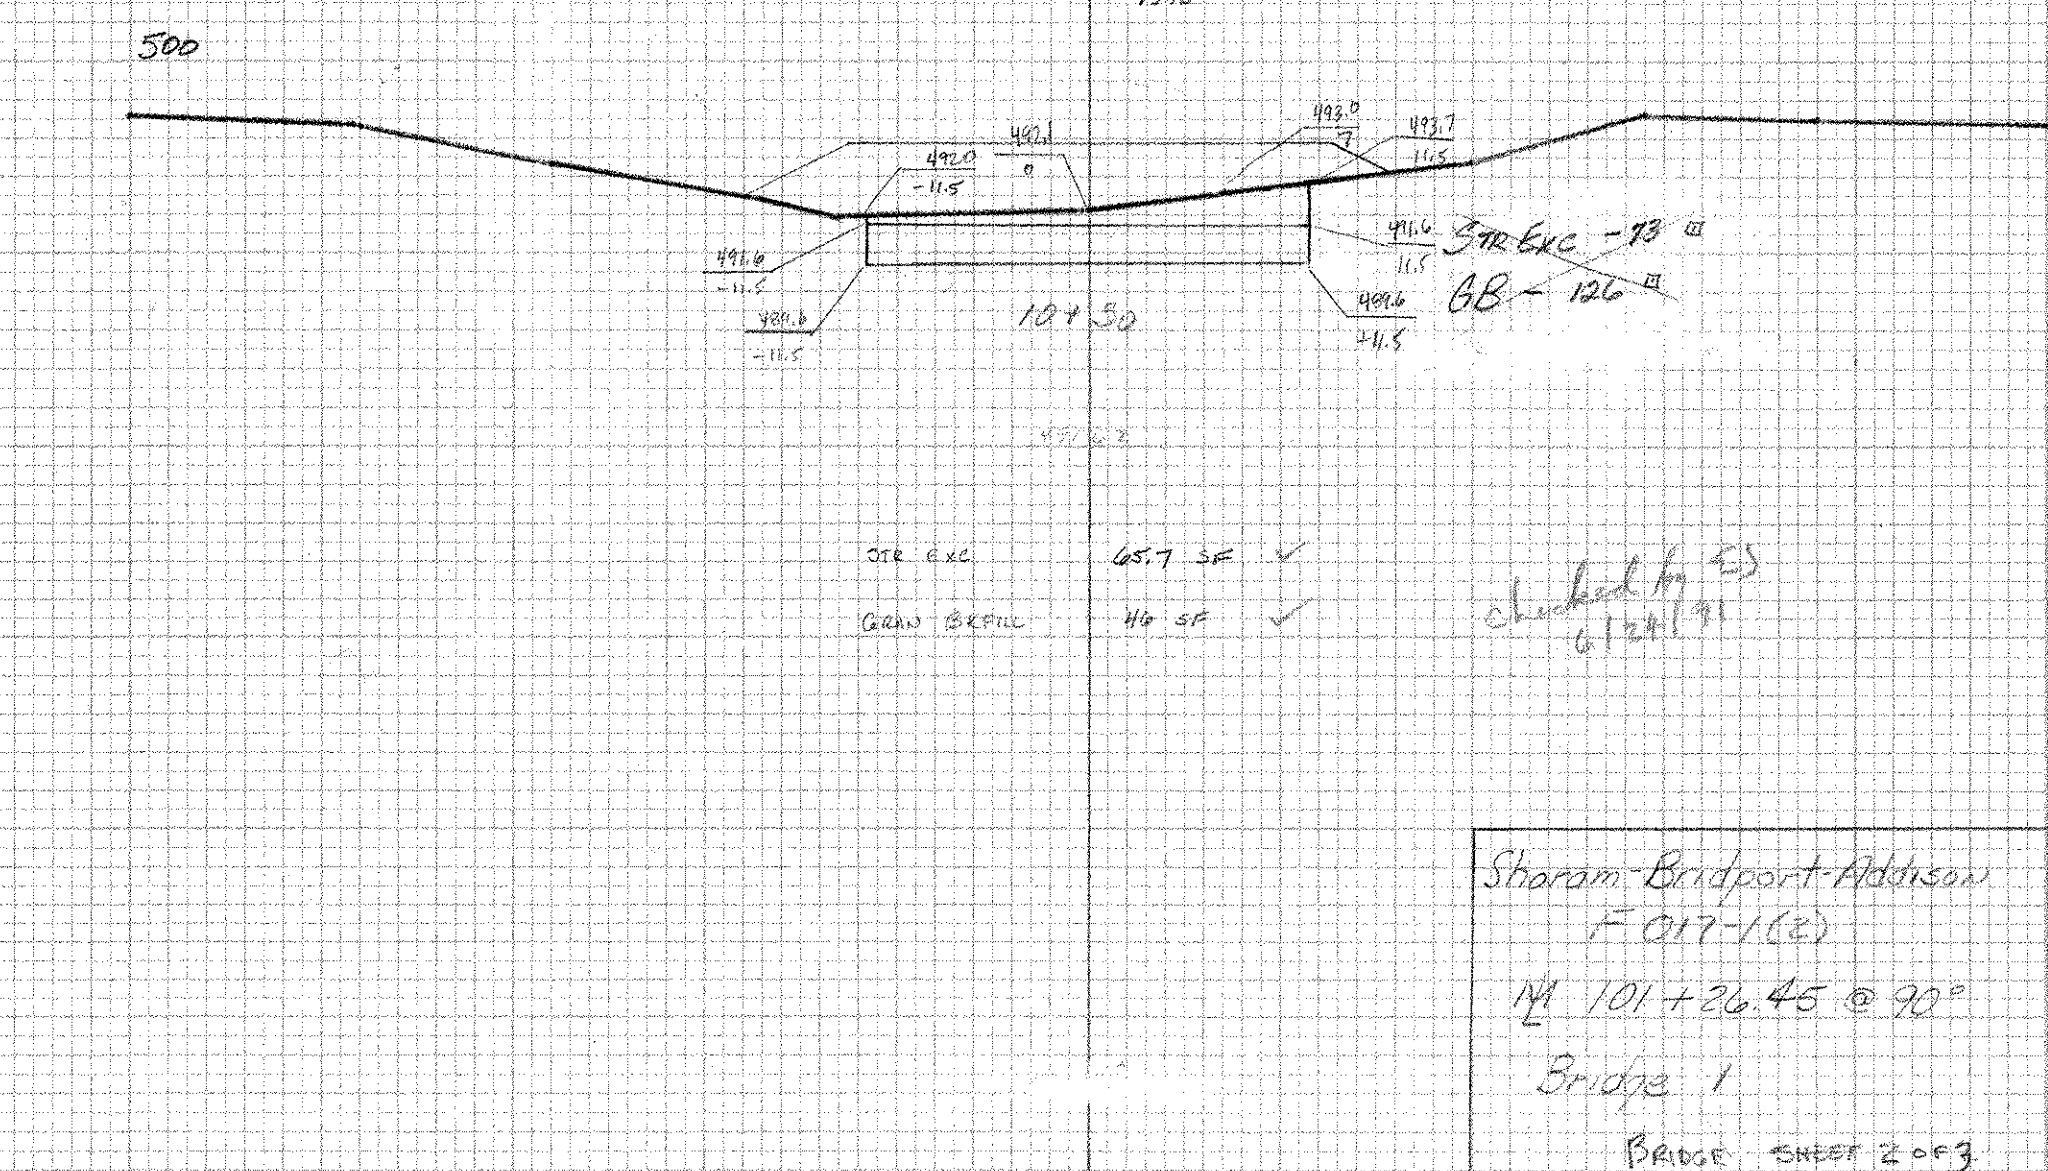
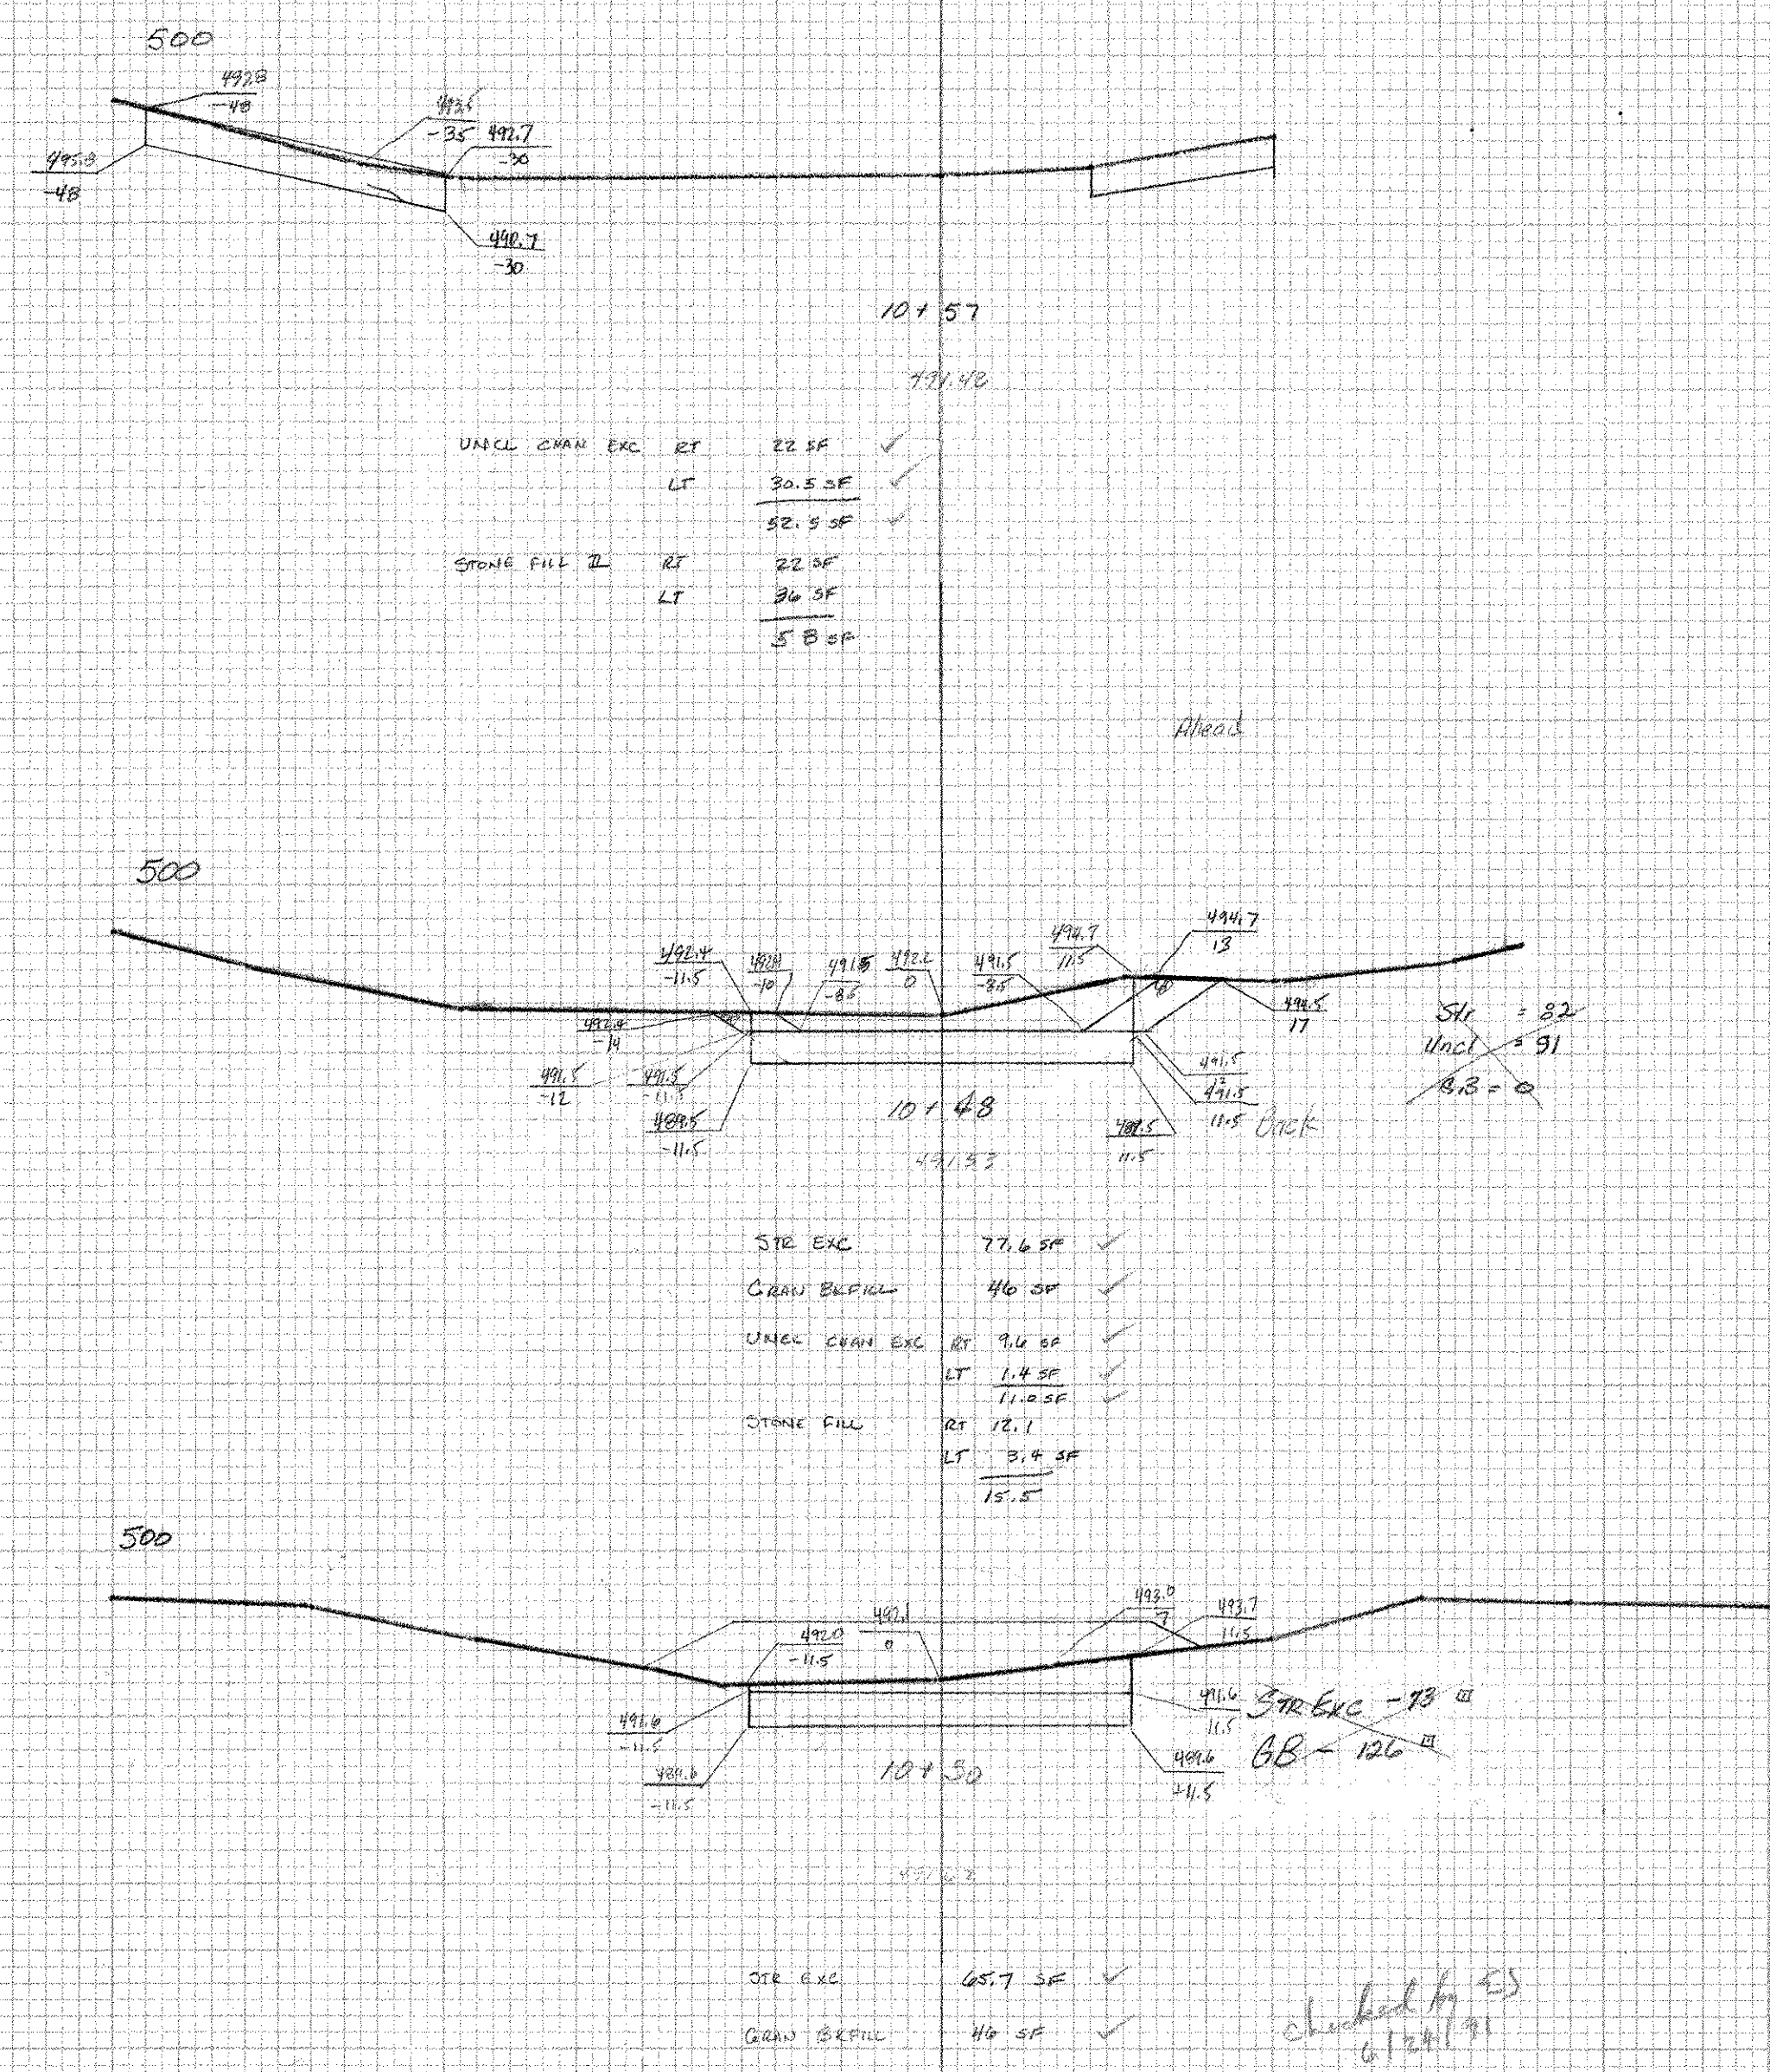
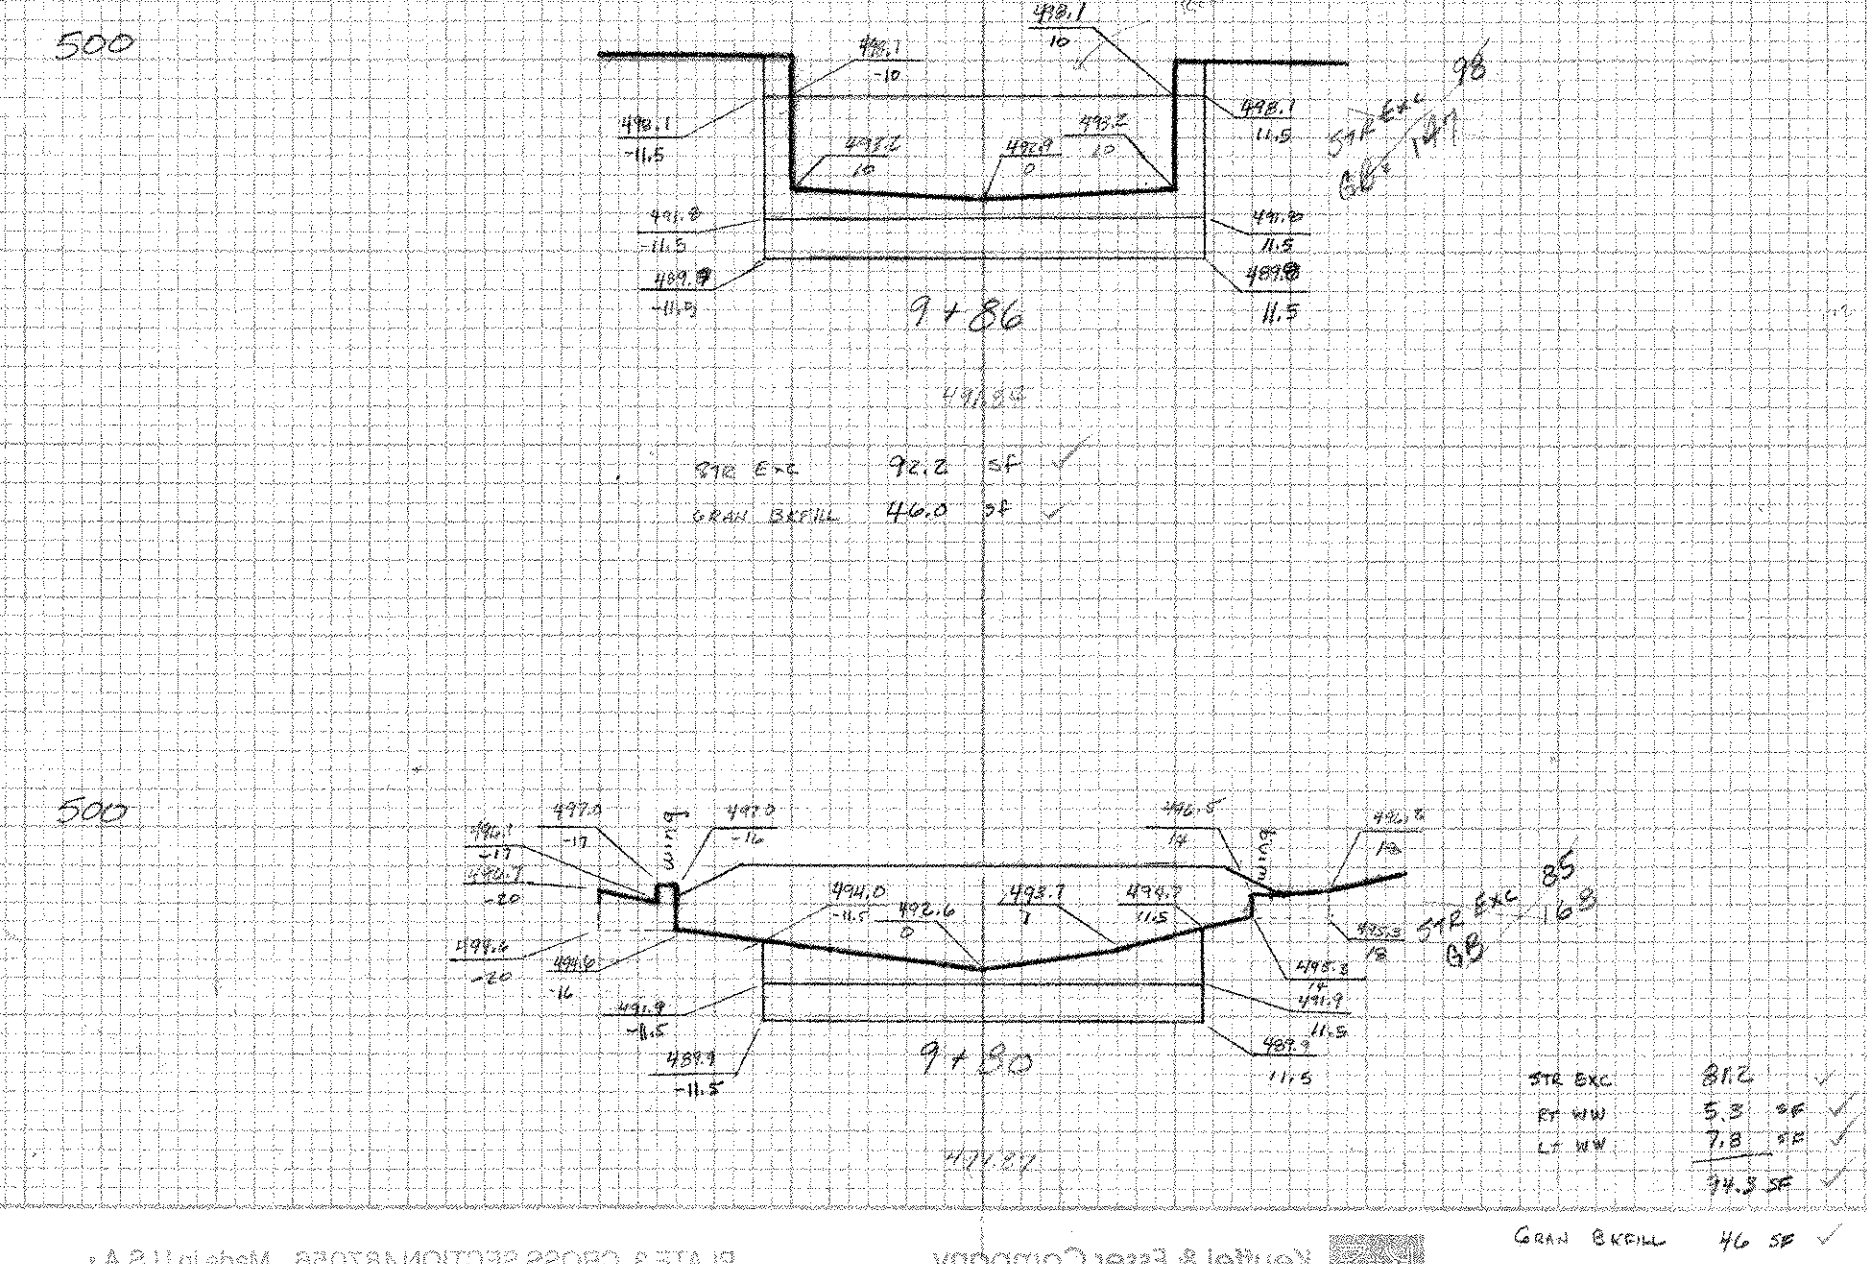
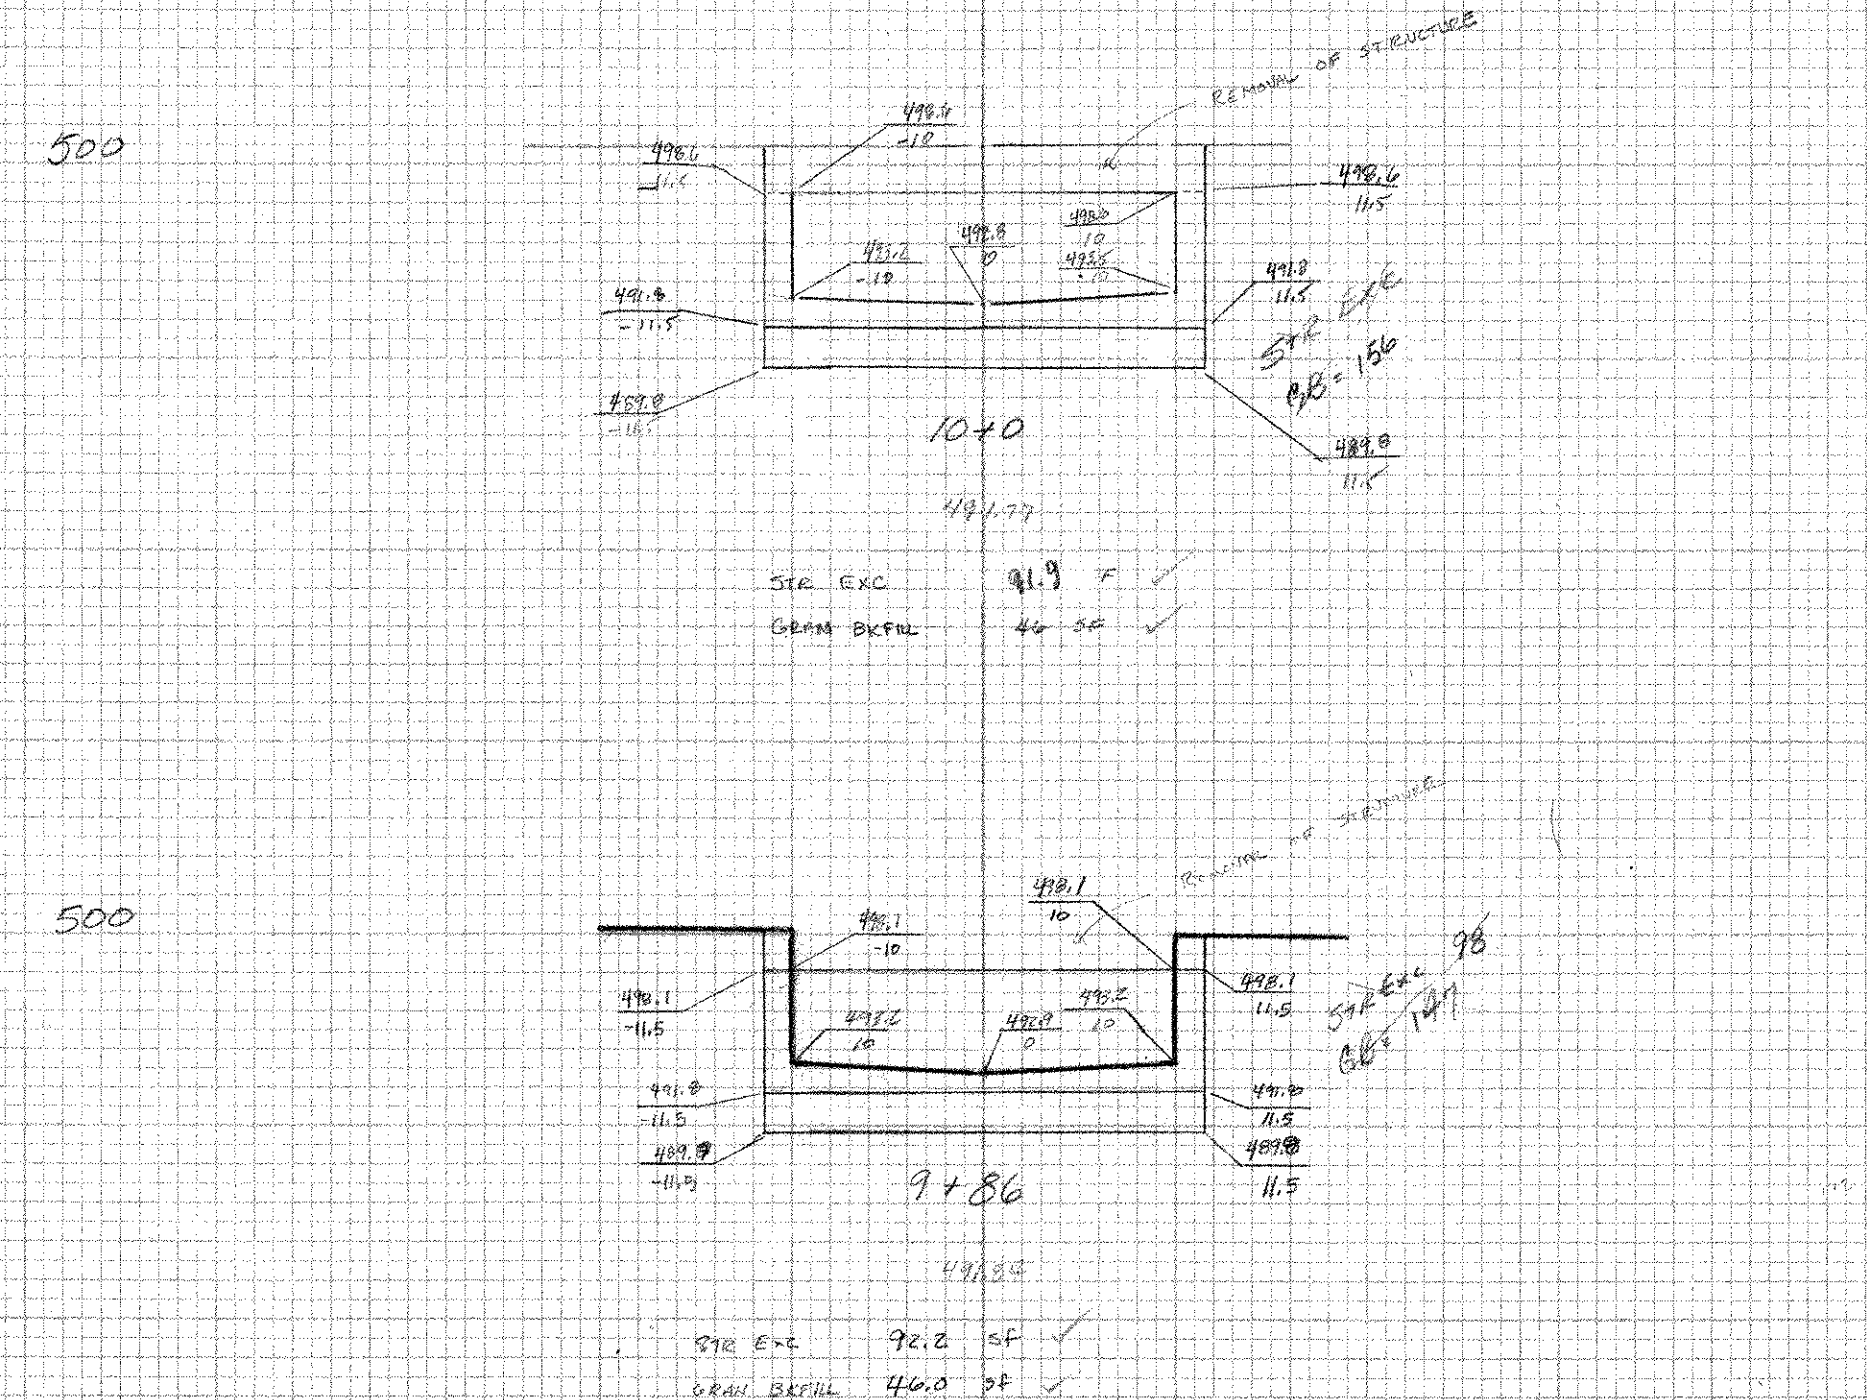
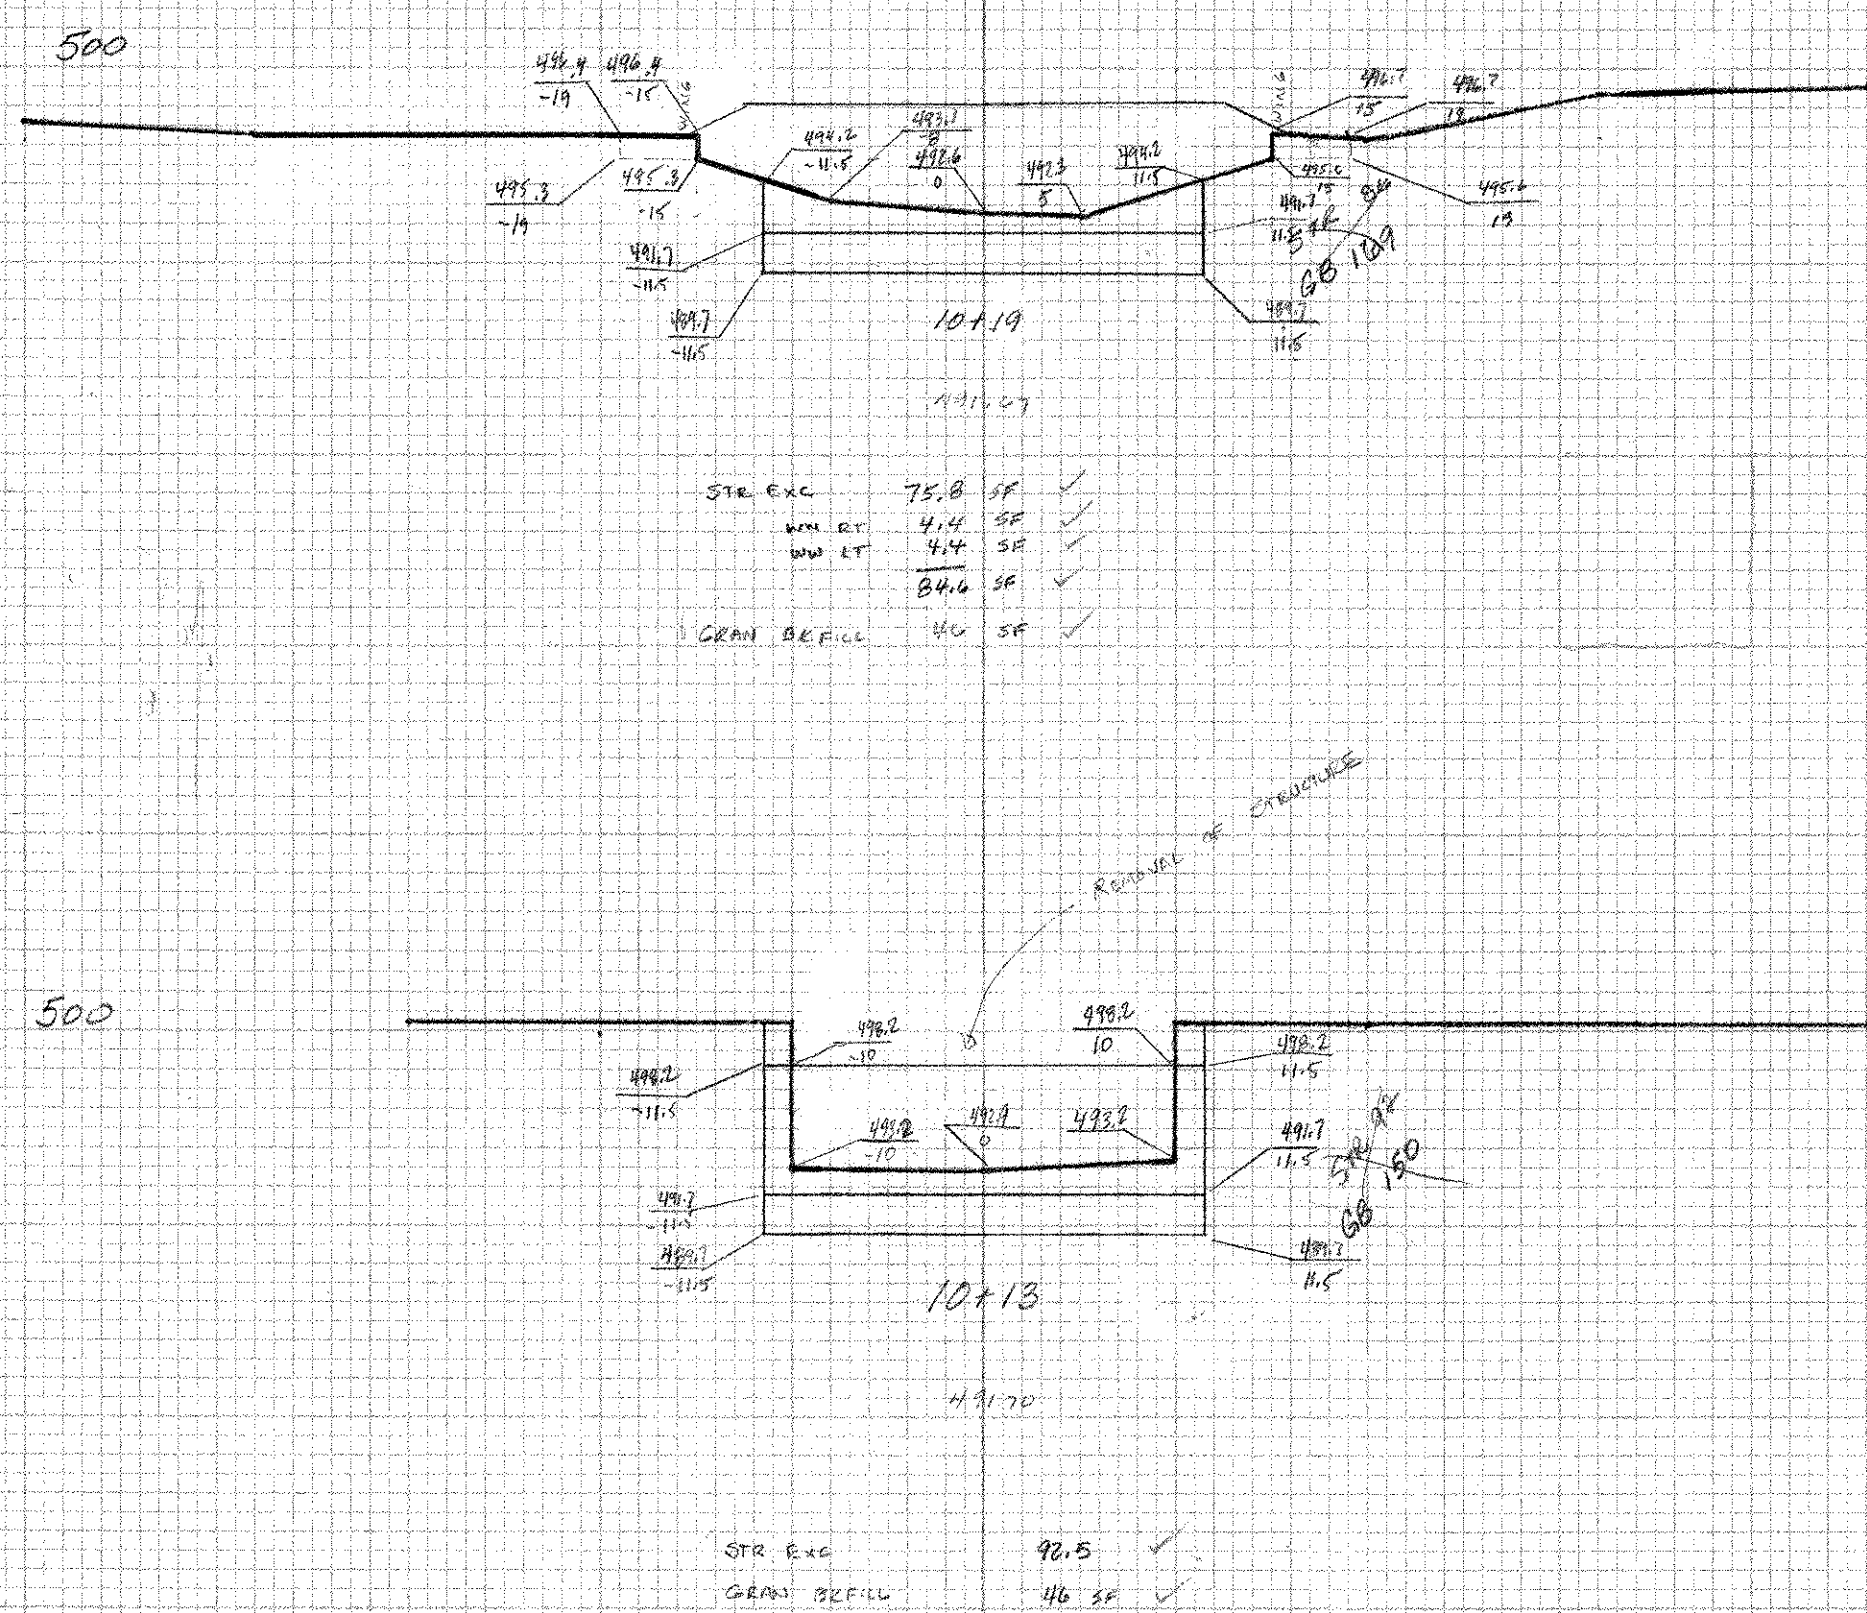


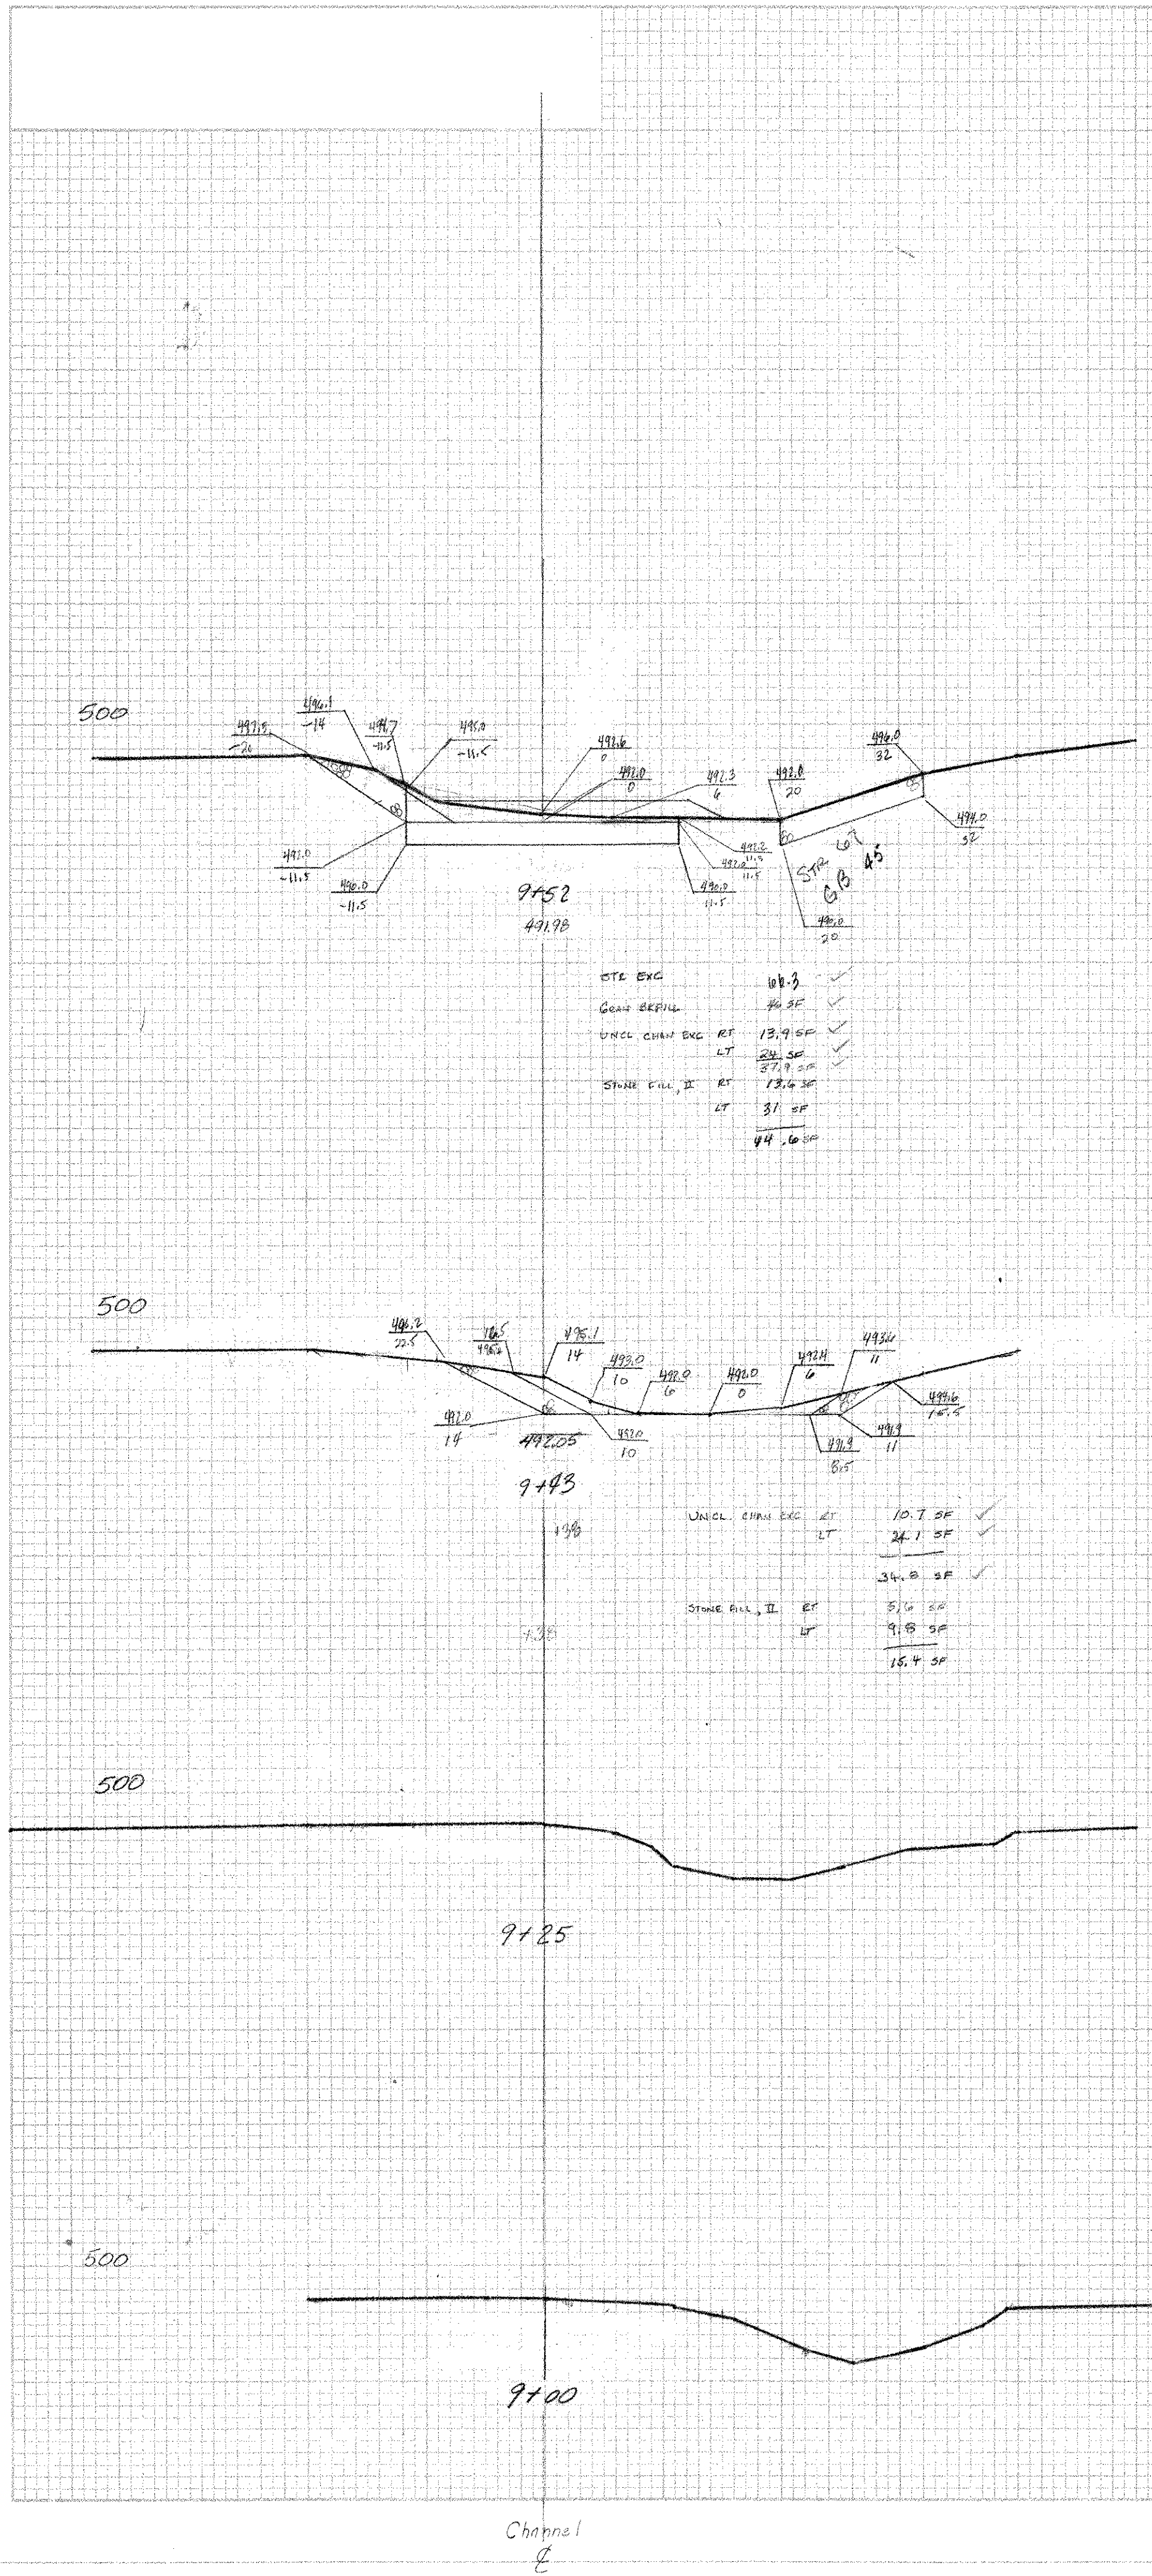

Sharon Bridgeport Addition
F 017-1(2)
N 101+26.45 @ 90°
Bridge 1
BRIDGE SHEET 2 OF 3

DESIGNED	DATE
CHECKED	DATE
IN CHARGE	DATE
APPROVED	DATE

DESIGNED	DATE
CHECKED	DATE
IN CHARGE	DATE
APPROVED	DATE