



TYPICAL SECTIONS & DESIGN DATA

1/2" Bituminous Concrete Pave., Item 406.25 Type III or
Type IV (leveling course)
1" Bituminous Concrete Pave., Item 406.25 Type III
(wearing course)

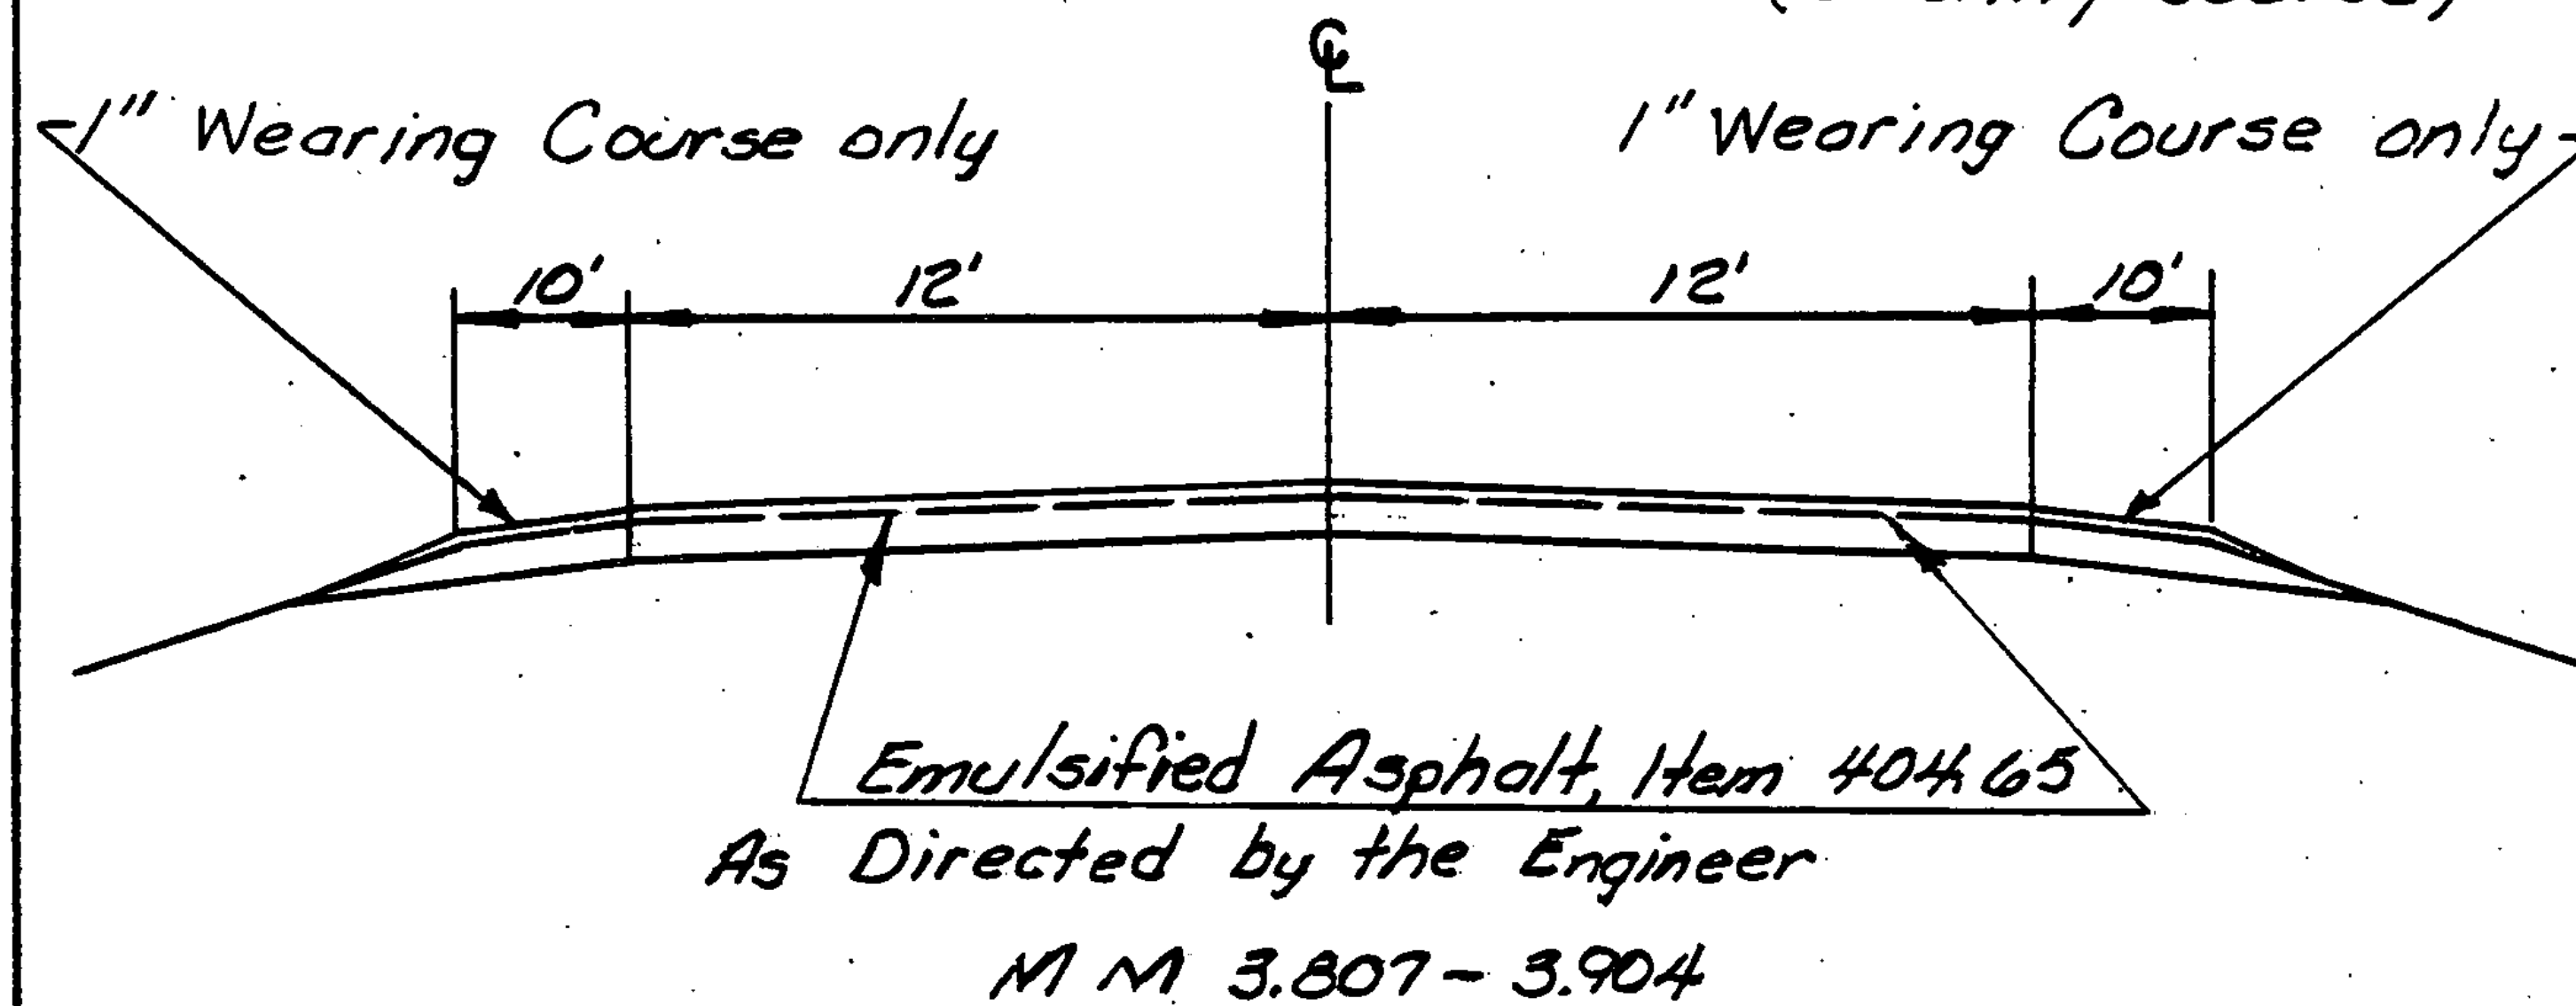

3/4" Cold Planing Bit. Pave., Item 210.10
3/4" Bituminous Concrete Pave., Item 406.25 Type III or
Type IV (leveling course)
1/2" Bituminous Concrete Pave., Item 406.25 Type III or
Type IV (leveling course)
1" Bituminous Concrete Pave., Item 406.25 Type III
(wearing course)

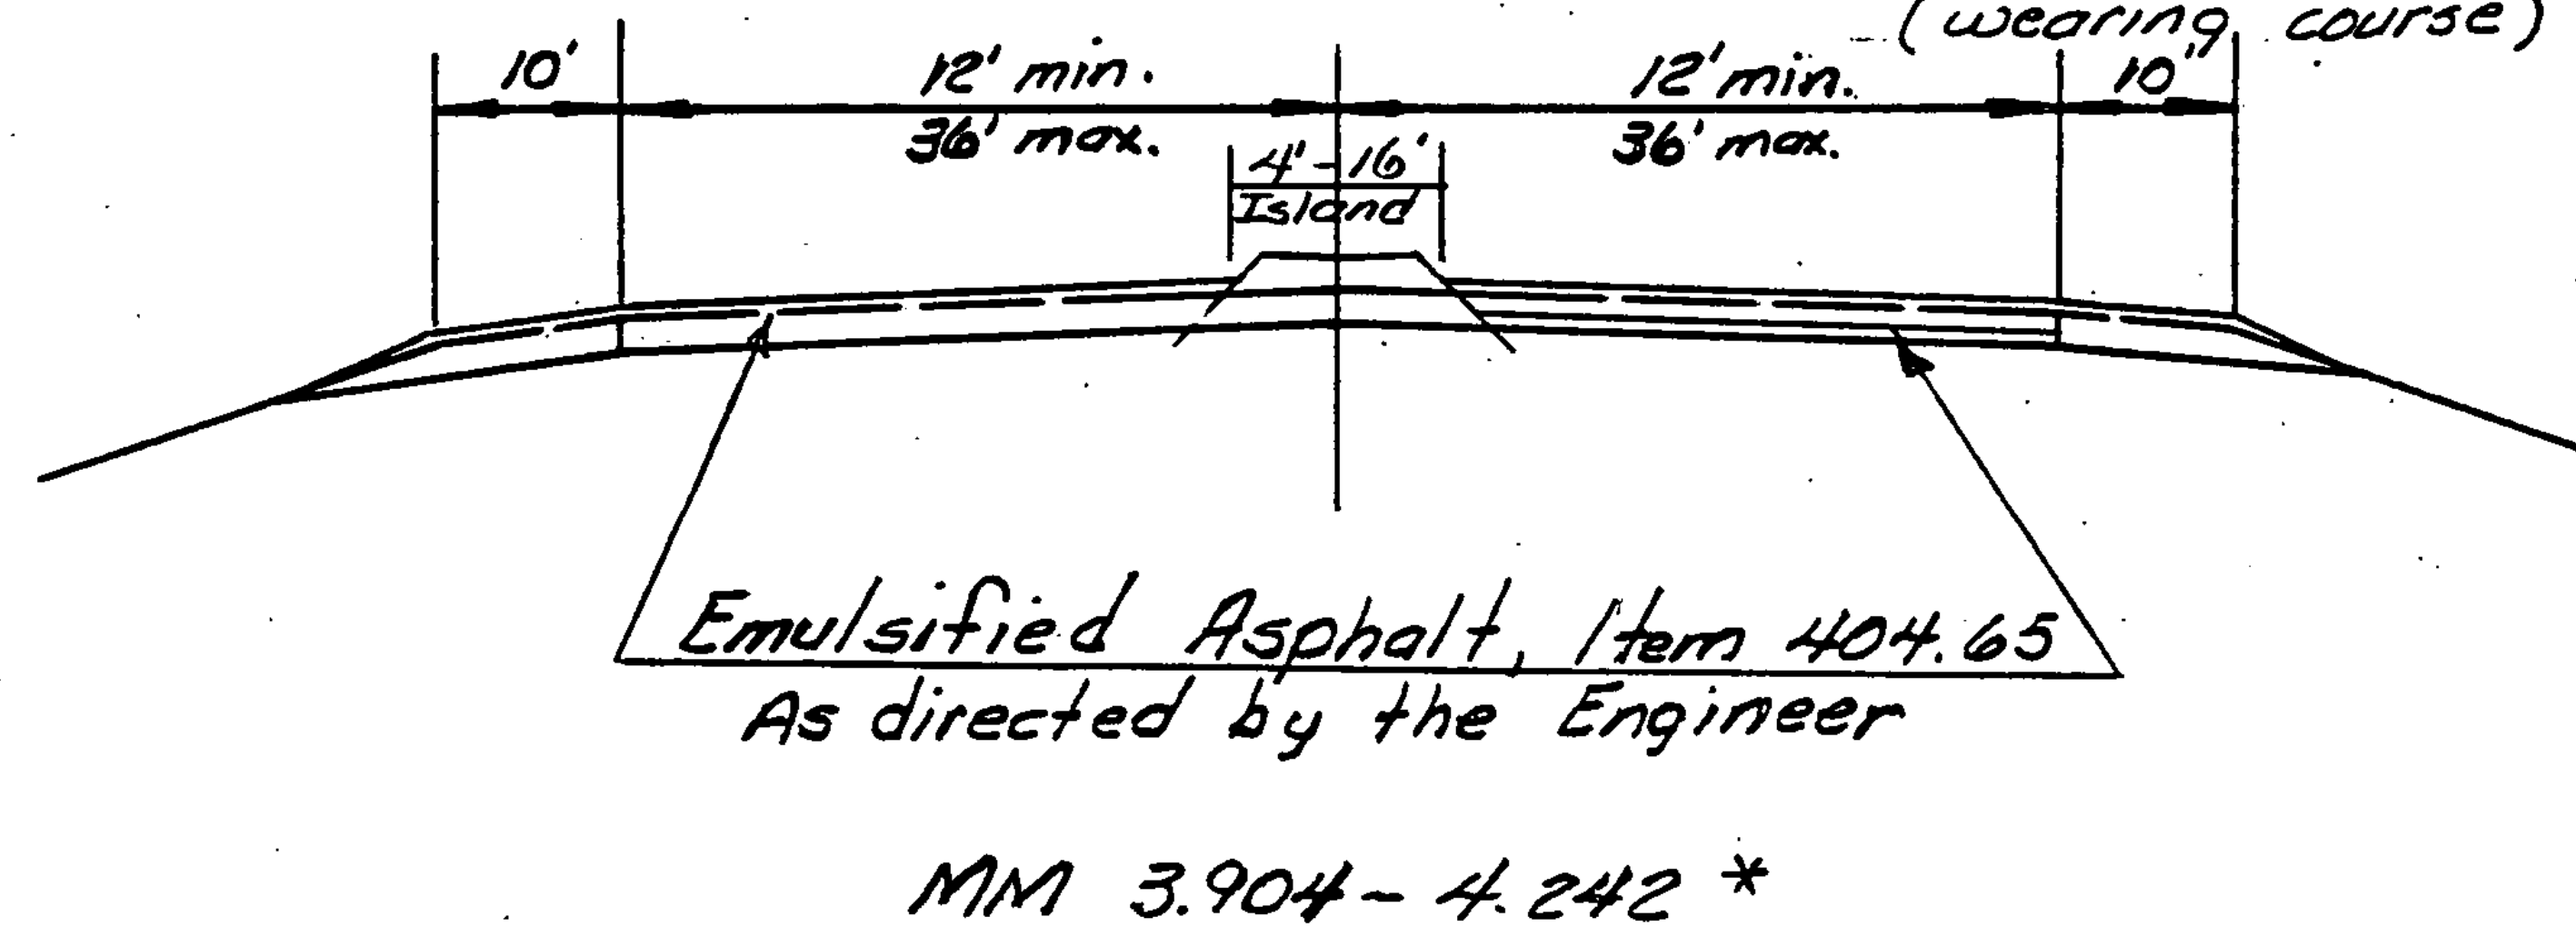

* Do Not PAVE BRIDGE No. 11 at MM 4.048

PROJECT BENNINGTON

NO. M 1000(7)S
SHEET 3 OF 13